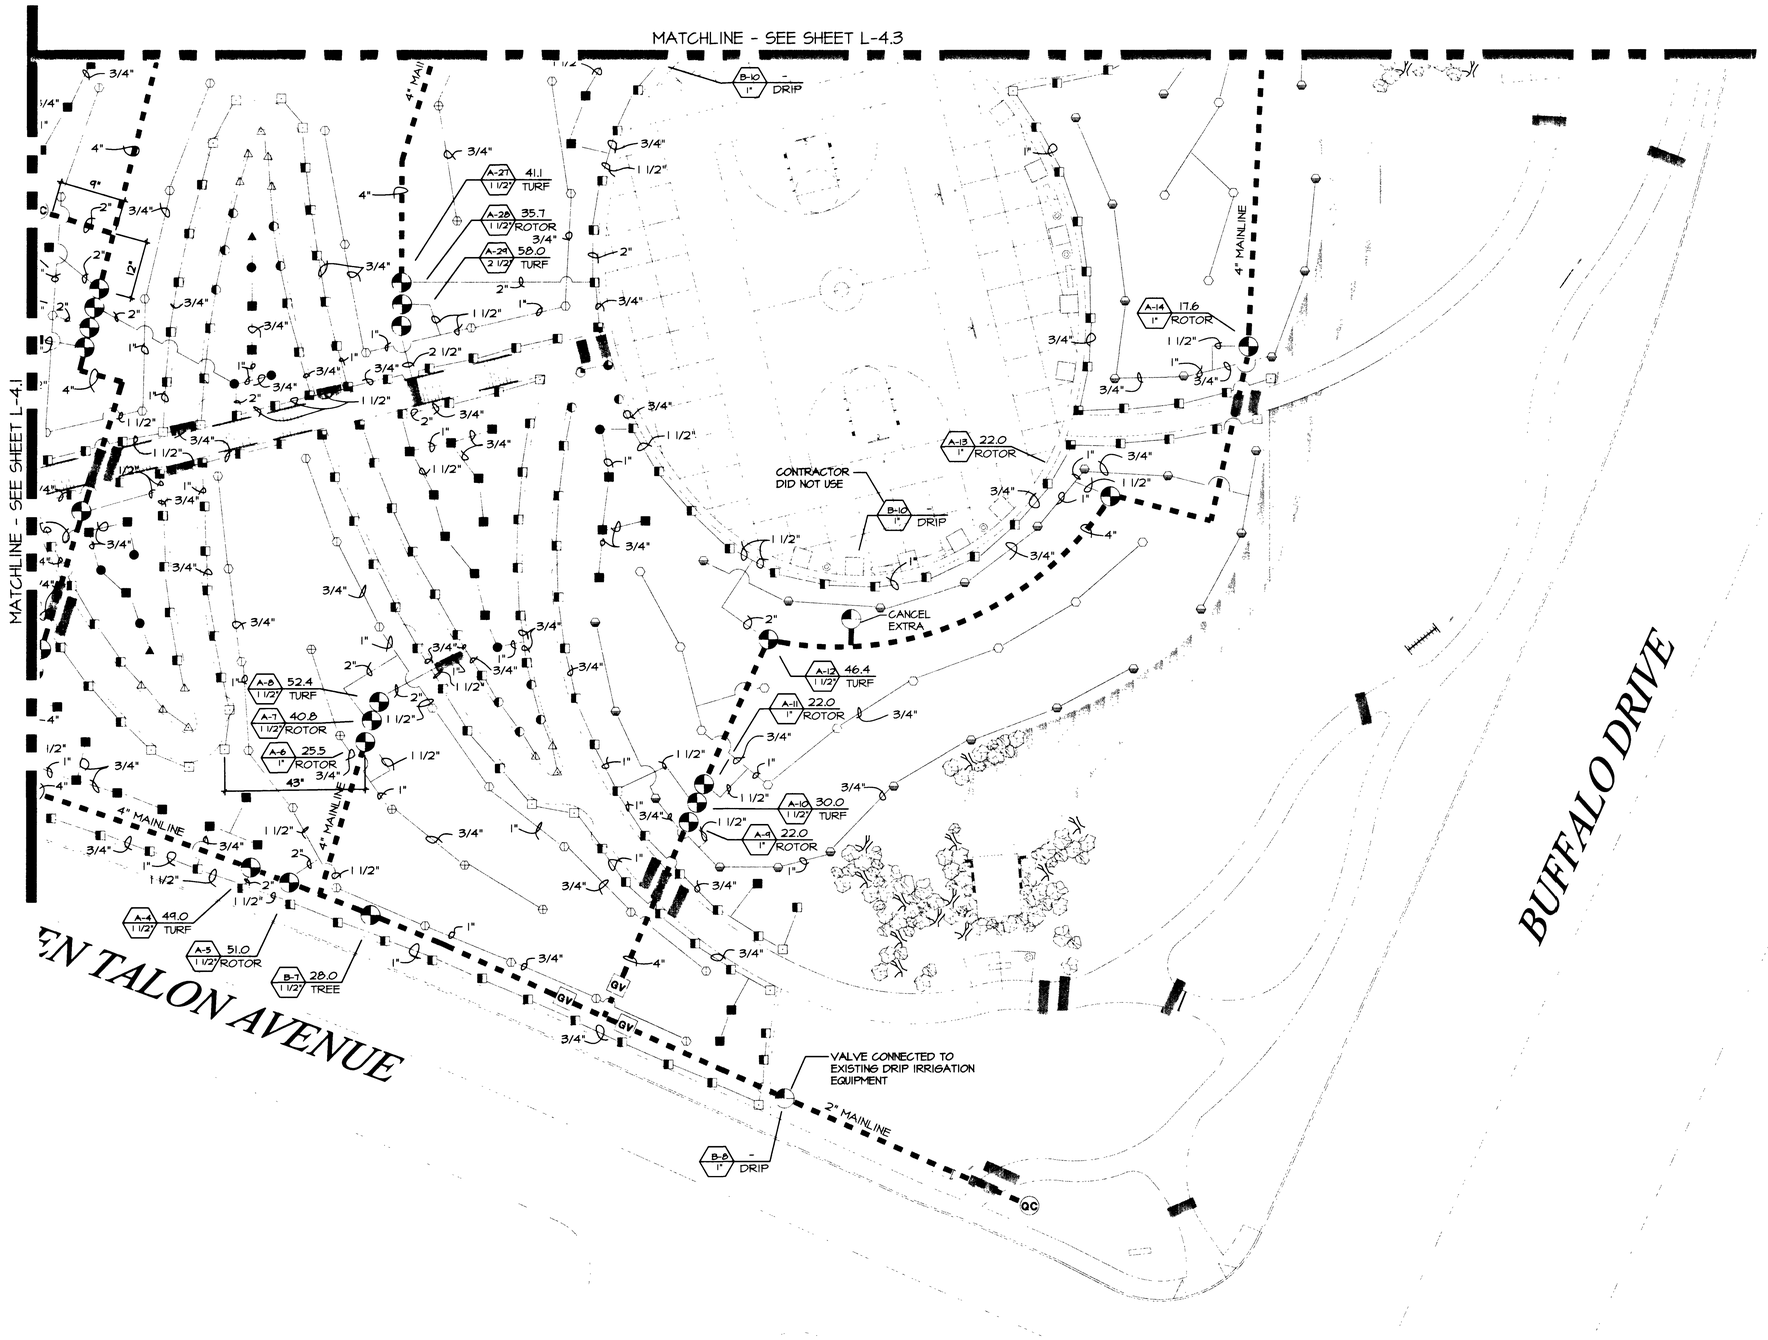

LANDSCAPE IRRIGATION PLAN

SCALE: 1"=20'-0"

48250

NORTH

Avoid cutting underground utility lines. It's costly.

Call before you Dig

1-800-227-2600

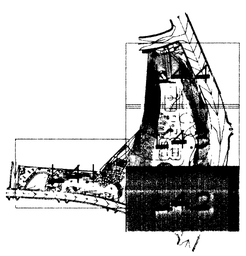

CITY OF LAS VEGAS NEVADA

REVISIONS

CONSULTANT

LUCCHESI GALATI ARCHITECTS
800 PILOT ROAD, SUITE A
LAS VEGAS, NEVADA 89119
(702) 896-7111

NVZUNINO & ASSOCIATES
LANDSCAPE ARCHITECTURE
LAND PLANNING
3191 South Jones Blvd.
Las Vegas Nevada 89146
Phone (702) 253-9390
Fax (702) 253-1016
E-Mail jwz@jwzunino.com

DEPARTMENT OF PUBLIC WORKS

ELKHORN SPRINGS
NEIGHBORHOOD PARK
BUFFALO DRIVE

LANDSCAPE IRRIGATION PLAN

STAMP

OWNER: CITY OF LAS VEGAS
DEPARTMENT OF PUBLIC WORKS
ARCHITECTURAL SERVICES

400 EAST STEWART AVENUE
LAS VEGAS, NEVADA 89101
PHONE: (702) 229-6535
FAX: (702) 382-3232
TDD: (702) 386-9108

DRAWN	HKS
FILE	28449-IR-TURF
DATE	3-9-01
SCALE	1" = 20'-0"
BID NO	01.15301.16
CLV DWG NO	650.64
SHT NO	40 OF 90

L4.2

DRAWINGS AS INSTRUMENTS OF SERVICE ARE THE PROPERTY OF THE DESIGN PROFESSIONAL. WHERE STAMP OF CERTIFICATION APPEARS ON THE DRAWINGS AND SPECIFICATIONS ANY USE OR REPRODUCTION IN WHOLE OR IN PART WITHOUT WRITTEN CONSENT IS STRICTLY PROHIBITED COPIES OF THE DRAWINGS AND SPECIFICATIONS WERE PREPARED AND ARE FOR THE CONSTRUCTION OF ANY OTHER PROJECT IS A VIOLATION