NOTES

1. EXISTING AREA TO REMAIN. EXCEPT AS INDICATED OTHERWISE.
2. PROVIDE CONNECTION TO MOTORIZED DOOR OPERATOR, COORDINATE WITH DIVISION 8. INSTALL AND WIRE ALL CONTROLS, ETC. AS REQUIRED.
3. PROVIDE 4" RAISED CONCRETE PAD.
4. INTERLOCK WITH OUTDOOR UNIT.
5. PROVIDE W.P. GFI MAINTENANCE RECEPTACLE ON ROOF.

NOTICE

1. EXISTING TO REMAIN SHOWN LIGHT. NEW SHOWN BOLD.

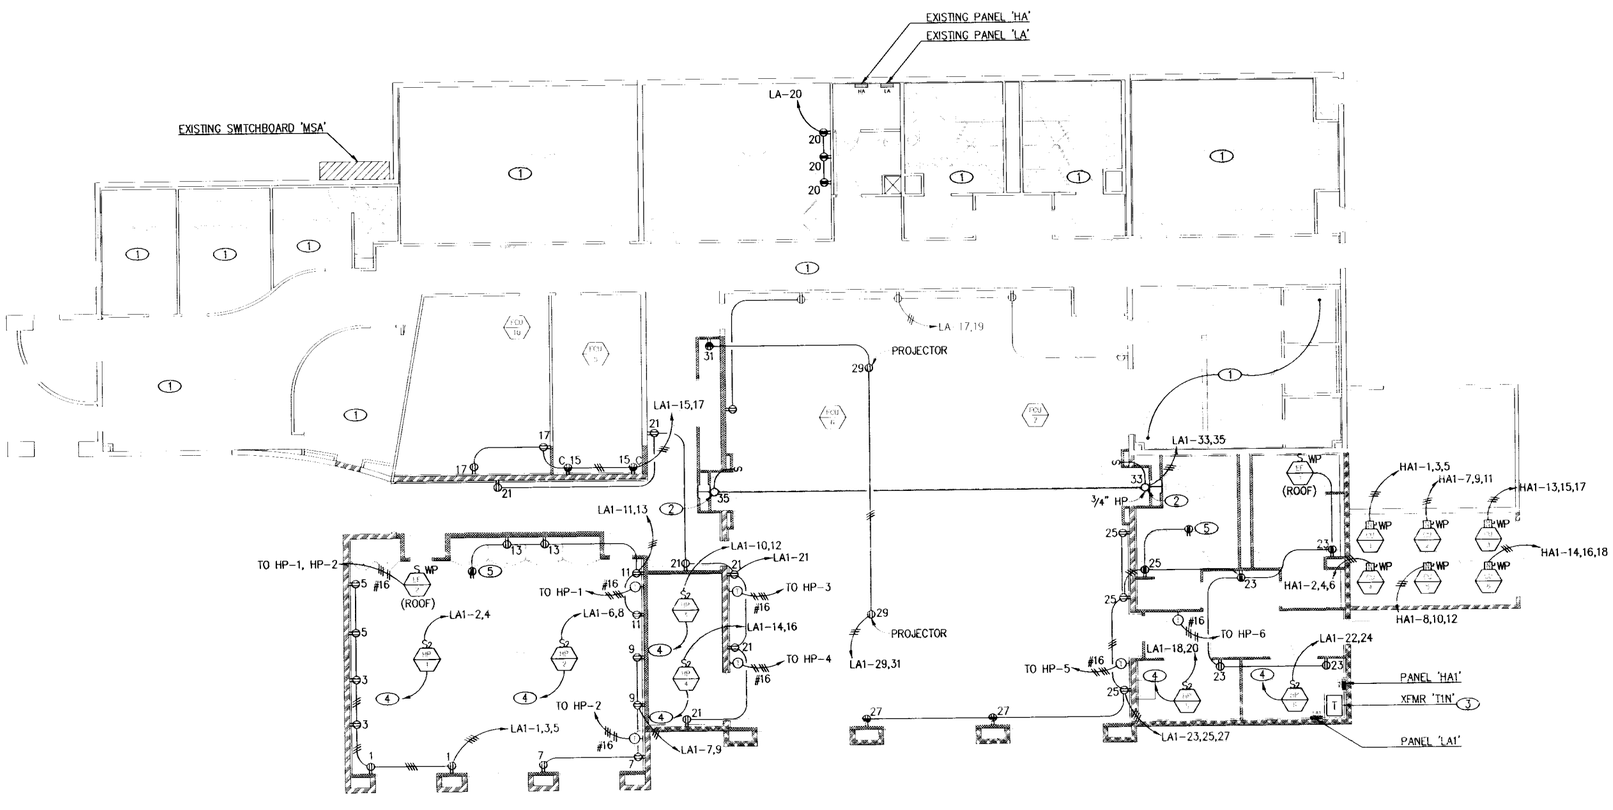

1 FLOOR PLAN - POWER

SCALE: 1/8"= 1'-0"

NORTH

Rev.	Date	By	Revision	Approved
	12-16-08		AS-BUILT	

WINSTON H. HENDERSON
ARCHITECTS
1555 EAST FLAMINGO ROAD STE. #350 LAS VEGAS, NV 89119
OFFICE (702) 893-9700 FAX (702) 893-9797

DOOLITTLE SENIOR CENTER
1950 NORTH J STREET
LAS VEGAS, NEVADA

FLOOR PLAN - POWER

Date: 12.20.08
Job No.: 06-010
Designed: NLB
Drawn: AMV
Update:
Checked: DLM

Sheet
E3.1

CONSULTING ENGINEERS
#06 0293

123839