ABBREVIATIONS

&	AND
@	AT
℄	CENTERLINE
#	POUND OR NUMBER
ABBREV.	ABBREVIATION
A.B.	ANCHOR BOLT
A.C.T.	ACOUSTICAL CEILING TILE
ACOUS.	ACOUSTICAL
A.D.	AREA DRAIN
ADJ	ADJUSTABLE
AGGR.	AGGREGATE
AL.	ALUMINUM
ALT	ALTERNATE
APPROX.	APPROXIMATE
ARCH.	ARCHITECTURAL
ASPH.	ASPHALT
A.V.	AUDIO/VISUAL
B.O.	BOTTOM OF
BD	BOARD
BITUM.	BITUMINOUS
BLDG	BUILDING
BLK	BLOCK
BLKG	BLOCKING
BM	BEAM
BOT.	BOTTOM
CAB.	CABINET
C.B.	CATCH BASIN
CEM.	CEMENT
C.F.C.I.	CONTRACTOR FURNISHED CONTRACTOR INSTALLED
C.F.O.I.	CONTRACTOR FURNISHED OWNER INSTALLED
C.G.	CORNER GUARD
C.J.	CONTROL JOINT
CLR	CLEAR
CLG	CEILING
CLK	CAULKING
CMU	CONCRETE MASONRY UNIT
CNTR	COUNTER
COL.	COLUMN
CONC.	CONCRETE
CONN.	CONNECTION
CONSTR.	CONSTRUCTION
CONT.	CONTINUOUS
CORR.	CORRIDOR
CPT	CARPET
C.R.	CARPET RAIL AND COLD-ROLLED
CTSK	COUNTERSUNK
CTR	CENTER
C.T.	CERAMIC TILE
DBL	DOUBLE
DIA.	DIAMETER OR ROUND
DIM.	DIMENSION
DISP.	DISPENSER
DN	DOWN
D.O.	DOOR OPENING
DR.	DOOR
D.S.	DOWN SPOUT
D.SP.	DRY STANDPIPE
DTL	DETAIL
DWG	DRAWING
DWR	DRAWER
E.	EAST
EA.	EACH
E.J.	EXPANSION JOINT
EL.	ELEVATION
ELEC.	ELECTRICAL
EMER.	EMERGENCY
ENCL.	ENCLOSURE
E.P.	ELECTRICAL PANEL
E.P.D.M.	SINGLE PLY ROOF MEMBRANE
EQ.	EQUAL
EQUIP.	EQUIPMENT
EX.	EXISTING
EXPO.	EXPOSED
E.W.C.	ELECTRIC WATER COOLER
EXP.	EXPANSION
EXT.	EXTERIOR
F.A.	FIRE ALARM
F.D.	FLOOR DRAIN
FDN	FOUNDATION
F.E.	FIRE EXTINGUISHER
F.E.C.	FIRE ENTINGUISHER CABINET
F.F.	FINISHED FLOOR
F.H.	FIRE HYDRANT
F.H.C.	FIRE HOSE CABINET
FIN.	FINISH
FLR	FLOOR
FLASH.	FLASHING
FLOUR.	FLUORESCENT
F.O.C.	FACE OF CONCRETE
F.O.F.	FACE OF FINISH
F.O.M.	FACE OF MASONRY
F.O.S.	FACE OF STUDS
FPRF	FIREPROOF
F.S.	FULL SIZE
FT	FEET OR FOOT
FTG	FOOTING
FUT.	FUTURE
GA.	GAUGE
GALV.	GALVANIZED
GL.	GLASS
GND	GROUND
GR.	GRADE
GYP.	GYPSUM
H.B.	HOSE BIB
H.C.	HOLLOW CORE
HDWD	HARDWOOD
HDWE	HARDWARE
H.M.	HOLLOW METAL
HORIZ.	HORIZONTAL
HR	HOUR
HGT	HEIGHT
I.D.	INSIDE DIAMETER
INSUL.	INSULATION
INT.	INTERIOR
JAN.	JANITOR
JT	JOINT
KIT.	KITCHEN
LAM.	LAMINATE
LAV.	LAVATORY
LT	LIGHT
MAX.	MAXIMUM
M.C.	MEDICINE CABINET
MECH.	MECHANICAL
MEMB.	MEMBRANE
MET.	METAL
MFR	MANUFACTURER
MH	MANHOLE
MIR.	MIRROR
MISC.	MISCELLANEOUS
M.O.	MASONRY OPENING
MTD.	MOUNTED
MULL.	MULLION
N.	NORTH
N.I.C.	NOT IN CONTRACT
NO.	NUMBER
NOM.	NOMINAL
N.T.S.	NOT TO SCALE
O/	OVER
O.A.	OVER ALL
OBS.	OBSCURE
O.C.	ON CENTER
O.D.	OUTSIDE DIAMETER
O.F.C.I.	OWNER FURNISHED CONTRACTOR INSTALLED
O.F.O.I.	OWNER FURNISHED OWNER INSTALLED
OPNG	OPENING
OPP.	OPPOSITE
O.S.B.	ORIENTED STRAND BOARD
PRCST	PRE-CAST
PL.	PLATE
P.L.	PLATE LINE
P.LAM.	PLASTIC LAMINATE
PLAS.	PLASTER
PLYWD.	PLYWOOD
PR.	PAIR
PT	POINT
RAD.	RADIUS
R.D.	ROOF DRAIN
REF.	REFERENCE
REFR.	REFRIGERATOR
REINF.	REINFORCED
REQ.	REQUIRED
RESIL.	RESILIENT
RGTR.	REGISTER
RM	ROOM
R.O.	ROUGH OPENING
RWD	REDWOOD
R.W.L.	RAIN WATER LEADER
S.	SOUTH
S.C.	SOLID CORE
SCHED.	SCHEDULE
SECT.	SECTION
SH.	SHELF
SHT	SHEET
SIM.	SIMILAR
SPEC.	SPECIFICATION
SQ.	SQUARE
S.ST.	STAINLESS STEEL
S.SK	SERVICE SINK
STD	STANDARD
STL	STEEL
STOR.	STORAGE
STRL	STRUCTURAL
SUSP.	SUSPENDED
SYM.	SYMMETRICAL
TEL.	TELEPHONE
THK	THICK
TRD OR T.	TREAD
T.O.C.	TOP OF CURB
T.O.P.	TOP OF PARAPET
T.O.W.	TOP OF WALL
TYP.	TYPICAL
UNFIN.	UNFINISHED
U.N.O.	UNLESS NOTED OTHERWISE
VAR.	VARIES
V.B.	VAPOR BARRIER
V.C.G.	VINYL CORNER GUARD
V.C.T.	VINYL COMPOSITE TILE
VERT.	VERTICAL
VEST.	VESTIBULE
W.	WEST
W.C.	WATER CLOSET
WD	WOOD
W.I.	WROUGHT IRON
W/O	WITHOUT
WP	WATERPROOF
WSCT	WAINSCOT
WT	WEIGHT

SYMBOLS LEGEND

Symbol	Description	Symbol	Description
(#)	NUMBER OF COMBINED OCCUPANTS USING EXIT	# / SHT	BUILDING SECTION/WALL SECTION
(#)	TOTAL NUMBER OF COMBINED OCCUPANTS USING EXIT	# / SHT	BUILDING ELEVATION
RM NAME / #	ROOM NUMBER	# / SHT	DETAIL NUMBER
#	DOOR NUMBER-REFER TO DOOR SCHEDULE		DATUM REFERENCE
#	EQUIPMENT NUMBER-REFER TO EQUIPMENT SCHEDULE	△	REVISION NUMBER
# # SHT # #	ELEVATION REFERENCE	RUN / RISE	SLOPE

MATERIALS LEGEND

EARTH	STEEL
CONCRETE	BATT INSULATION
MASONRY	BLOCKING
PLYWOOD	ROUGH WOOD

44983

GENERAL NOTES

1. GENERAL NOTES APPLY TO ALL DRAWINGS. SHEET NOTES PERTAIN TO SPECIFIC SHEETS.
2. THE TERM "ARCHITECT/ENGINEER" REFERS TO THE RESPONSIBLE ENTITY WHOSE NAME APPEARS ON THE CONTRACT DOCUMENTS.
3. THE TERM "CONTRACT DOCUMENTS" REFERS TO THE DRAWINGS, SPECIFICATIONS & OTHER DOCUMENTS ISSUED BY THE ARCHITECT/ENGINEER.
4. THE DRAWINGS & PROJECT MANUAL ARE PREPARED TO SHOW THE ARCHITECT'S INTENT IN THE DESIGN & CONSTRUCTION FOR THIS PROJECT. IN ALL MATTERS RELATED TO THE USE OR INTERPRETATION OF THESE VARIOUS DRAWINGS & PROJECT MANUAL, THE ARCHITECT'S WRITTEN STATEMENT SHALL BE CONSIDERED FINAL. MAKE NO DEVIATIONS FROM THE DRAWINGS OR PROJECT MANUAL WITHOUT WRITTEN APPROVAL FROM THE ARCHITECT.
5. ABSOLUTE ACCURACY OF DATA INDICATED IN THE DRAWINGS &/OR SPECIFICATIONS IS NOT GUARANTEED. THE DOCUMENTS MAY REPRESENT IMPERFECT DATA & MAY CONTAIN ERRORS, OMISSIONS, INCONSISTENCIES, CODE VIOLATIONS & IMPROPER USE OF MATERIALS. SUCH DEFICIENCIES WILL BE CORRECTED WHEN IDENTIFIED. THE CONTRACTOR IS REQUIRED TO CAREFULLY STUDY & COMPARE THE DRAWINGS & SPECIFICATIONS & IMMEDIATELY REPORT TO THE ARCHITECT ANY DEFICIENCIES DISCOVERED THE CONTRACTOR MUST REQUIRE EACH SUBCONTRACTOR TO LIKEWISE STUDY THE DOCUMENTS & REPORT ANY DEFICIENCIES DISCOVERED. THE CONTRACTOR IS REQUIRED TO RESOLVE ALL REPORTED DEFICIENCIES W/ THE ARCHITECT PRIOR TO STARTING THE WORK. IF THE CONTRACTOR PROCEEDS W/ THE WORK AFFECTED WITHOUT WRITTEN INSTRUCTION FROM THE ARCHITECT, THE CONTRACTOR SHALL BE RESPONSIBLE FOR ANY WORK RESULTING IN DAMAGE OR DEFECT AT NO ADDITIONAL COST TO THE OWNER.
6. DO NOT SCALE DRAWINGS, WRITTEN DIMENSIONS TAKE PRECEDENCE OVER SCALED DIMENSIONS.
7. DIMENSIONS AS SHOWN ON ARCHITECTURAL FLOOR PLANS ARE ACTUAL & FACE TO FACE OF CMU, CENTERLINE OF COLUMN, FACE OF STUD, UNLESS NOTED OTHERWISE.
8. DIMENSIONS FOR DOOR OPENINGS SHOWN NOMINAL ARE TO ALLOW FOR ¼" SHIMMING & SEALANT OF EXTERIOR FRAMES AS NOTED ON PLANS.
9. NO PORTION OF THE WORK REQUIRING A SHOP DRAWING OR SAMPLE SUBMISSION SHALL BE COMMENCED UNTIL THE SUBMISSION HAS BEEN APPROVED BY THE ARCHITECT. THE AUTHOR OF, OR PARTY RESPONSIBLE FOR EACH SHOP DRAWING IS REQUIRED TO INSURE THAT SUCH DOCUMENTS ACCURATELY CONFORM W/ THE DESIGN CONCEPT & COMPLY W/ THE INFORMATION GIVEN IN THE CONTRACT DOCUMENTS. ALL SUCH PORTIONS OF THE WORK SHALL BE IN ACCORDANCE W/ APPROVED SHOP DRAWINGS & SAMPLES.
10. THE GENERAL CONTRACTOR SHALL SUPERVISE & DIRECT ALL WORK. HE SHALL BE RESPONSIBLE FOR ALL MEANS & METHODS, TECHNIQUES, SEQUENCES & PROCEDURES & COORDINATE ALL PORTIONS OF WORK UNDER THE CONTRACT. HE IS TO USE ADEQUATE NUMBERS OF SKILLED WORKMEN WHO ARE THOROUGHLY TRAINED & EXPERIENCED IN THEIR TRADES & WHO ARE COMPLETELY FAMILIAR W/ THE SPECIFIED REQUIREMENTS & METHODS NECESSARY FOR PROPER PERFORMANCE OF THE WORK.
11. THE GENERAL CONTRACTOR SHALL APPLY FOR & OBTAIN AT THE CONTRACTOR'S SOLE EXPENSE, ALL NECESSARY CONSTRUCTION PERMITS REQUIRED BY ALL APPLICABLE BUILDING CODES & REGULATORY CITY & COUNTY AGENCIES.
12. THE GENERAL CONTRACTOR IS TO BE FAMILIAR W/ THE EXISTING JOB SITE & CONDITIONS. THE GENERAL CONTRACTOR SHALL SUBMIT A WRITTEN DEFICIENCY LIST OF ALL EXISTING SYSTEMS PRIOR TO COMMENCEMENT OF SCOPE OF WORK. HE IS TO ACCEPT THOSE EXISTING CONDITIONS AS HE FINDS THEM. ALL TRADES ARE TO BE FAMILIAR W/ ALL DOCUMENTS & INFORMATION SHOWN. INFORMATION ON ANY SHEET IS AS BINDING AND IS AS IF SHOWN ON ALL SHEETS.
13. THE GENERAL CONTRACTOR SHALL MAINTAIN THE JOB SITE IN A CLEAN & ORDERLY CONDITION, FREE OF DEBRIS & LITTER. EACH SUBCONTRACTOR IMMEDIATELY UPON COMPLETION OF EACH PHASE OF HIS WORK SHALL REMOVE ALL TRASH & DEBRIS AS A RESULT OF HIS OPERATION.
14. THE GENERAL CONTRACTOR SHALL BE RESPONSIBLE FOR INITIATING, MAINTAINING & SUPERVISING ALL SAFETY PRECAUTIONS & PROGRAMS IN CONNECTION W/ THE WORK & PROVIDE SAFE ACCESS TO & FROM ALL LOCATIONS.
15. THE GENERAL CONTRACTOR SHALL PROVIDE PUBLIC PROTECTION & MAINTENANCE TO ALL AREAS AFFECTED BY THE WORK AS NECESSARY & AS REQUIRED BY LOCAL, STATE & FEDERAL CODES.
16. THE GENERAL CONTRACTOR SHALL PROVIDE ALL FIRE EXTINGUISHERS REQUIRED & LOCATED BY FIRE DEPARTMENT INSPECTOR IN THE FIELD.
17. THE GENERAL CONTRACTOR SHALL PROVIDE EXIT SIGNS PER U.B.C.
18. THE CONTRACTOR SHALL PERFORM ALL WORK SHOWN OR NOTED ON THE DRAWINGS IN STRICT ACCORDANCE W/, OR EXCEEDING, ALL LOCAL, STATE & FEDERAL MINIMUM STANDARDS OF AGENCIES HAVING JURISDICTION OVER THE PROJECT, & THE CURRENT & APPLICABLE EDITIONS OF THE UNIFORM BUILDING CODE, UNIFORM MECHANICAL CODE, UNIFORM PLUMBING CODE & NATIONAL ELECTRICAL CODE.
19. THE CONTRACTOR SHALL BE FAMILIAR W/ ALL DRAWINGS & SPECIFICATIONS OF THE VARIOUS BUILDING SYSTEMS. INFORMATION SHOWN ON ONE DOCUMENT MAY REPRESENT INFORMATION RELATIVE TO OTHER DOCUMENTS.
20. THE CONTRACTOR SHALL VERIFY ALL DIMENSIONS IN THE FIELD & NOTIFY THE ARCHITECT OF ANY ERRORS, OMISSIONS, OR DISCREPANCIES PRIOR TO PROCEEDING W/ THE WORK.
21. THE CONTRACTOR SHALL BE RESPONSIBLE FOR THE ACCURACY OF THE BUILDING LINES & LEVELS AND FOR THE CAREFUL COMPARISON OF THE LINES & LEVELS SHOWN ON THE DRAWINGS W/ EXISTING SITE CONDITIONS, & CALL ANY DISCREPANCIES TO THE ATTENTION OF THE ARCHITECT PRIOR TO PROCEEDING W/ THE WORK.
22. THE CONTRACTOR SHALL REQUEST A CLARIFICATION FROM THE ARCHITECT IF UNCERTAIN OF EXACT REQUIREMENTS OF THE DRAWINGS & SPECIFICATIONS. HE SHALL BE RESPONSIBLE TO CORRECT THE CONDITIONS CONSTRUCTED IN ERROR AT CONTRACTOR'S OWN EXPENSE & SHALL BE RESPONSIBLE FOR THE EXPENSE & REPAIR OF ANY RESULTING DAMAGE OR DEFECT TO THE WORK OR PROPERTY OF OTHERS.
23. THE CONTRACTOR SHALL CONFINE OPERATION AT THE SITE TO AREAS PERMITTED BY LAW, ORDINANCES, PERMITS & THE CONTRACT DOCUMENTS. HE SHALL NOT UNREASONABLY ENCUMBER THE SITE WITH ANY MATERIALS OR EQUIPMENT.
24. THE CONTRACTOR SHALL PERFORM ALL CUTTING, FITTING OR PATCHING OF HIS WORK THAT MAY BE REQUIRED & SHALL NOT ENDANGER ANY WORK BY CUTTING, EXCAVATING, OR OTHERWISE ALTERING THE WORK OR ANY PART OF IT.
25. THE CONTRACTOR SHALL PROVIDE ALL MEASURES NECESSARY TO PROTECT THE STRUCTURE DURING CONSTRUCTION SUCH MEASURES SHALL INCLUDE, BUT NOT BE LIMITED TO BRACING, SHORING FOR LOADS DUE TO CONSTRUCTION EQUIPMENT, ETC.
26. ALL CONSTRUCTION & MATERIALS SHALL BE EQUAL TO OR EXCEED MINIMUM REQUIREMENTS OF THE CURRENT EDITION OF THE UNIFORM BUILDING CODE, NATIONAL ELECTRICAL CODE, & ALL REQUIREMENTS OF THE VARIOUS GOVERNING AGENCIES.
27. ALL WORK IS TO BE COMPLETE, OPERABLE & ACCOMPLISHED IN A NEAT & WORKMANLIKE MANNER IN ACCORDANCE W/ THE BEST PRACTICES OF THE VARIOUS TRADES & TO THE SATISFACTION OF THE ARCHITECT AND/OR OWNER.
28. ALL FLOOR & WALL PENETRATIONS REQUIRED FOR PIPES, CONDUIT, ETC., SHALL BE SEALED TO STOP THE PASSAGE OF FIRE &/OR SMOKE AT RATED WALLS.
29. INSTALL ALL MANUFACTURED ITEMS, MATERIALS & EQUIPMENT IN STRICT ACCORDANCE W/ THE MANUFACTURER'S RECOMMENDED SPECIFICATIONS, UNLESS OTHERWISE SPECIFICALLY NOTED & APPROVED BY THE ARCHITECT.
30. FIRE SPRINKLERS ARE TO BE DESIGN/BUILD. THE BUILDING IS TO BE FULLY SPRINKLERED. ALL DESIGN COMPONENTS FOR A COMPLETE INSTALLATION SHALL MEET ALL CODE REQUIREMENTS. THE INSTALLATION SHALL MEET THE DESIGN INTENT OF THE DRAWINGS. NOTIFY ARCHITECT & GENERAL CONTRACTOR OF ANY DISCREPANCIES PRIOR TO INSTALLATION.
31. ALL FIRE RATED PARTITIONS INCLUDING TAPING & FINISHING OF GYPSUM BOARD FACES SHALL BE IN ACCORDANCE W/ MANUFACTURER DIRECTIONS FOR ACHIEVING SPECIFIED RATING. ALL OPENINGS, GAPS, ETC. SHALL BE FILLED W/ APPROVED FIRE SAFEING. ALL MECHANICAL/ELECTRICAL PENETRATIONS SHALL CONFORM TO ALL CODES GOVERNING SUCH PENETRATIONS.
32. PARTITIONS & CEILINGS SHALL BE PLUMB, LEVEL &/ OR TRUE TO INTENDED LINE IN ACCORDANCE W/ TOLERANCES IN THE PROJECT MANUAL OR THE RECOMMENDED TRADE STANDARD, WHICHEVER IS MORE STRINGENT.
33. PROVIDE ⅝" THICK TYPE 'X' GYPSUM BOARD BEHIND ELECTRICAL PANELS AS REQUIRED BY I.D. CODE.

DRAWING INDEX

–	COVER SHEET
GENERAL	
G1.01	GENERAL NOTES, INDEX AND LEGENDS
G1.02	PROJECT DATA AND EXITING DIAGRAM
CIVIL	
C1.01	GRADING AND DRAINAGE PLAN
C2.01	UTILITY AND HORIZONTAL CONTROL PLAN
ARCHITECTURAL	
AS1.01	SITE PLAN
A1.01	FLOOR PLAN
A2.01	BUILDING SECTIONS/WALL SECTIONS
A3.01	EXTERIOR ELEVATIONS
A3.02	EXTERIOR ELEVATIONS
A4.01	ROOF PLAN
A5.01	REFLECTED CEILING PLAN
A6.01	DETAILS
A6.02	DETAILS
A6.03	DETAILS
STRUCTURAL	
SN	GENERAL NOTES
S-1	FOUNDATION PLAN
S-1.1	FOUNDATION PLAN-ADDITIVE ALTERNATE 2
SD-1	DETAILS
MECHANICAL/PLUMBING	
MP1.0	INDEX, LEGEND, SCHEDULES, NOTES, DIAGRAMS
MP2.0	FLOOR PLAN
ELECTRICAL	
E1.01	LEGEND, ONELINE DIAGRAM
E1.02	LIGHTING, POWER AND COMMUNICATION, FIRE PLAN

PROJECT TEAM

ARCHITECT:	JVC ASSOCIATES INC. 4290 CAMERON STREET, SUITE 2 LAS VEGAS, NEVADA 89103 (702) 871-3416 FAX:(702) 871-2630 JIM VAN COMPERNOLLE, ARCHITECT ROY BURSON, PROJECT MANAGER
ELECTRICAL ENGINEERING:	TJ KROB CONSULTING ENGINEERS 7151 CASCADE VALLEY CT., SUITE 200 LAS VEGAS, NEVADA 89128 (702)871-3621 FAX:(702)871-8353 TOM KROB, P.E.
CIVIL ENGINEERING:	DWYER ENGINEERS 7310 SMOKE RANCH RD., SUITE E LAS VEGAS, NEVADA 89128 (702) 254-2200 FAX: (702) 254-2236 DAVID DWYER P.E.
STRUCTURAL ENGINEERING:	TKH CONSULTING ENGINEERS 5650 W. CHARLESTON BOULEVARD, SUITE 5 LAS VEGAS, NEVADA 89102 (702) 870-7086 FAX: (702) 870-0832 TIN-KEI HO, P.E.
MECHANICAL/PLUMBING ENGINEERING:	STRATEGIC ENGINEERING GROUP 2701 CRIMSON CANYON DRIVE, SUITE 120 LAS VEGAS, NEVADA 89128 (702) 240-3600 FAX: (702) 240-3636 THOMAS J. McGAHEY, P.E.

VICINITY MAP

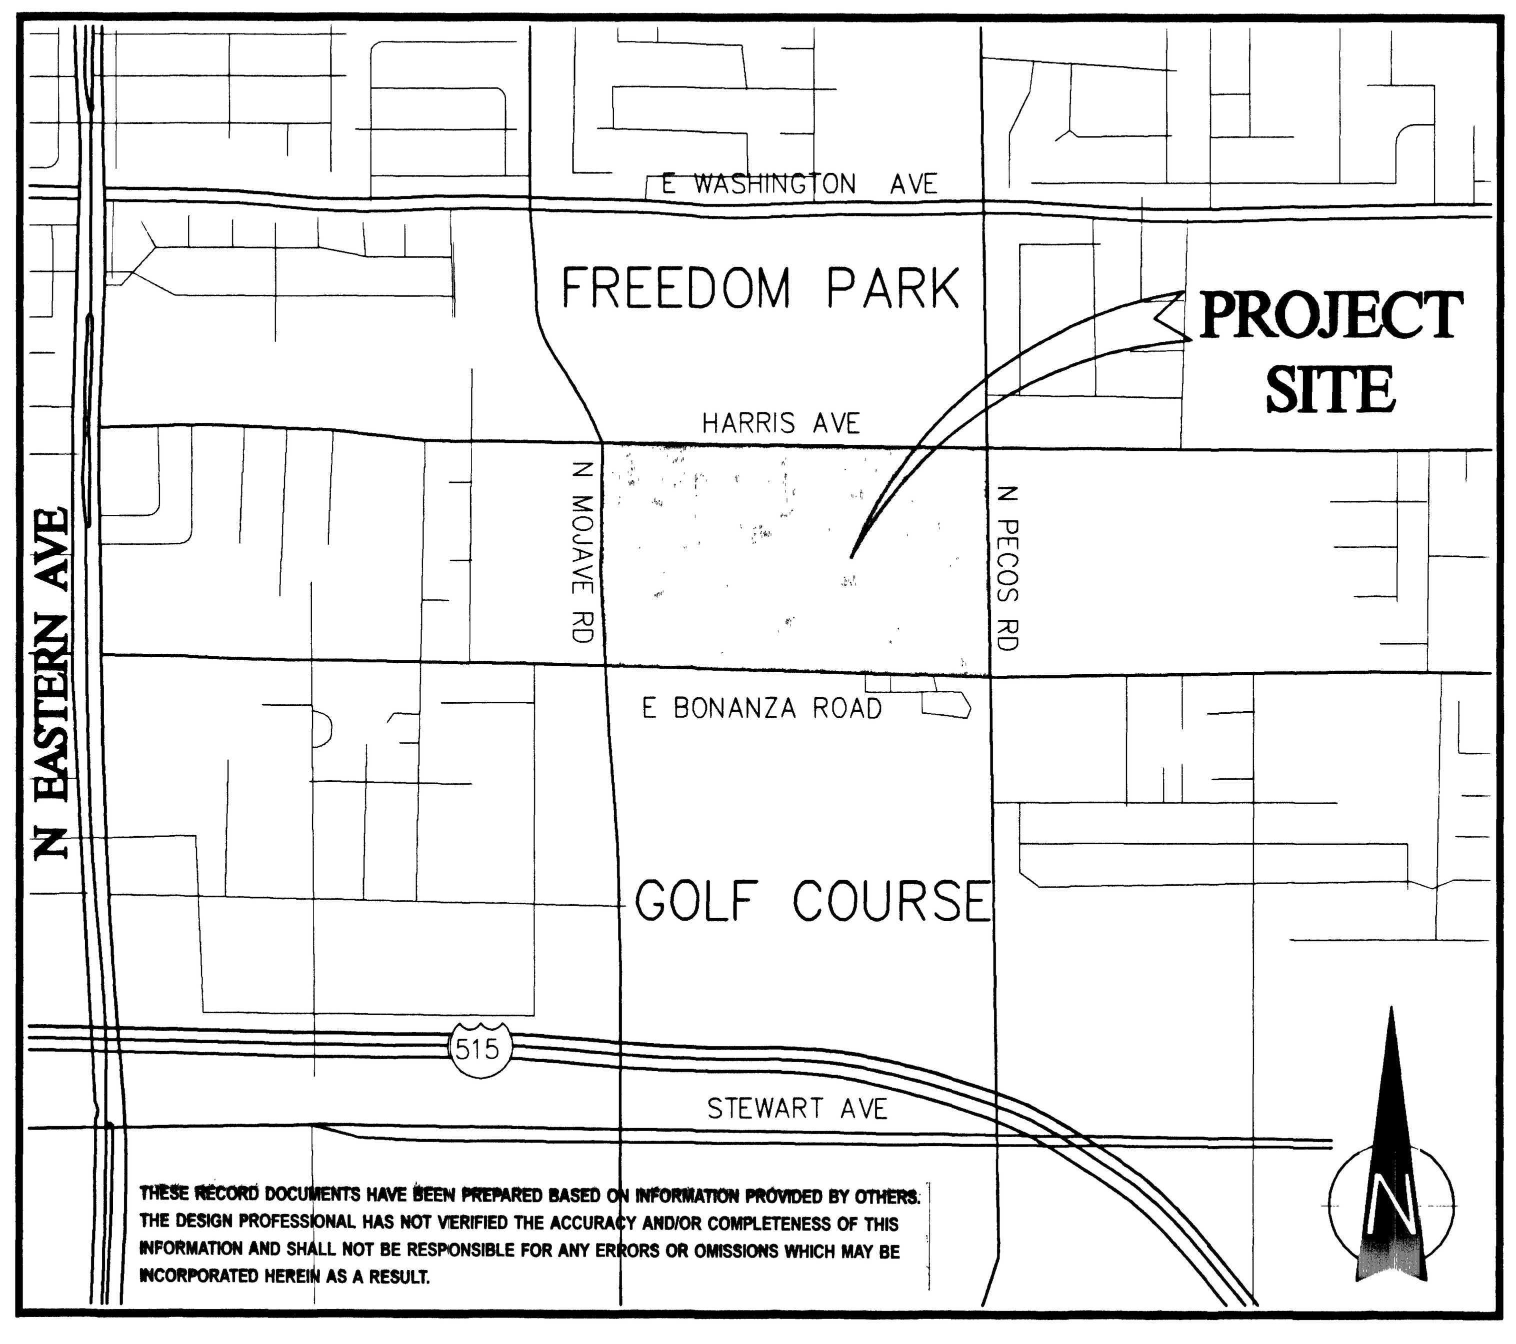

CITY OF LAS VEGAS NEVADA

DEPARTMENT OF PUBLIC WORKS

REVISIONS

CONSULTANT

JVC ASSOCIATES, INC.
ARCHITECTURE-PLANNING-INTERIORS
4290 CAMERON STREET, SUITE 2
LAS VEGAS, NEVADA 89103
TELEPHONE: 702-871-3416
FAX: 702-871-2630

© JVC ASSOCIATES, INC. 2001

A NEW CITY OF LAS VEGAS PROJECT:
EAST YARD TRANSFER STATION
BONANZA AND MOJAVE
LAS VEGAS, NEVADA

STAMP

OWNER: CITY OF LAS VEGAS
DEPARTMENT OF PUBLIC WORKS
ARCHITECTURAL SERVICES

400 EAST STEWART AVENUE
LAS VEGAS, NEVADA 89101
PHONE: (702) 229-6535
FAX: (702) 382-3232
TDD: (702) 386-9108

DRAWN	RAA
CHECK	JVC
FILE	-
DATE	08-24-01
SCALE	-
BID NO	01.15301.19
CLV DWG NO	513.66
SHT NO	G1.01

DRAWINGS AS INSTRUMENTS OF SERVICE ARE THE PROPERTY OF THE DESIGN PROFESSIONAL WHOSE STAMP OF CERTIFICATION APPEARS ON THE DRAWINGS AND SPECIFICATIONS ANY USE OR REPRODUCTION IN WHOLE OR IN PART WITHOUT WRITTEN CONSENT IS STRICTLY PROHIBITED COPIES OF THE DRAWINGS AND SPECIFICATIONS RETAINED BY THE CLIENT MAY BE UTILIZED ONLY FOR OCCUPYING THE PROJECT FOR WHICH THEY WERE PREPARED AND NOT FOR THE CONSTRUCTION OF ANY OTHER PROJECT N A C 623.780