

**FOUNDATION PLAN - ADDITIVE ALTERNATE**

SCALE: 1/8" = 1'-0"

**IMPORTANT**  
 THESE PLANS ARE SUBJECT TO CITY/COUNTY PLANS/CHECK CORRECTIONS. GENERAL CONTRACTOR AND ALL SUBCONTRACTORS TO VERIFY THAT THEY ARE IN POSSESSION OF THE LATEST CITY/COUNTY APPROVED DRAWINGS PRIOR TO FINALIZING CONTRACT, PURCHASE, FABRICATION, AND INSTALLATION OF ALL BUILDING COMPONENTS & SYSTEMS.

**TKH**  
 TKH Consulting Engineers  
 5650 W. Charleston Blvd.  
 Suite 5  
 Las Vegas  
 NV 89146  
 Phone (702) 870-7086  
 Fax (702) 870-0832


REVISIONS		
NO.	DATE	BY

THESE RECORD DOCUMENTS HAVE BEEN PREPARED BASED ON INFORMATION PROVIDED BY OTHERS. THE DESIGN PROFESSIONAL HAS NOT VERIFIED THE ACCURACY AND/OR COMPLETENESS OF THIS INFORMATION AND SHALL NOT BE RESPONSIBLE FOR ANY ERRORS OR OMISSIONS WHICH MAY BE INCORPORATED HEREIN AS A RESULT.

**SLAB ON GRADE**  
 6" CONC. SLAB W/ #3 @ 18" O.C. EACH WAY • MID-DEPTH OVER 2" SAND OVER 6 MIL. VISQUEEN MEMBRANE OVER 4" TYPE II OVER PREPARED SOIL PER SOIL REPORT  
 CONTRACTORS SHALL VERIFY ALL GRADING REQUIREMENTS PER SOIL REPORT ARE MET PRIOR TO CONSTRUCTION

SPREAD FOOTING SCHEDULE	
F1	5'-6" SQ X 30" THICK FOOTING W/ (6) #5 EACH WAY T. & B.
F2	3'-6" SQ X 30" THICK FOOTING W/ (4) #5 EACH WAY T. & B.

ANCHOR BOLT SCHEDULE				
TYPE	DIAMETER	LENGTH	PROJECTION	DETAIL
AB1	1 1/4"	21"	3"	(A)
AB2	1"	18"	2"	(A)
AB3	3/4"	18"	2"	(A)
AB4	3/4"	14"	2"	(B)

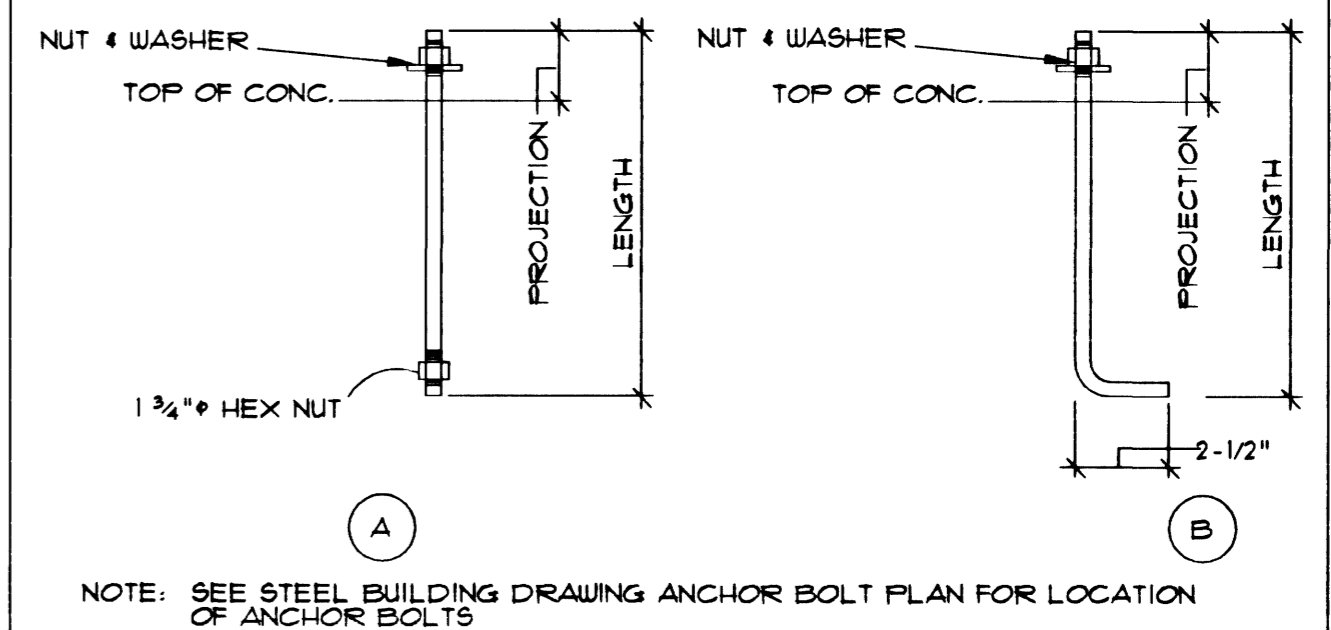

**EAST YARD TRANSFER STATION  
 FOR THE CITY OF LAS VEGAS  
 NEC BONANZA ROAD AND MOJAVE ROAD  
 LAS VEGAS, NEVADA**  
**FOUNDATION PLAN - ADDITIVE ALTERNATE**

DATE: 2-18-02  
 DRAWN BY:  
 CHECKED BY: TKH  
 PROJECT NO.: 533201

SHEET NO.:  
**S-11**