



REVISIONS
 ARCH'L REVISIONS 1/19/01

CONSULTANT
 JOB # 20 25405

DEPARTMENT OF PUBLIC WORKS

Dexter Park - Rehab
 - Restroom Facility (Prototype One) -

FOUNDATION PLAN,
 ROOF FRAMING PLAN

DEPARTMENT OF PUBLIC WORKS
 ARCHITECTURAL SERVICES

400 EAST STEWART AVENUE
 LAS VEGAS, NEVADA 89101
 PHONE: (702) 229-6335
 FAX: (702) 386-9338
 TDD: (702) 386-9108

ARCHITECT
 RICHARD DANIELSON, AIA, NCARB

DRAWN: J.L.J.

FILE:

DATE: 1/28/01


SCALE: 2'-2"

PROJECT: Dexter Park

SHT NO:

RR-S1

650-16-11

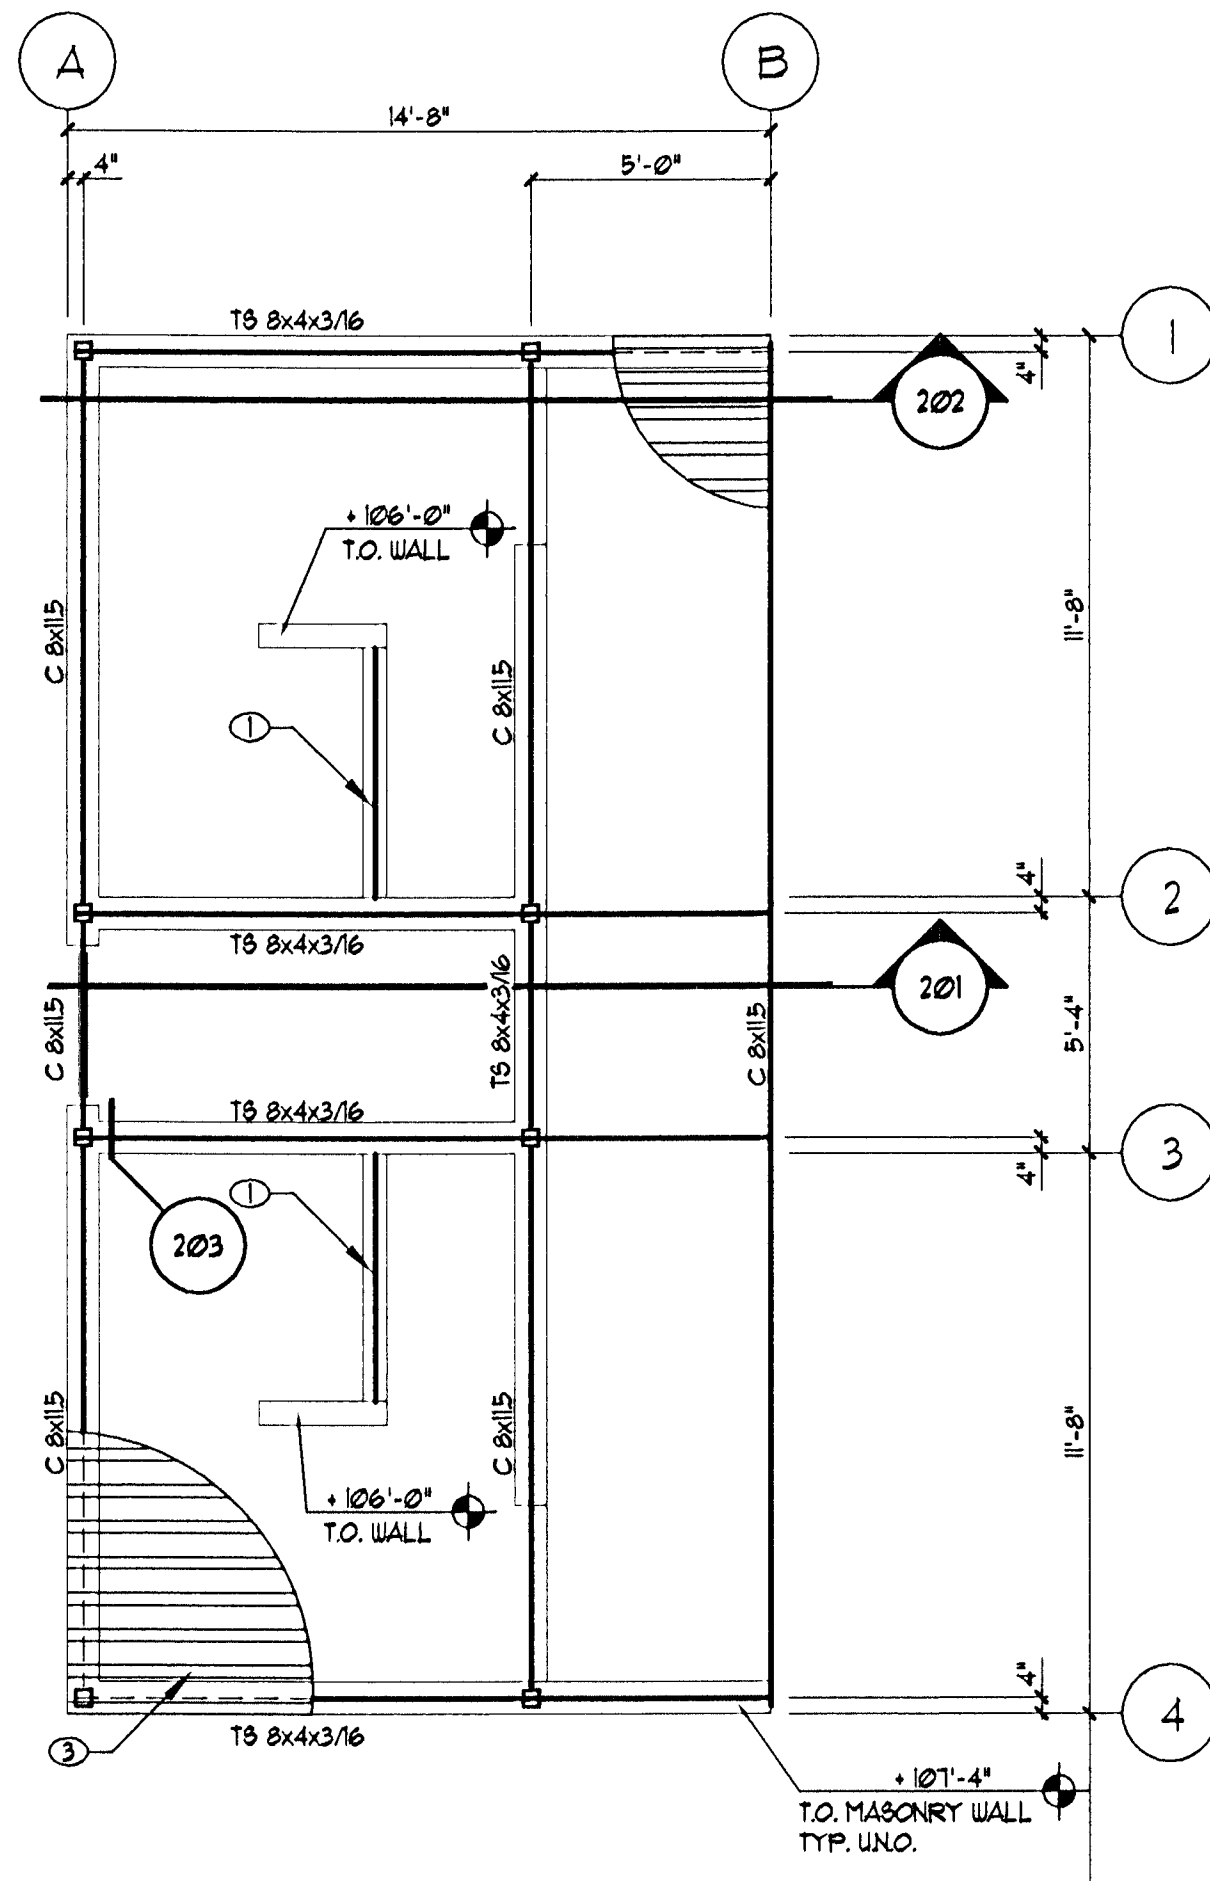

FRAMING PLAN KEYNOTES


- ① MASONRY LINTEL PER GENERAL STRUCTURAL NOTES
- ② T8 4x4x3/16 COLUMN, TYPICAL (3)
- ③ 3"x6A TYPE N STEEL DECK (MILCRAFT 3N8 OR EQUAL), ATTACH PER G.S.N.

FRAMING PLAN NOTES

- A. SEE ARCH'L FOR ROOF ELEVATIONS
- B. SEE ARCH'L DRAWINGS FOR IN-FILL FRAMING

ROOF FRAMING PLAN

SCALE: 1/4" = 1'-0"

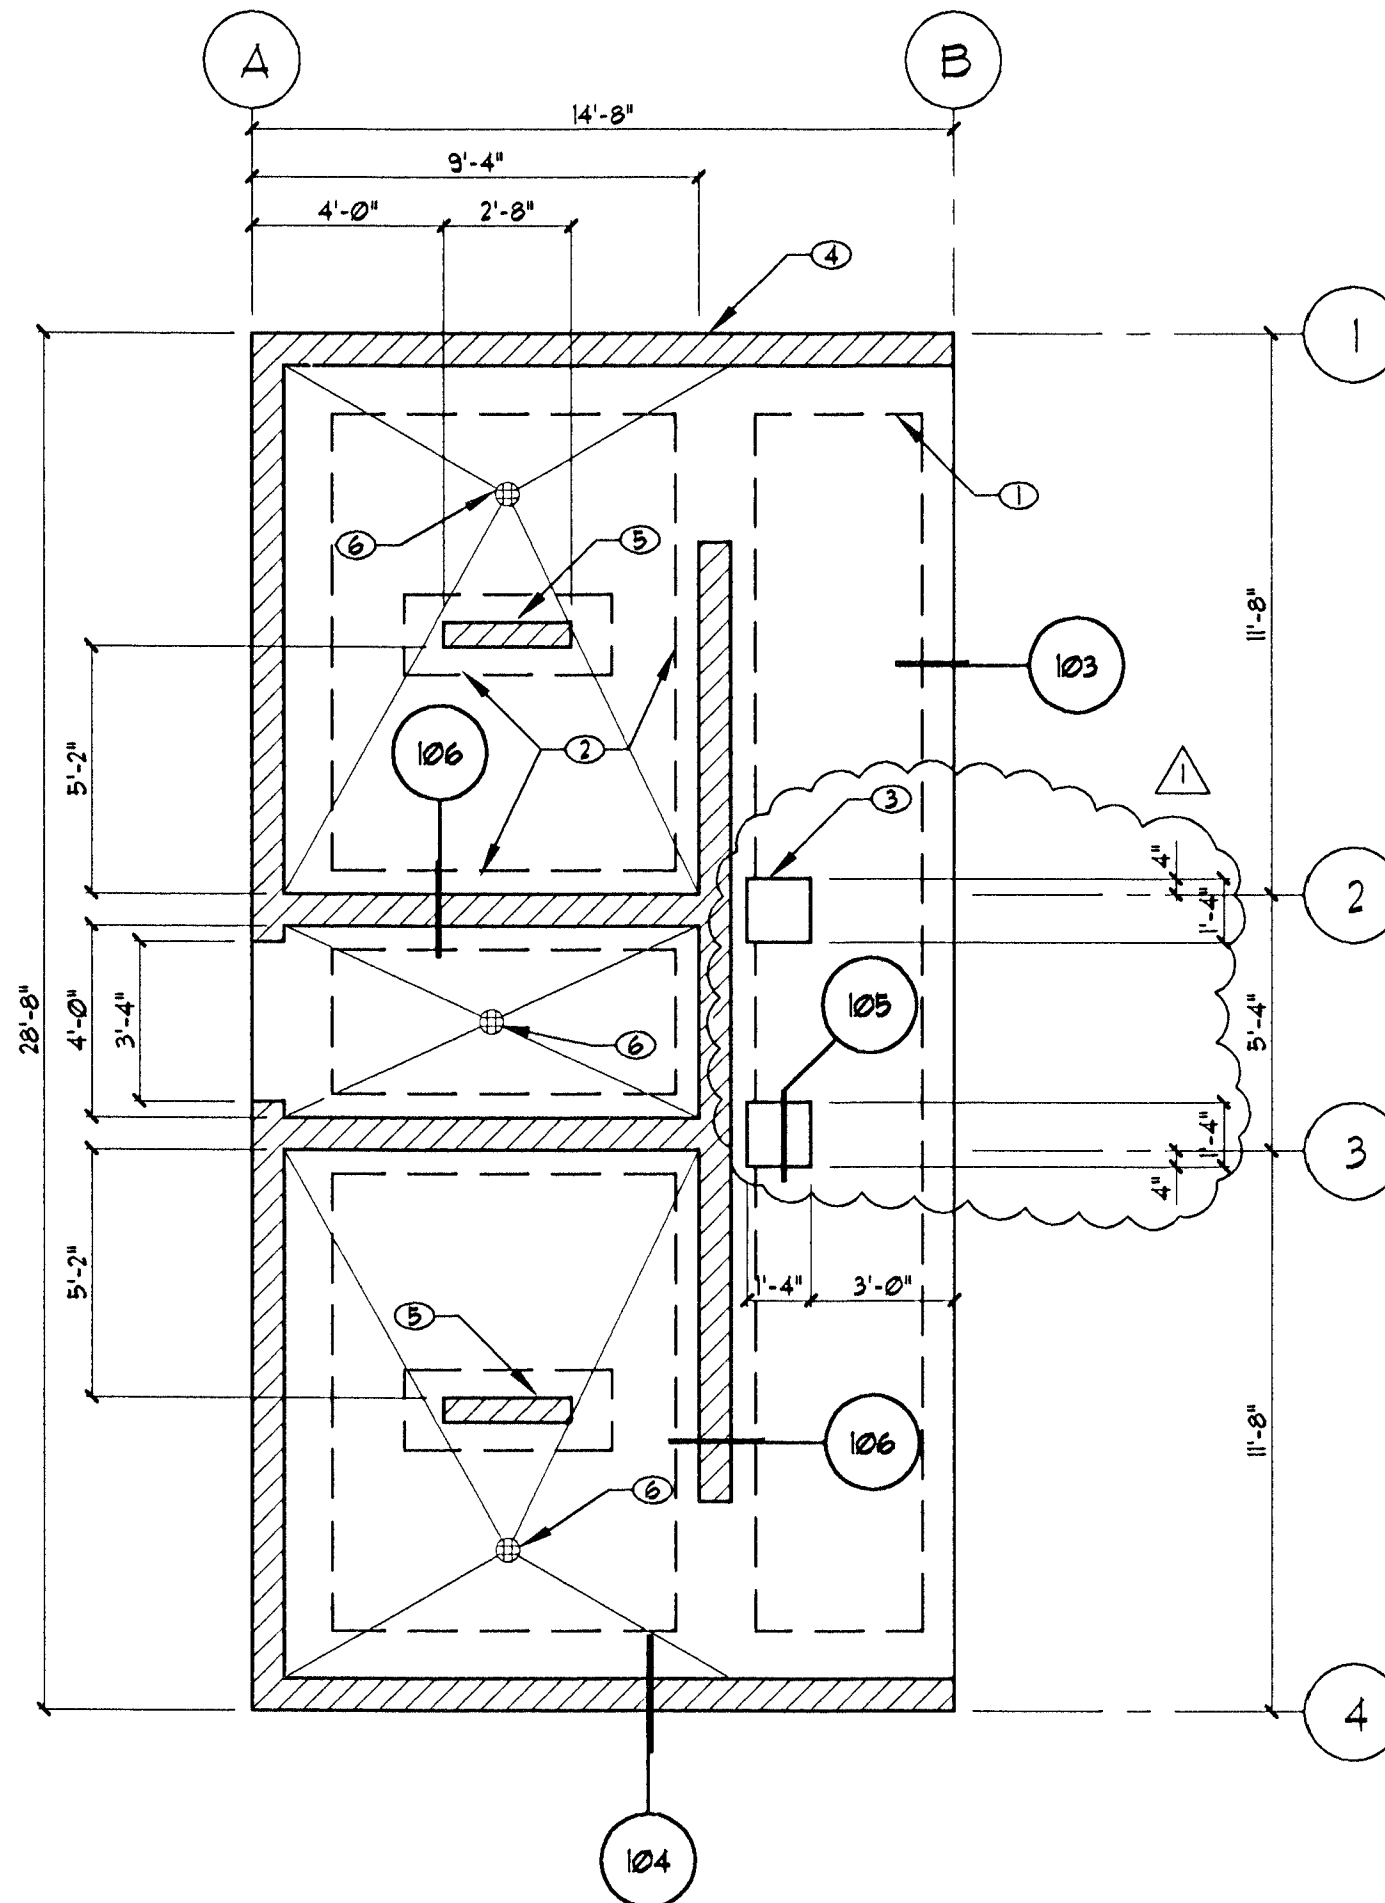

FOUNDATION PLAN KEYNOTES

- ① 1'-8" WIDE x 12" THICK x CONT. FOOTING W/ (2) #4 CONT. TOP & BOTTOM TYP. AT PERIMETER WALLS
- ② 1'-8" WIDE x 12" THICKENED SLAB W/ (2) #4 CONT. TOP & BOTTOM TYP. AT INTERIOR WALLS
- ③ CONCRETE SEAT PER DETAIL 105
- ④ 8" CMU WALL, REINFORCE PER GENERAL STRUCTURAL NOTES, TYPICAL UNO.
- ⑤ 6" CMU WALL, REINFORCE PER GENERAL STRUCTURAL NOTES, TYPICAL UNO.
- ⑥ FLOOR DRAIN PER ARCHITECTURAL


FOUNDATION PLAN NOTES

- A. VERIFY ALL DIMENSIONS PRIOR TO CONSTRUCTION. RESOLVE DISCREPANCIES WITH ARCHITECT.
- B. VERIFY LOCATION OF ALL INSERTS IN SLAB WITH ARCH'L, MECH, PLUMBING, AND ELECT. PRIOR TO CONSTRUCTION.
- C. FINISH FLOOR ELEVATION = 102'-0" UNO. SLOPE TO DRAIN PER ARCHITECTURAL.
- D. CONCRETE SLAB SHALL BE 4" THICK OVER APPROVED SUBGRADE PER G.S.N. REINFORCE WITH 6 x 6 - W4 x W4 x W4F. PROVIDE (2) #4 x 48" MID HEIGHT SLAB BARS ADJACENT TO ALL DISCONTINUOUS JOINTS AND AT SQUARE CORNERS OF SLAB OPENINGS, STEPS, FOUR JOINTS, ETC.
- E. INSTALL SLAB CONTROL JOINTS PER TYP. DETAIL WHERE SHOWN ON ARCH'L FLOOR PLAN.
- F. FOR TYPICAL DETAILS OF PIPE THRU FOOTINGS AND TRENCHES ADJACENT TO FOOTINGS SEE DETAIL 101.

FOUNDATION PLAN

SCALE: 1/4" = 1'-0"

WRIGHT
 STRUCTURAL ENGINEERS, INC
 7310 Smoke Ranch Road, Suite P Las Vegas, NV 89128
 (702) 233-6400 Fax (702) 233-1164 www.wrightengco.com

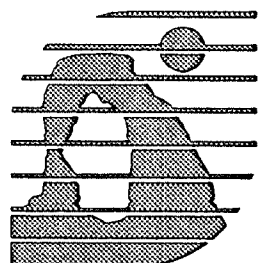

DRAWINGS AND SPECIFICATIONS OF SERVICE ARE THE PROPERTY OF THE DESIGN PROFESSIONAL WHOSE STAMP OF CERTIFICATION APPEARS ON THE DRAWINGS AND SPECIFICATIONS. UNLESS OTHERWISE SPECIFIED, THESE DRAWINGS AND SPECIFICATIONS ARE THE PROPERTY OF THE DESIGN PROFESSIONAL WHOSE STAMP OF CERTIFICATION APPEARS ON THE DRAWINGS AND SPECIFICATIONS.