
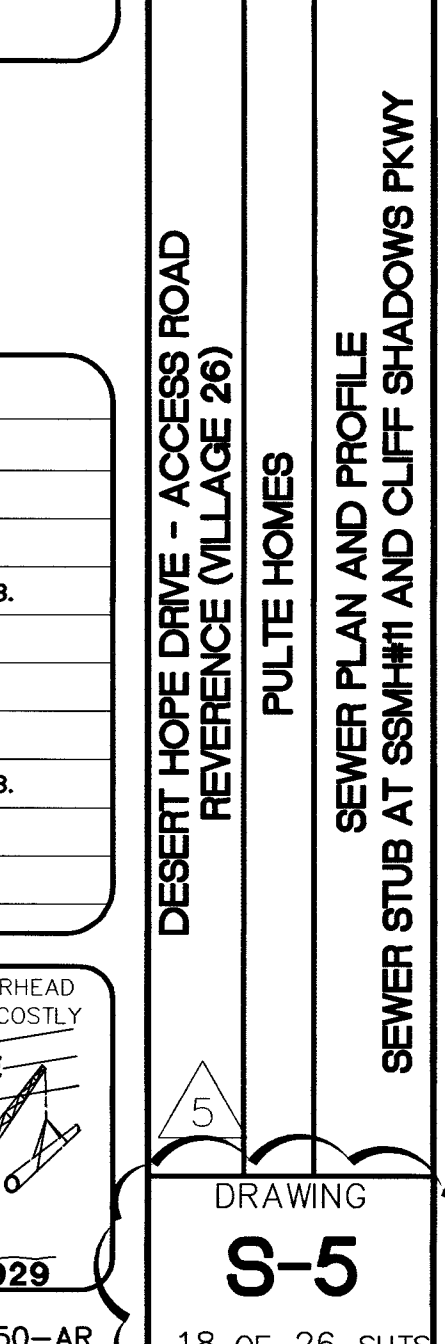
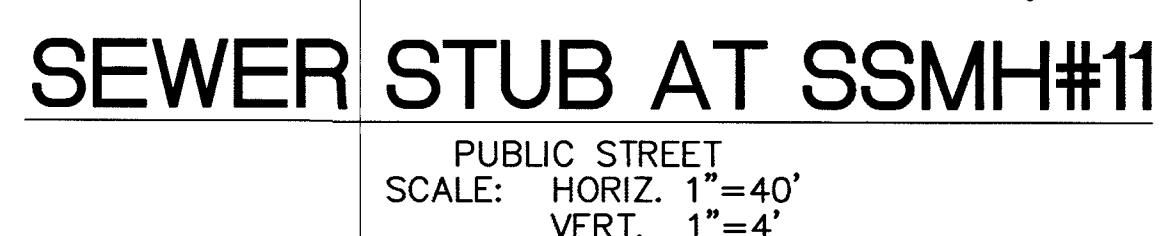
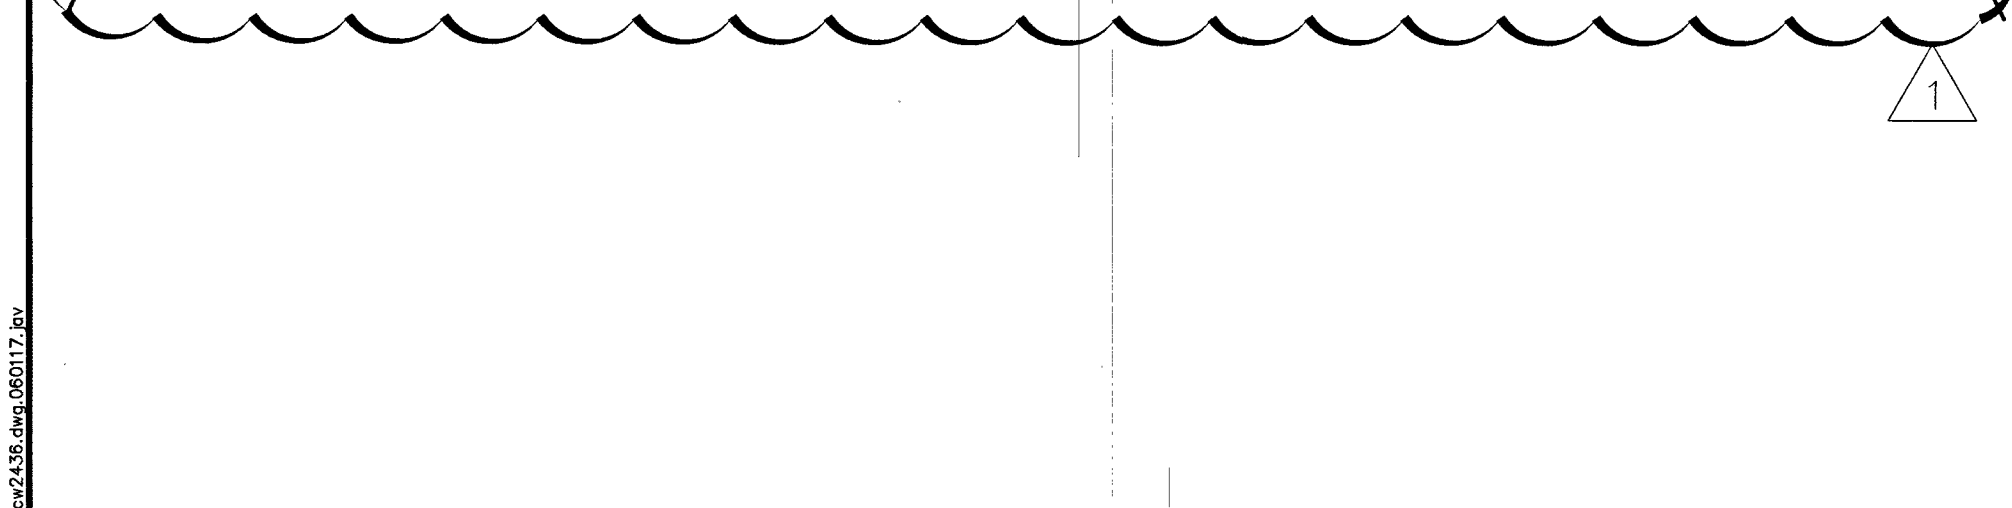


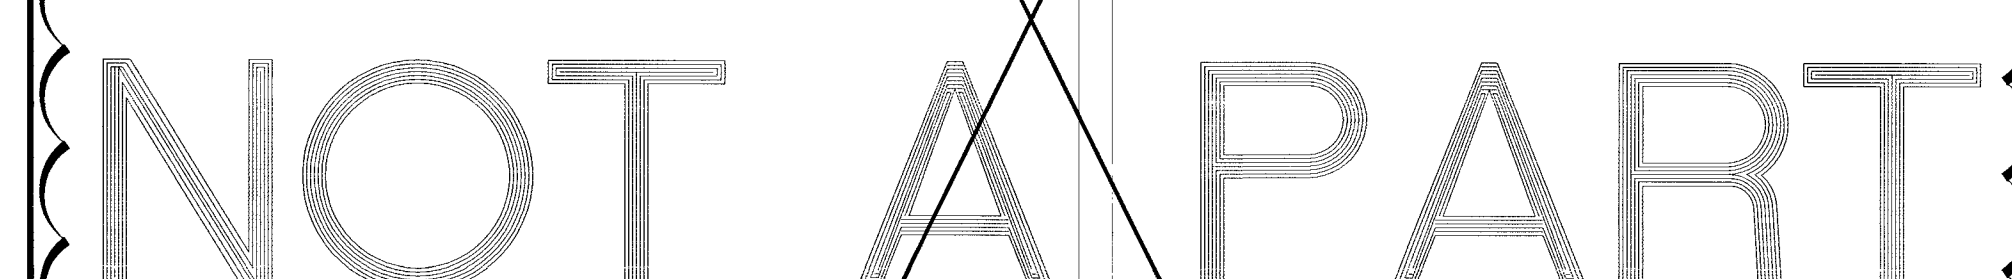

42 18929 CIV DRAWING NO 107Y4950-AR