



E:\Hill Clark Files\HCA Current Projects\1534 Nadel - DC Plaza\autocad\Planting Plan.dwg

ALL DRAWINGS AND WRITTEN MATERIAL APPEARING HEREIN CONSTITUTE THE ORIGINAL AND UNPUBLISHED WORK OF THE ARCHITECT AND THE SAME MAY NOT BE DUPLICATED, USED OR DISCLOSED WITHOUT THE WRITTEN CONSENT OF THE ARCHITECT. Copyright © 2016, NADEL STUDIO ONE INC. ALL RIGHTS RESERVED.

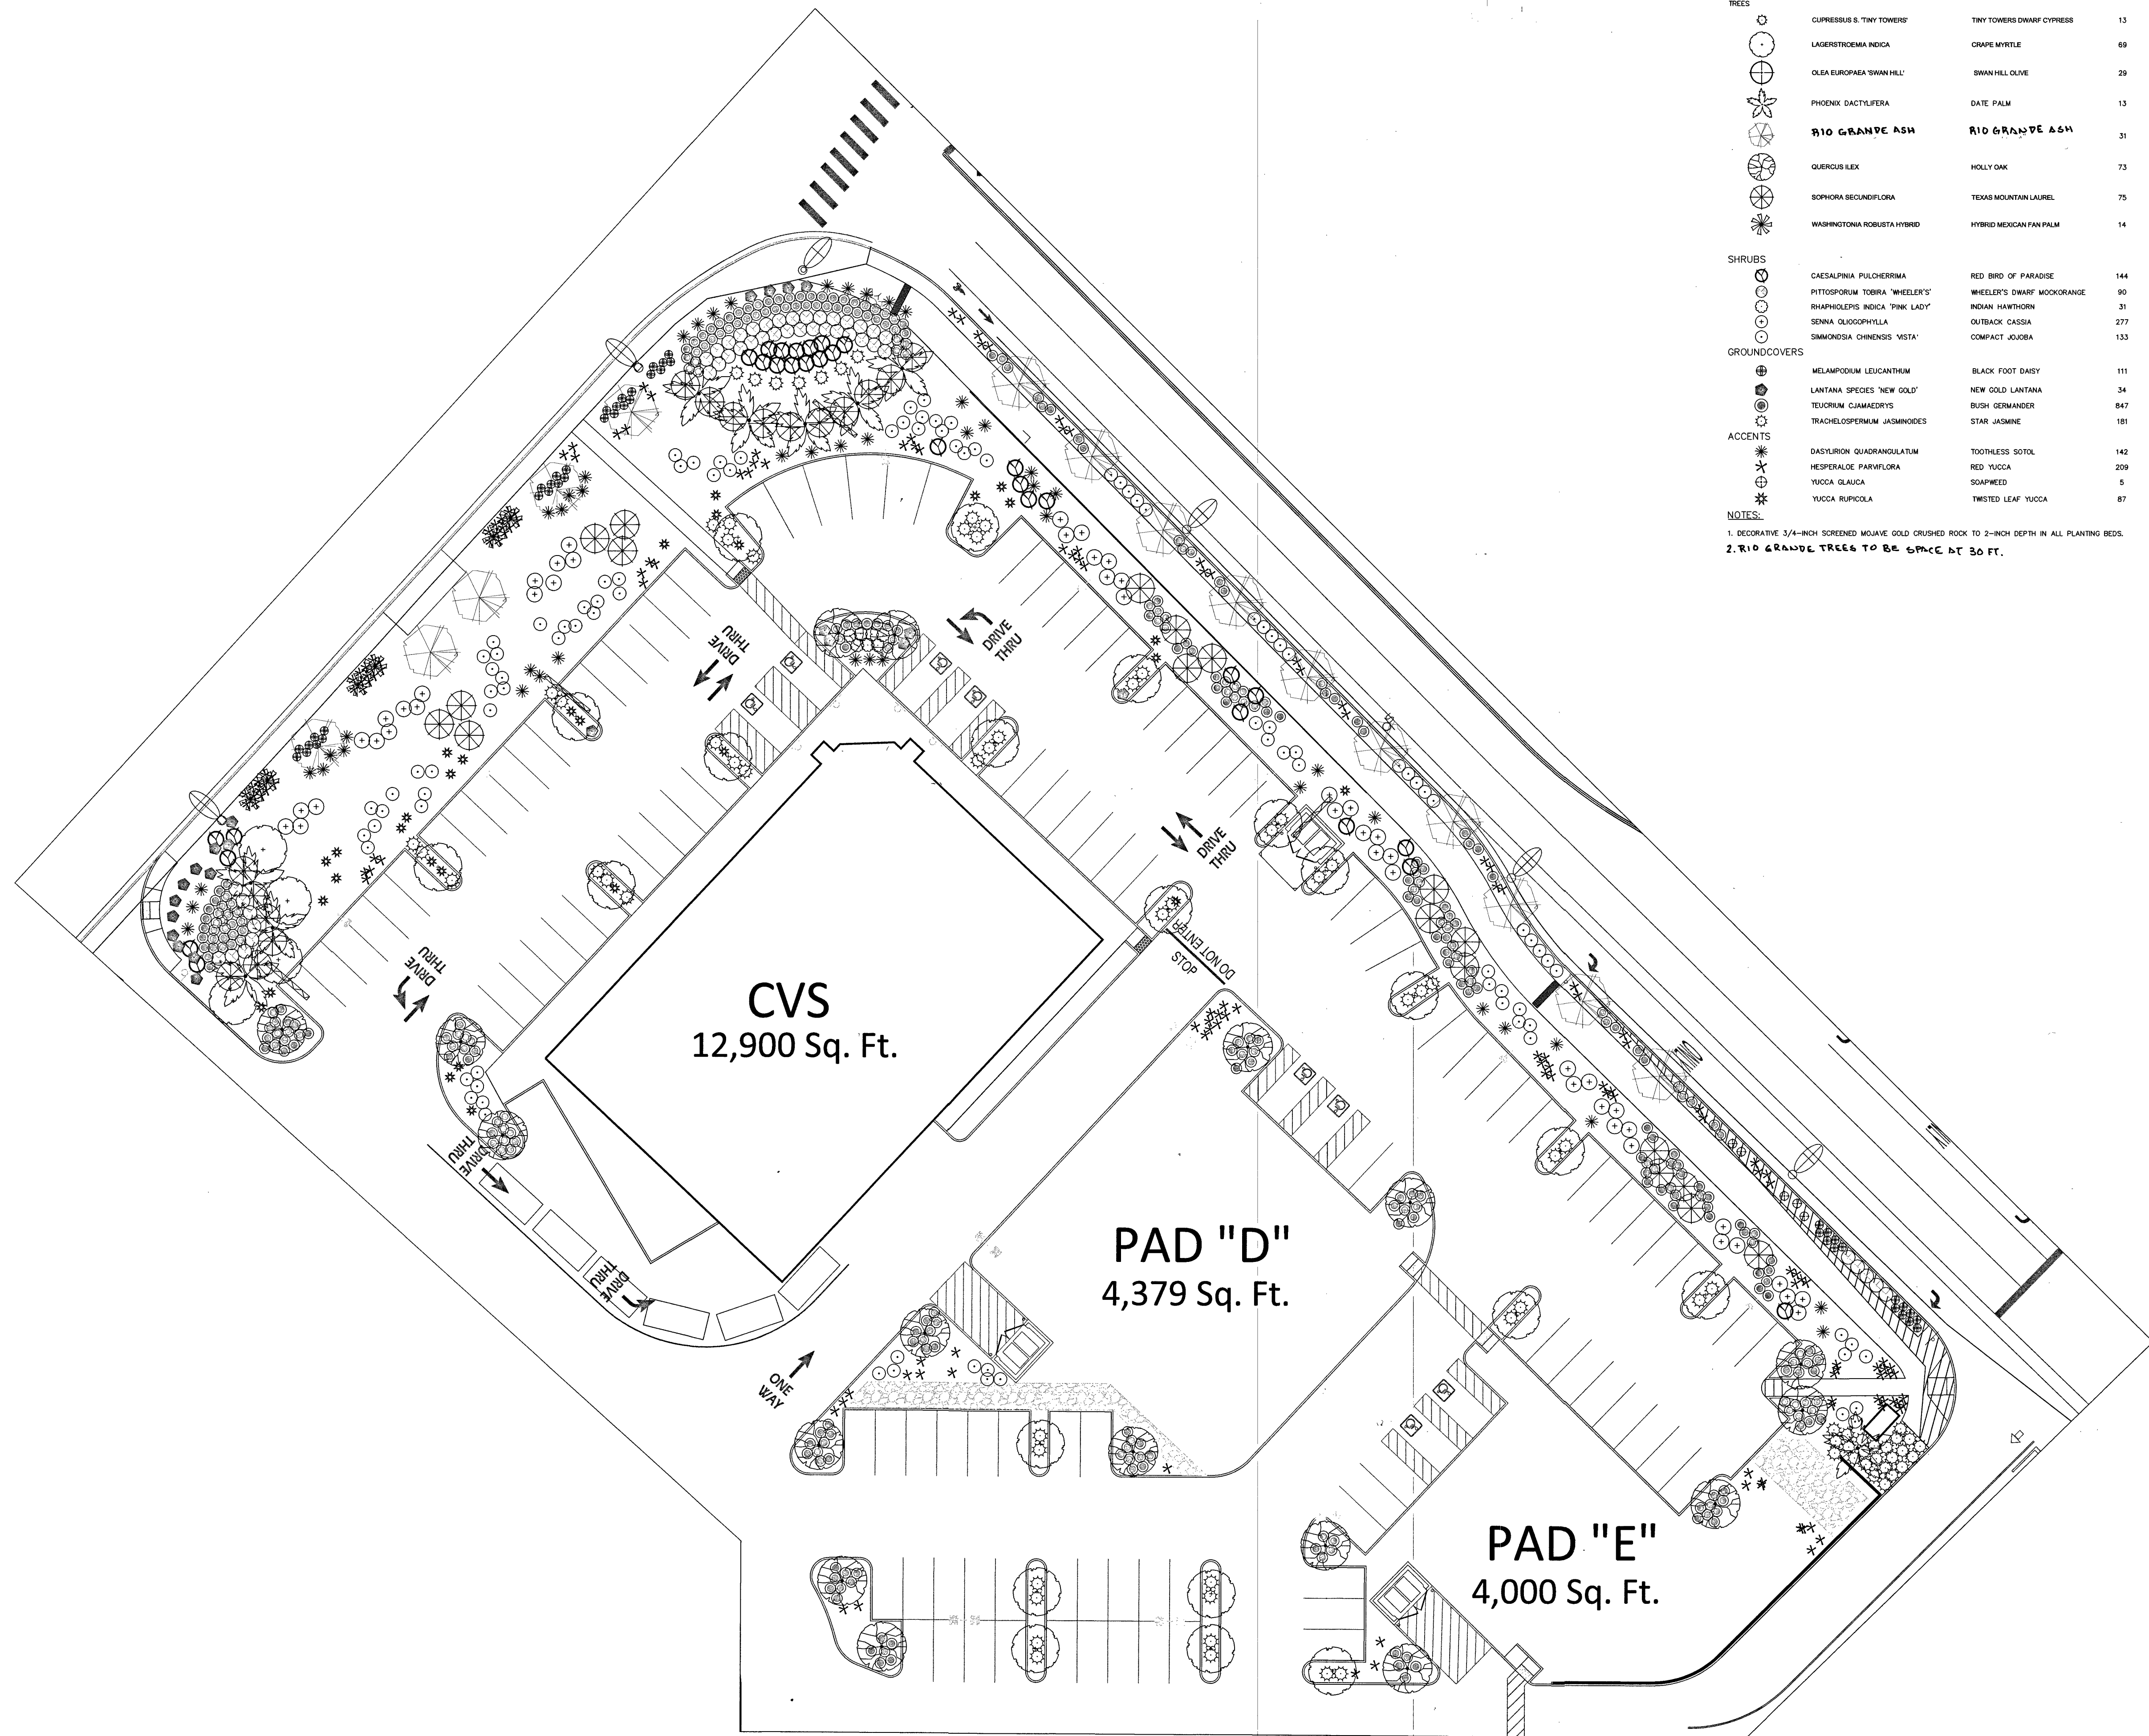


PLANT SCHEDULE SYMBOL	BOTANICAL NAME	COMMON NAME	QTY.	SIZE	REMARKS
TREES					
	CUPRESSUS S. 'TINY TOWERS'	TINY TOWERS DWARF CYPRESS	13	15 GAL	STANDARD TRUNK
	OLEA EUROPAEA 'SWAN HILL'	SWAN HILL OLIVE	29	36" BOX	MULTI-TRUNK (3 TO 4 TRUNKS)
	PHOENIX DACTYLIFERA	DATE PALM	13	20" BROWN TRUNK	SHOVEL CUT STRAIGHT AND EVEN TRUNKS
	RIO GRANDE ASH	RIO GRANDE ASH	31	24" BOX	STANDARD TRUNK
	QUERCUS ILEX	HOLLY OAK	73	24" BOX	STANDARD TRUNK
	SOPHORA SECUNDIFLORA	TEXAS MOUNTAIN LAUREL	75	24" BOX	MULTI-TRUNK (3 TO 4 TRUNKS)
	WASHINGTONIA ROBUSTA HYBRID	HYBRID MEXICAN FAN PALM	14	18" BROWN TRUNK	ALL TRUNKS ARE TO BE SKINNED STRAIGHT AND EVEN
SHRUBS					
	CAESALPINIA PULCHERRIMA	RED BIRD OF PARADISE	144	5 GAL	
	PITTOSPORIUM TOBIRA 'WHEELER'S'	WHEELER'S DWARF MOCKORANGE	90	5 GAL	
	RHAPHIOLEPS INDICA 'PINK LADY'	INDIAN HAWTHORN	31	5 GAL	
GROUNDCOVERS					
	LANTANA SPECIES 'NEW GOLD'	NEW GOLD LANTANA	34	5 GAL	
	TEUORIUM CLAMAEADRY'S	BUSH GERMANDER	847	5 GAL	
	TRACHELOSPERMUM JASMINOIDES	STAR JASMINE	181	5 GAL	
ACCENTS					
	DASYLIRON QUADRANGULATUM	TOOTHLESS SOTOL	142	5 GAL	
	HESPERALOE PARVIFLORA	RED YUCCA	209	5 GAL	
	YUCCA GLAUCA	SOAPWEED	5	5 GAL	
	YUCCA RUPICOLA	TWISTED LEAF YUCCA	87	5 GAL	
NOTES					
					1. DECORATIVE 3/4-INCH SCREENED MOJAVE GOLD CRUSHED ROCK TO 2-INCH DEPTH IN ALL PLANTING BEDS.
					2. RIO GRANDE TREES TO BE PLACED AT 30 FT.

PLANTING PLAN

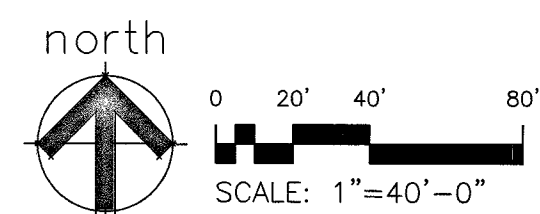

NADEL

NADEL NEVADA INC
175 E. WARM SPRINGS ROAD
SUITE 100
LAS VEGAS, NV 89119
T. 702.896.2000
F. 702.896.7170
WWW.NADELARC.COM
LOS ANGELES
COSTA MESA
SAN DIEGO
LAS VEGAS

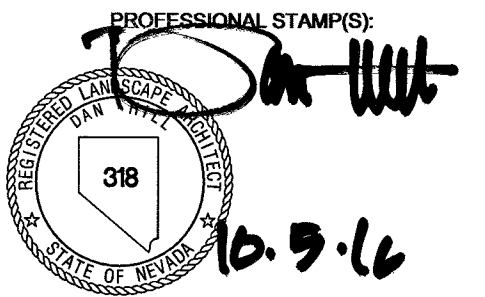

HILL CLARK & ASSOCIATES
LANDSCAPE ARCHITECTURE

94 Megan Drive
Henderson, NV 89074
P: (702) 358-8700

CLIENT:
FARM AND DURANGO
INVESTORS, LLC.
848 N. RAINBOW BOULEVARD
#5465
LAS VEGAS, NV 89107
11.05.2015

CLIENT PROJECT NO:
PROJECT:
DC PLAZA

FARM RD. AND N. DURANGO DR.
LAS VEGAS, NV 89143

PUBLIC AGENCY SUBMITTAL: N/A
ISSUED FOR BIDDING: N/A
ISSUED FOR CONSTRUCTION: N/A

REVISIONS:
ISSUE NO.: DESCRIPTION: ISSUE DATE:

NADEL PROJECT NO: 15141
PROJECT DATE: 07.26.2016
ISSUE DATE:

PLANTING PLAN

L 2.02
107V6734 H# 64486

BD SUBMITTAL SET