


NADEL NEVADA INC

175 E. WARM SPRINGS ROAD
SUITE 100
LAS VEGAS, NV 89119
T. 702.896.2000
F. 702.896.7170
WWW.NADELARC.COM

LOS ANGELES
COSTA MESA
SAN DIEGO
LAS VEGAS

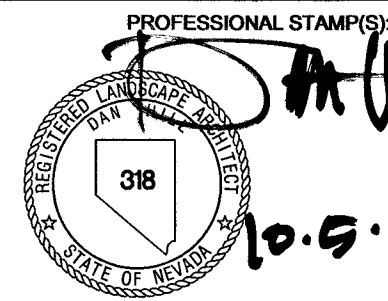

CONSULTANT:



94 Megan Drive
Henderson, NV 89074
P: (702) 358-8700

CLIENT:

FARM AND DURANGO
INVESTORS, LLC.

848 N. RAINBOW BOULEVARD
#5465
LAS VEGAS, NV 89107
11.05.2015

CLIENT PROJECT No

PROJECT:

DC PLAZA

FARM RD. AND N. DURANGO DR.
LAS VEGAS, NV 89143

PUBLIC AGENCY SUBMITTAL: N/A
ISSUED FOR BIDDING: N/A
ISSUED FOR CONSTRUCTION: N/A

REVISIONS:
ISSUE DESCRIPTION: ISSUE DATE:
NO.:

BD SUBMITTAL SET

NADEL PROJECT No: 15141
PROJECT DATE: 07.26.2016


DRAWING TITLE:

PLANTING PLAN

L 2.03
107V6734 H# 64486

PLANT SYMBOL	BOTANICAL NAME	COMMON NAME	QTY.	SIZE	REMARKS
TREES					
	CUPRESSUS S. 'TINY TOWERS'	TINY TOWERS DWARF CYPRESS	13	15 GAL	STANDARD TRUNK
	LAGERSTROEMIA INDICA	GRAPE MYRTLE	69	24" BOX	STANDARD TRUNK
	OLEA EUROPAEA 'SWAN HILL'	SWAN HILL OLIVE	29	30" BOX	MULTI-TRUNK (3 TO 4 TRUNKS)
	PHOENIX DACTYLIFERA	DATE PALM	13	20' BROWN TRUNK	SHOVEL CUT STRAIGHT AND EVEN TRUNKS
	RIO GRANDE DSH	RIO GRANDE ASH	31	24" BOX	STANDARD TRUNK
	QUERCUS ILEX	HOLLY OAK	73	24" BOX	STANDARD TRUNK
	SOPHORA BECUNDFLORA	TEXAS MOUNTAIN LAUREL	75	24" BOX	MULTI-TRUNK (3 TO 4 TRUNKS)
	WASHINGTONIA ROBUSTA HYBRID	HYBRID MEXICAN FAN PALM	14	18' BROWN TRUNK	ALL TRUNKS ARE TO BE SKINNED STRAIGHT AND EVEN
SHRUBS					
	CAESALPINIA PULCHERRIMA	RED BIRD OF PARADISE	144	5 GAL	
	PITTOSPORUM TOBIRA 'WHEELER'S'	WHEELER'S DWARF MOCKORANGE	90	5 GAL	
	RHAPHIOLEPS INDICA 'PINK LADY'	INDIAN HAWTHORN	31	5 GAL	
	SENNIA OLIGOPHYLLA	OUTBACK CASSIA	277	5 GAL	
	SMILAX CHINENSIS 'VISTA'	COMPACT JOJOBA	133	5 GAL	
GROUNDCOVERS					
	MELAMPYRUM LEUCANTHEMUM	BLACK FOOT DAISY	111	5 GAL	
	LANTANA SPECIES 'NEW GOLD'	NEW GOLD LANTANA	34	5 GAL	
	TEUCRIUM CJAMAEADRYIS	BUSH GERMANDER	847	5 GAL	
	TRACHELOSPERMUM JASMINOIDES	STAR JASMINE	181	5 GAL	
ACCENTS					
	DASYLIRION QUADRANGULATUM	TOOTHLESS SOTOL	142	5 GAL	
	HESPERALOE PARVIFLORA	RED YUCCA	209	5 GAL	
	YUCCA GLAUCA	SOAPWEED	5	5 GAL	
	YUCCA RUPICOLA	TWISTED LEAF YUCCA	87	5 GAL	

NOTES:
1. DECORATIVE 3/4-INCH SCREENED MUAWE GOLD CRUSHED ROCK TO 2-INCH DEPTH IN ALL PLANTING BEDS.
2. RIO GRANDE TREE TO BE SPACE AT 30 FT.

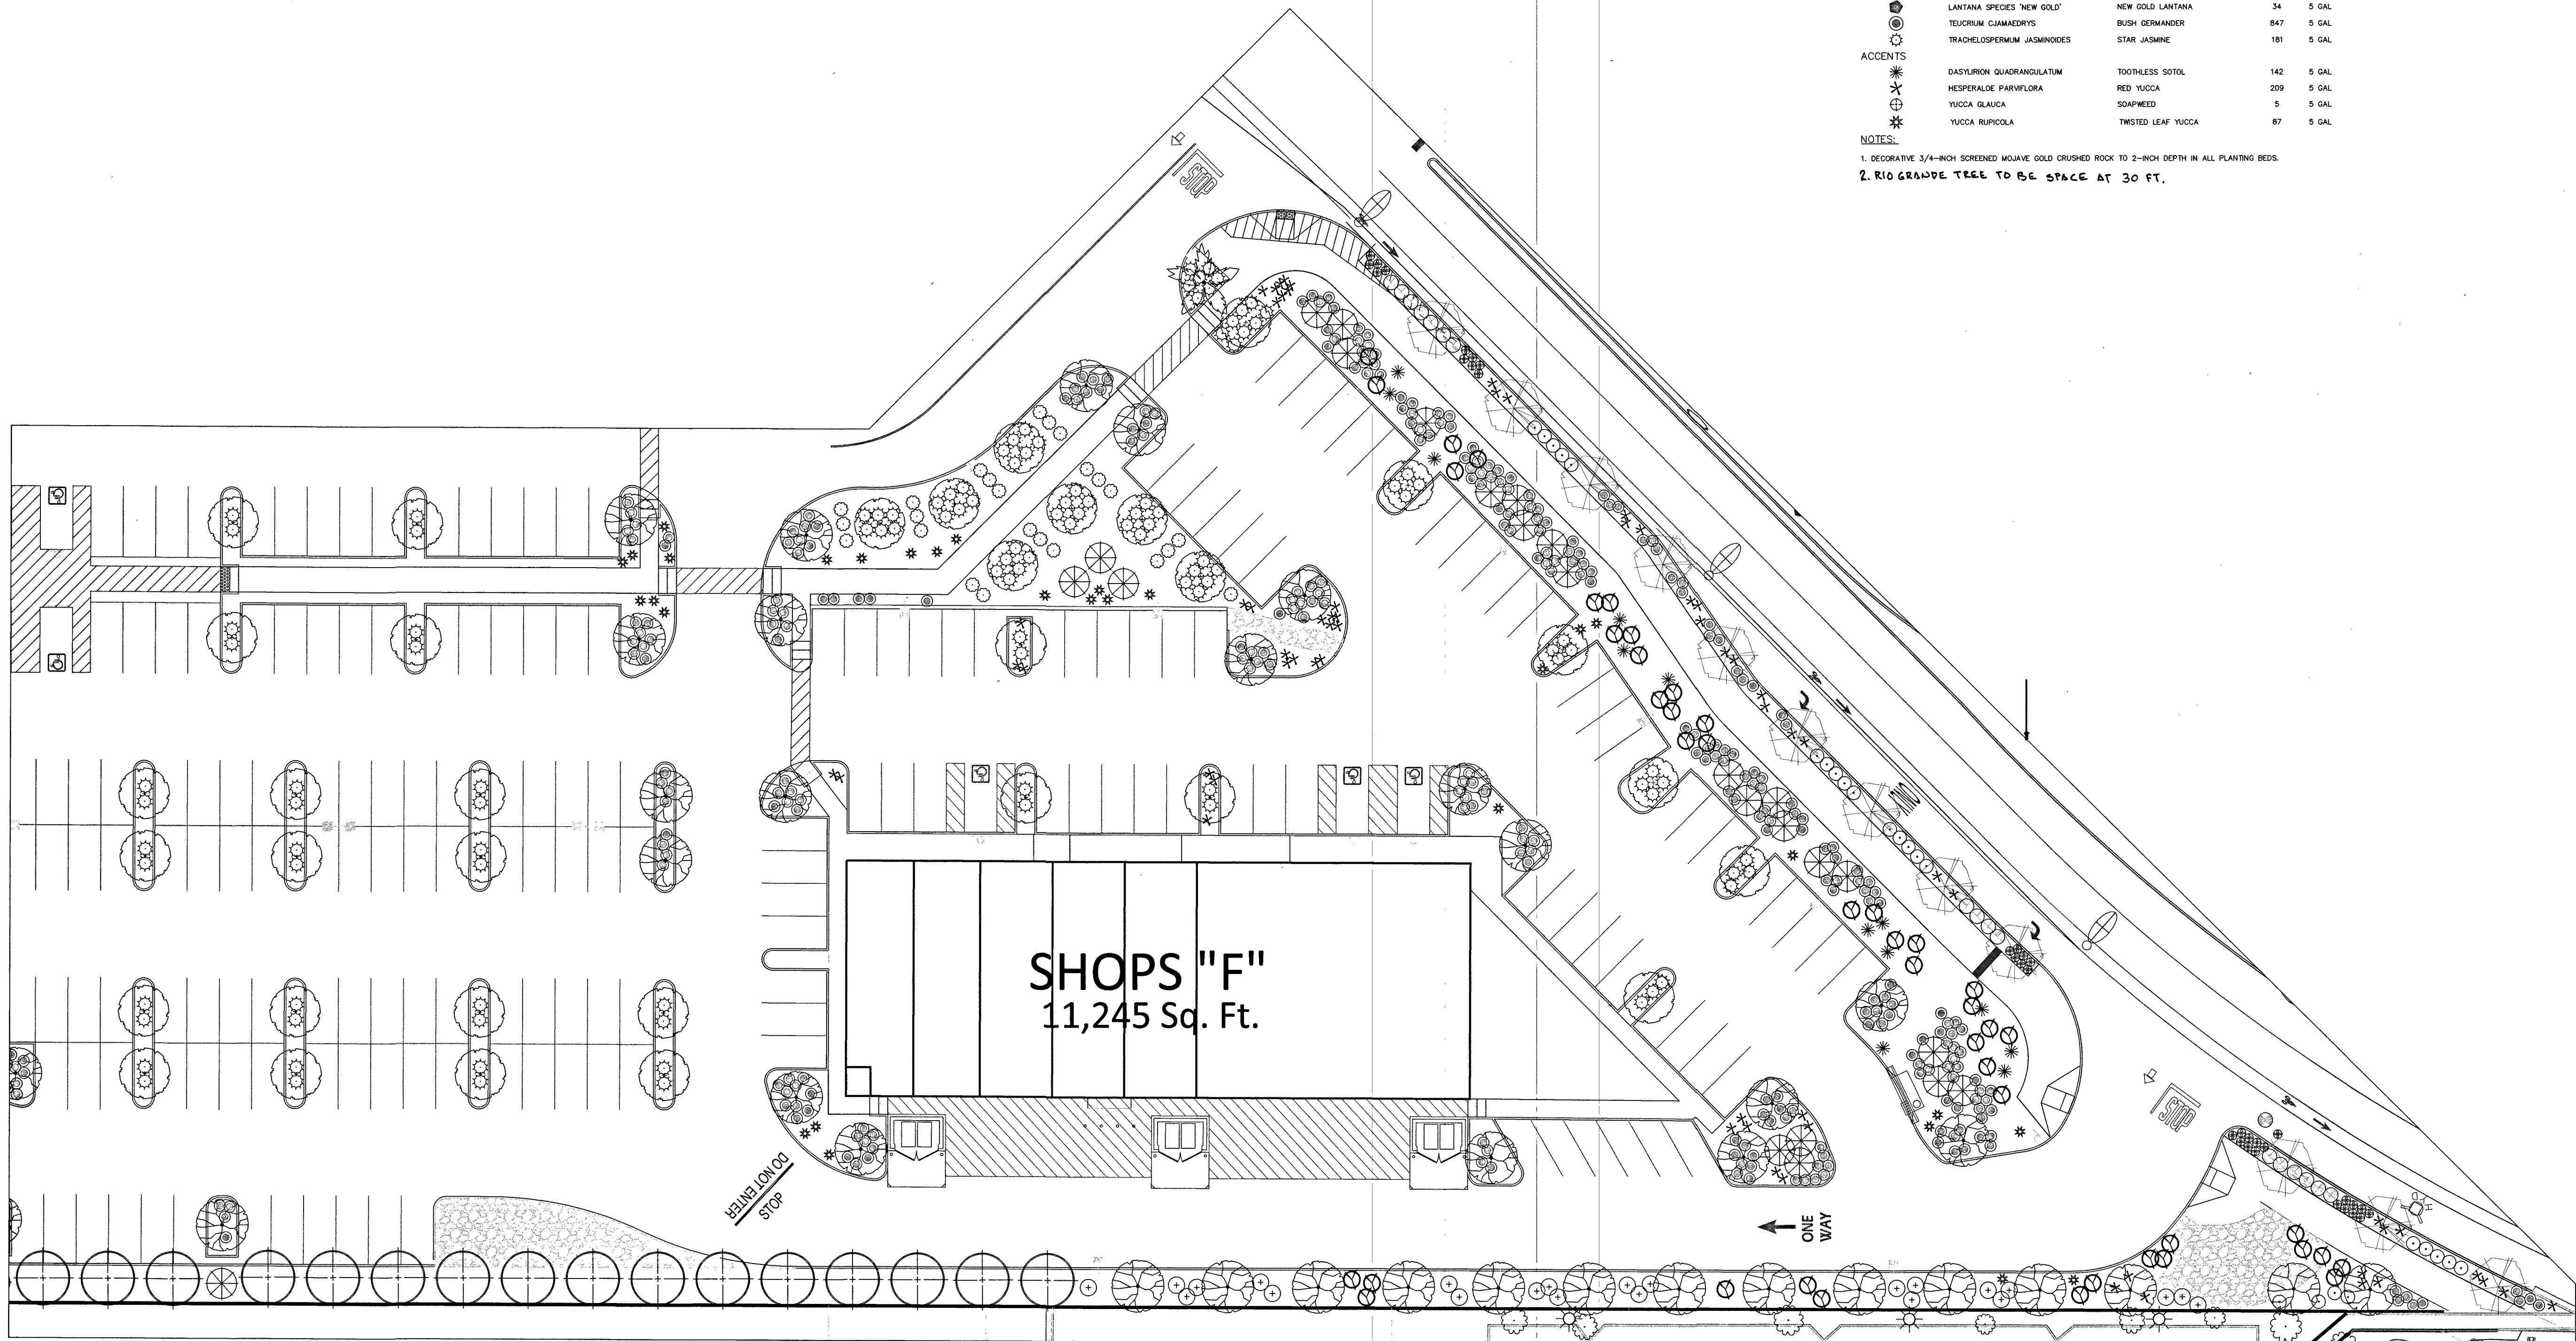

PLANTING PLAN

