


PLANT SCHEDULE	BOTANICAL NAME	COMMON NAME	QTY.	SIZE	REMARKS
TREES					
○	CUPRESSUS S. 'TINY TOWERS'	TINY TOWERS DWARF CYPRESS	13	15 GAL	STANDARD TRUNK
○	LAGERSTROEMIA INDICA	GRAPE MYRTLE	69	24" BOX	STANDARD TRUNK
○	OLEA EUROPAEA 'SWAN HILL'	SWAN HILL OLIVE	29	30" BOX	MULTI-TRUNK (3 TO 4 TRUNKS)
★	PHOENIX DACTYLIFERA	DATE PALM	13	20' BROWN TRUNK	SHOVEL CUT STRAIGHT AND EVEN TRUNKS
○	RIO GRANDE DSH	RIO GRANDE ASH	31	24" BOX	STANDARD TRUNK
○	QUERCUS ILEX	HOLLY OAK	73	24" BOX	STANDARD TRUNK
○	SOPHORA BECUNDFLORA	TEXAS MOUNTAIN LAUREL	75	24" BOX	MULTI-TRUNK (3 TO 4 TRUNKS)
○	WASHINGTONIA ROBUSTA HYBRID	HYBRID MEXICAN FAN PALM	14	18' BROWN TRUNK	ALL TRUNKS ARE TO BE SKINNED STRAIGHT AND EVEN
SHRUBS					
○	CAESALPINIA PULCHERRIMA	RED BIRD OF PARADISE	144	5 GAL	
○	PITTOSPORIUM TOBIRA 'WHEELER'S'	WHEELER'S DWARF MOCKORANGE	90	5 GAL	
○	RHAPHIOLEPIS INDICA 'PINK LADY'	INDIAN HAWTHORN	31	5 GAL	
○	SENNIA OLIGOPHYLLA	OUTBACK CASSIA	277	5 GAL	
○	SMILAX CHINENSIS 'VISTA'	COMPACT JOJOBA	133	5 GAL	
GROUND COVERS					
○	MELAMPYRUM LEUCANTHEMUM	BLACK FOOT DAISY	111	5 GAL	
○	LANTANA SPECIES 'NEW GOLD'	NEW GOLD LANTANA	34	5 GAL	
○	TEUCRIUM CJAMAEADRYIS	BUSH GERMANDER	847	5 GAL	
○	TRACHELOSPERMUM JASMINOIDES	STAR JASMINE	181	5 GAL	
ACCENTS					
★	DASYLIRION QUADRANGULATUM	TOOTHLESS SOTOL	142	5 GAL	
★	HESPERALOE PARVIFLORA	RED YUCCA	209	5 GAL	
★	YUCCA GLAUCA	SOAPWEED	5	5 GAL	
★	YUCCA RUPICOLA	TWISTED LEAF YUCCA	87	5 GAL	

NOTES:
1. DECORATIVE 3/4-INCH SCREENED MUAWE GOLD CRUSHED ROCK TO 2-INCH DEPTH IN ALL PLANTING BEDS.
2. RIO GRANDE TREE TO BE SPACE AT 30 FT.

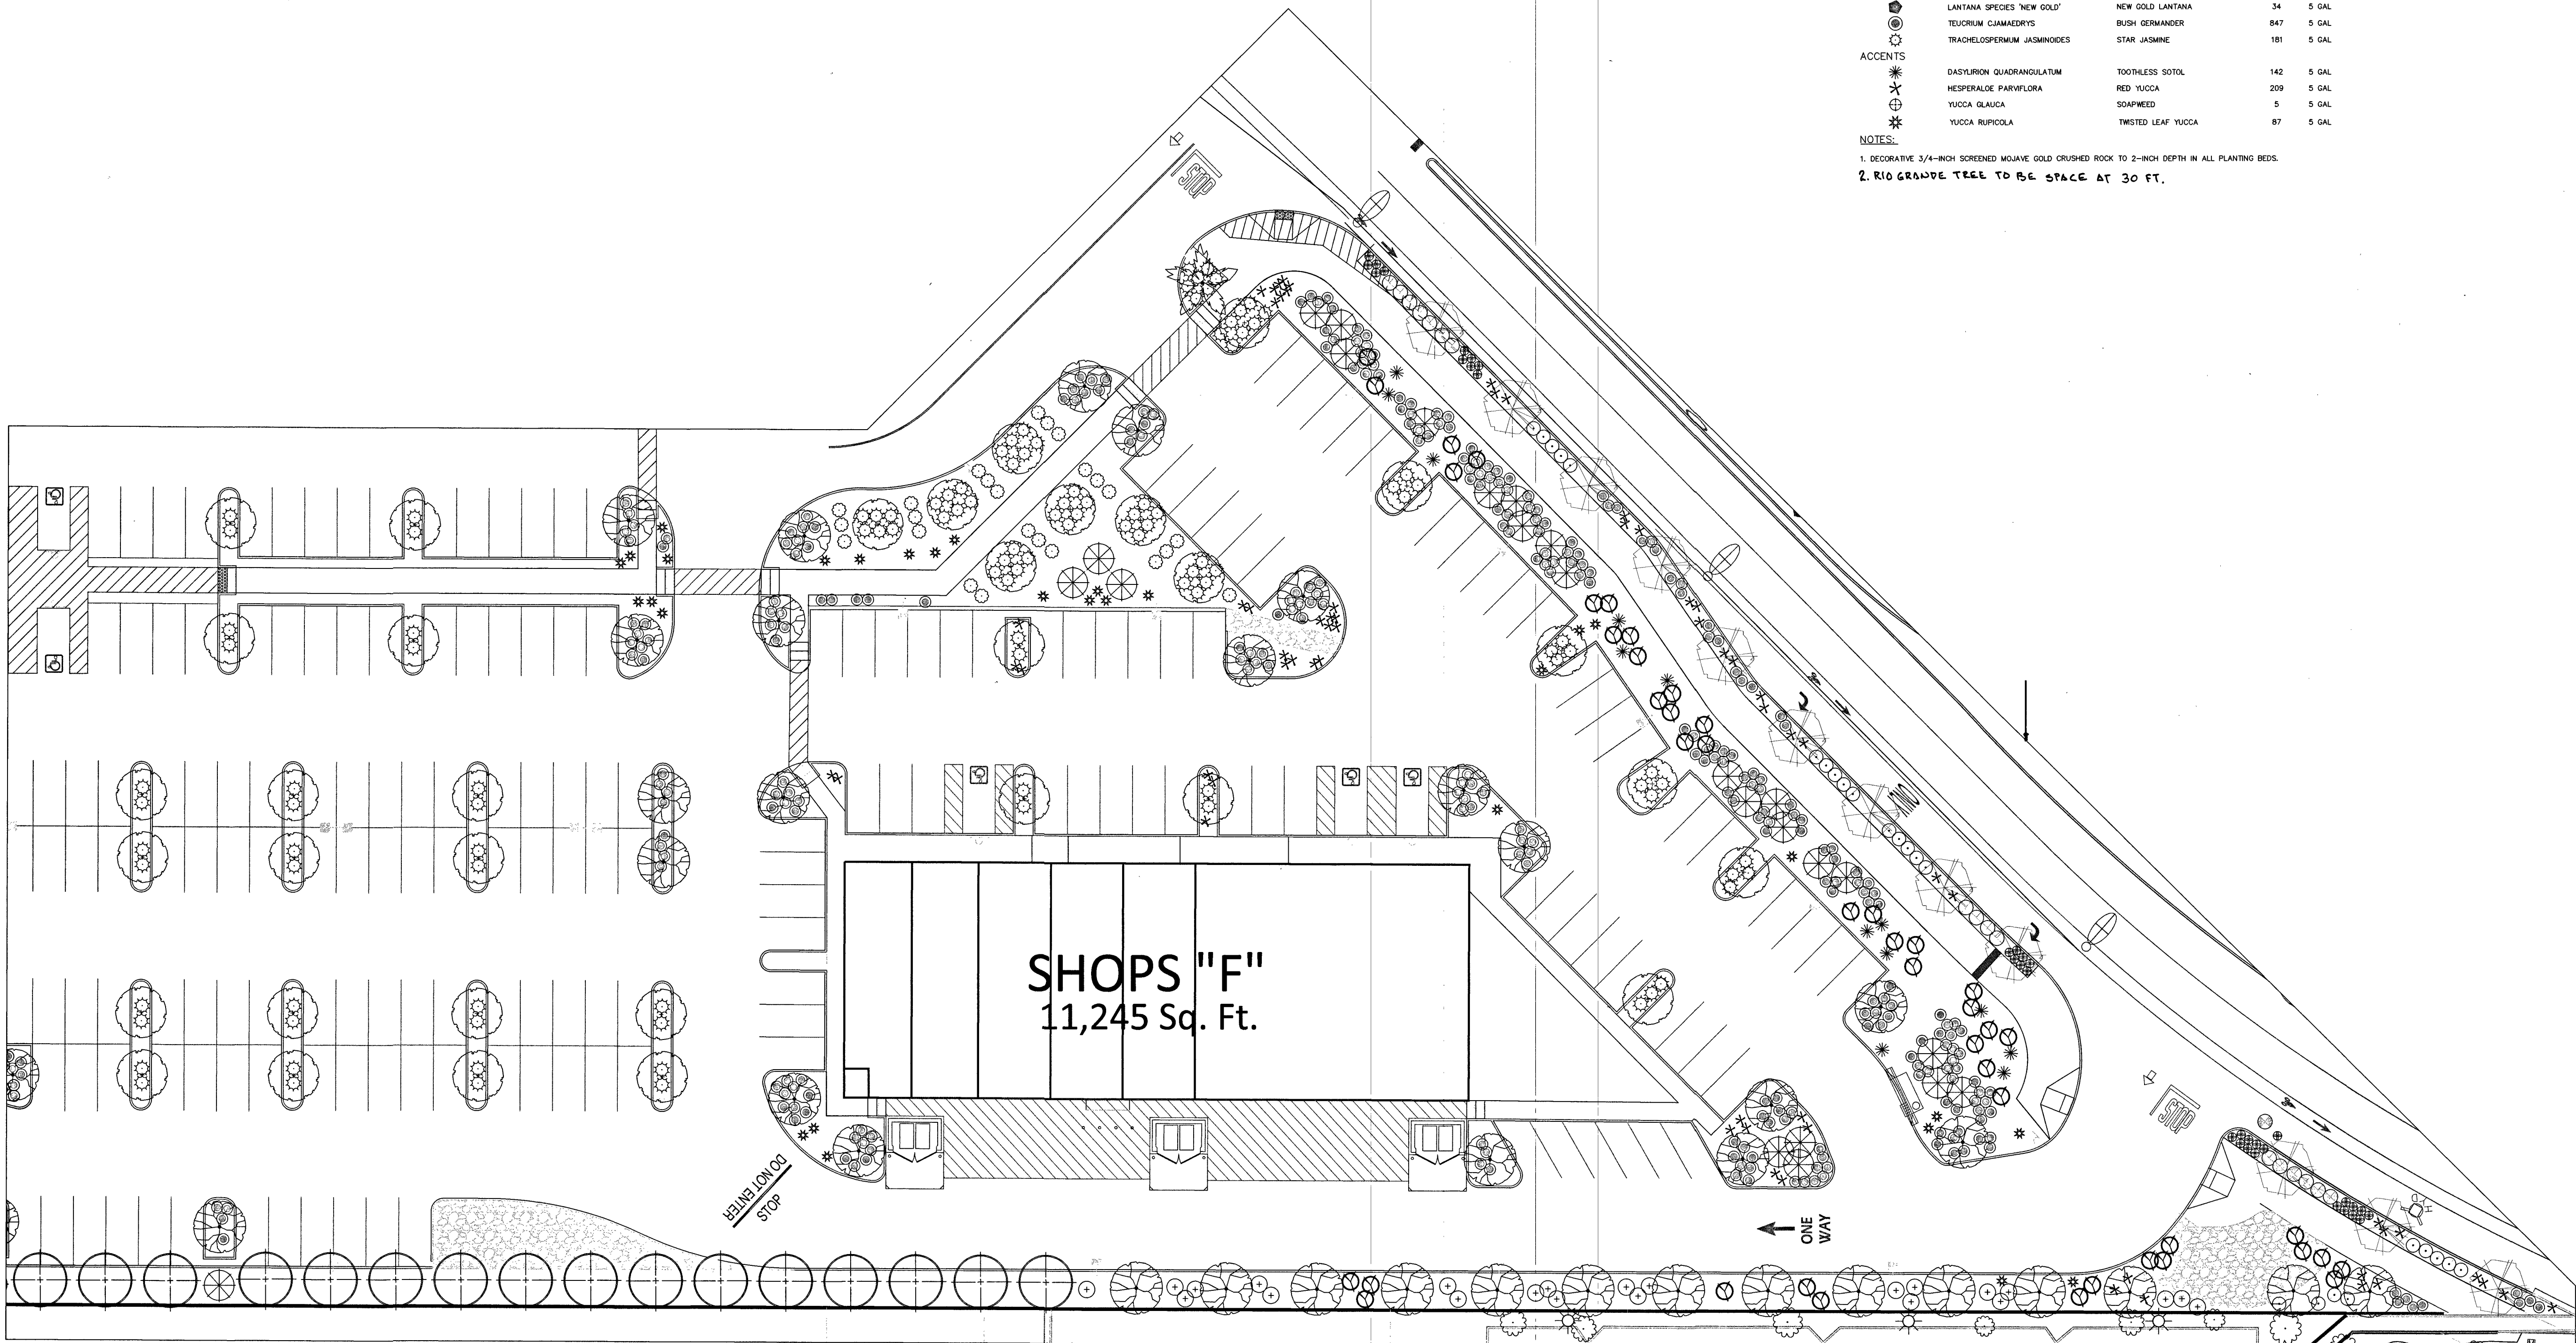

PLANTING PLAN

