

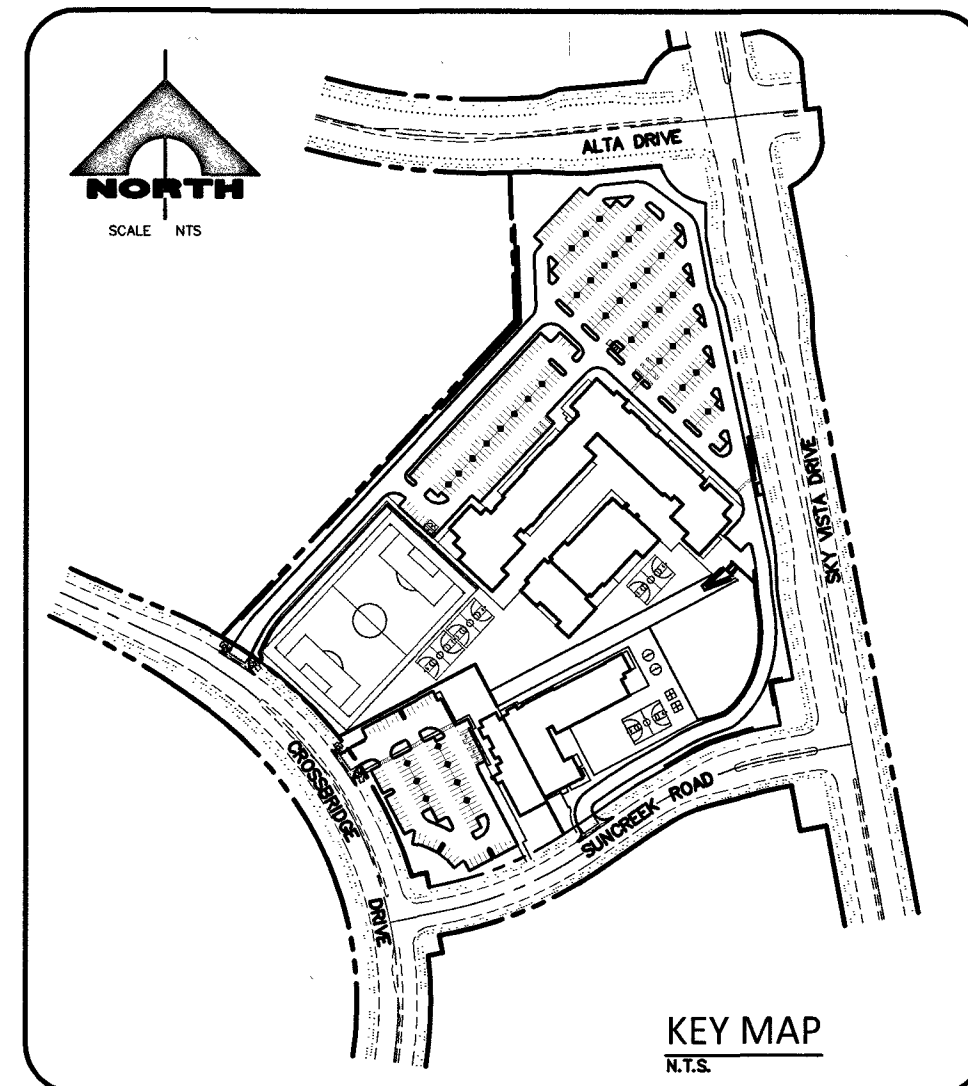
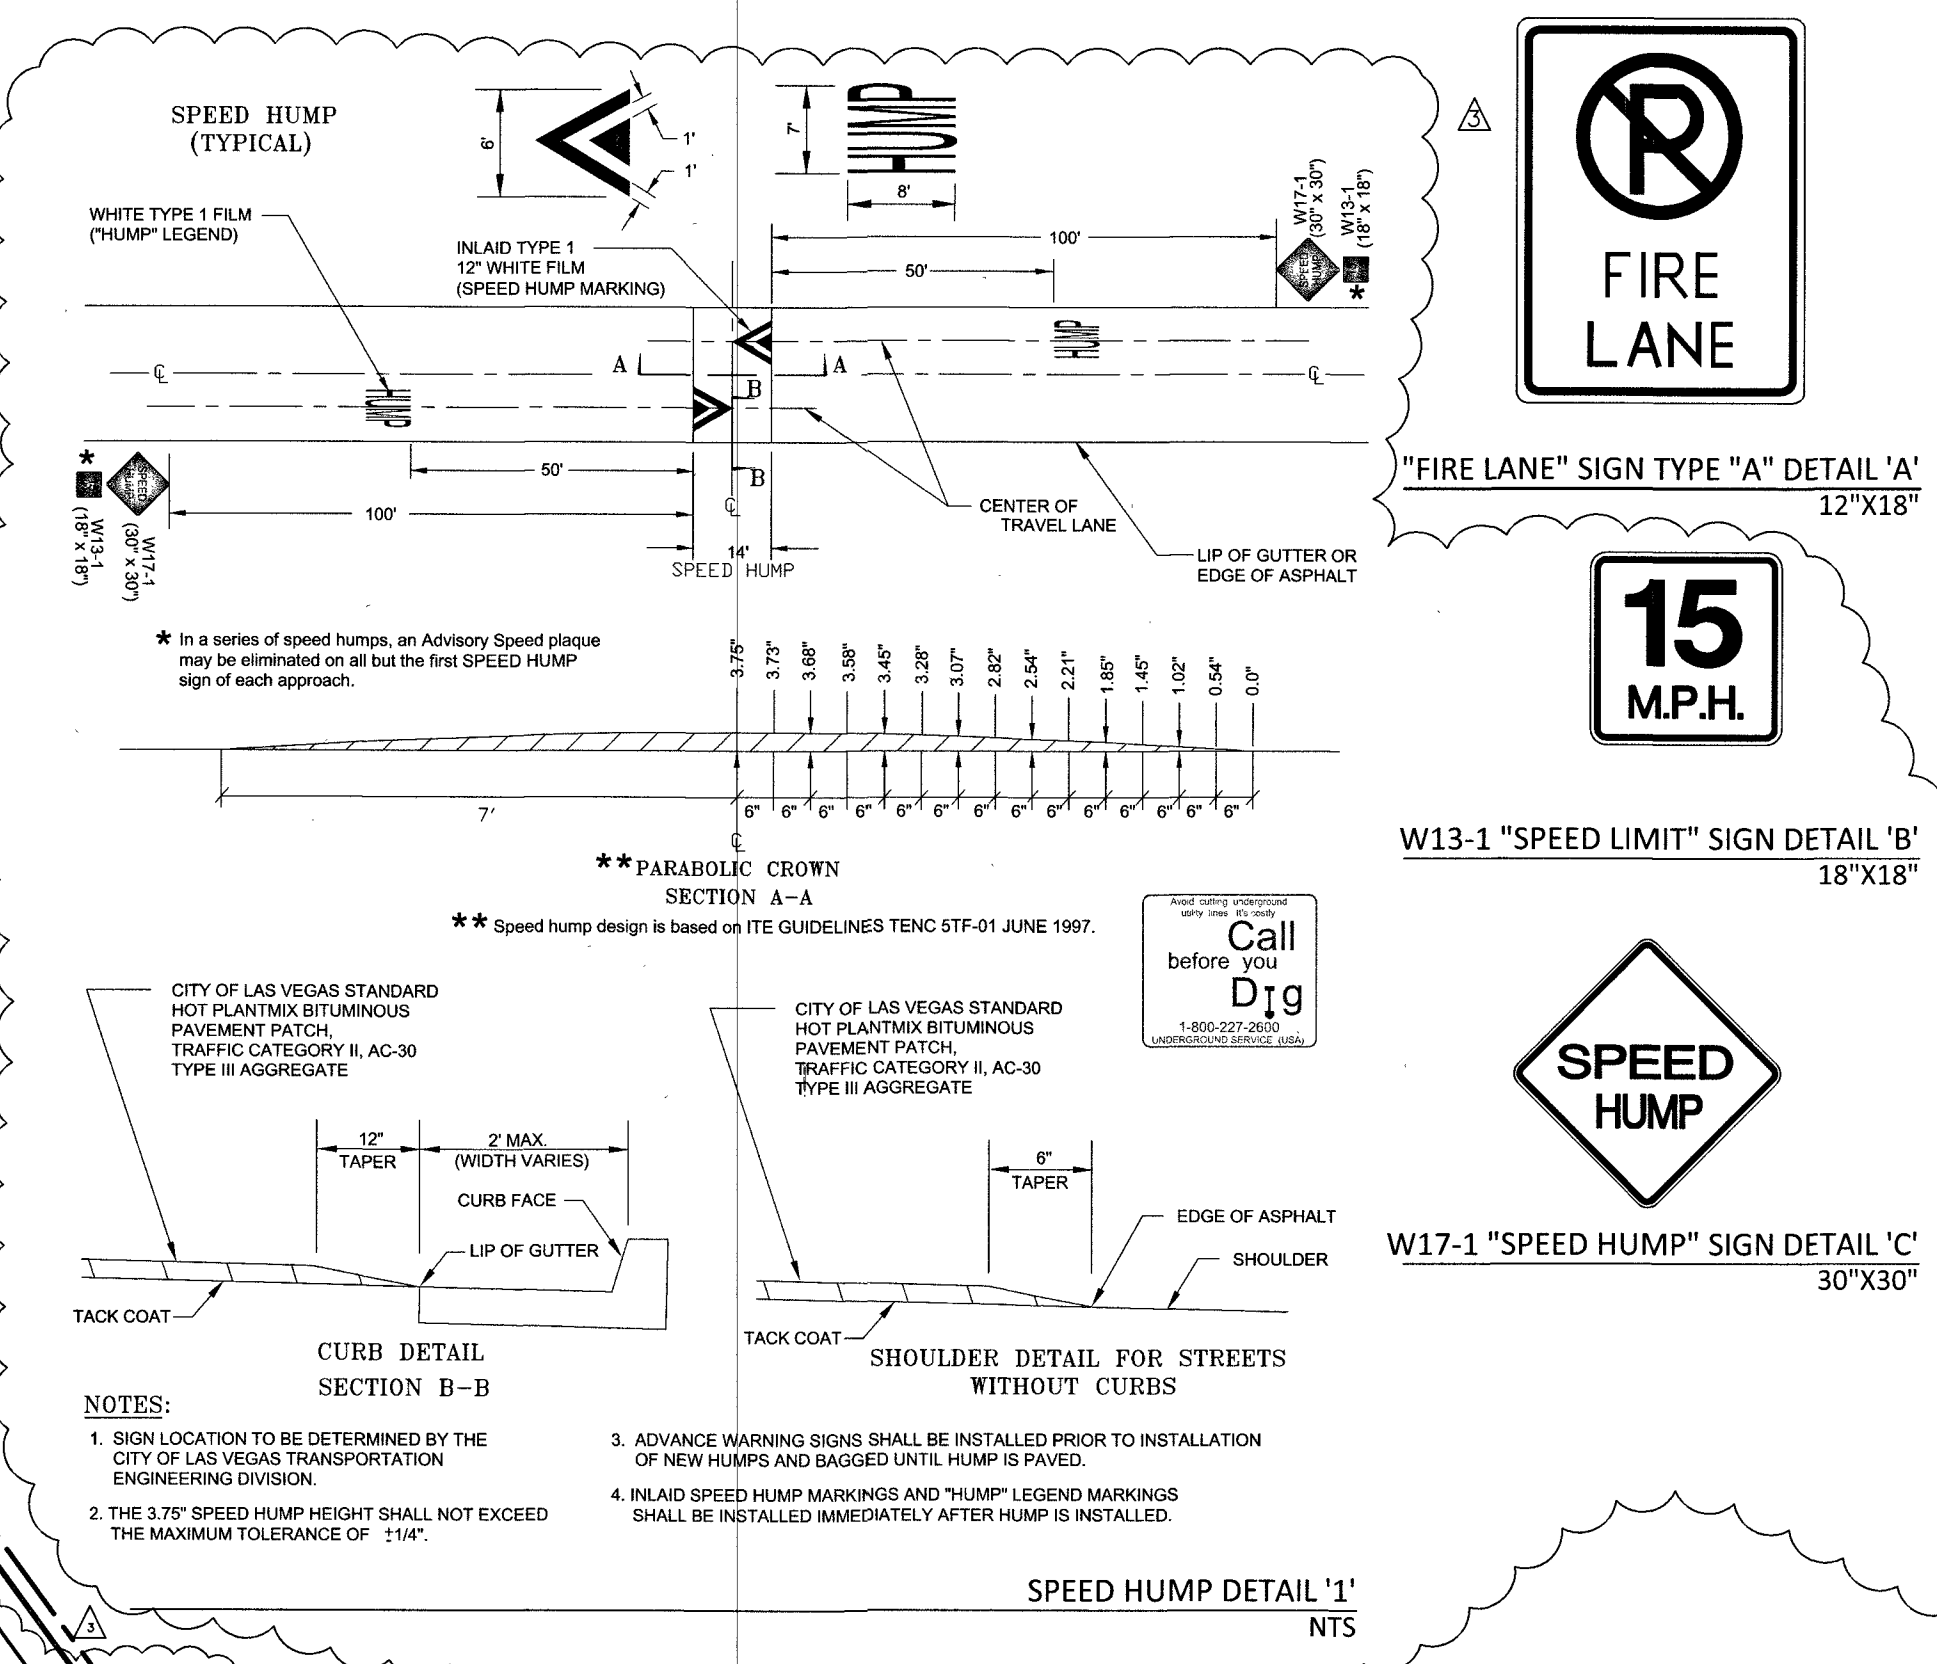
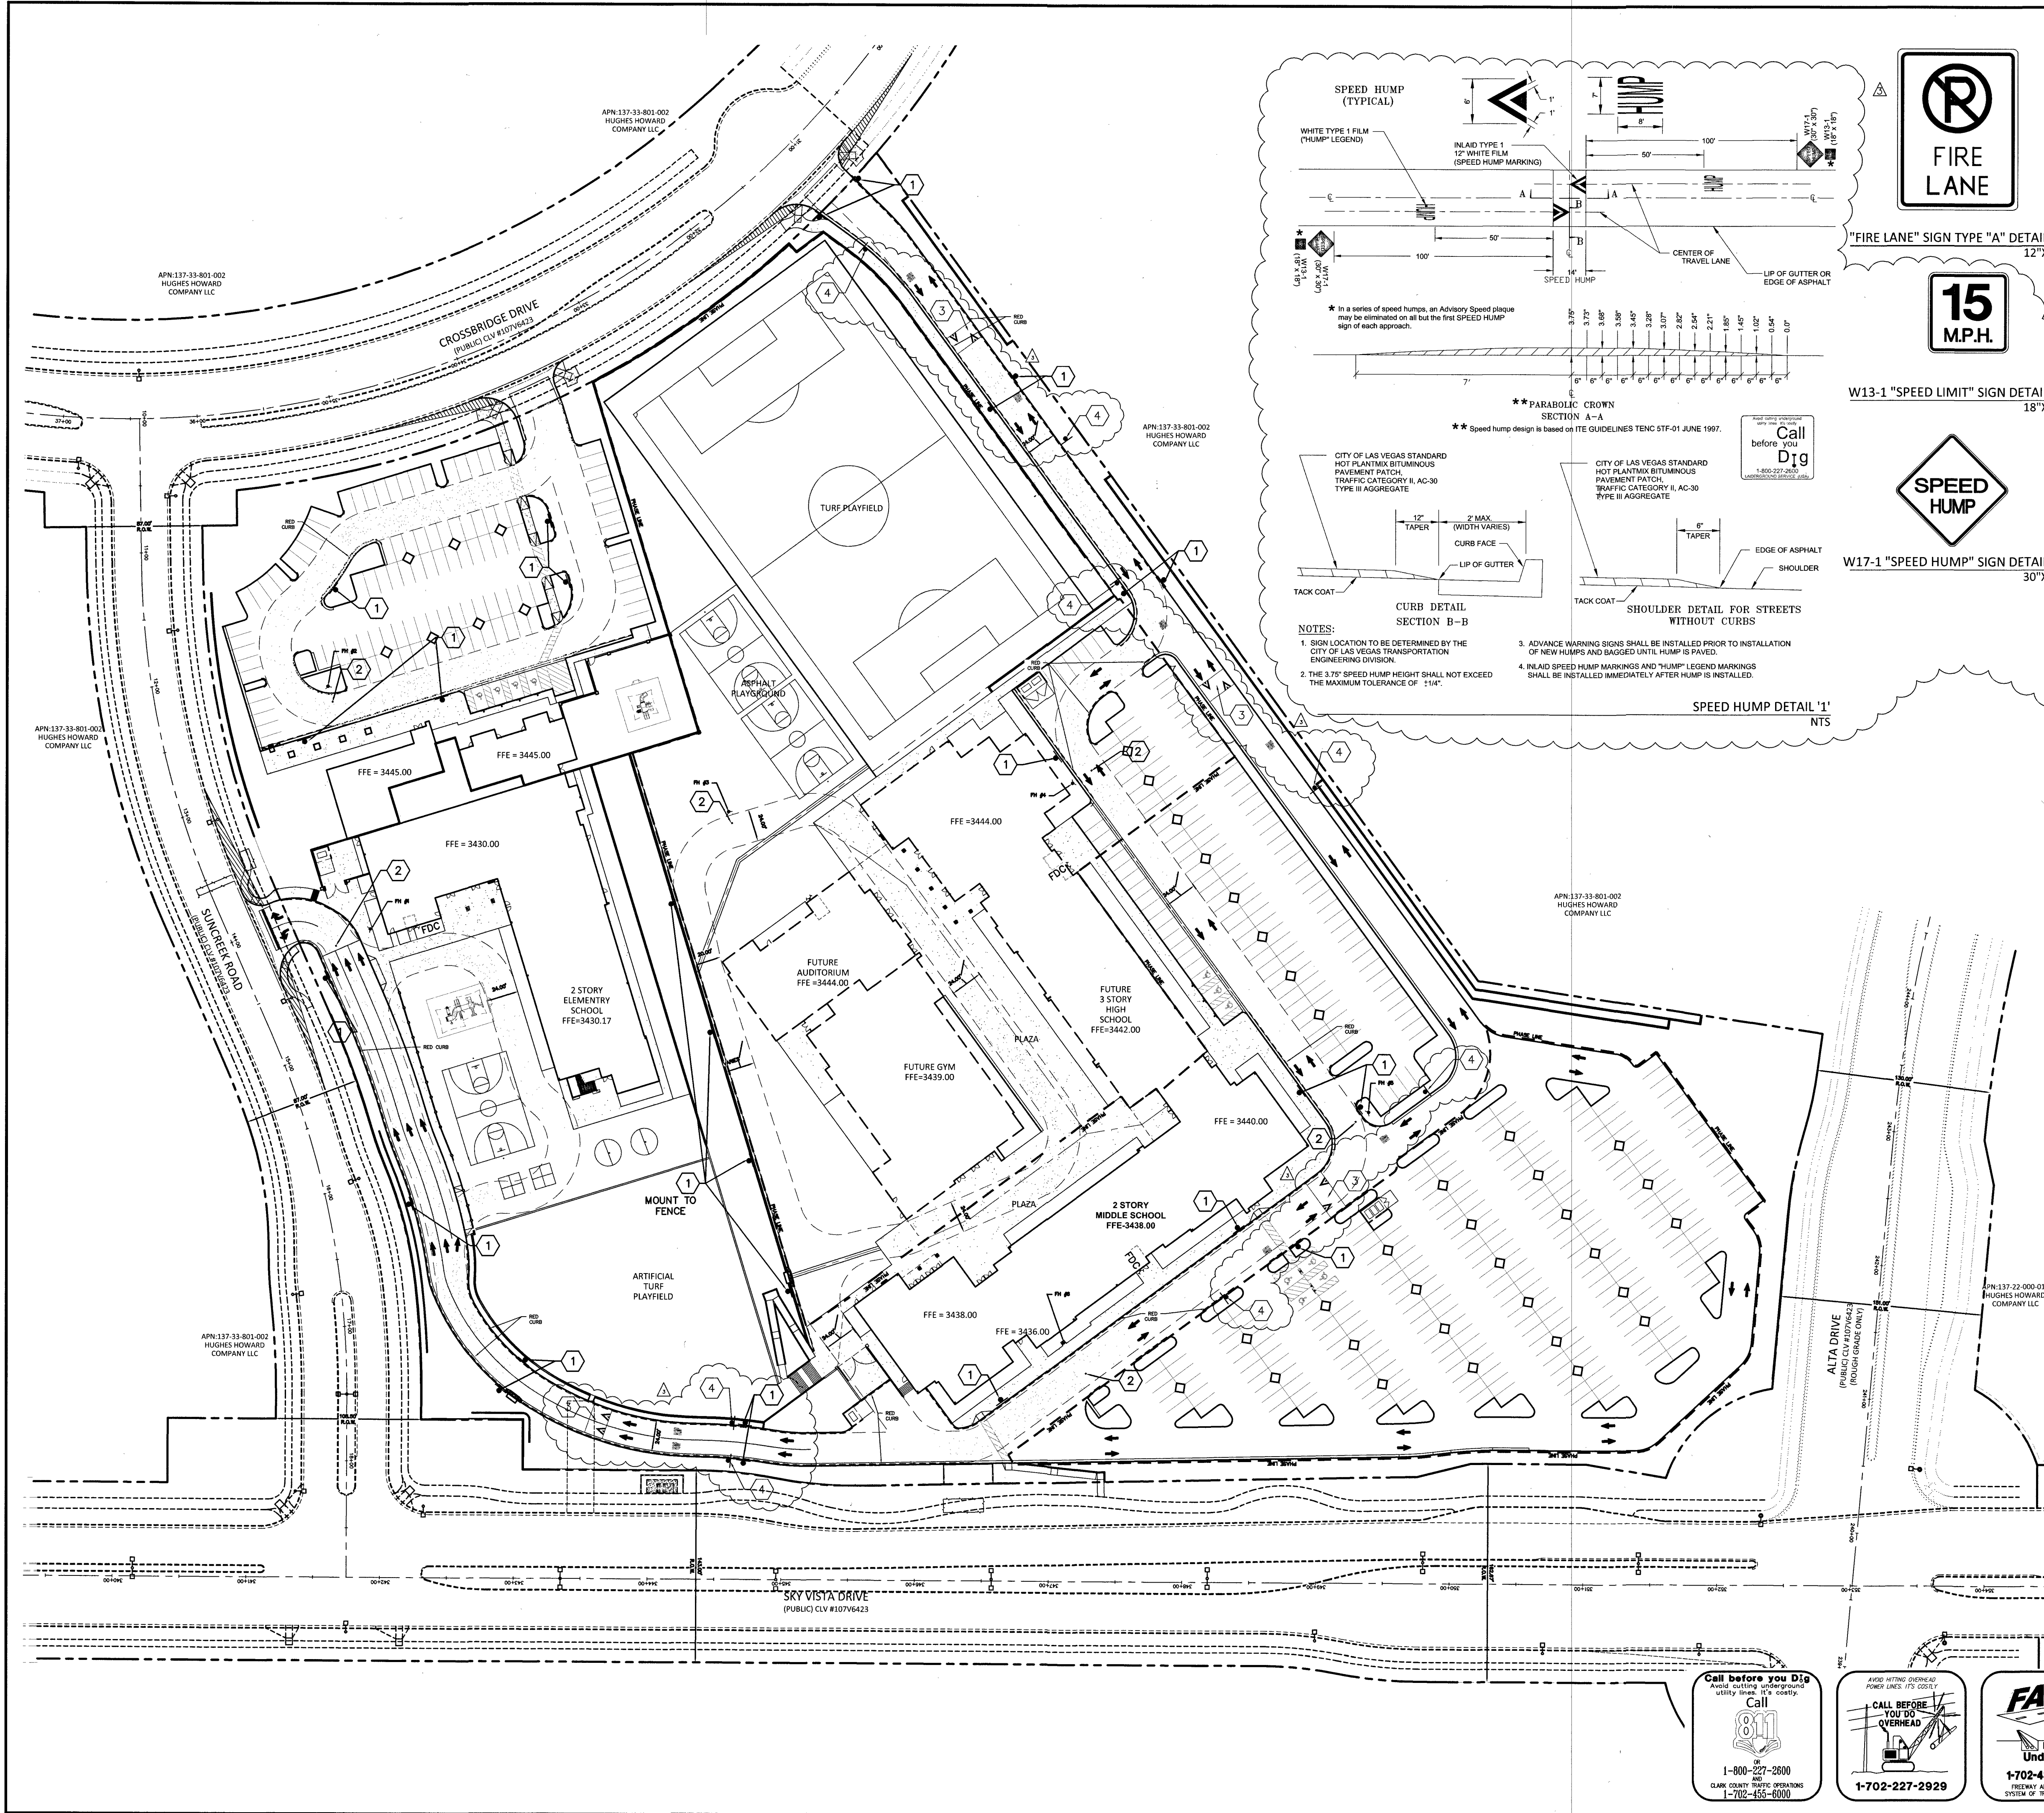


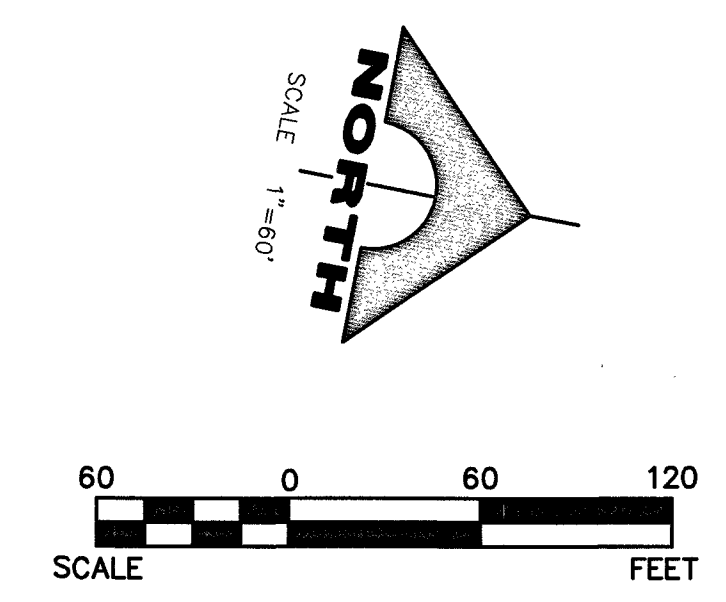

SIGNAGE CONSTRUCTION NOTES

NO.	ITEM USCCA: UNIFORM STANDARD DRAWINGS CLARK COUNTY AREA.
1	INSTALL "FIRE LANE" SIGNS PER DETAIL "A" THIS SHEET.
2	INSTALL "FIRE HYDRANT BLUE REFLECTOR" PER CITY OF LAS VEGAS FIRE DEPARTMENT GUIDELINES.
3	INSTALL SPEED HUMP PER DETAIL "1" THIS SHEET.
4	INSTALL "SPEED HUMP" AND "SPEED LIMIT" SIGNS PER DETAIL "B" AND "C" THIS SHEET.

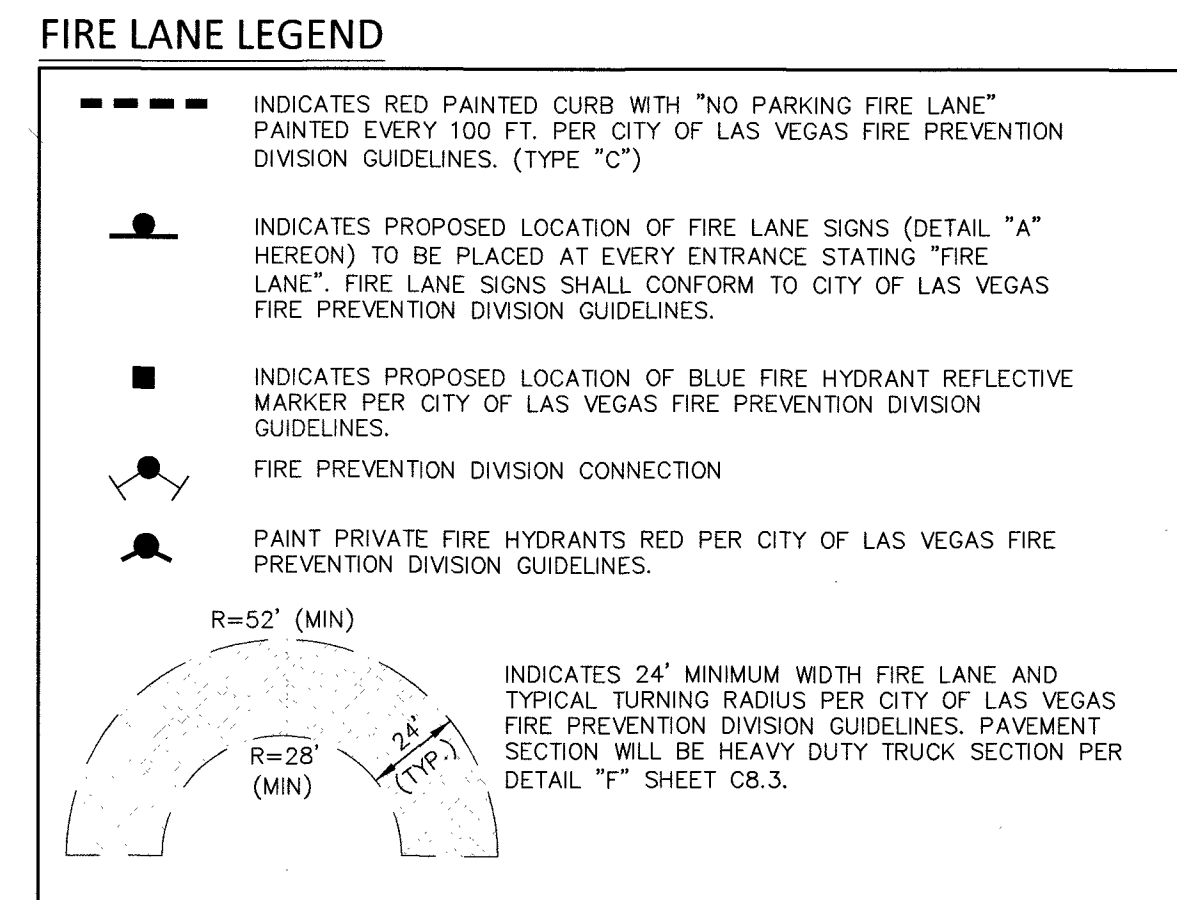

APPROVALS

[Signature] 12/7/16
LAS VEGAS FIRE & RESCUE DATE

BASIS OF BEARINGS

NORTH 05°36'32" WEST BEING THE BEARING OF THE WEST LINE OF THE NORTHWEST QUARTER (NW 1/4) OF SECTION 33, TOWNSHIP 20 SOUTH, RANGE 59 EAST, M.D.M. AS SHOWN IN BOOK 149, PAGE 46 PLATS ON FILE AT THE CLARK COUNTY, NEVADA RECORDER'S OFFICE.

BENCHMARK

DESCRIPTION	NAVD 88 DATUM	NAVD 88 DATUM
CITY OF LAS VEGAS VERTICAL CONTROL POINT "D368". BEING A USCGS DISC SET IN ROCK SOUTH OF CHARLESTON BLVD & WEST OF DEONTON BASIN.	3248.63 (FEET)	989.574 (METERS)
CITY OF LAS VEGAS VERTICAL CONTROL 2008 AND ADJUSTMENT (UPDATED 05/24/2010) BASED ON NORTH AMERICAN VERTICAL DATUM OF 1988 (NAVD'88).		

Call before you Dig
Call
1-800-227-2600
CLARK COUNTY TRAFFIC OPERATIONS
1-702-455-6000

Call before you Dig
Call
1-702-227-2929

FAST
Call before you UnderGround
1-702-432-5300
FREIGHTWAY AND ARTERIAL SYSTEM OF TRANSPORTATION

PROFESSIONAL ENGINEER SEAL
PAUL F. FRITZ
Exp. 06/30/2017
CIVIL
No. 16825
DATE: 11-24-16

NO.	DATE	DESCRIPTION
1	11/14/16	ADD SPEED BUMPS, SIGNAGE AND STRIPING

PROJECT NO. 889-002

DESIGN: *[Signature]*

DRAWN: *[Signature]*

CHECK: *[Signature]*

PLOT DATE: 11-29-16

PLOT TIME: 11:46:28

CA LAS VEGAS SVD, LLC

DORAL ACADEMY SUMMERLIN CAMPUS

FIRE ACCESS PLAN

DRAWING C3.7

10 OF 35 SHEETS

H: 62408 / CLV: 00-00000