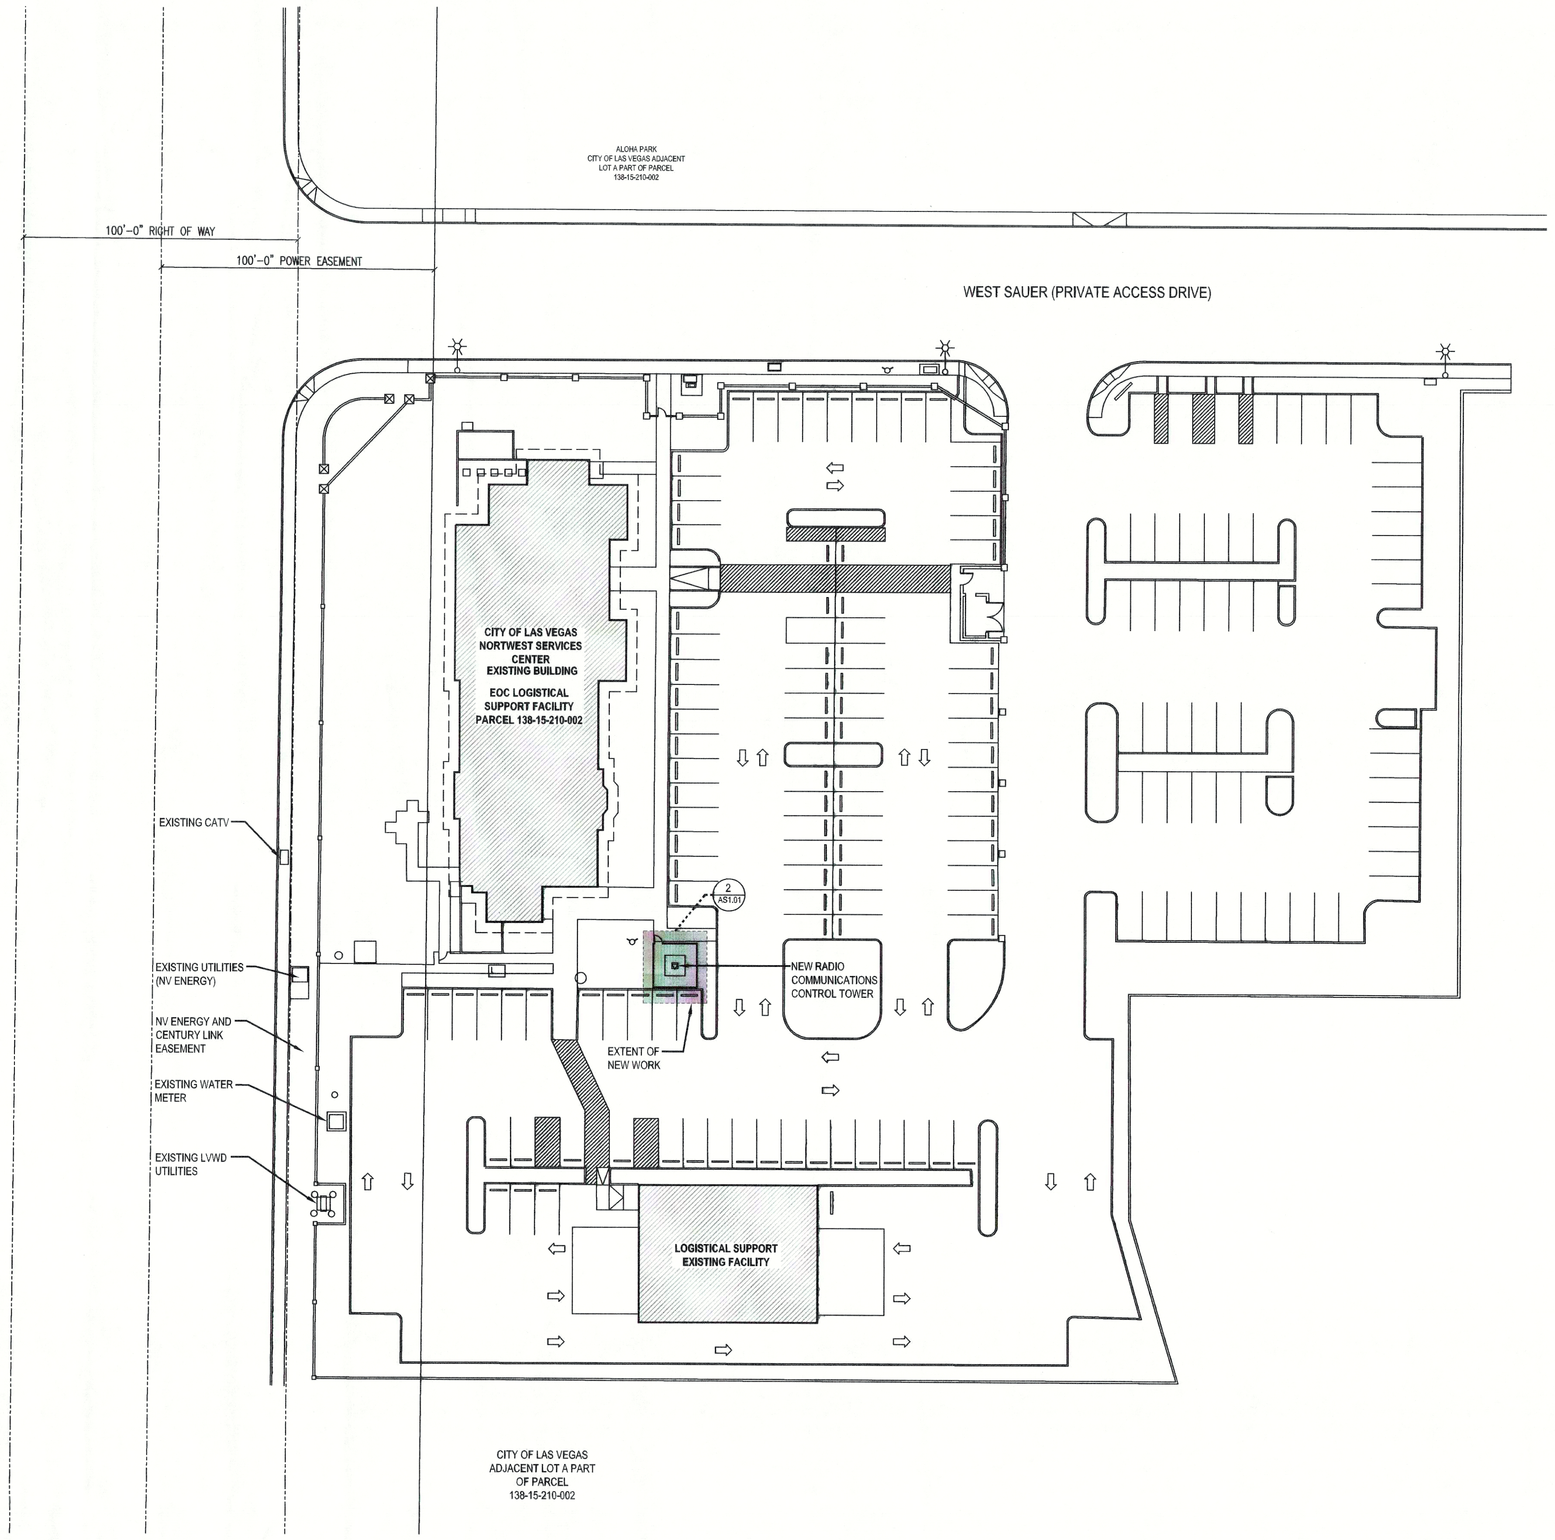

1 ARCHITECTURAL SITE PLAN

SCALE: 1/32" = 1'-0"

NORTH

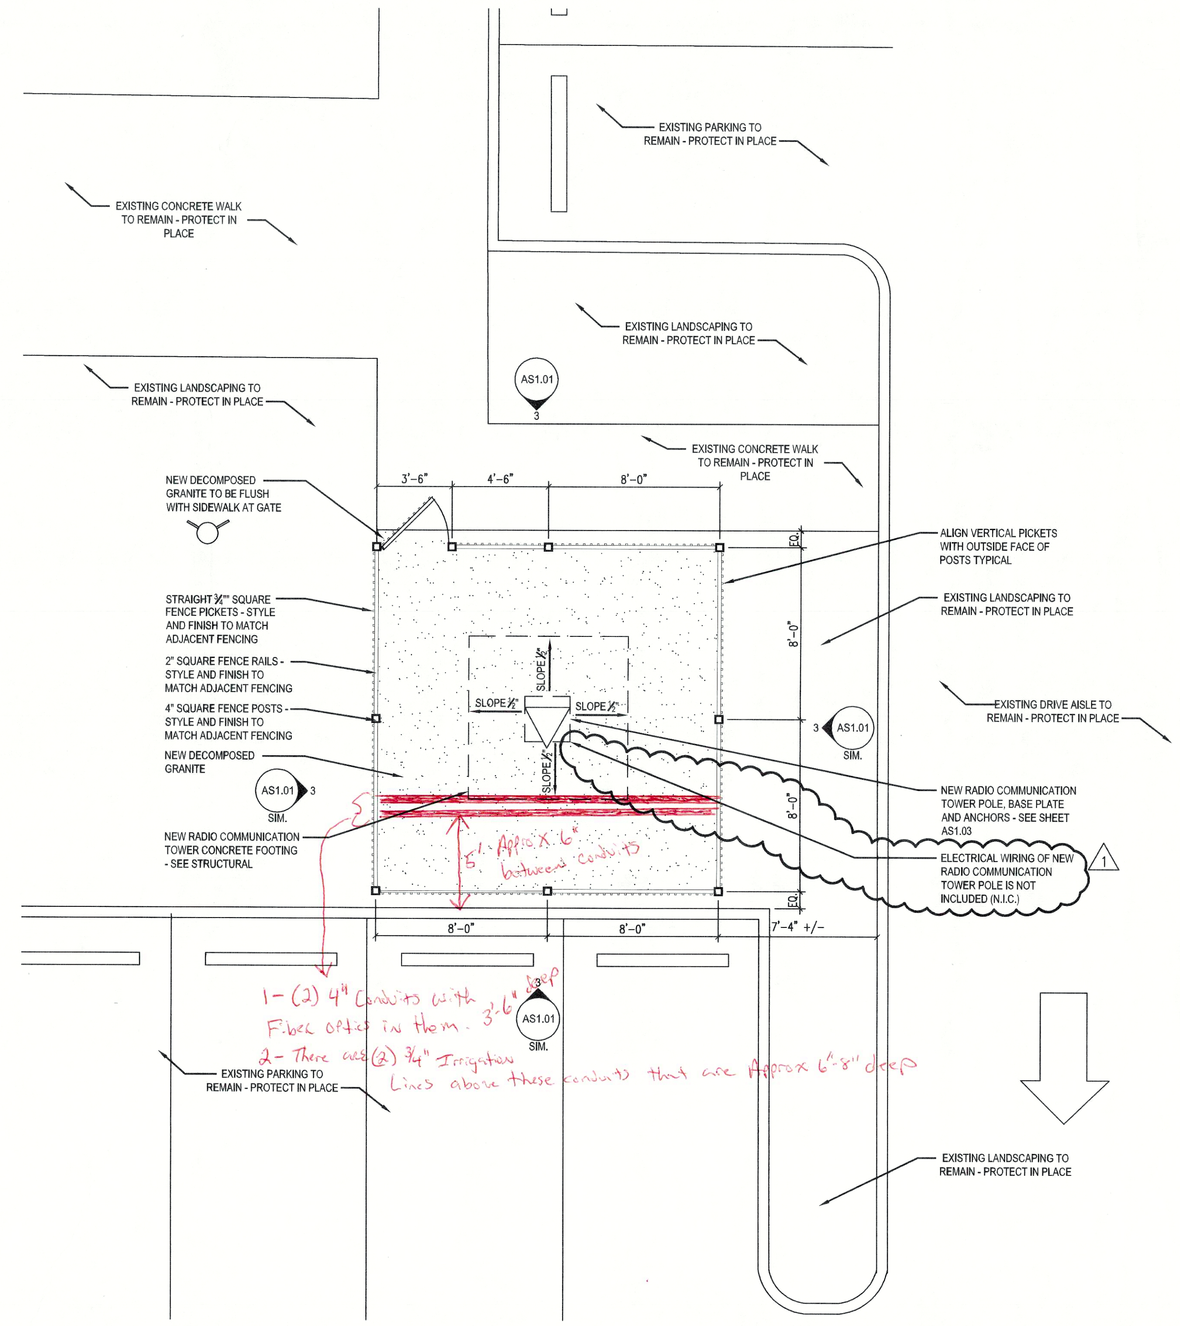

2 ENLARGED ARCHITECTURAL SITE PLAN

SCALE: 1/4" = 1'-0"

NORTH

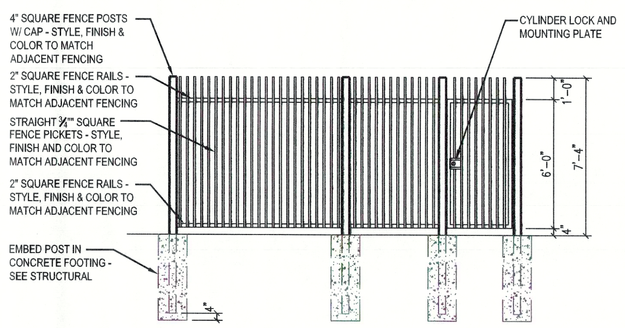

3 SECURITY FENCE ELEVATION

SCALE: 1/4" = 1'-0"

PLANS APPROVED
CONSTRUCTION
Building & Safety Dept.
City of Las Vegas, Nevada
MAR 08 2016
Does Not Include Electrical, Plumbing, Mechanical Structural or Off-Site Improvements. Make No Change Without Approval. Plan is Not a Permit to Violate Any Ordinance.

RECEIVED
MAR 07 2016
CITY OF LAS VEGAS
PERMITS

CONSTRUCTION • DESIGN BUILD
Sletten COMPANIES
SLETTEN CONSTRUCTION OF NEVADA, INC.

Seal
REGISTERED ARCHITECT No. 631 NEVADA
MAR 07 2016

SHEET TITLE
ARCHITECTURAL SITE PLANS AND ELEVATION

PROJECT NAME
NEW RADIO COMMUNICATION TOWER AND SECURITY FENCE
DEPARTMENT OF PUBLIC WORKS
EMERGENCY OPERATIONS CENTER - LOGISTICAL SUPPORT FACILITY
7551 SAUER DRIVE LAS VEGAS, NEVADA 89128

Revisions

#	Description	Date
1	CLVDSC COMMENTS	12/30/15

Date: 12/11/15
Issued for: PLANS CHECK REVIEW
Designed By:
Drawn By:
Checked By:
Project Manager:
DCC Project No.:

Sheet Number
AS BUILT
AS1.01