




GRAPHIC SCALE

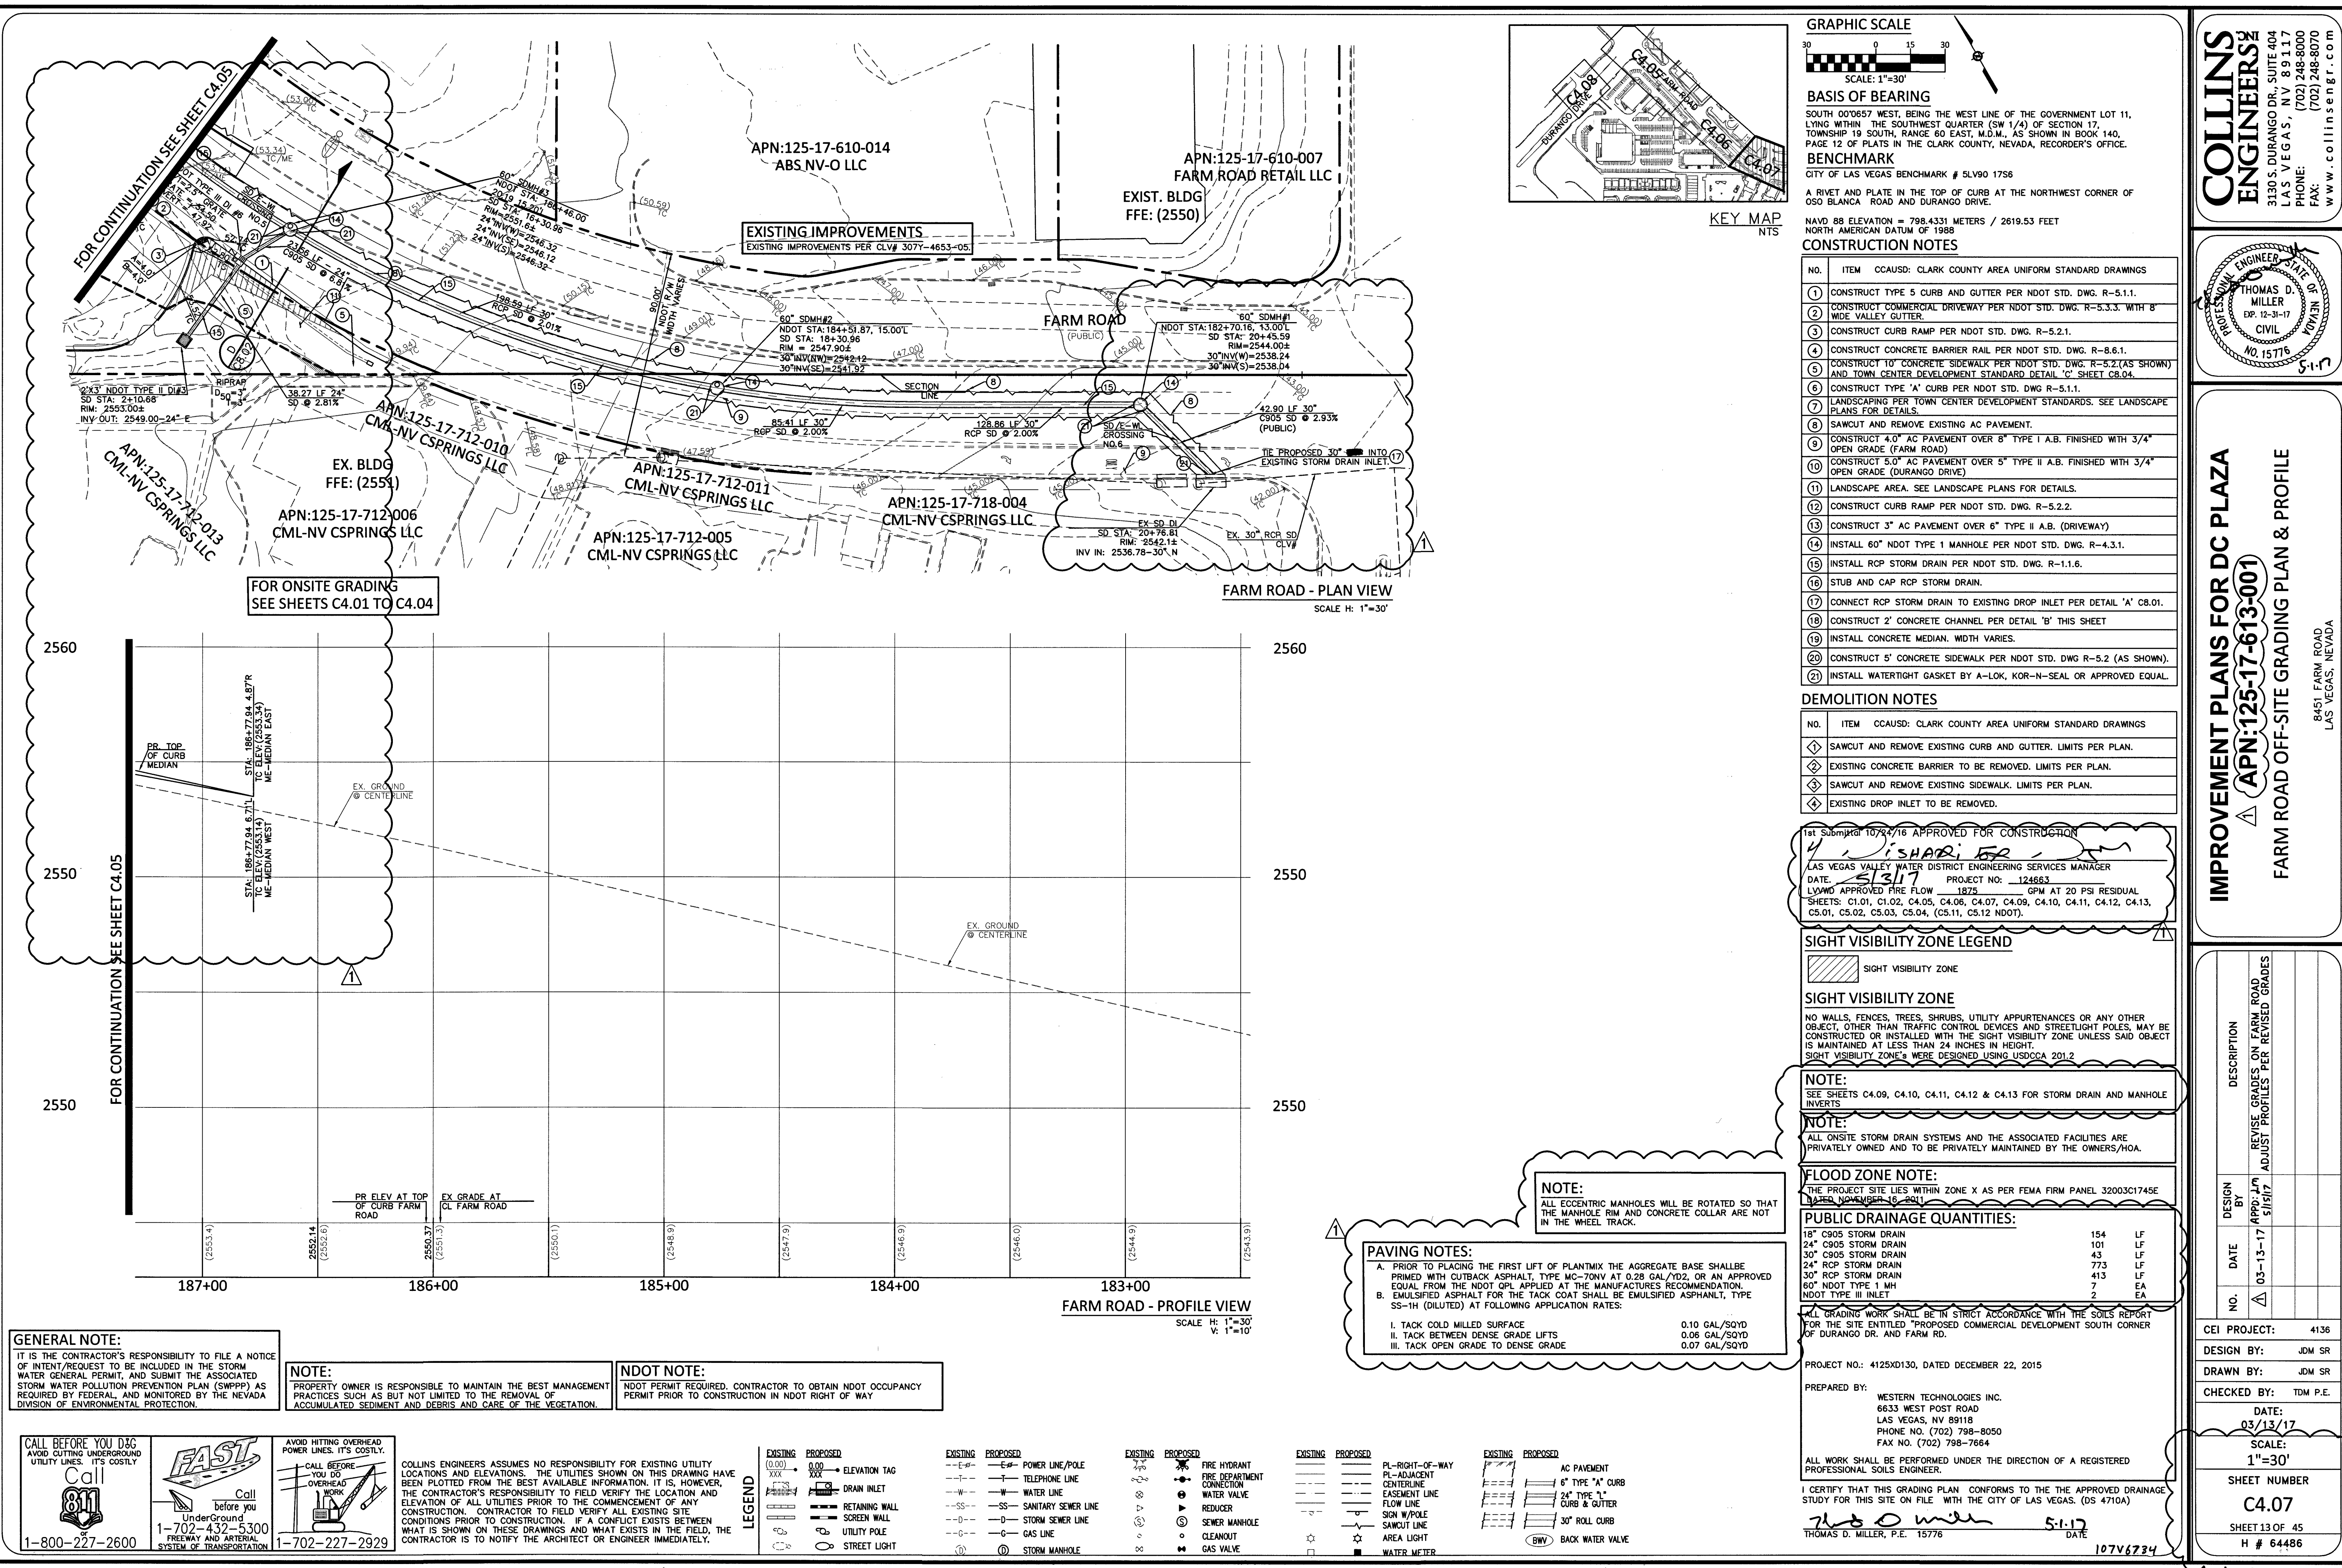

SCALE: 1"=30'

BASIS OF BEARING

SOUTH 00°06'57" WEST, BEING THE WEST LINE OF THE GOVERNMENT LOT 11, LYING WITHIN THE SOUTHWEST QUARTER (SW 1/4) OF SECTION 17, TOWNSHIP 19 SOUTH, RANGE 60 EAST, M.D.M., AS SHOWN IN BOOK 140, PAGE 12 OF PLATS IN THE CLARK COUNTY, NEVADA, RECORDER'S OFFICE.

BENCHMARK

CITY OF LAS VEGAS BENCHMARK # 5LV90 1756

A RIVET AND PLATE IN THE TOP OF CURB AT THE NORTHWEST CORNER OF OSO BLANCA ROAD AND DURANGO DRIVE.

NAVD 88 ELEVATION = 798.4331 METERS / 2619.53 FEET NORTH AMERICAN DATUM OF 1988

CONSTRUCTION NOTES

1. CONSTRUCT TYPE 5 CURB AND GUTTER PER NDOT STD. DWG. R-5.1.1.
2. CONSTRUCT COMMERCIAL DRIVEWAY PER NDOT STD. DWG. R-5.3.3. WITH 8" WIDE VALLEY GUTTER.
3. CONSTRUCT CURB RAMP PER NDOT STD. DWG. R-5.2.1.
4. CONSTRUCT CONCRETE BARRIER RAIL PER NDOT STD. DWG. R-8.6.1.
5. CONSTRUCT 10" CONCRETE SIDEWALK PER NDOT STD. DWG. R-5.2 (AS SHOWN) AND TOWN CENTER DEVELOPMENT STANDARD DETAIL 'C' SHEET C8.04.
6. CONSTRUCT TYPE 'A' CURB PER NDOT STD. DWG. R-5.1.1.
7. LANDSCAPING PER TOWN CENTER DEVELOPMENT STANDARDS. SEE LANDSCAPE PLANS FOR DETAILS.
8. SAWCUT AND REMOVE EXISTING AC PAVEMENT.
9. CONSTRUCT 4.0" AC PAVEMENT OVER 8" TYPE I A.B. FINISHED WITH 3/4" OPEN GRADE (FARM ROAD).
10. CONSTRUCT 5.0" AC PAVEMENT OVER 5" TYPE II A.B. FINISHED WITH 3/4" OPEN GRADE (DURANGO DRIVE).
11. LANDSCAPE AREA. SEE LANDSCAPE PLANS FOR DETAILS.
12. CONSTRUCT CURB RAMP PER NDOT STD. DWG. R-5.2.2.
13. CONSTRUCT 3" AC PAVEMENT OVER 6" TYPE II A.B. (DRIVEWAY).
14. INSTALL 60" NDOT TYPE 1 MANHOLE PER NDOT STD. DWG. R-4.3.1.
15. INSTALL RCP STORM DRAIN PER NDOT STD. DWG. R-1.1.6.
16. STUB AND CAP RCP STORM DRAIN.
17. CONNECT RCP STORM DRAIN TO EXISTING DROP INLET PER DETAIL 'A' C8.01.
18. CONSTRUCT 2" CONCRETE CHANNEL PER DETAIL 'B' THIS SHEET.
19. INSTALL CONCRETE MEDIAN. WIDTH VARIES.
20. CONSTRUCT 5" CONCRETE SIDEWALK PER NDOT STD. DWG. R-5.2 (AS SHOWN).
21. INSTALL WATERTIGHT GASKET BY A-LOK, KOR-N-SEAL OR APPROVED EQUAL.

DEMOLITION NOTES

1. SAWCUT AND REMOVE EXISTING CURB AND GUTTER. LIMITS PER PLAN.
2. EXISTING CONCRETE BARRIER TO BE REMOVED. LIMITS PER PLAN.
3. SAWCUT AND REMOVE EXISTING SIDEWALK. LIMITS PER PLAN.
4. EXISTING DROP INLET TO BE REMOVED.

1st Submittal 10/24/16 APPROVED FOR CONSTRUCTION

LAS VEGAS VALLEY WATER DISTRICT ENGINEERING SERVICES MANAGER
DATE: 5/31/17 PROJECT NO: 124683
LAWD APPROVED FIRE FLOW 1875 GPM AT 20 PSI RESIDUAL
SHEETS: C1.01, C1.02, C4.05, C4.06, C4.07, C4.08, C4.10, C4.11, C4.12, C4.13, C5.01, C5.02, C5.03, C5.04, (C5.11, C5.12 NDOT).

SIGHT VISIBILITY ZONE LEGEND

NO WALLS, FENCES, TREES, SHRUBS, UTILITY APPURTENANCES OR ANY OTHER OBJECT, OTHER THAN TRAFFIC CONTROL DEVICES AND STREETLIGHT POLES, MAY BE CONSTRUCTED OR INSTALLED WITHIN THE SIGHT VISIBILITY ZONE UNLESS SAID OBJECT IS MAINTAINED AT LESS THAN 24 INCHES IN HEIGHT.

SIGHT VISIBILITY ZONE'S WERE DESIGNED USING USDOCA 201.2

NOTE:

SEE SHEETS C4.09, C4.10, C4.11, C4.12 & C4.13 FOR STORM DRAIN AND MANHOLE INVERTS

NOTE:

ALL ON-SITE STORM DRAIN SYSTEMS AND THE ASSOCIATED FACILITIES ARE PRIVATELY OWNED AND TO BE PRIVATELY MAINTAINED BY THE OWNERS/HOA.

FLOOD ZONE NOTE:

THE PROJECT SITE LIES WITHIN ZONE X AS PER FEMA FIRM PANEL 32003C1745E

PUBLIC DRAINAGE QUANTITIES:

18" C905 STORM DRAIN	154	LF
24" C905 STORM DRAIN	101	LF
30" C905 STORM DRAIN	43	LF
24" RCP STORM DRAIN	773	LF
30" RCP STORM DRAIN	413	LF
60" NDOT TYPE 1 MH	7	EA
NDOT TYPE III INLET	2	EA

ALL GRADING WORK SHALL BE IN STRICT ACCORDANCE WITH THE SOILS REPORT FOR THE SITE ENTITLED "PROPOSED COMMERCIAL DEVELOPMENT SOUTH CORNER OF DURANGO DR. AND FARM RD."

PROJECT NO.: 4125X0130, DATED DECEMBER 22, 2015

PREPARED BY:

WESTERN TECHNOLOGIES INC.
6633 WEST POST ROAD
LAS VEGAS, NV 89118
PHONE NO. (702) 798-8050
FAX NO. (702) 798-7664

ALL WORK SHALL BE PERFORMED UNDER THE DIRECTION OF A REGISTERED PROFESSIONAL ENGINEER.

I CERTIFY THAT THIS GRADING PLAN CONFORMS TO THE THE APPROVED DRAINAGE STUDY FOR THIS SITE ON FILE WITH THE CITY OF LAS VEGAS. (DS 4710A)

THOMAS D. MILLER, P.E. 15776

DATE: 5-1-17

107V6734

GENERAL NOTE:

IT IS THE CONTRACTOR'S RESPONSIBILITY TO FILE A NOTICE OF INTENT/REQUEST TO BE INCLUDED IN THE STORM WATER GENERAL PERMIT, AND SUBMIT THE ASSOCIATED STORM WATER POLLUTION PREVENTION PLAN (SWPPP) AS REQUIRED BY FEDERAL, AND MONITORED BY THE NEVADA DIVISION OF ENVIRONMENTAL PROTECTION.

NOTE:

PROPERTY OWNER IS RESPONSIBLE TO MAINTAIN THE BEST MANAGEMENT PRACTICES SUCH AS BUT NOT LIMITED TO THE REMOVAL OF ACCUMULATED SEDIMENT AND DEBRIS AND CARE OF THE VEGETATION.

NDOT NOTE:

NDOT PERMIT REQUIRED. CONTRACTOR TO OBTAIN NDOT OCCUPANCY PERMIT PRIOR TO CONSTRUCTION IN NDOT RIGHT OF WAY

CALL BEFORE YOU DIG
AVOID CUTTING UNDERGROUND UTILITY LINES. IT'S COSTLY.

Call before you dig
Underground
1-702-432-5300
FREEMAN AND ARTERIAL SYSTEM OF TRANSPORTATION

1-800-227-2600

AVOID HITTING OVERHEAD POWER LINES. IT'S COSTLY.

Call before you dig
Overhead
1-702-227-2929

COLLINS ENGINEERS ASSUMES NO RESPONSIBILITY FOR EXISTING UTILITY LOCATIONS AND ELEVATIONS. THE UTILITIES SHOWN ON THIS DRAWING HAVE BEEN PLOTTED FROM THE BEST AVAILABLE INFORMATION. IT IS, HOWEVER, THE CONTRACTOR'S RESPONSIBILITY TO FIELD VERIFY THE LOCATION AND ELEVATION OF ALL UTILITIES PRIOR TO THE COMMENCEMENT OF ANY CONSTRUCTION. CONTRACTOR TO FIELD VERIFY ALL EXISTING SITE CONDITIONS PRIOR TO CONSTRUCTION. IF A CONFLICT EXISTS BETWEEN WHAT IS SHOWN ON THESE DRAWINGS AND WHAT EXISTS IN THE FIELD, THE CONTRACTOR IS TO NOTIFY THE ARCHITECT OR ENGINEER IMMEDIATELY.

LEGEND

EXISTING	PROPOSED	DESCRIPTION
---	---	ELEVATION TAG
---	---	TELEPHONE LINE
---	---	WATER LINE
---	---	SANITARY SEWER LINE
---	---	STORM SEWER LINE
---	---	GAS LINE
---	---	STORM MANHOLE
---	---	POWER LINE/POLE
---	---	RETAINING WALL
---	---	SCREEN WALL
---	---	UTILITY POLE
---	---	STREET LIGHT
---	---	PL-ADJACENT CENTERLINE EASEMENT LINE
---	---	FLOW LINE
---	---	SAWTOOTH LINE
---	---	AREA LIGHT
---	---	WATER METER
---	---	AC PAVEMENT
---	---	6" TYPE 'A' CURB
---	---	24" TYPE 'L' CURB & GUTTER
---	---	30" ROLL CURB
---	---	BACK WATER VALVE
---	---	FIRE HYDRANT CONNECTION
---	---	WATER VALVE
---	---	REDUCER
---	---	SEWER MANHOLE
---	---	CLEANOUT
---	---	GAS VALVE

COLLINS ENGINEERS
3130 S DURANGO DR. SUITE 404
LAS VEGAS, NV 89117
PHONE: (702) 248-8000
FAX: (702) 248-8070
www.collinsengr.com

PROFESSIONAL ENGINEER
STATE OF NEVADA
THOMAS D. MILLER
EXP. 12-31-17
CIVIL
NO. 15776

IMPROVEMENT PLANS FOR DC PLAZA
APN: 125-17-613-001
FARM ROAD OFF-SITE GRADING PLAN & PROFILE

CEI PROJECT: 4136
DESIGN BY: JDM SR
DRAWN BY: JDM SR
CHECKED BY: TOM P.E.
DATE: 03/13/17
SCALE: 1"=30'
SHEET NUMBER
C4.07
SHEET 13 OF 45
H # 64486