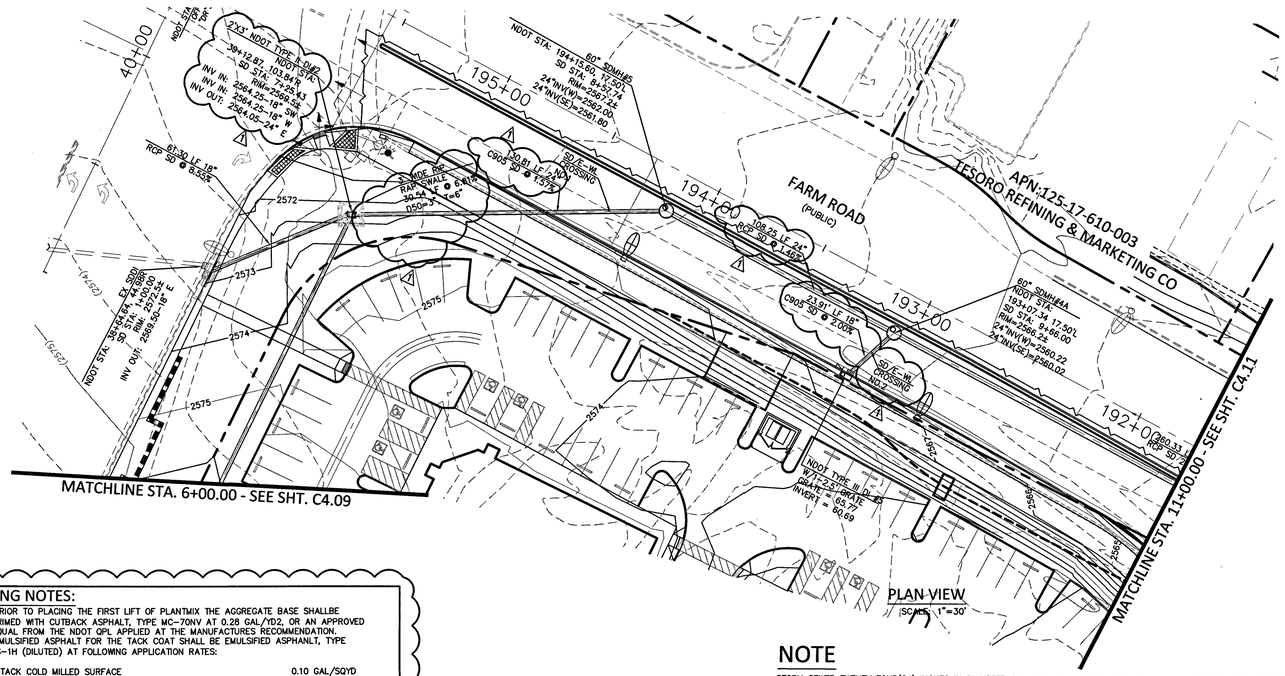
MATCHLINE STA. 6+00.00 - SEE SHT. C4.09
MATCHLINE STA. 11+00.00 - SEE SHT. C4.11
FARM ROAD
(PUBLIC)
APN:125-17-610-003
TESORO REFINING & MARKETING CO
195+00
194+00
193+00
192+00
40+00
2572
2573
2574
2575
