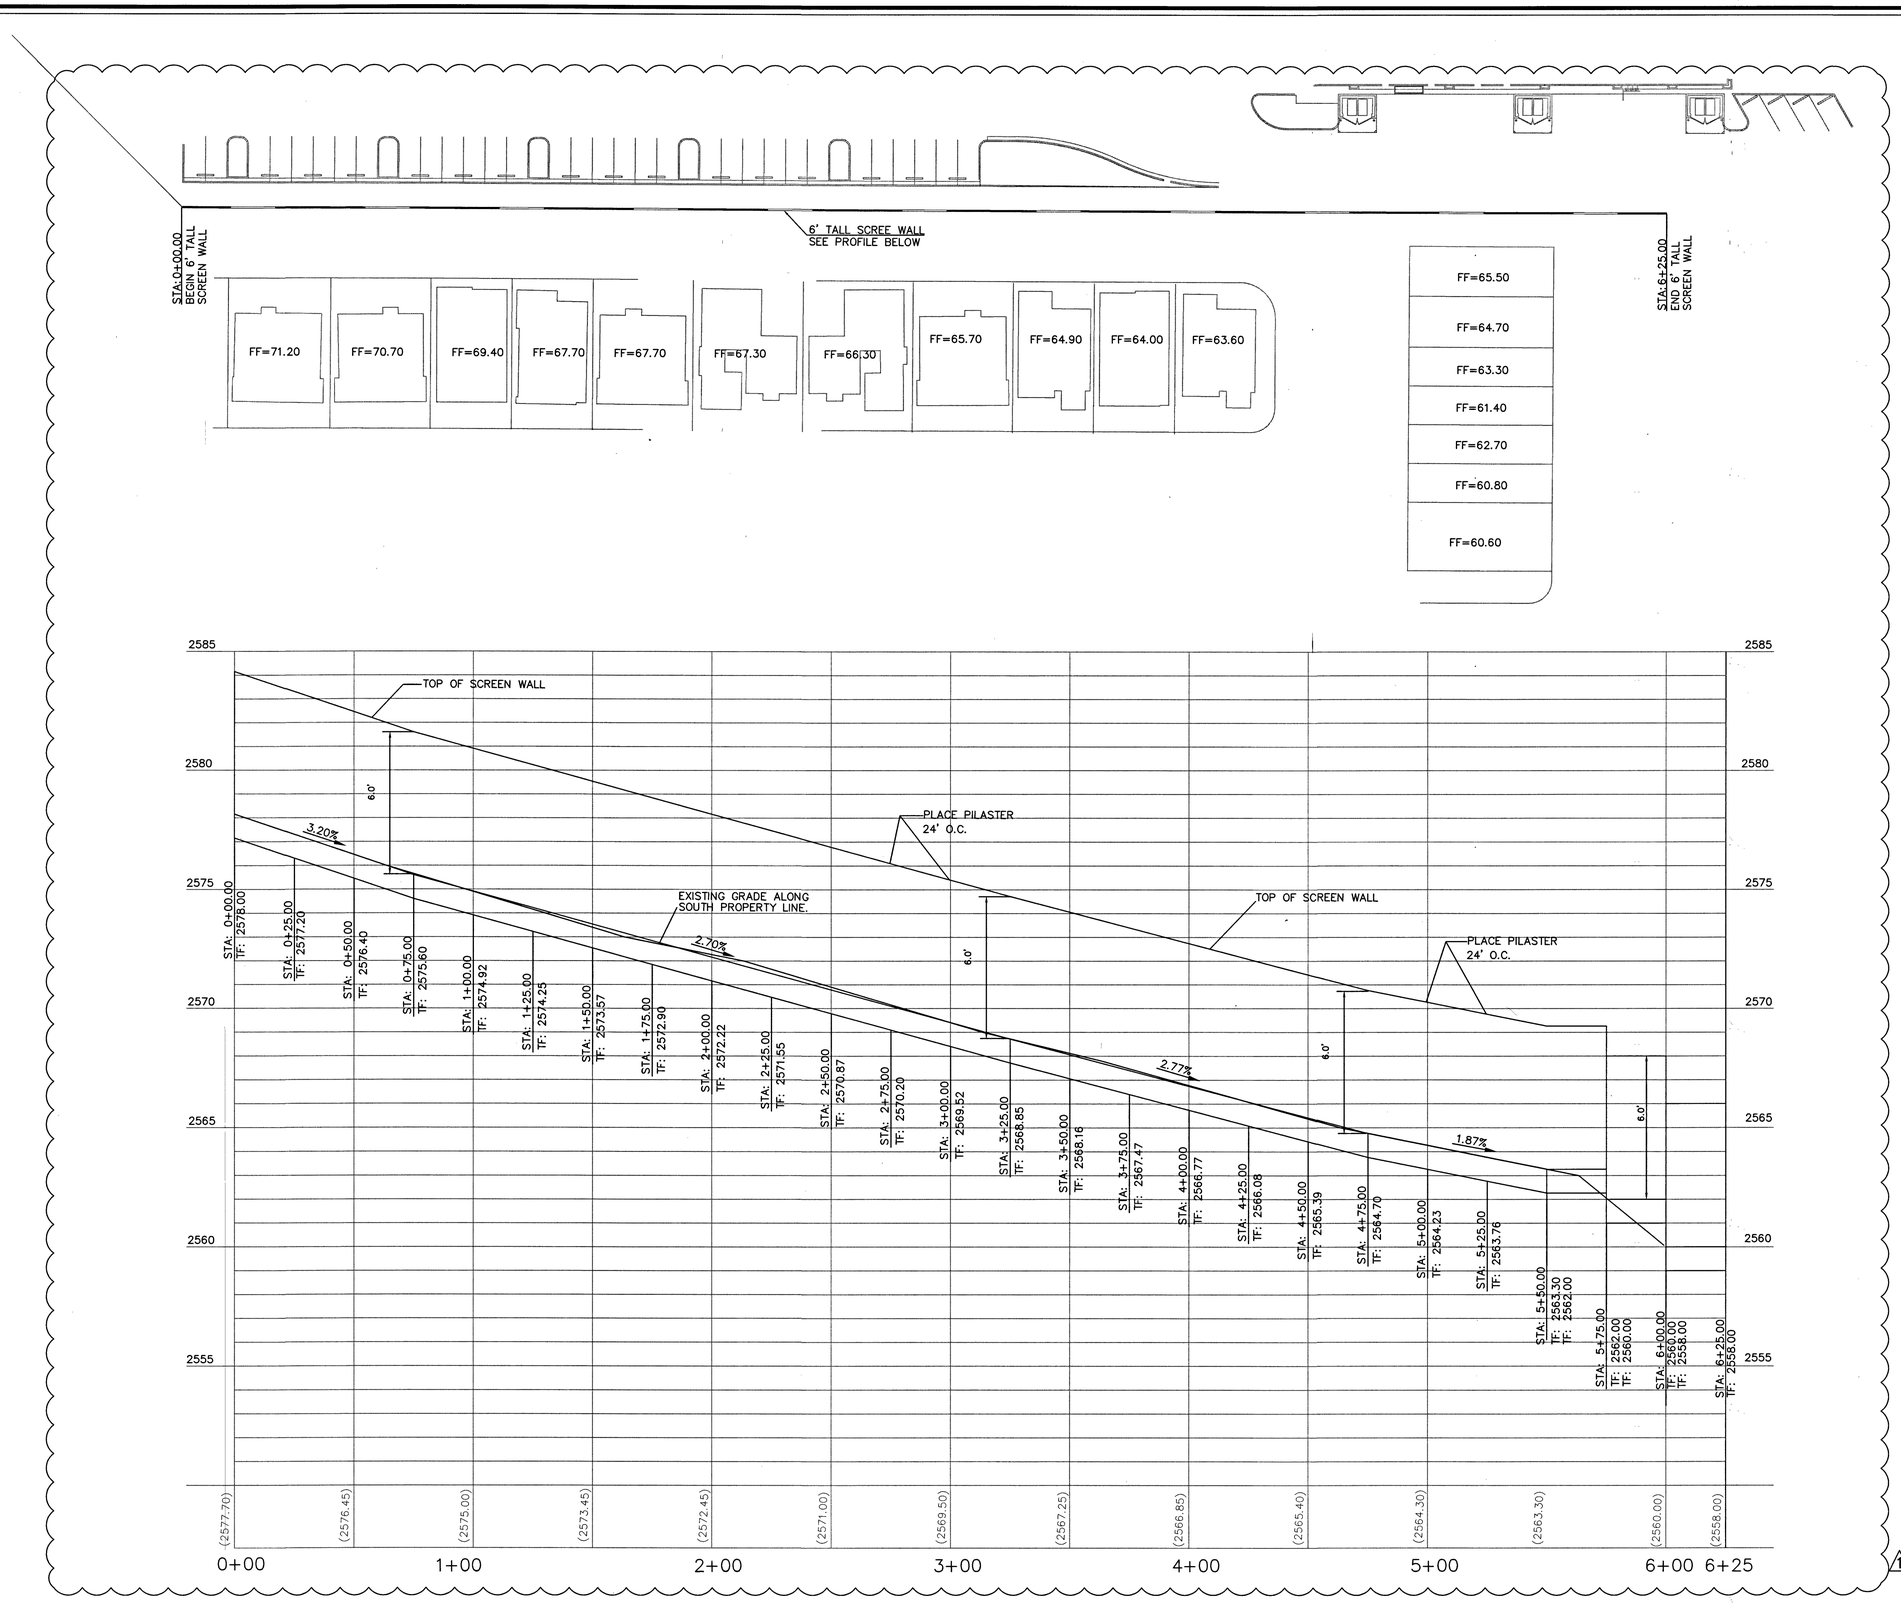

COLLINS ENGINEERS
3130 S. DURANGO DR., SUITE 404
LAS VEGAS, NV 89117
PHONE: (702) 248-8000
FAX: (702) 248-8070
www.collinsengr.com

PROFESSIONAL ENGINEER STATE OF NEVADA
THOMAS D. MILLER
EXP. 12-31-17
CIVIL
NO. 15776

IMPROVEMENT PLANS FOR DC PLAZA

APN:125-17-613-001

PLAN & PROFILE SCREEN WALL AT SOUTH PROPERTY LINE

8451 FARM ROAD
LAS VEGAS, NEVADA

NO.	DATE	DESIGN BY	DESCRIPTION
1	01-15-17	APPROVED SLH	NEW SHEET- SCREEN WALL PROFILE

CEI PROJECT:	4136
DESIGN BY:	JDM SR
DRAWN BY:	JDM SR
CHECKED BY:	TDM P.E.
DATE:	03/13/17
SCALE:	1"=30'
SHEET NUMBER	C8.06
SHEET 37 OF 45	
H # 64486	

10746734

H:\CAD\LAND\4136-DELTA\DWG\SHEETS\4136-C8.01-DET-D.DWG 04/28/2017 01:33:43 PM