

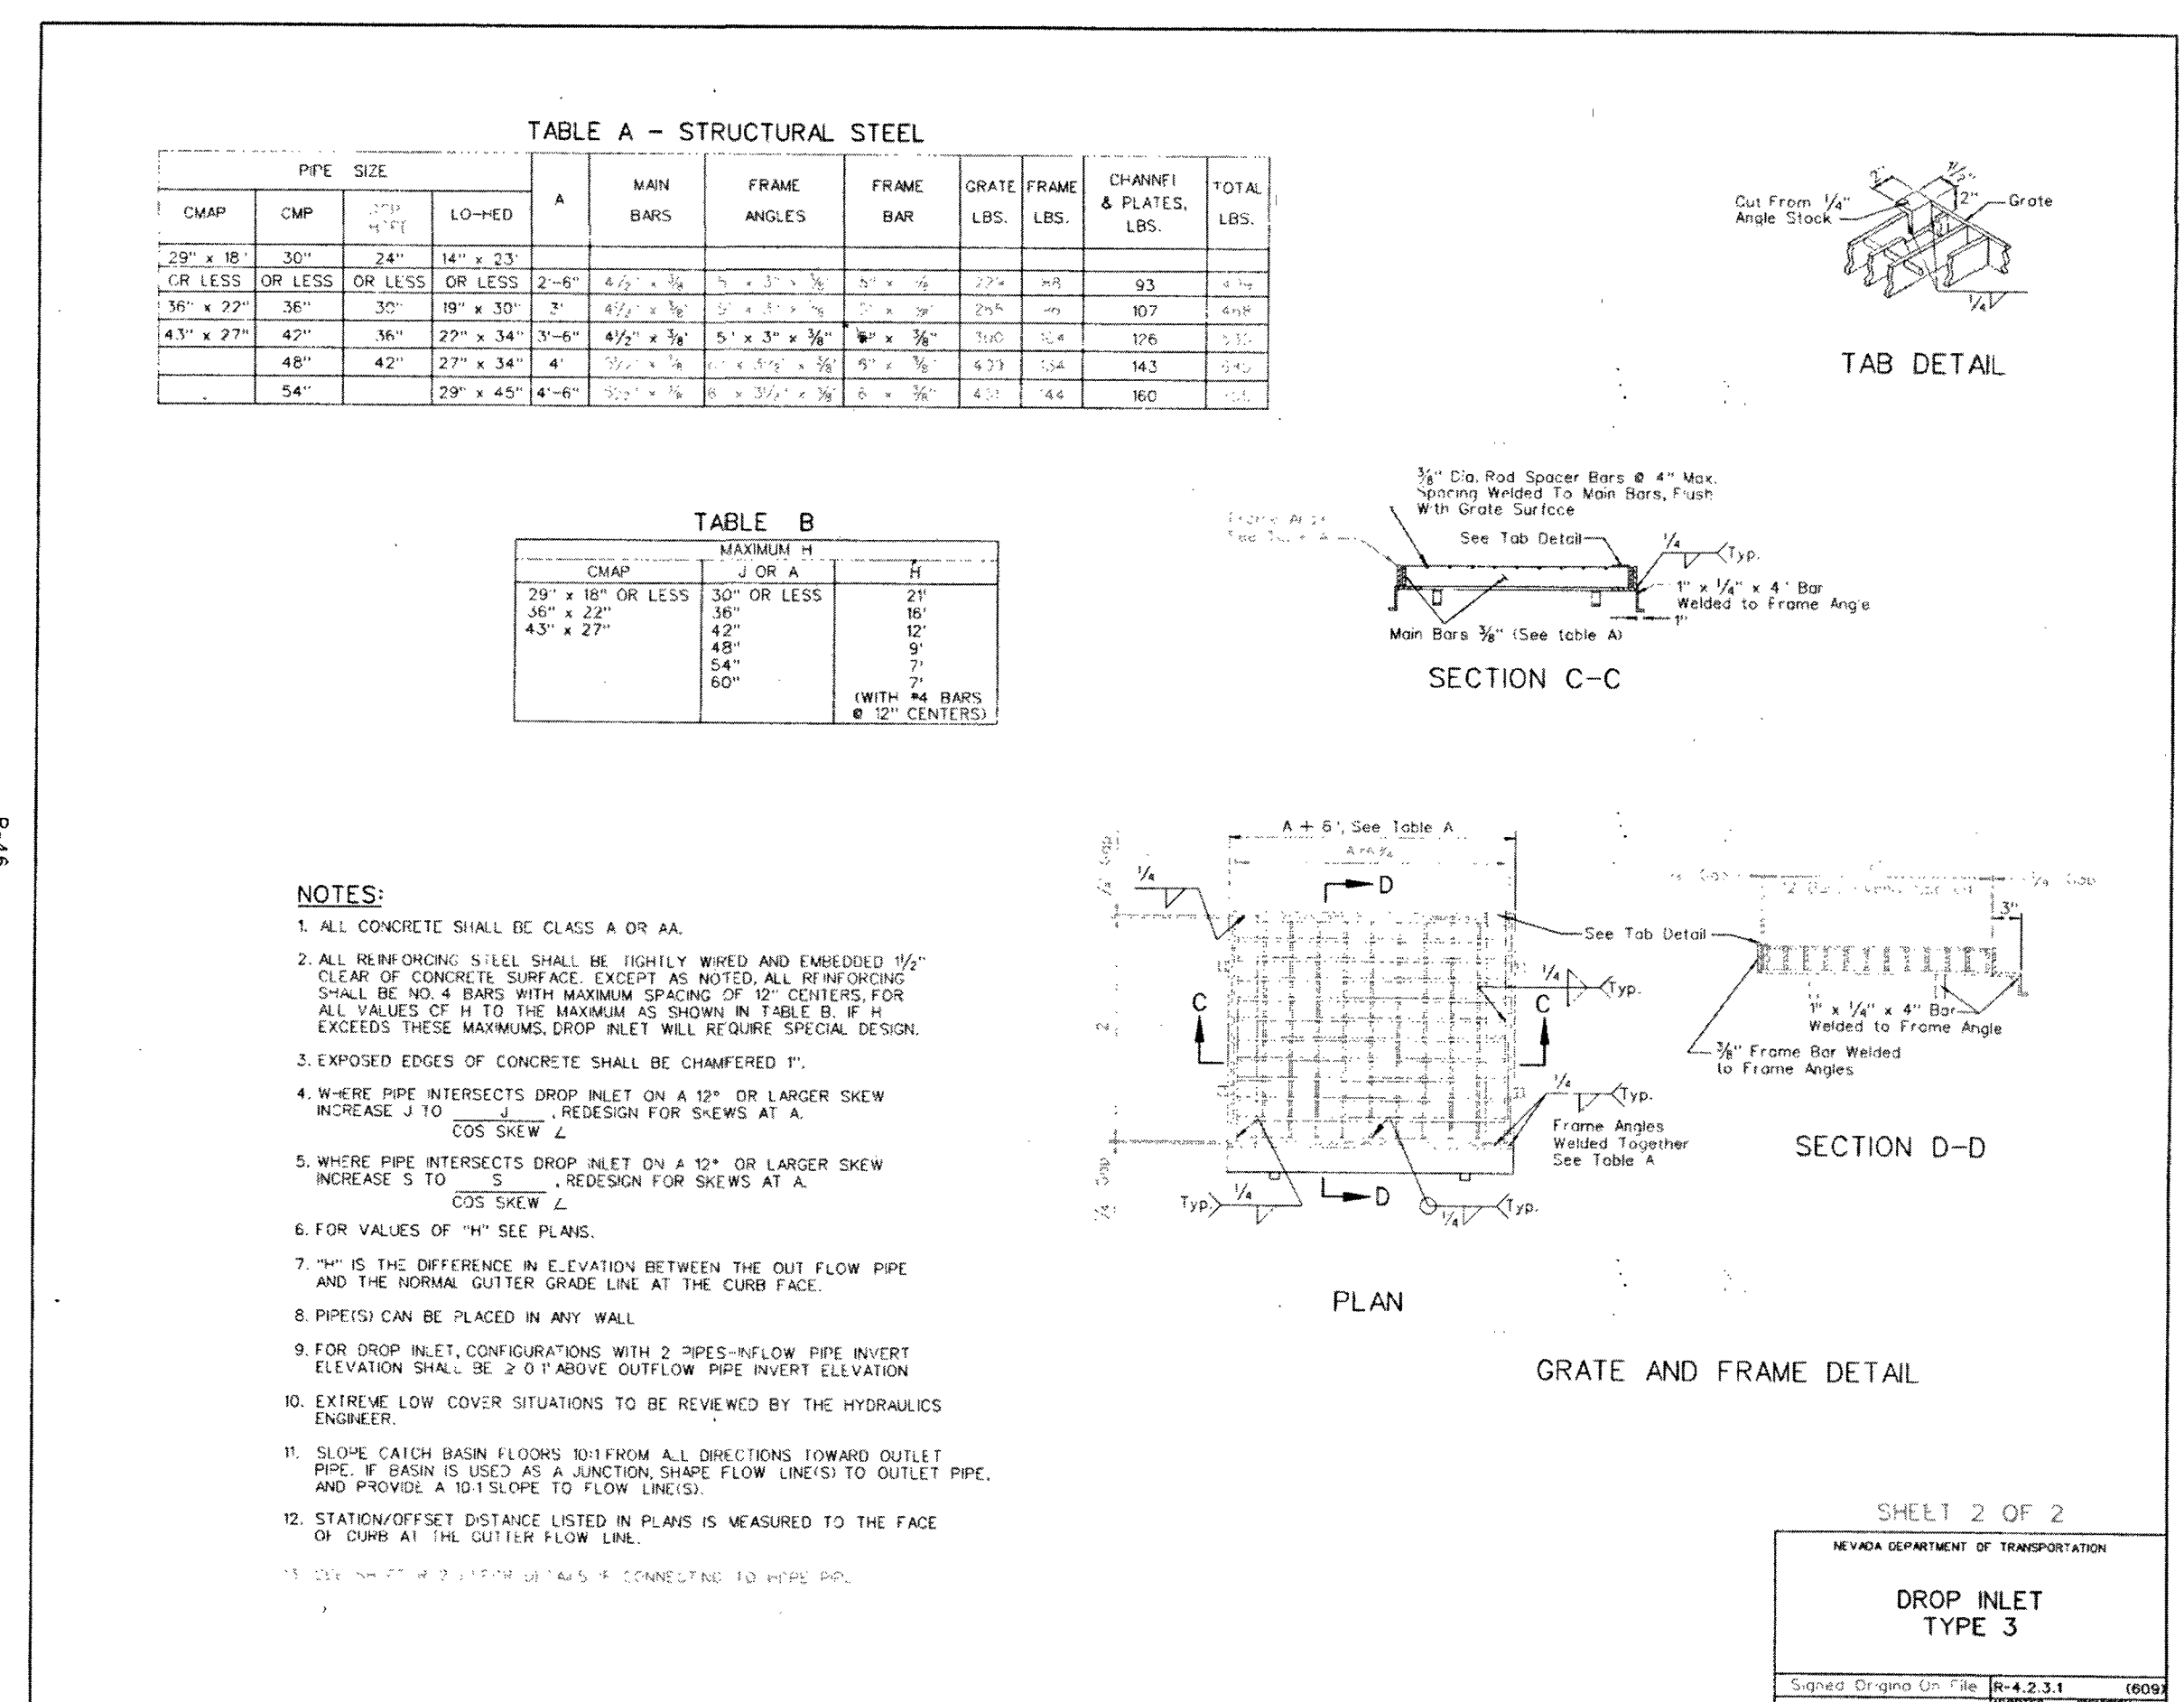
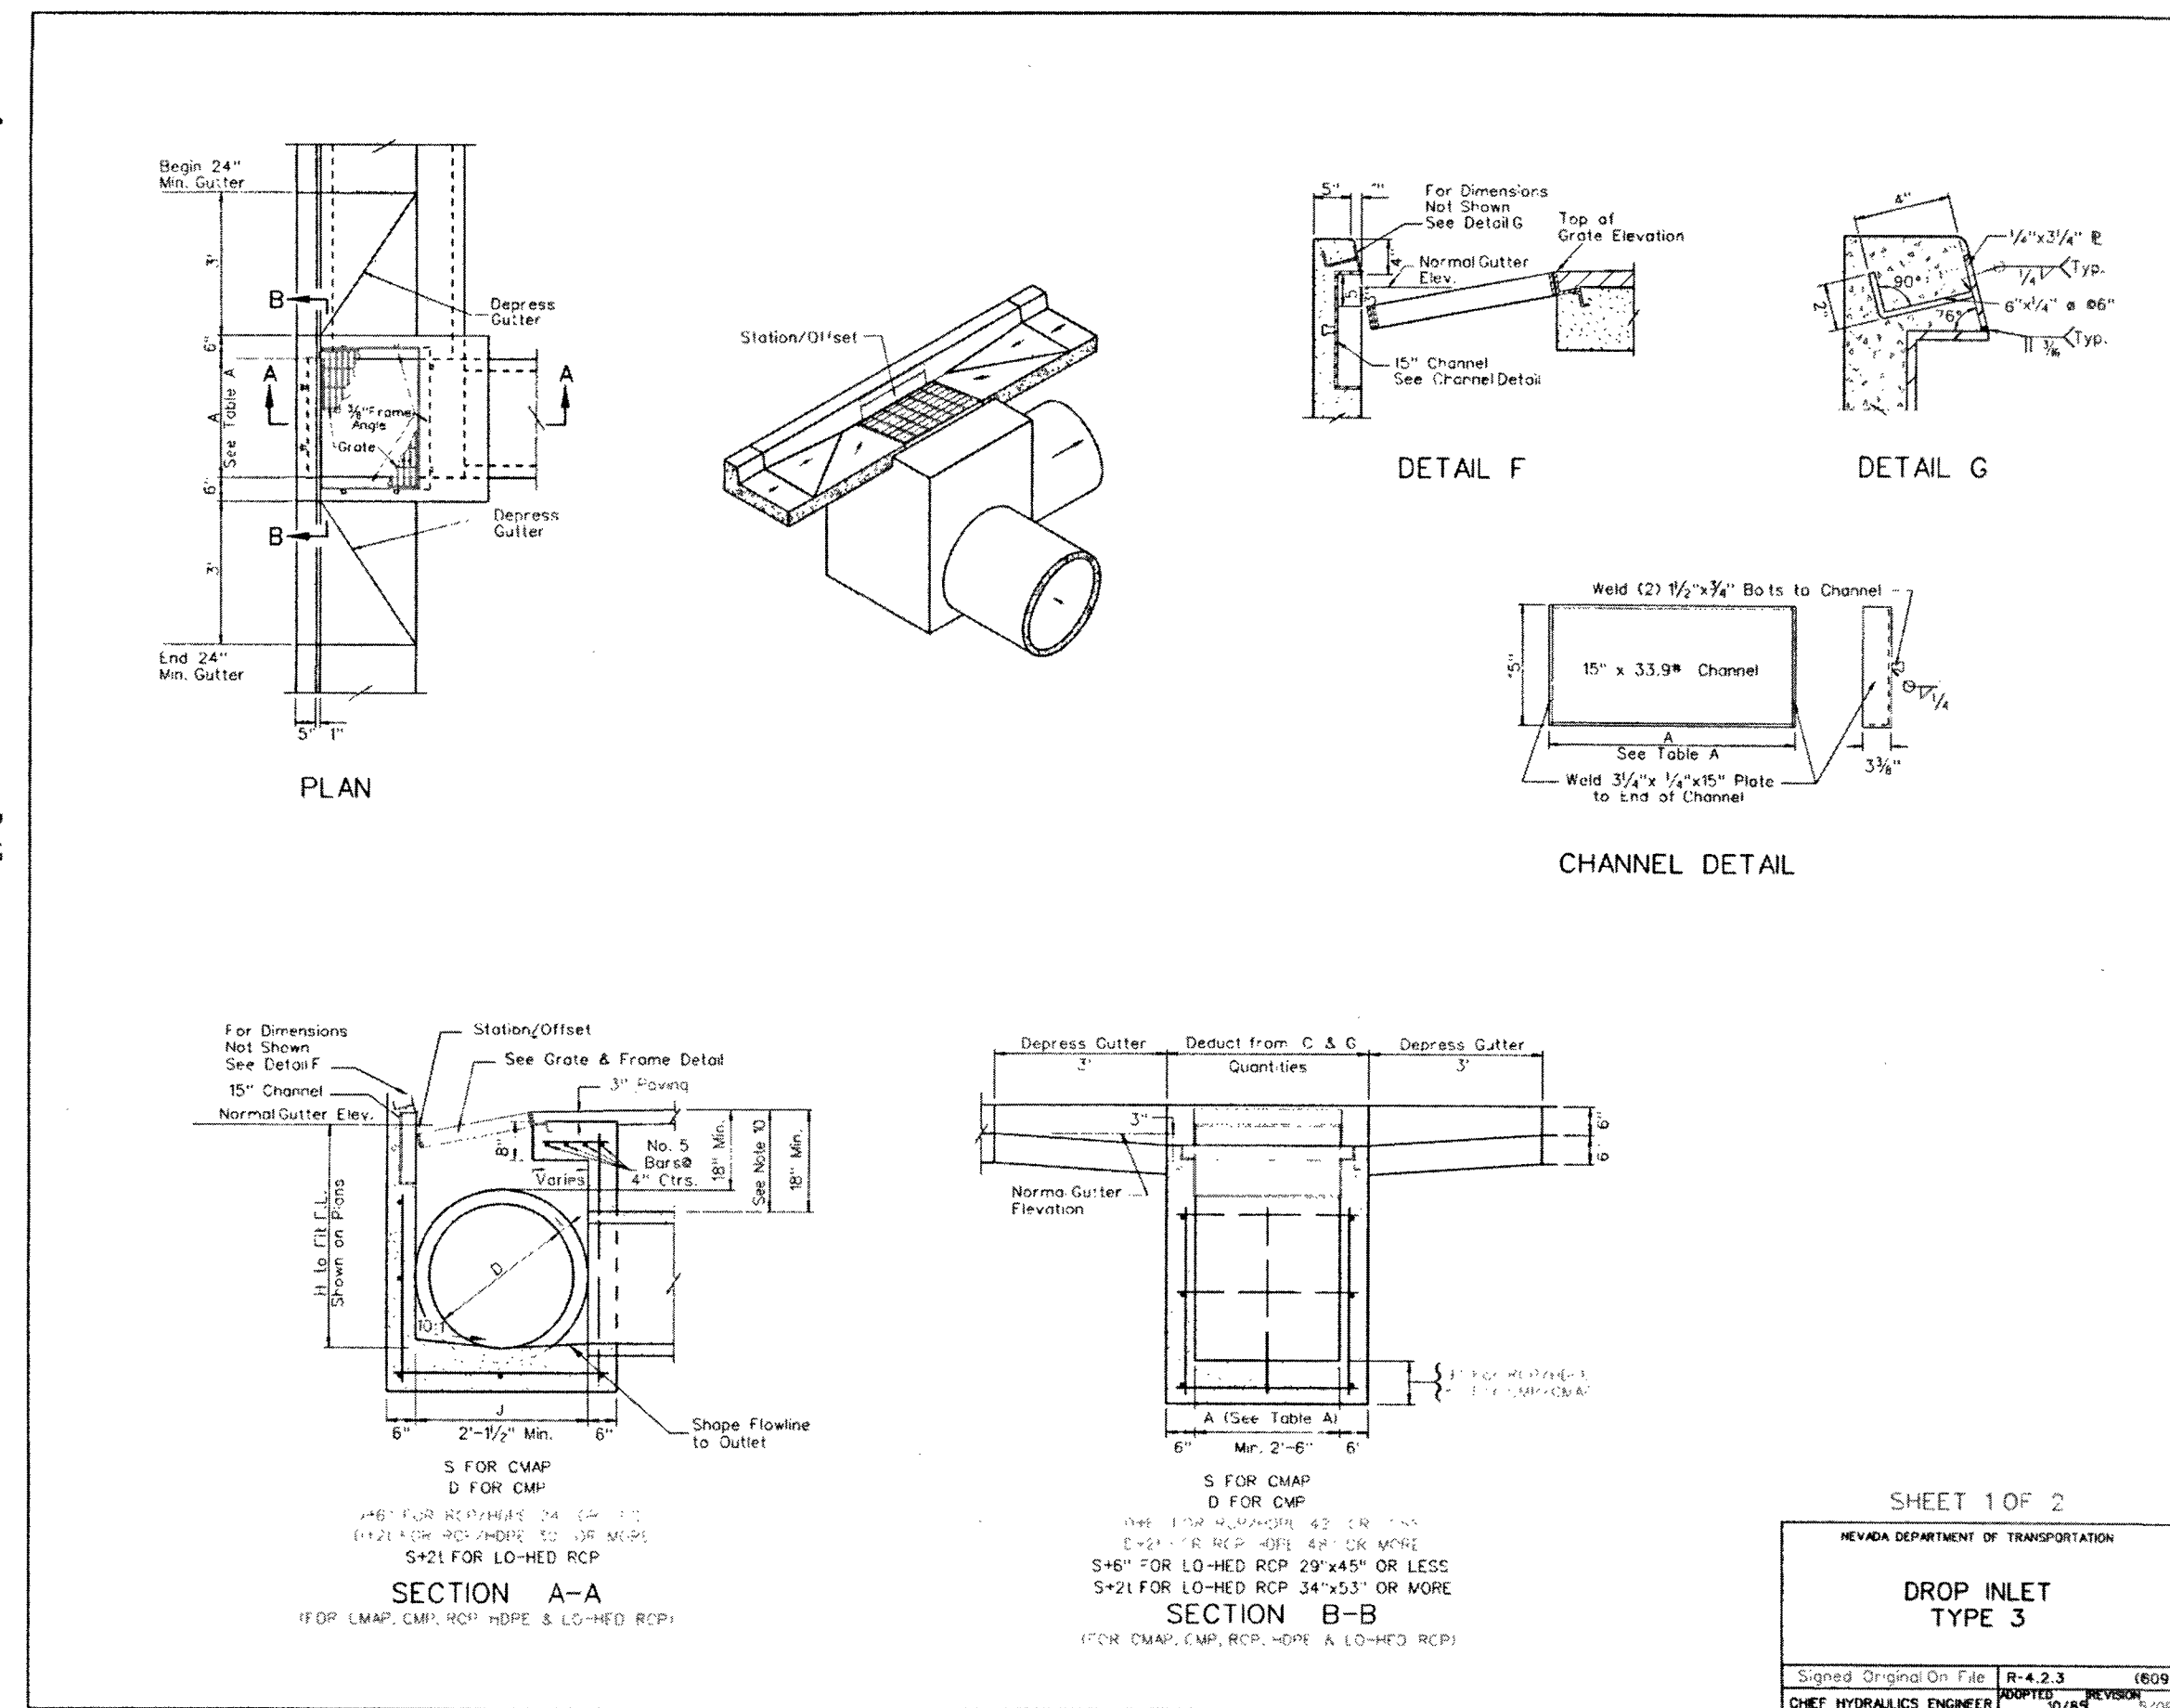
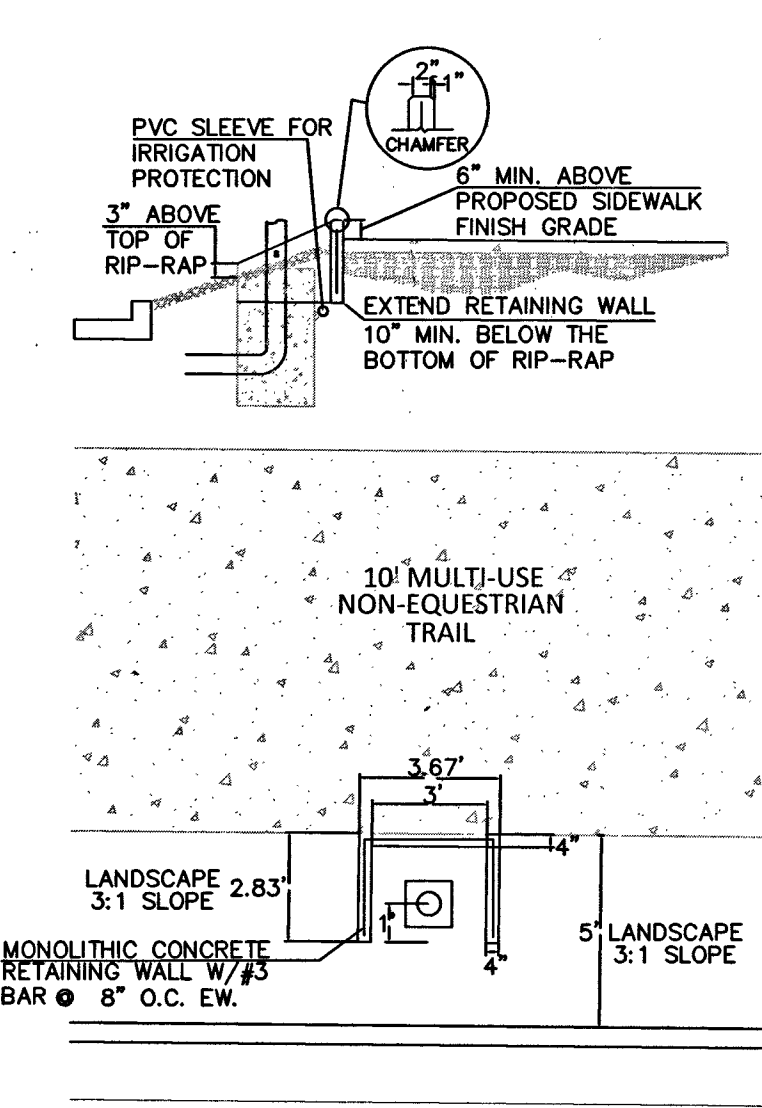
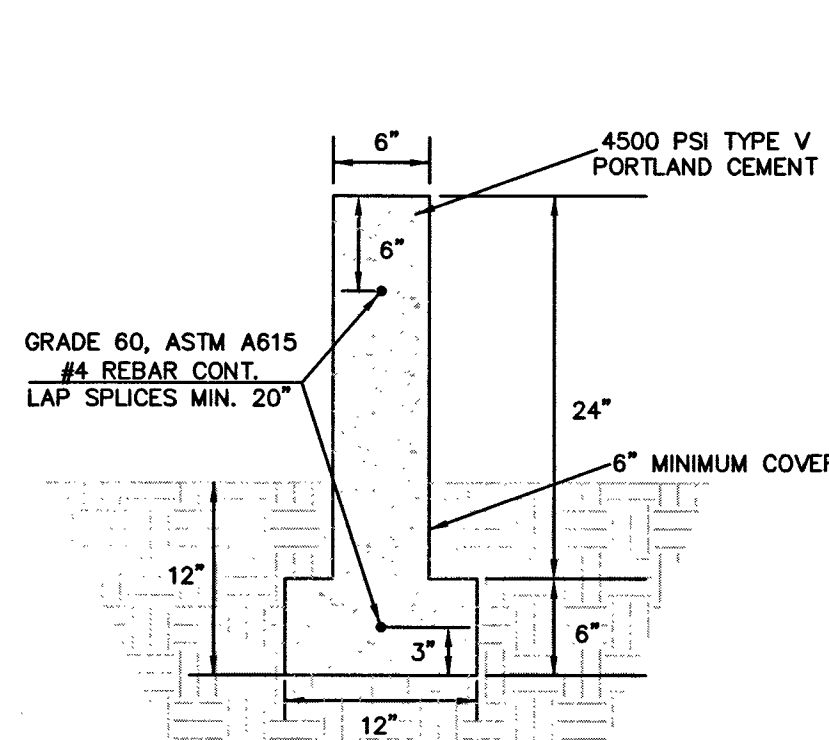


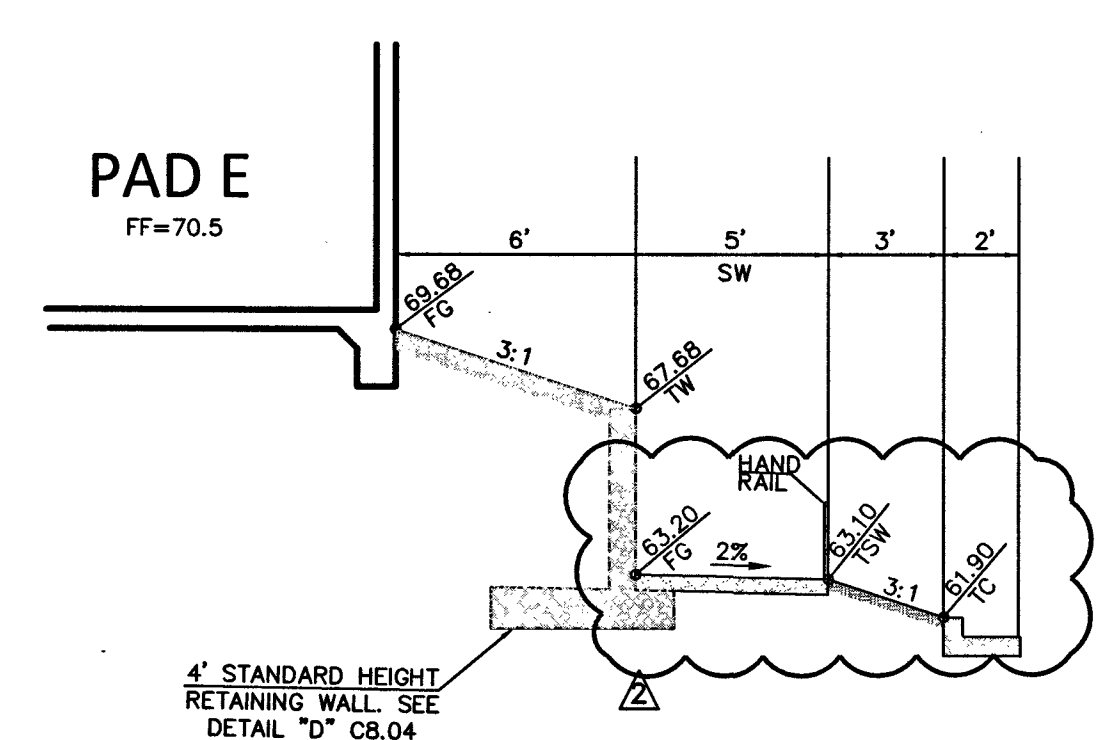

G C8.03 TYPE 3 DROP INLET NTS

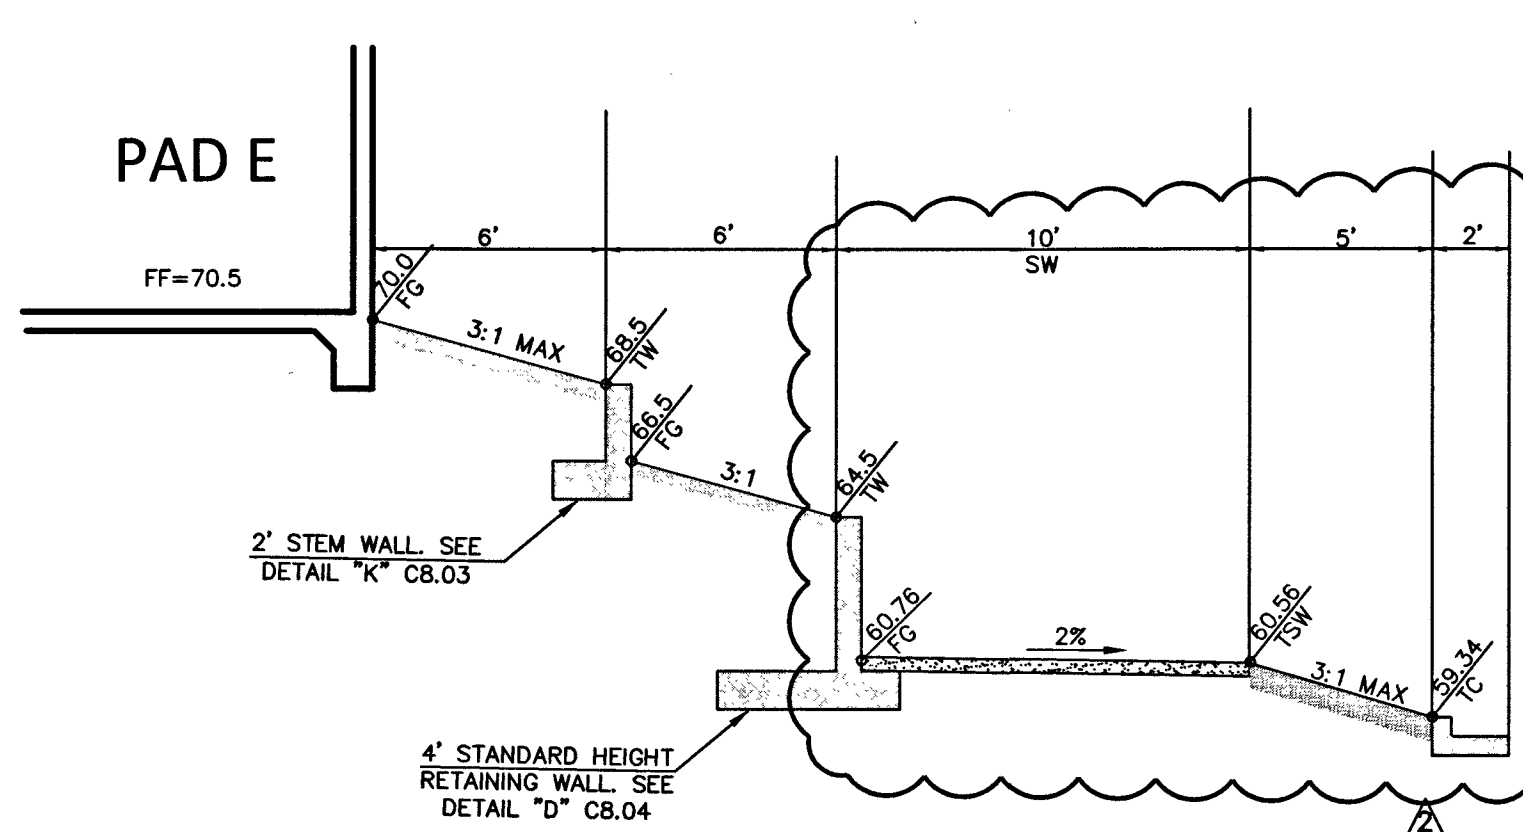

COLLINS ENGINEERS
3130 S. DURANGO DR., SUITE 404
LAS VEGAS, NV 89117
PHONE: (702) 248-8000
FAX: (702) 248-8070
www.collinsengr.com

PROFESSIONAL ENGINEER - STATE OF NEVADA
THOMAS D. MILLER
No. 15776
12-14-17

IMPROVEMENT PLANS FOR DC PLAZA
APN: 125-17-613-001

DETAIL SHEET
8451 FARM ROAD
LAS VEGAS, NEVADA

DESCRIPTION		DESIGN BY	
REVISED DETAILS "H", "J", "K" & "L"		REVISED DETAILS "H", "J", "K" & "L"	
NO.		DATE	
1		01-15-17	
2		11-30-17	

CEI PROJECT: 4136
DESIGN BY: JDM SR
DRAWN BY: JDM SR
CHECKED BY: TDM P.E.

DATE: 03/13/17
SCALE: 1"=30'
SHEET NUMBER
C8.03
107V6734
SHEET 34 OF 45
H # 64486