
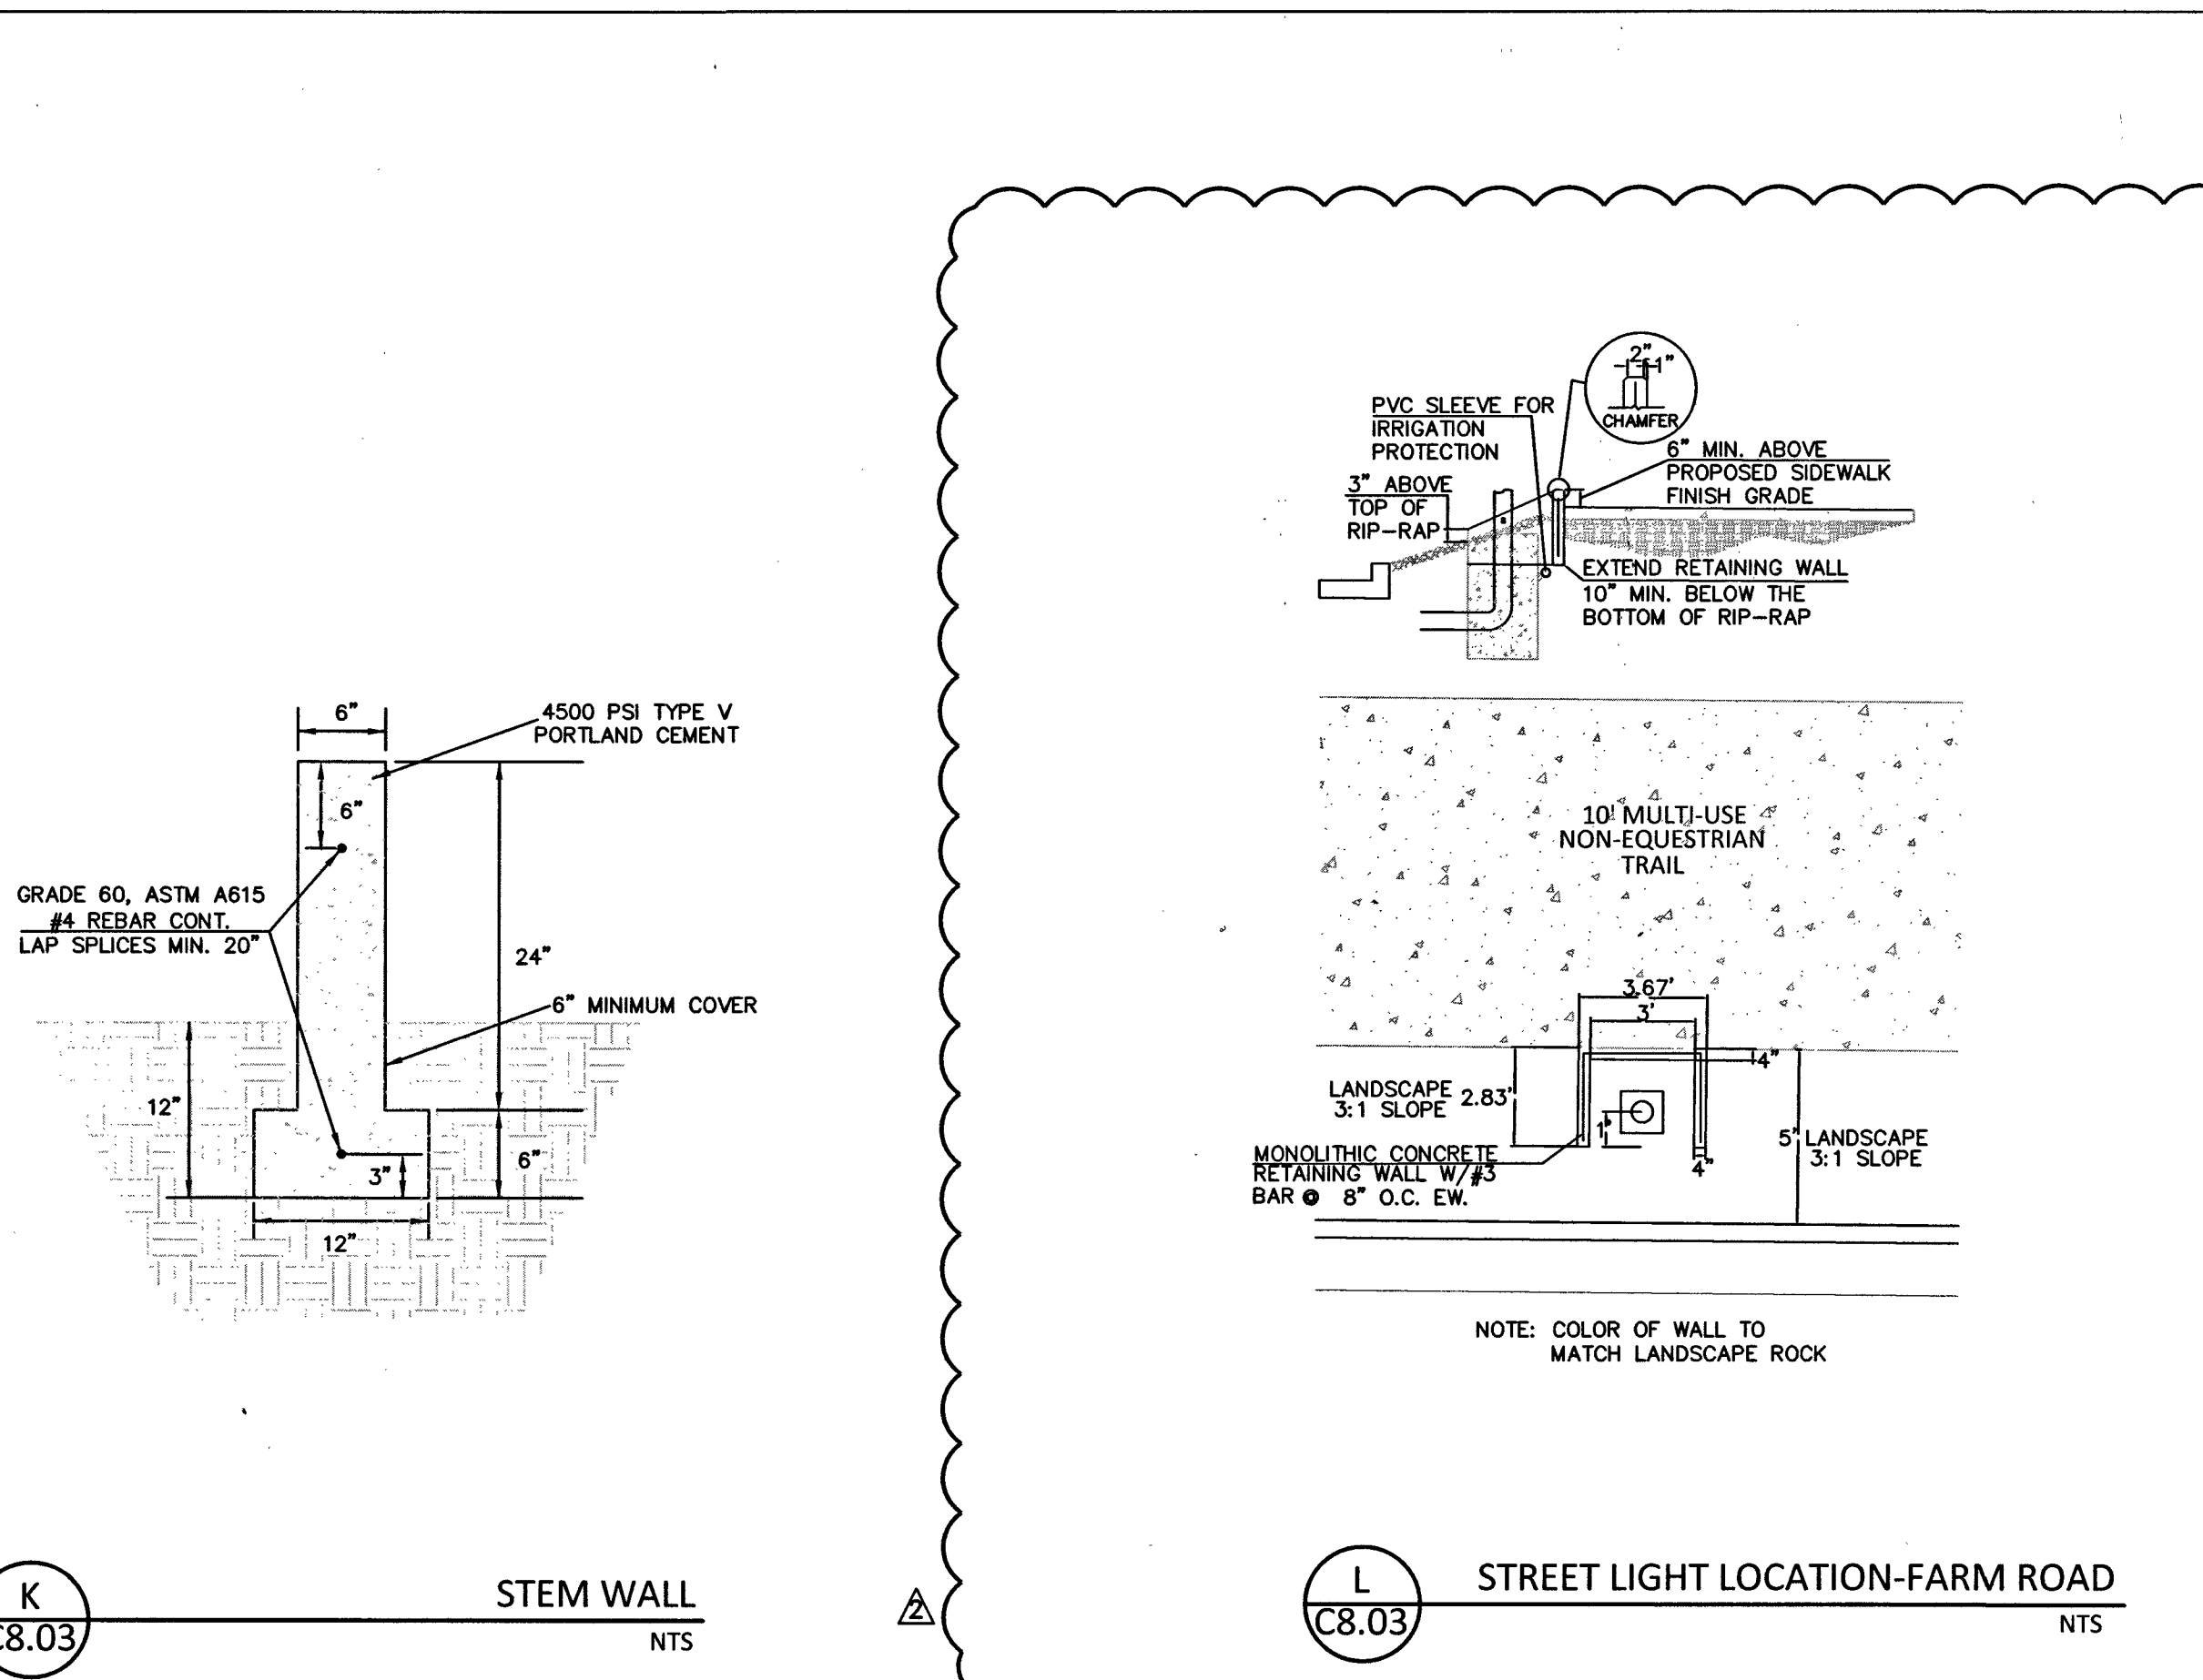
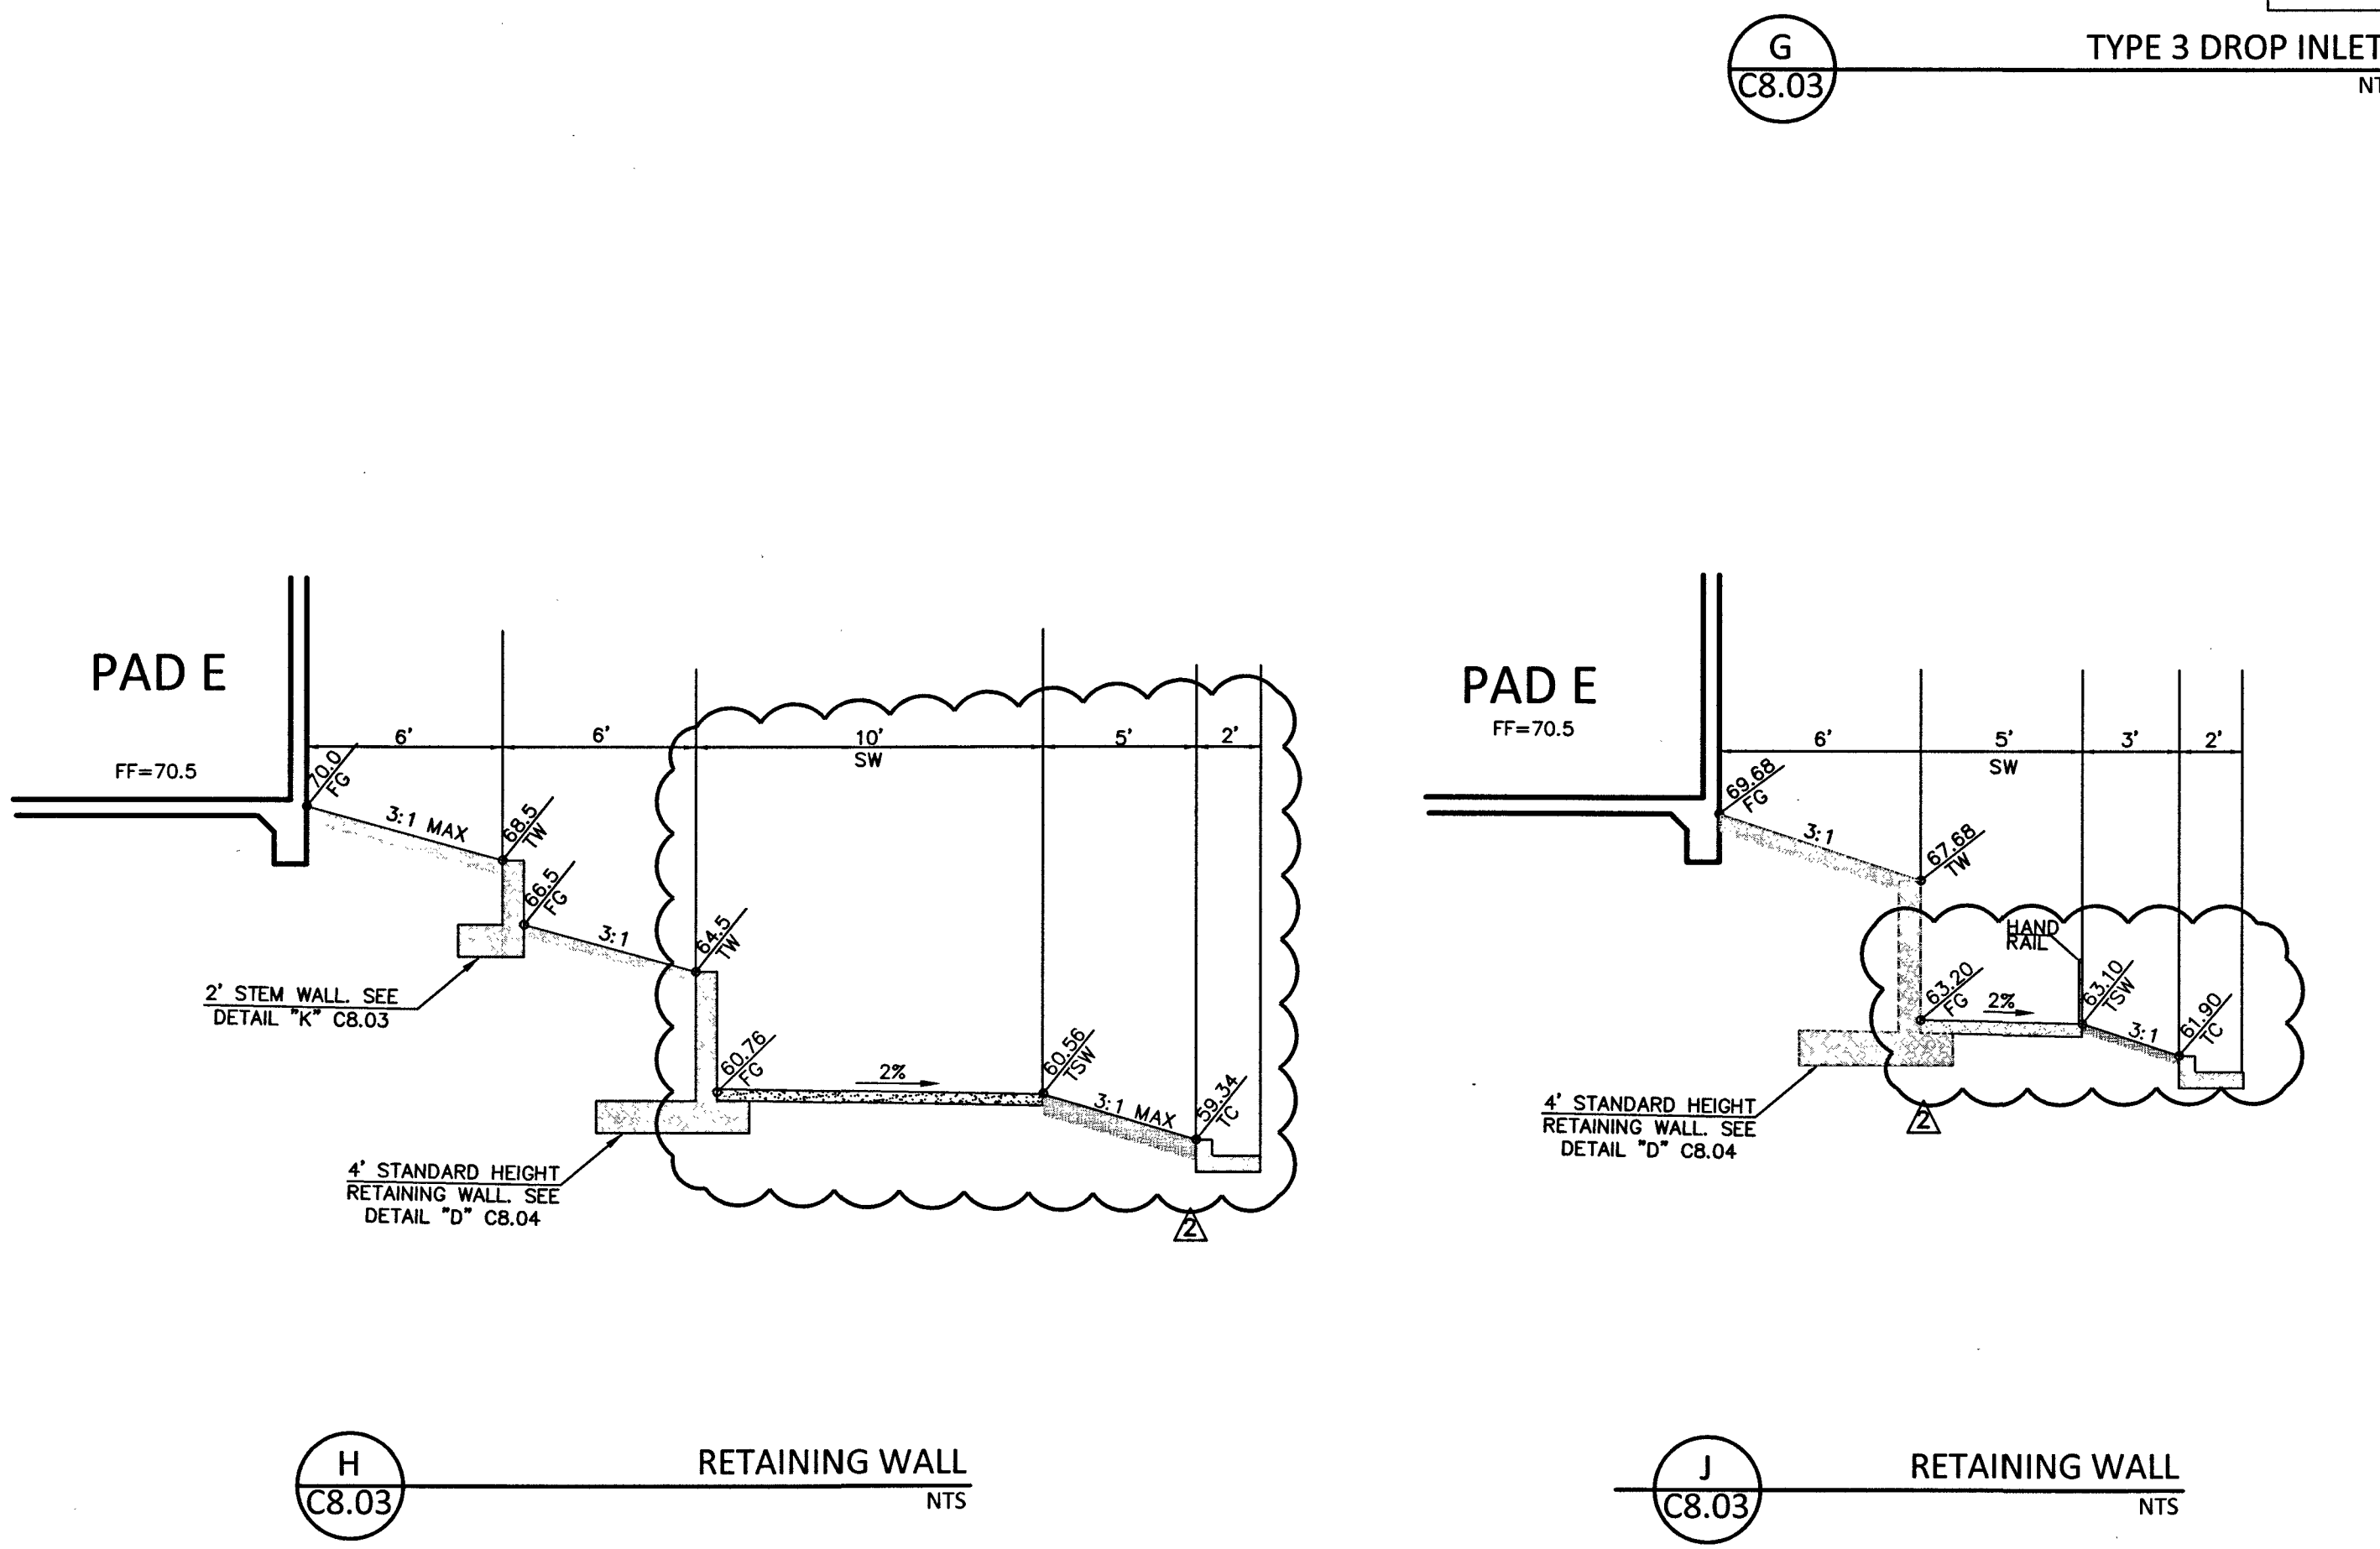
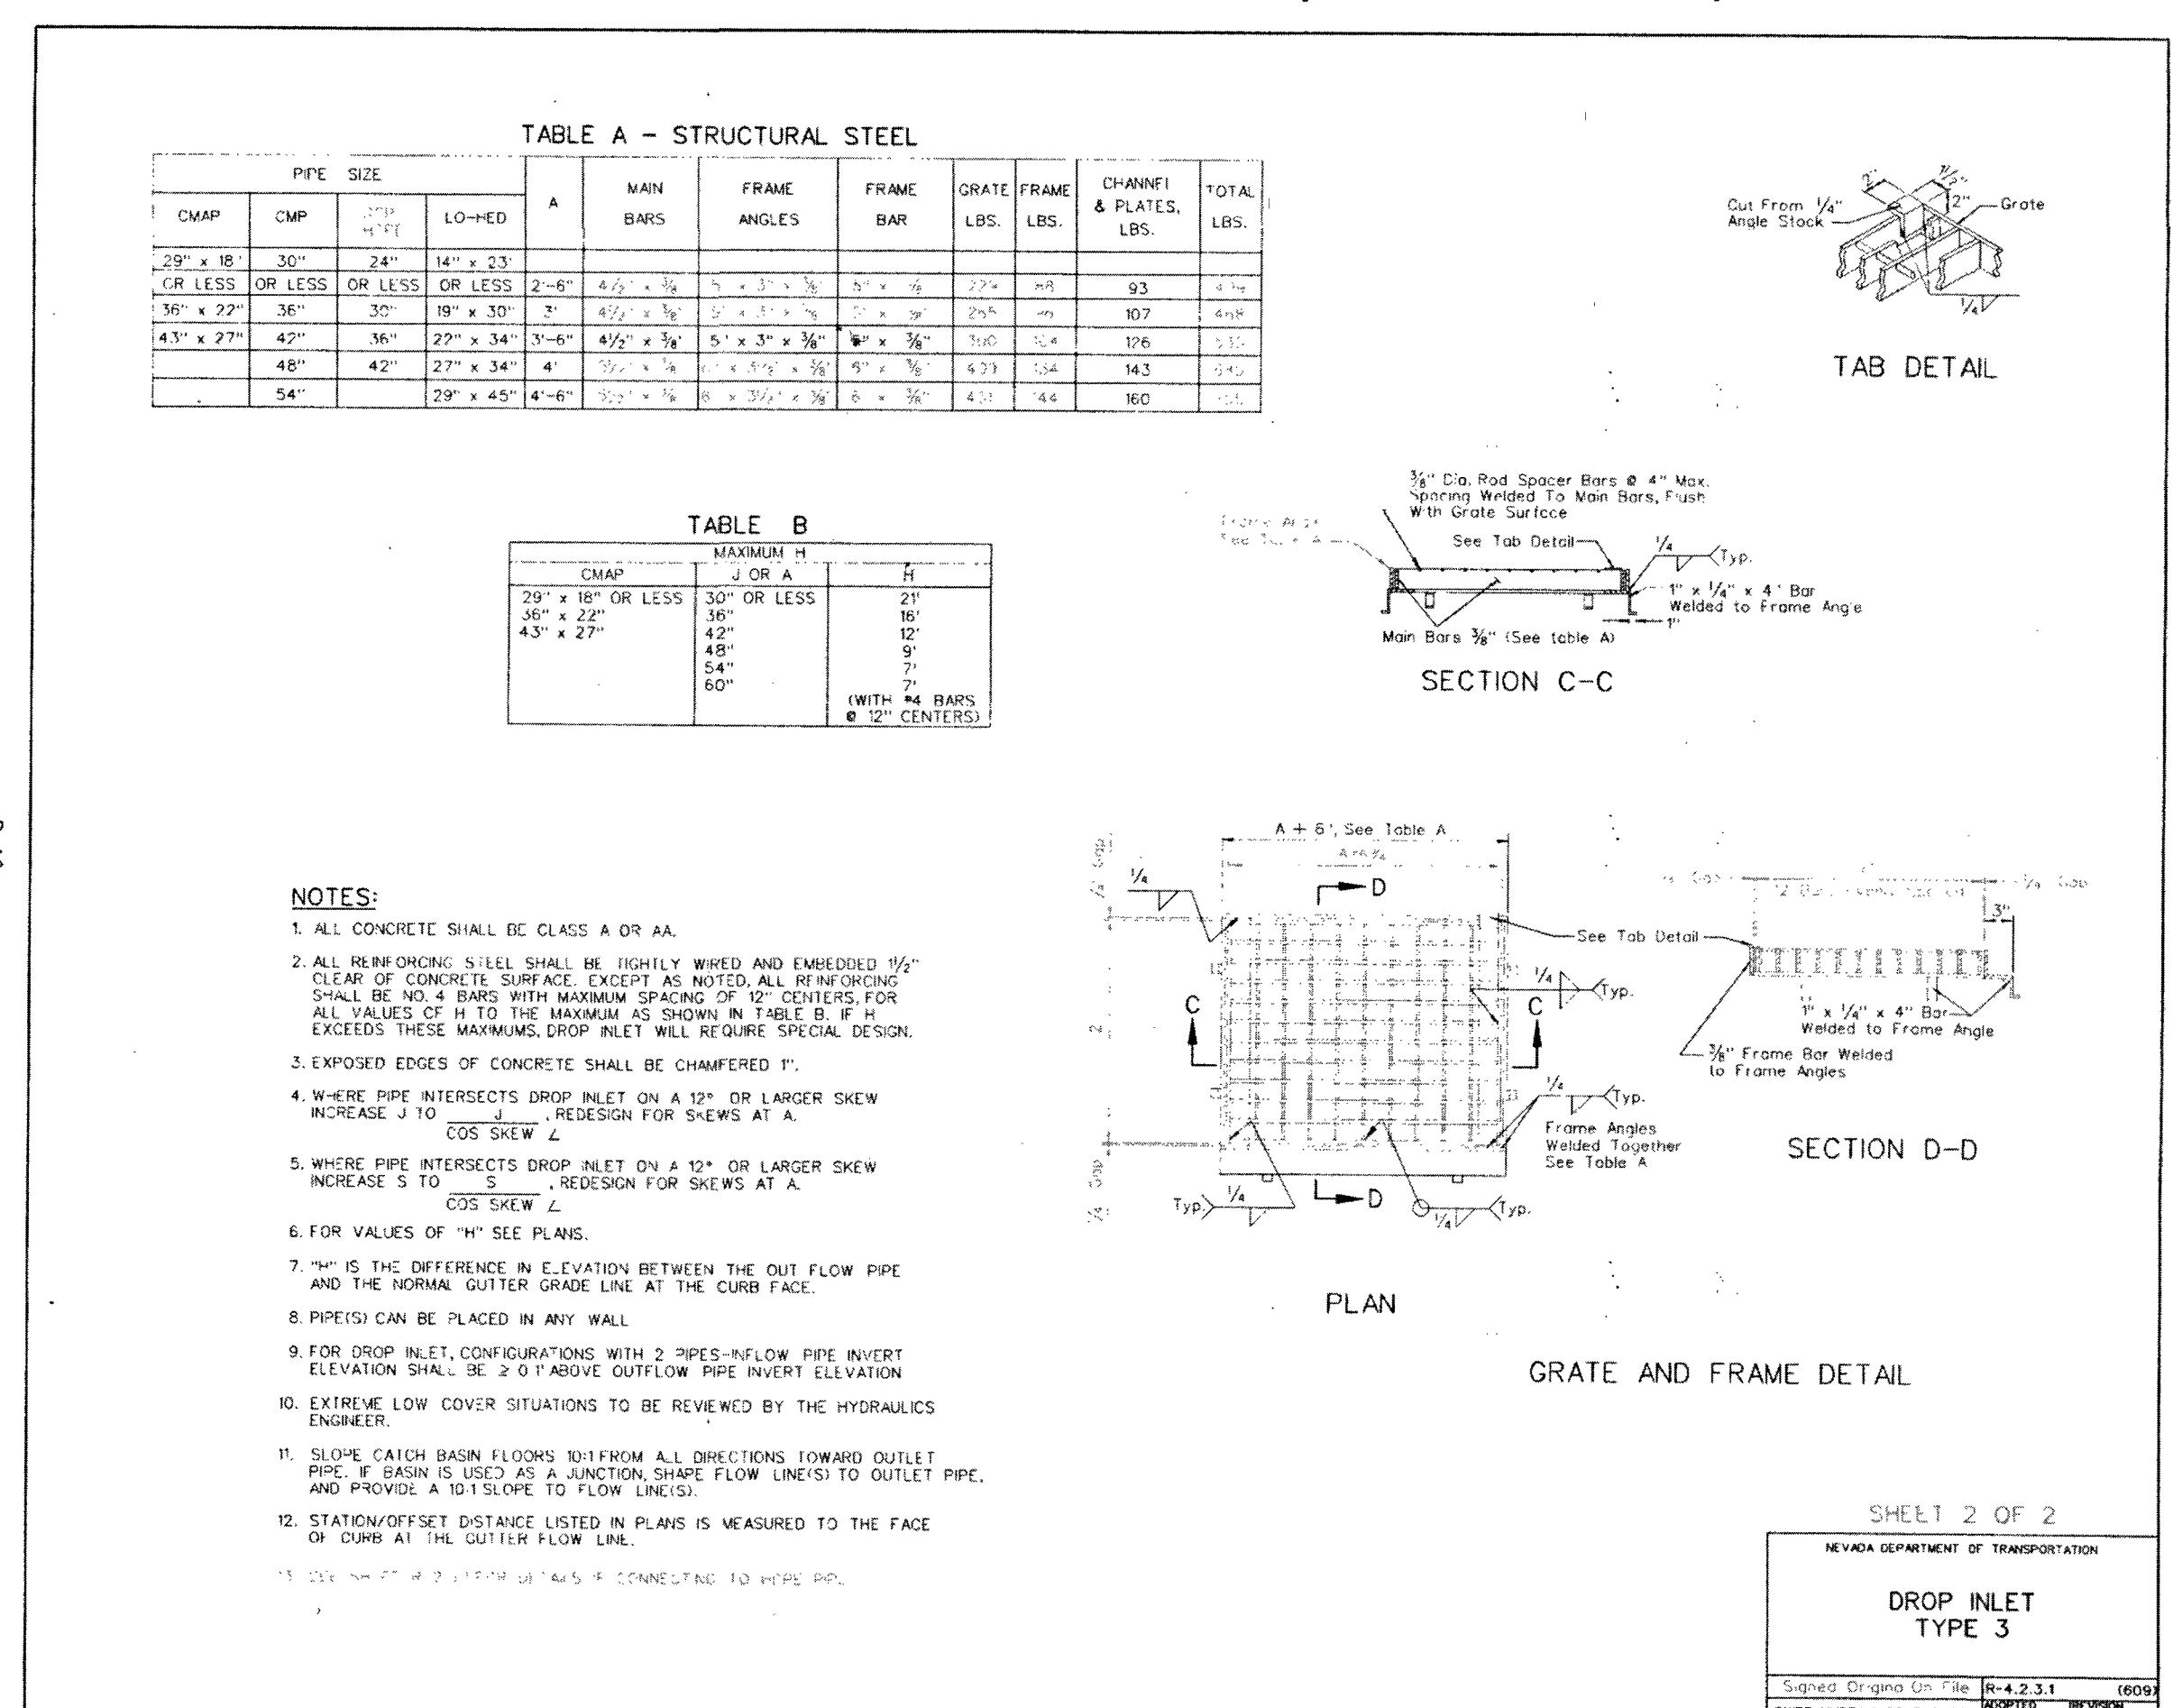


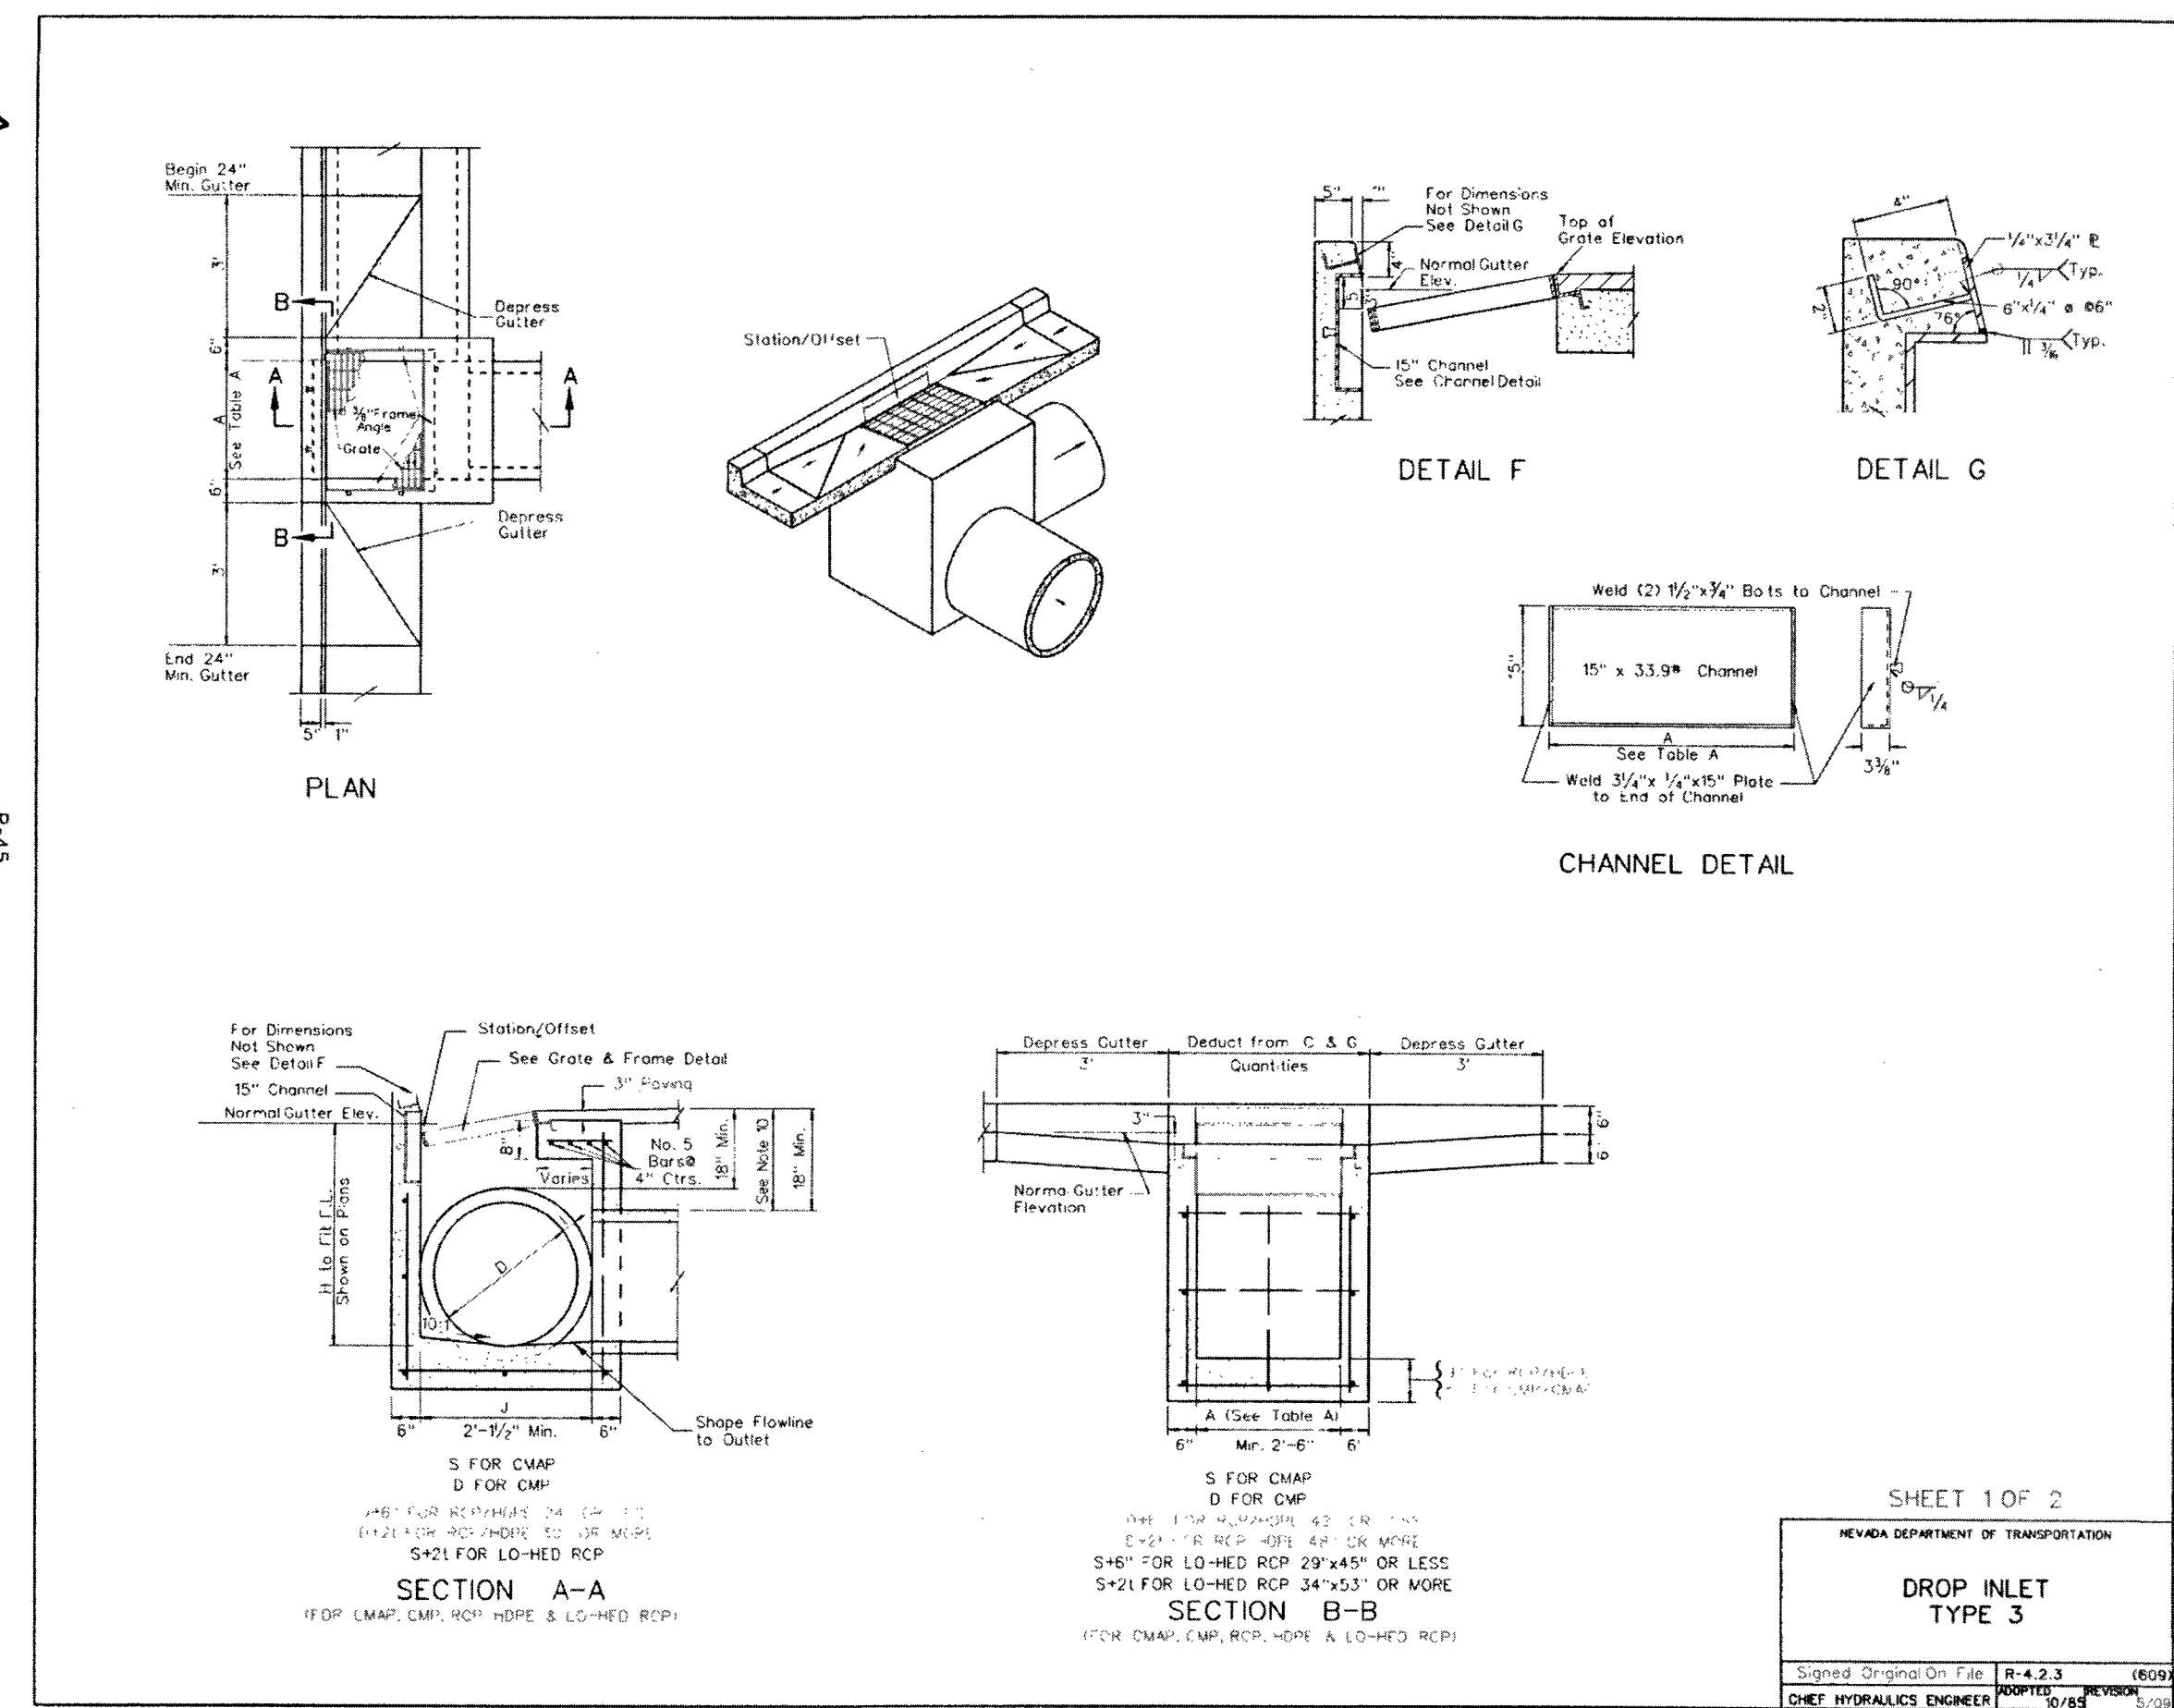

COLLINS ENGINEERS
 3130 S. DURANGO DR., SUITE 404
 LAS VEGAS, NV 89117
 PHONE: (702) 248-8000
 FAX: (702) 248-8070
 www.collinsengr.com

PROFESSIONAL ENGINEER - STATE OF NEVADA
 THOMAS D. MILLER
 DP-12-31-19
 CIVIL
 NO. 15776
 12-14-17

IMPROVEMENT PLANS FOR DC PLAZA
APN: 125-17-613-001
DETAIL SHEET
 8451 FARM ROAD
 LAS VEGAS, NEVADA

NO.	DATE	DESIGN BY	DESCRIPTION
1	01-15-17	JDM	REVISED DETAILS "H", "J" & "K"
2	11-30-17	JDM	REVISED DETAILS "H" & "J" ADDED DETAIL "L"

CEI PROJECT: 4136
 DESIGN BY: JDM SR
 DRAWN BY: JDM SR
 CHECKED BY: TDM P.E.
 DATE: 03/13/17
 SCALE: 1"=30'
 SHEET NUMBER
C8.03
 107V6734
 SHEET 34 OF 45
 H # 64486