


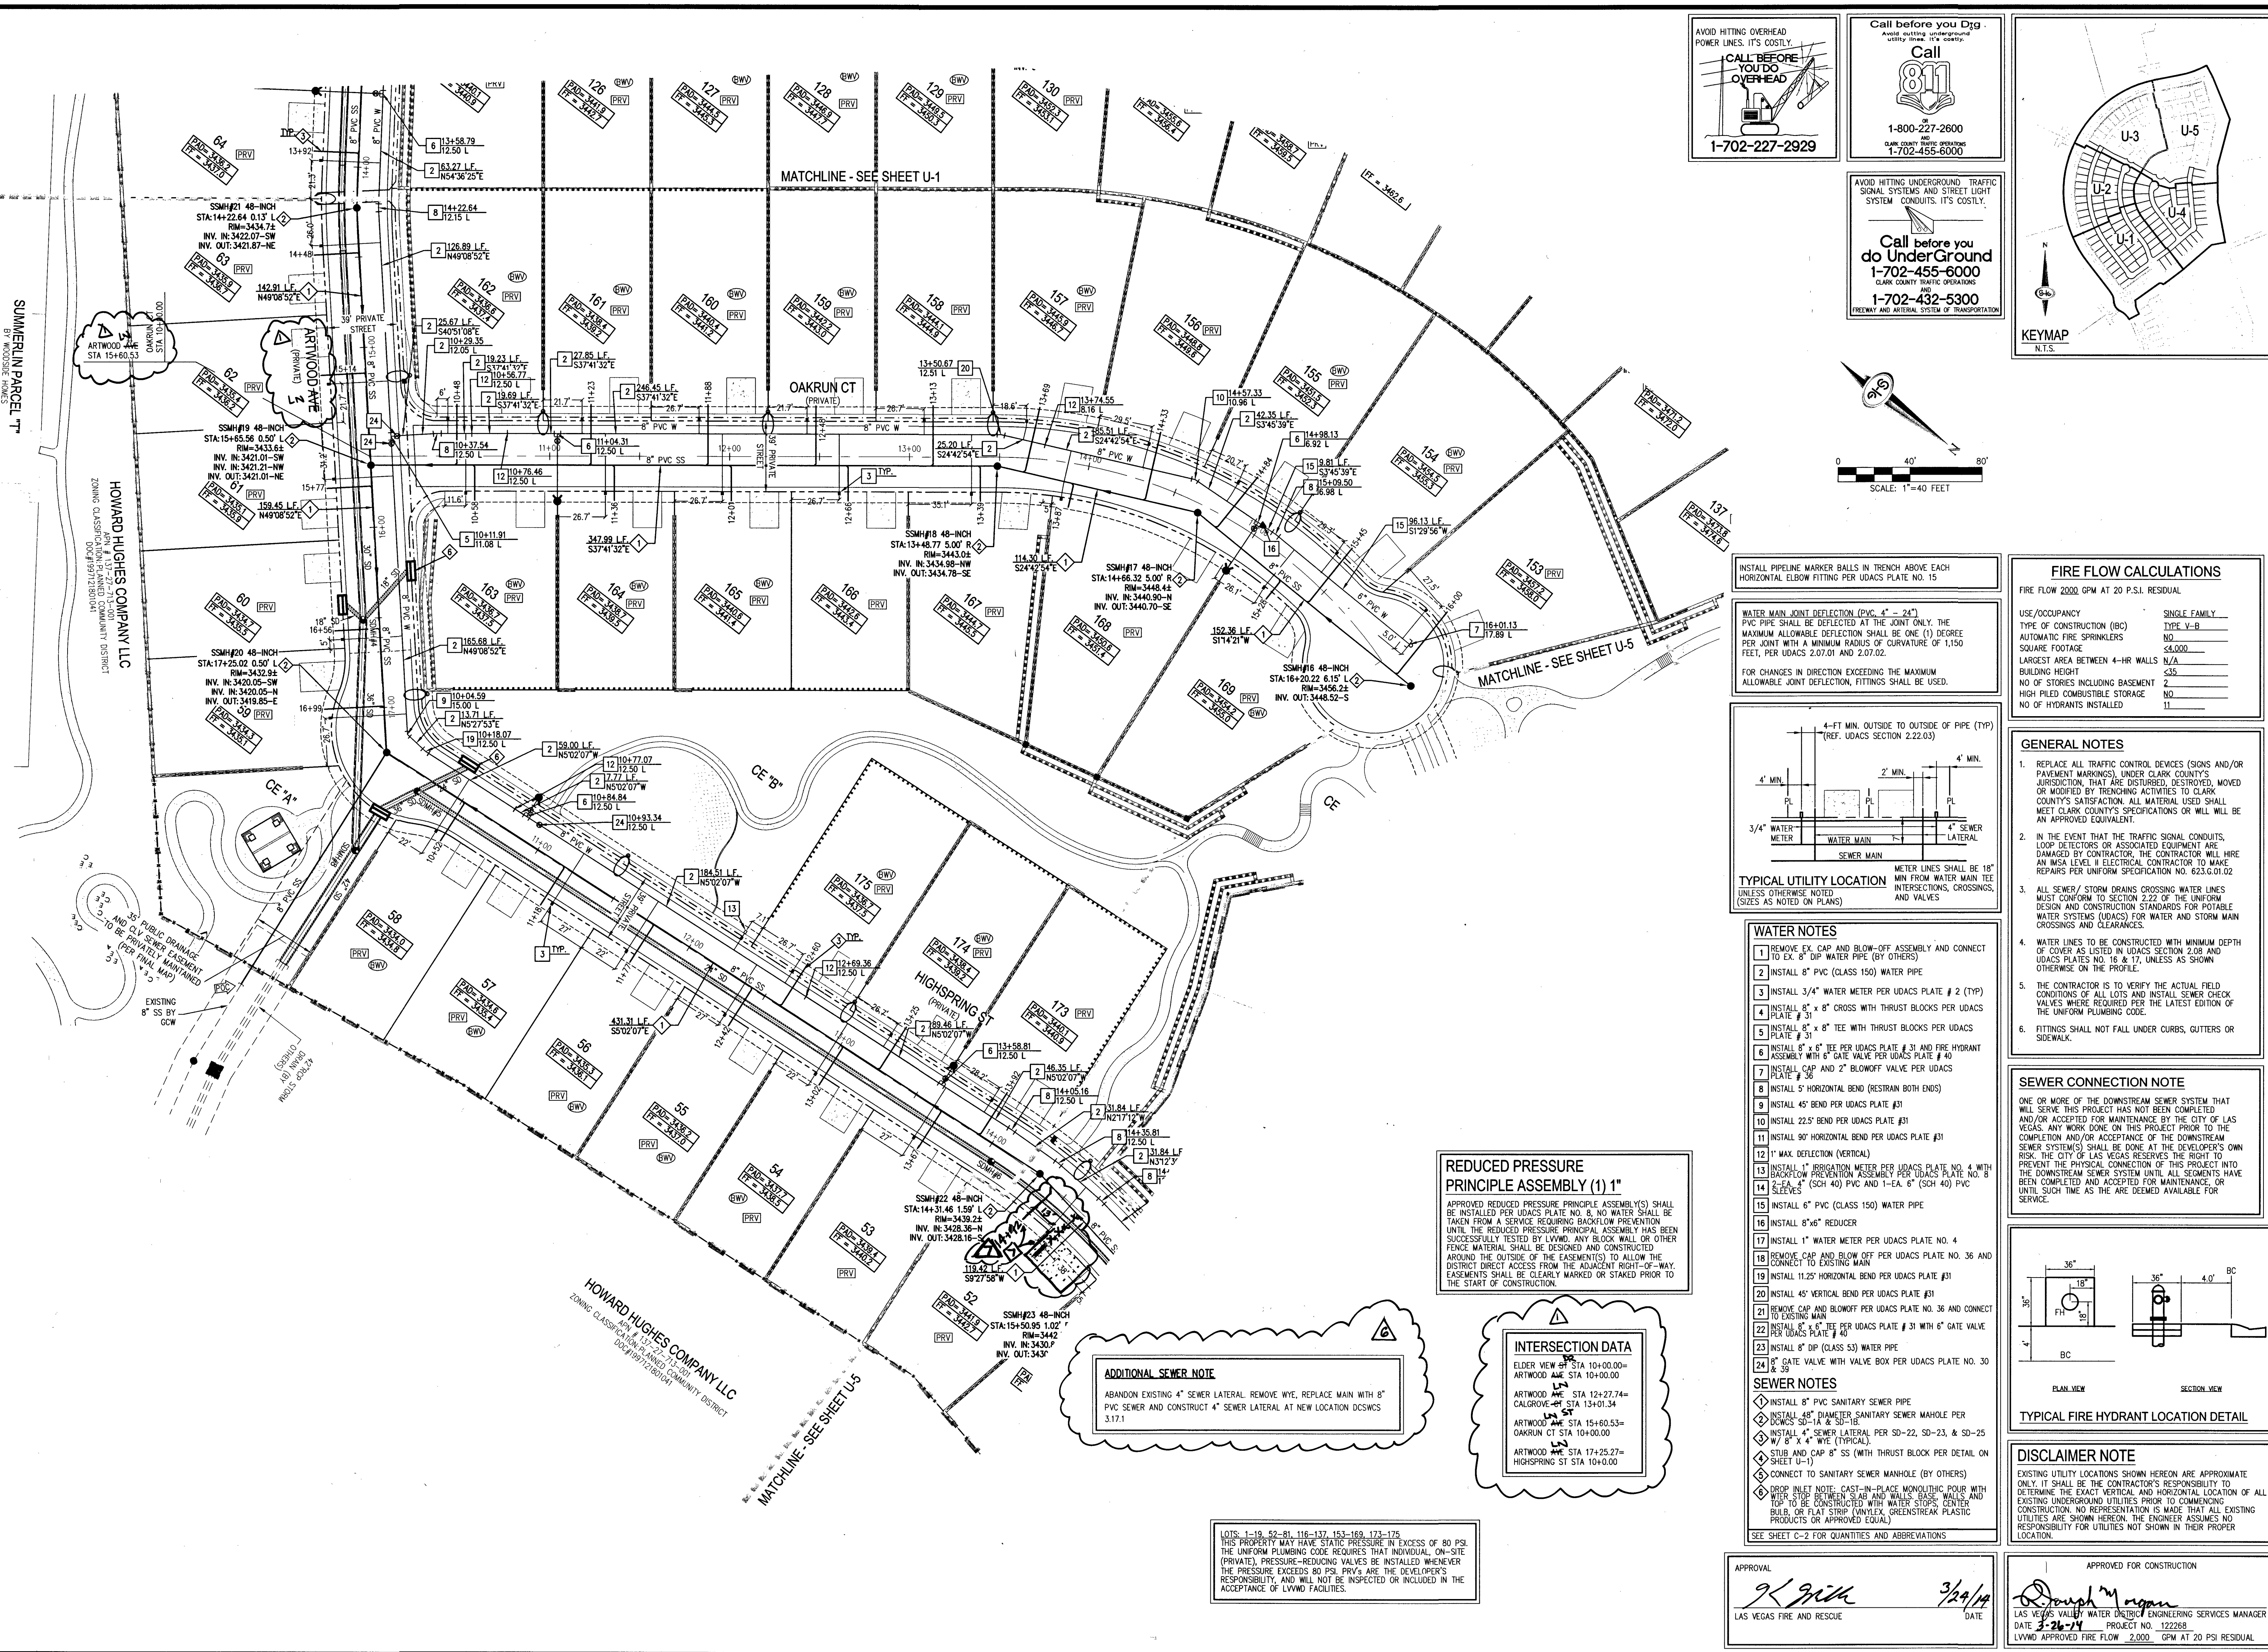

AVOID HITTING OVERHEAD
POWER LINES. IT'S COSTLY.

**CALL BEFORE
YOU DO
OVERHEAD**

1-702-227-2929

AVOID HITTING UNDERGROUND TRAFFIC
SIGNAL SYSTEMS AND STREET LIGHT
SYSTEM CONDUITS. IT'S COSTLY.




**Call before you
do UnderGround**
1-702-455-6000
CLARK COUNTY TRAFFIC OPERATIONS
AND
1-702-432-5300
FREEWAY AND ARTERIAL SYSTEM OF TRANSPORTATION

INSTALL PIPELINE MARKER BALLS IN TRENCH ABOVE EACH HORIZONTAL ELBOW FITTING PER UDACS PLATE NO. 15

WATER MAIN JOINT DEFLECTION (PVC, 4" - 24")
PVC PIPE SHALL BE DEFLECTED AT THE JOINT ONLY. THE MAXIMUM ALLOWABLE DEFLECTION SHALL BE ONE (1) DEGREE PER JOINT WITH A MINIMUM RADIUS OF CURVATURE OF 1,150 FEET, PER UDACS 2.07.01 AND 2.07.02.

FOR CHANGES IN DIRECTION EXCEEDING THE MAXIMUM ALLOWABLE JOINT DEFLECTION, FITTINGS SHALL BE USED.

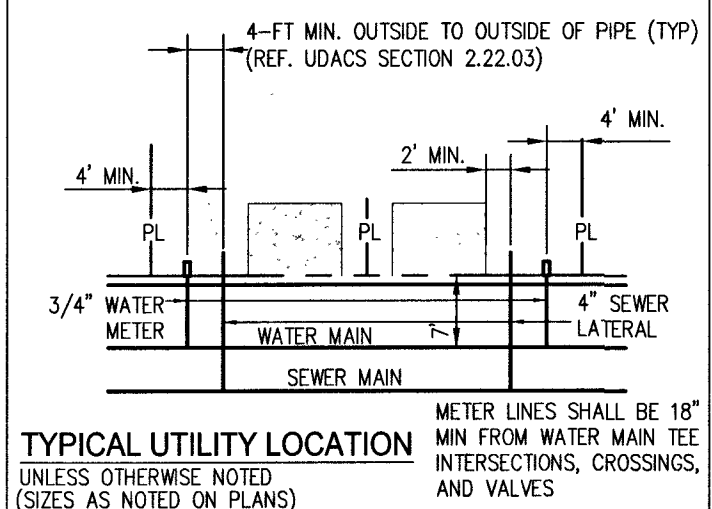

WATER NOTES

- 1 REMOVE EX. CAP AND BLOW-OFF ASSEMBLY AND CONNECT TO EX. 8" DIP WATER PIPE (BY OTHERS)
- 2 INSTALL 8" PVC (CLASS 150) WATER PIPE
- 3 INSTALL 3/4" WATER METER PER UDACS PLATE #2 (TYP)
- 4 INSTALL 8" x 8" CROSS WITH THRUST BLOCKS PER UDACS PLATE #31
- 5 INSTALL 8" x 8" TEE WITH THRUST BLOCKS PER UDACS PLATE #31
- 7 INSTALL CAP AND 2" BLOWOFF VALVE PER UDACS PLATE #35
- 8 INSTALL 5' HORIZONTAL BEND (RESTRAIN BOTH ENDS)
- 9 INSTALL 45° BEND PER UDACS PLATE #31
- 10 INSTALL 22.5° BEND PER UDACS PLATE #31
- 11 INSTALL 90° HORIZONTAL BEND PER UDACS PLATE #31
- 12 1" MAX DEFLECTION (VERTICAL)
- 13 INSTALL 1" IRRIGATION METER PER UDACS PLATE NO. 4 WITH BACKFLOW PREVENTION ASSEMBLY PER UDACS PLATE NO. 8 SLEEVES (SCH 40) PVC AND 1-EA. 6" (SCH 40) PVC
- 14 INSTALL 6" PVC (CLASS 150) WATER PIPE
- 16 INSTALL 8" 6" REDUCER
- 17 INSTALL 1" WATER METER PER UDACS PLATE NO. 4
- 18 REMOVE CAP AND BLOW OFF PER UDACS PLATE NO. 36 AND CONNECT TO EXISTING MAIN
- 19 INSTALL 11.25' HORIZONTAL BEND PER UDACS PLATE #31

The diagram illustrates the typical fire hydrant location detail, consisting of two views: Plan View and Section View.




TYPICAL FIRE HYDRANT LOCATION DETAIL

APPROVED FOR CONSTRUCTION

Douglas Morgan

LAS VEGAS VALLEY WATER DISTRICT ENGINEERING SERVICES MANAGER

DATE 3-26-14 PROJECT NO. 122268

LVWD APPROVED FIRE FLOW 2,000 GPM AT 20 PSI RESIDUAL