
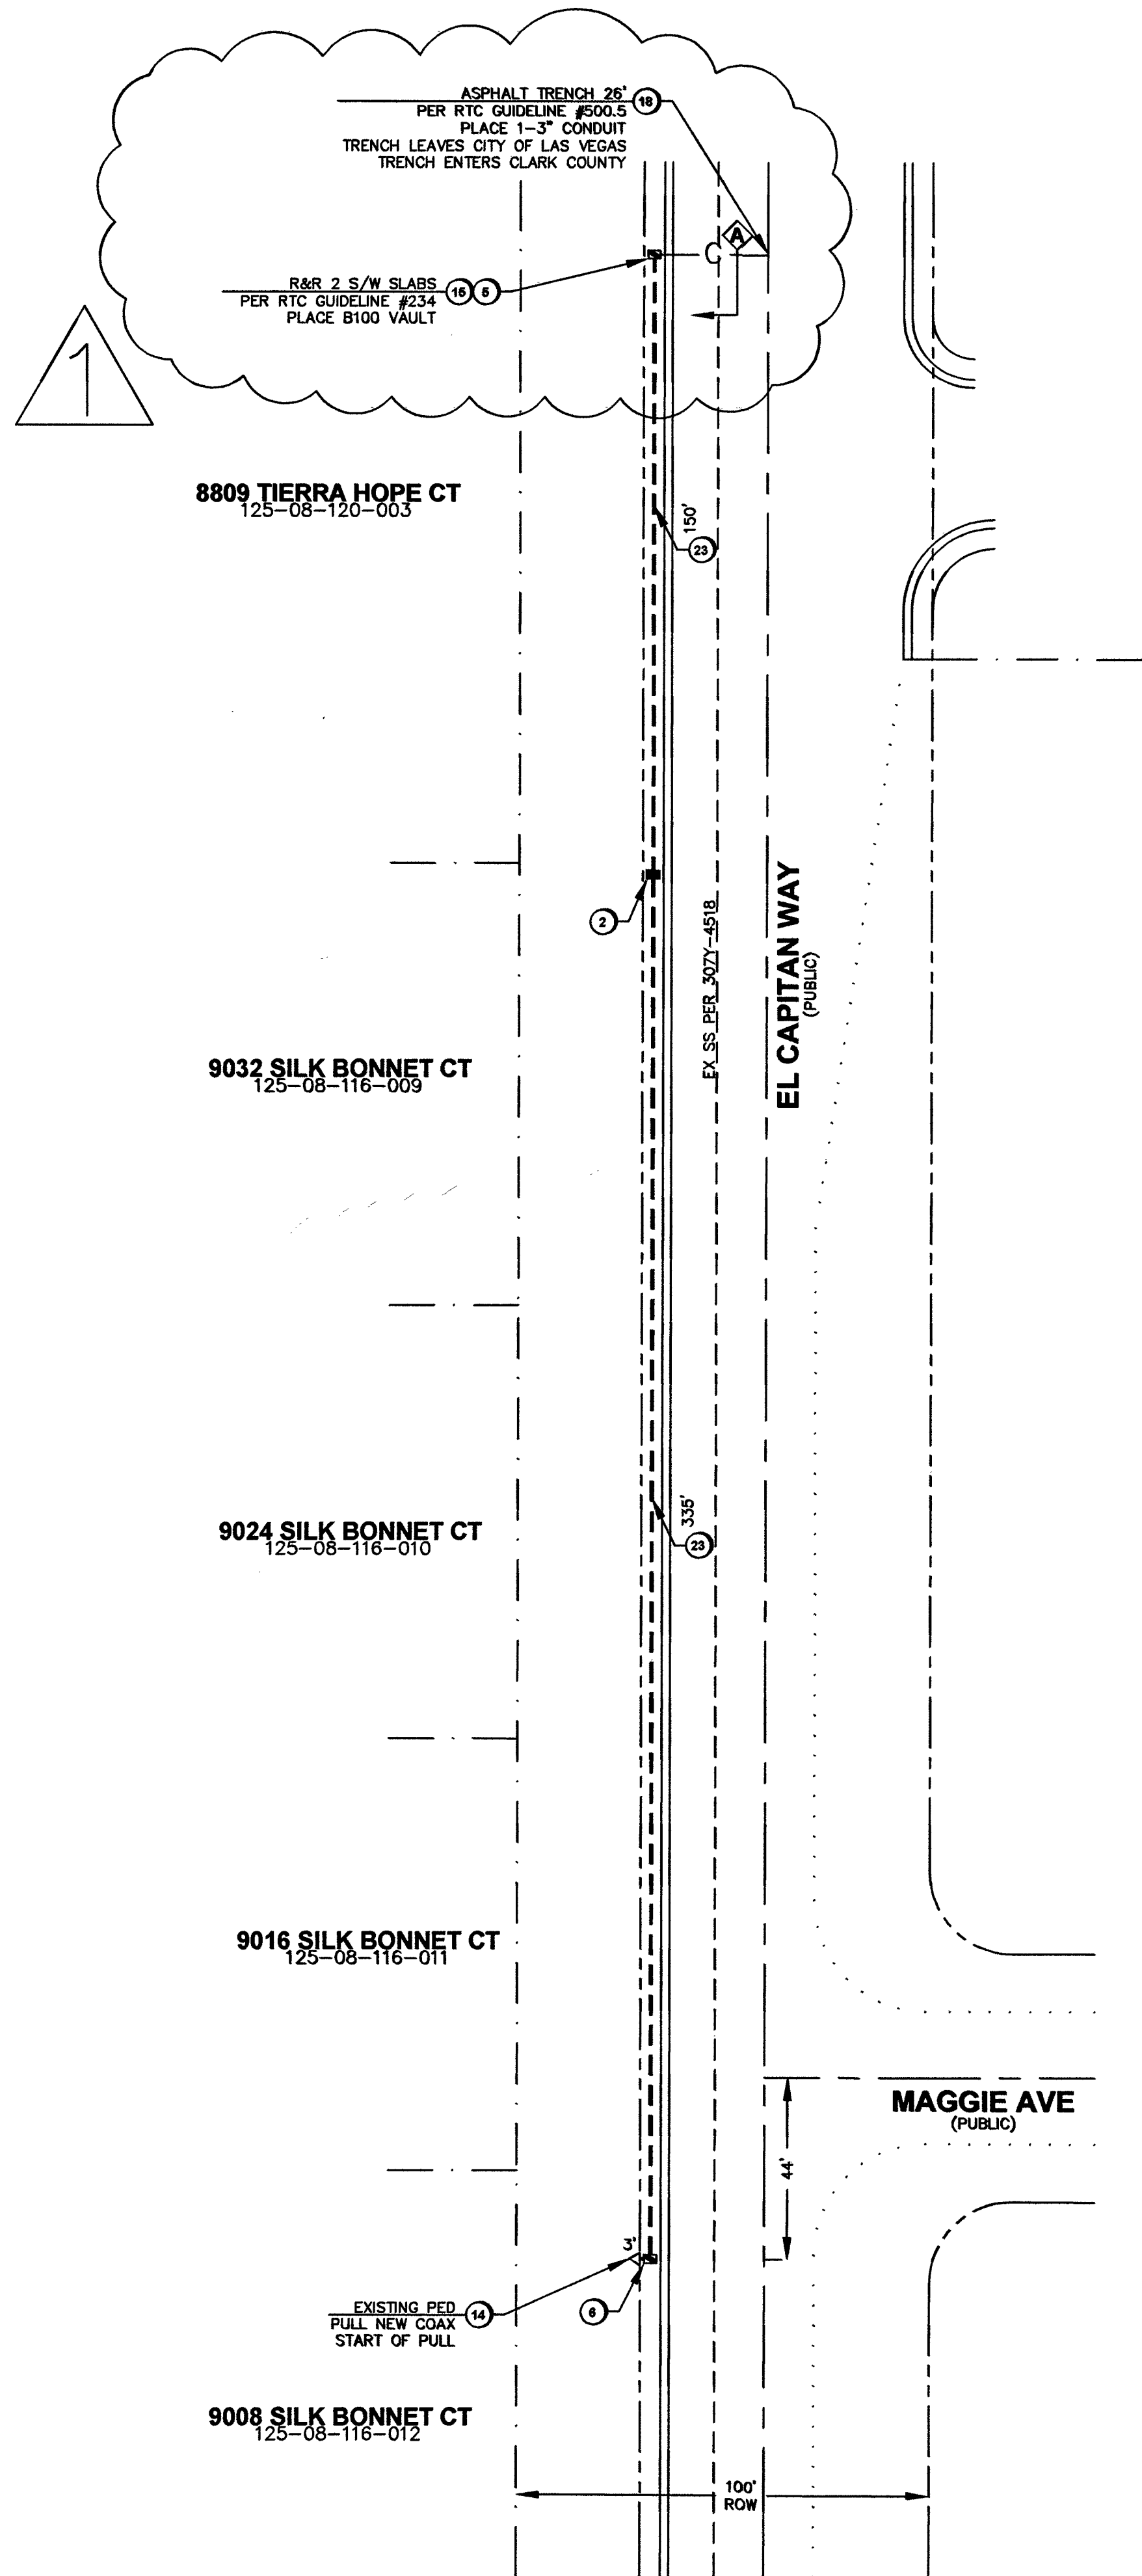


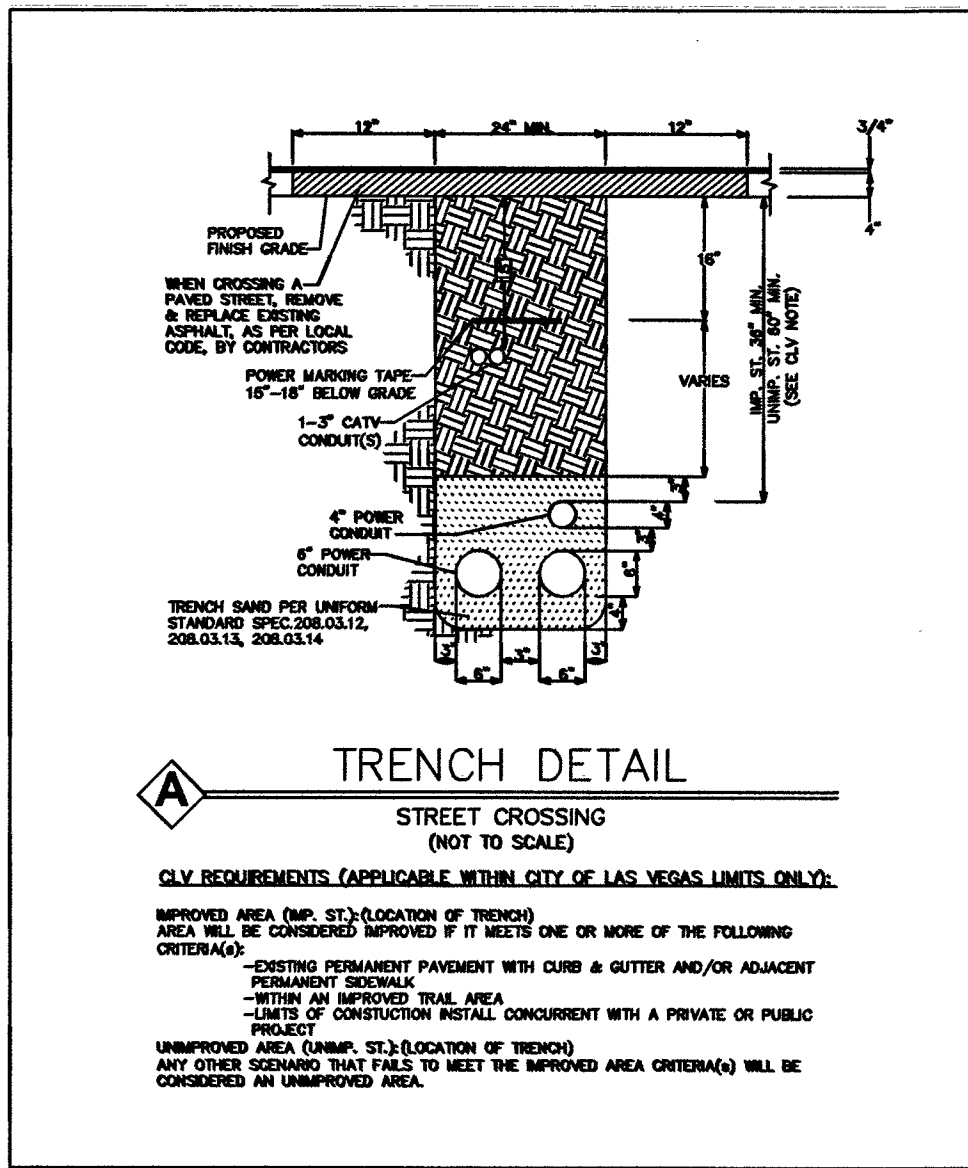

LEGEND	
1	INSTALL B-36 PULL BOX (24"x36"x24")
2	EXISTING B-36 PULL BOX (24"x36"x24")
3	INSTALL B-50 PULL BOX (13"x24"x24")
4	EXISTING B-50 PULL BOX (13"x24"x24")
5	INSTALL B-100 PULL BOX (24"x36"x24")
6	EXISTING B-100 PULL BOX (24"x36"x24")
7	INSTALL T-200 CATV VAULT (30"x48"x36")
8	EXISTING T-200 CATV VAULT (30"x48"x36")
9	INSTALL T-400 CATV VAULT (36"x60"x36")
10	EXISTING T-400 CATV VAULT (36"x60"x36")
11	INSTALL T-600 CATV VAULT (48"x72"x36")
12	EXISTING T-600 CATV VAULT (48"x72"x36")
13	INSTALL NEW CATV PEDESTAL
14	EXISTING NEW CATV PEDESTAL
15	R&R S/W SLAB(S)
16	POTHOLE
17	---S--- SIDEWALK/DIRT TRENCH INSTALL
18	---C--- ASPHALT/STREET TRENCH INSTALL
19	---B--- PROPOSED BORE
20	---X--- EXISTING CATV CONDUIT(S)
21	---OHC--- PROPOSED OVERHEAD FIBER OPTIC CABLE OR COAX INSTALL
22	---XOHC--- EXISTING OVERHEAD FIBER OPTIC CABLE OR COAX
23	--- --- U.G. FIBER/COAX PULL
24	--- --- RIGHT OF WAY LINE
25	--- --- LOT/PROPERTY LINE
26	--- --- EDGE OF PAVEMENT
27	[P] EXISTING NVE PULL BOX
28	[T] EXISTING TELCO PULL BOX
29	[TM] EXISTING TELCO MANHOLE
30	[T] EXISTING TELCO POLE
31	[NVE] EXISTING NVE POLE
32	[NVE] EXISTING NVE TRANSMISSION POLE
33	[X] EXISTING JOINT POLE
34	[X] EXISTING JOINT POLE WITH TRANSFORMER
35	[Y] POLE ANCHOR
36	[TS] EXISTING NVE TRANSFORMER TRANSFORMER PAD
37	[TS] SNWA TEST STATION
38	[TS] COX POWER SUPPLY (49"x24"x52")
39	[RC] INSTALL RHINO CABINET
40	[R] RISER POLE/QUADRANT DETAIL RISER OWNERSHIP NOTED
41	[R] RAILROAD
42	[MH] EXISTING MANHOLE (SS),(SD)...ECT
43	--- --- 1in CONDUIT LATERAL
44	
45	

DISCLAIMER NOTE	
UTILITY LOCATIONS SHOWN HEREON ARE APPROXIMATE ONLY. IT SHALL BE THE CONTRACTOR'S RESPONSIBILITY TO DETERMINE THE EXACT HORIZONTAL AND VERTICAL LOCATION OF ALL EXISTING UNDERGROUND AND OVERHEAD UTILITIES PRIOR TO COMMENCING CONSTRUCTION. NO REPRESENTATION IS MADE THAT ALL EXISTING UTILITIES ARE SHOWN HEREON. THE ENGINEER ASSUMES NO RESPONSIBILITY FOR UTILITIES NOT SHOWN OR UTILITIES NOT SHOWN IN THEIR PROPER LOCATIONS.	
BEFORE YOU DIG OR 1-800-227-2600 UNDERGROUND SERVICE (USA)	
BEFORE YOU OVERHEAD 1-702-227-2929 NEVADA POWER ENVIRONMENT AND SAFETY SERVICE DEPARTMENT	
TOTAL BORE	0'
TOTAL DIRT TRENCH	0'
TOTAL ASPHALT TRENCH	26'
TOTAL TRENCH	26'
SIDEWALK REMOVAL/REPAIR	
TOTAL S/W PANELS	2
TOTAL LINEAR FOOTAGE	10'

(T19S R60E)

VICINITY MAP
(NOT TO SCALE)

REVISIONS

REV	DESCRIPTION	DATE	BY
1	CHANGED ROUTE FROM BORE TO TRENCH	4/18/18	MM
	CHANGED PROJECT NAME		

ALL CONSTRUCTION AND MATERIALS SHALL BE IN
ACCORDANCE WITH THE "UNIFORM STANDARD
SPECIFICATIONS FOR PUBLIC WORKS
CONSTRUCTION OFF-SITE IMPROVEMENTS, CLARK
COUNTY AREA NEVADA" LATEST ISSUE; THE
"UNIFORM STANDARD DRAWINGS FOR PUBLIC
WORKS CONSTRUCTION, CLARK COUNTY AREA
NEVADA" LATEST ISSUE; AND OTHER APPLICABLE
APPROVED STANDARDS ISSUED BY THE
CONTROLLING AGENCY; ALL LOCAL CITY CODES
AND ORDINANCES APPLICABLE.

APPROVED FOR CONSTRUCTION
THIS APPROVAL IS FOR WORK IN CLV RW OR CLV
EASEMENT ONLY. OBTAINING PERMISSION OR
EASEMENT FOR WORK SHOWN IN PRIVATE
PROPERTY IS THE RESPONSIBILITY OF THE UTILITY.

APPROVAL DATE 9 2 18

PERMIT # 115120
DRAWN BY: WTB
DATE: 2-23-18
SCALE: 1:30
NODE: 115120
PROJECT #: 405201700000115120
TECH #: 702-296-7336
APPROVED BY: CHARLES TESTUT

CITY/ENTITY: CITY OF LAS VEGAS
333 N. RANCHO DRIVE
LAS VEGAS, NEVADA 89106
PHONE: (702) 545-1606
FAX: (702) 545-2606

PROJECT LOCATION: 333 N. RANCHO DRIVE
LAS VEGAS, NEVADA 89106
(702) 229-6885

SUB-CONTRACTOR: N EL CAPITAN WAY & MAGGIE AVE

ENTITY NOTES: CLOVER

SHEET No: 1

SHEET 1 OF 1