
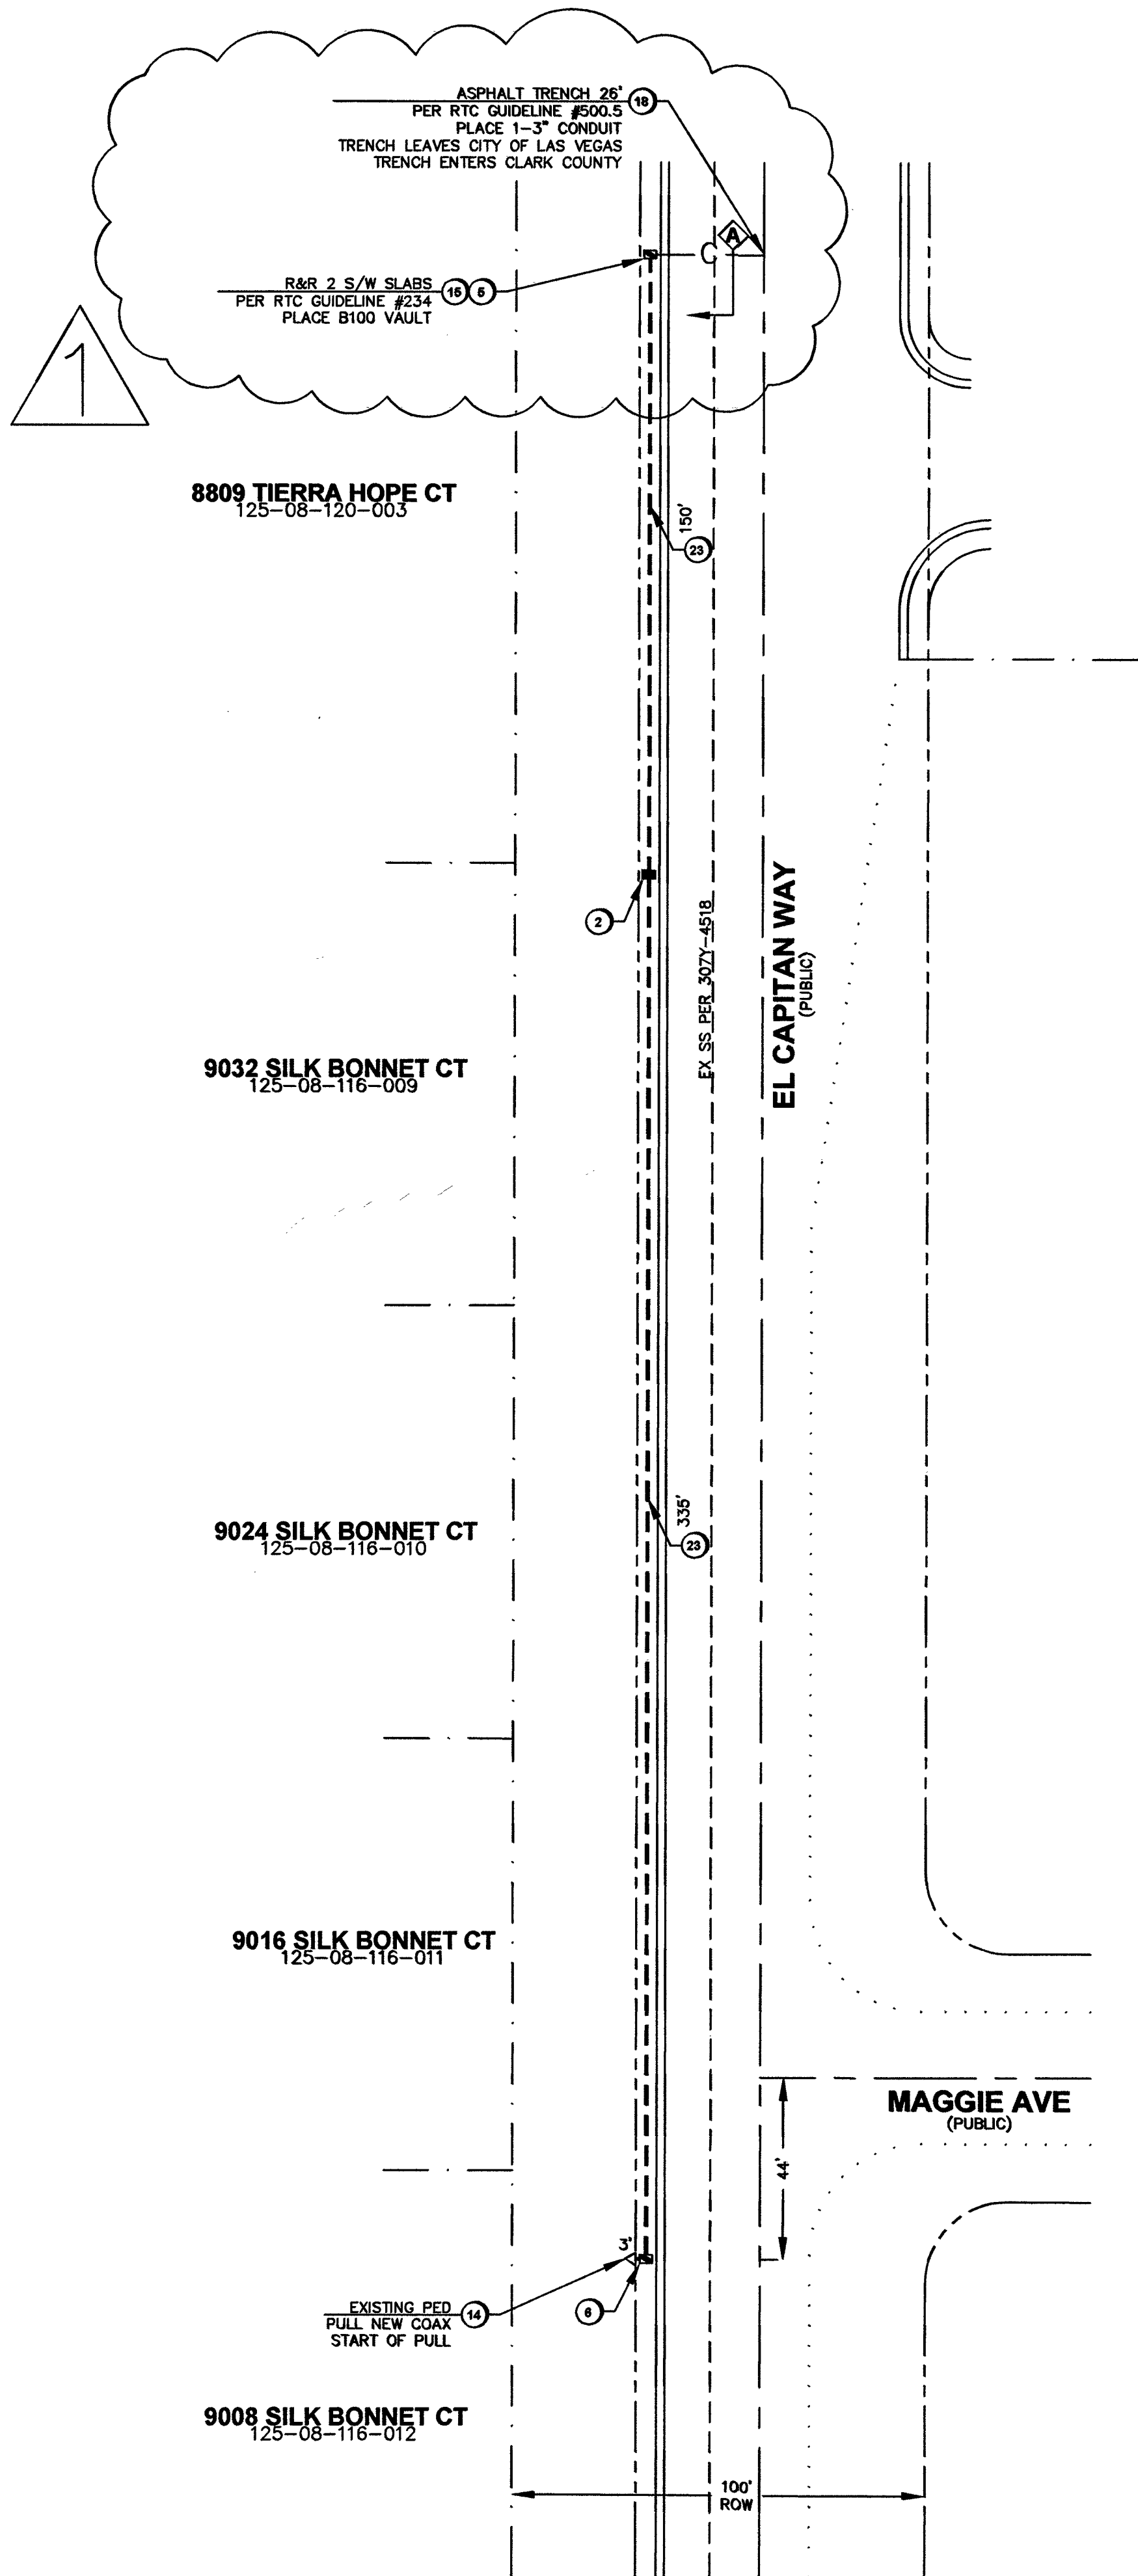


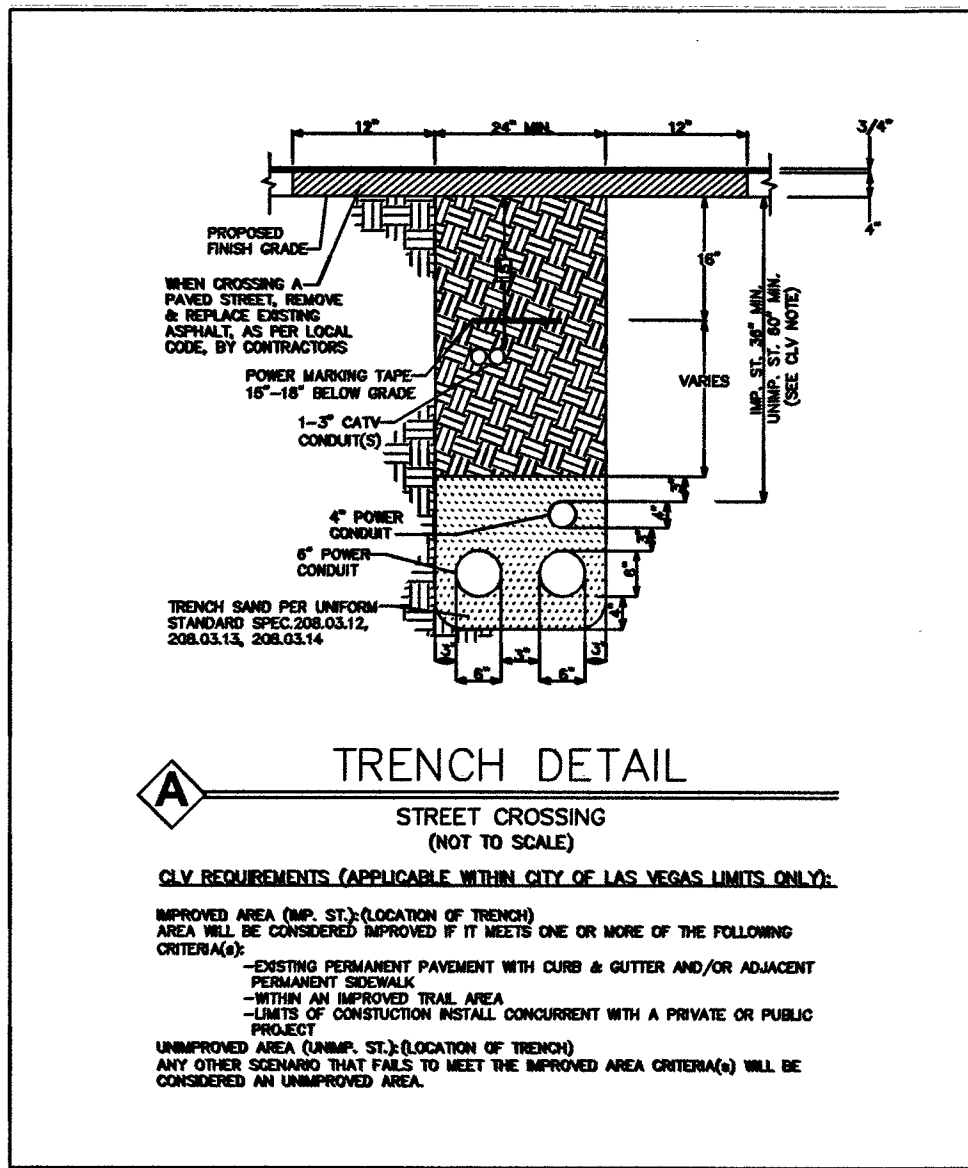

LEGEND	
1	INSTALL B-36 PULL BOX (24"x36"x24")
2	EXISTING B-36 PULL BOX (24"x36"x24")
3	INSTALL B-50 PULL BOX (13"x24"x24")
4	EXISTING B-50 PULL BOX (13"x24"x24")
5	INSTALL B-100 PULL BOX (24"x36"x24")
6	EXISTING B-100 PULL BOX (24"x36"x24")
7	INSTALL T-200 CATV VAULT (30"x48"x36")
8	EXISTING T-200 CATV VAULT (30"x48"x36")
9	INSTALL T-400 CATV VAULT (36"x60"x36")
10	EXISTING T-400 CATV VAULT (36"x60"x36")
11	INSTALL T-600 CATV VAULT (48"x72"x36")
12	EXISTING T-600 CATV VAULT (48"x72"x36")
13	INSTALL NEW CATV PEDESTAL
14	EXISTING NEW CATV PEDESTAL
15	R&R S/W SLAB(S)
16	POTHOLE
17	--- SIDEWALK/DIRT TRENCH INSTALL
18	--- ASPHALT/STREET TRENCH INSTALL
19	--- PROPOSED BORE
20	--- EXISTING CATV CONDUIT(S)
21	--- PROPOSED OVERHEAD FIBER OPTIC CABLE OR COAX INSTALL
22	--- EXISTING OVERHEAD FIBER OPTIC CABLE OR COAX
23	--- U.G. FIBER/COAX PULL
24	--- RIGHT OF WAY LINE
25	--- LOT/PROPERTY LINE
26	--- EDGE OF PAVEMENT
27	P EXISTING NVE PULL BOX
28	T EXISTING TELCO PULL BOX
29	TM EXISTING TELCO MANHOLE
30	T EXISTING TELCO POLE
31	EXISTING NVE POLE
32	NVE EXISTING NVE TRANSMISSION POLE
33	EXISTING JOINT POLE
34	EXISTING JOINT POLE WITH TRANSFORMER
35	POLE ANCHOR
36	EXISTING NVE TRANSFORMER TRANSFORMER PAD
37	TS SNWA TEST STATION
38	COX POWER SUPPLY (49"x24"x52")
39	INSTALL RHINO CABINET
40	RISER POLE/QUADRANT DETAIL RISER OWNERSHIP NOTED
41	RAILROAD
42	EXISTING MANHOLE (SS)(SD)...ECT
43	--- 1in CONDUIT LATERAL
44	
45	

DISCLAIMER NOTE	
UTILITY LOCATIONS SHOWN HEREON ARE APPROXIMATE ONLY. IT SHALL BE THE CONTRACTOR'S RESPONSIBILITY TO DETERMINE THE EXACT HORIZONTAL AND VERTICAL LOCATION OF ALL EXISTING UNDERGROUND AND OVERHEAD UTILITIES PRIOR TO COMMENCING CONSTRUCTION. NO REPRESENTATION IS MADE THAT ALL EXISTING UTILITIES ARE SHOWN HEREON. THE ENGINEER ASSUMES NO RESPONSIBILITY FOR UTILITIES NOT SHOWN OR UTILITIES NOT SHOWN IN THEIR PROPER LOCATIONS.	
BEFORE YOU DIG OR 1-800-227-2600 UNDERGROUND SERVICE (USA)	
BEFORE YOU OVERHEAD CALL 1-702-432-6300 LAS VEGAS AREA COMPUERED SYSTEM	
TOTAL BORE 0'	
TOTAL DIRT TRENCH 0'	
TOTAL ASPHALT TRENCH 26'	
TOTAL TRENCH 26'	
SIDEWALK REMOVAL/REPAIR	
TOTAL S/W PANELS 2	
TOTAL LINEAR FOOTAGE 10'	

(T19S R60E)

VICINITY MAP (NOT TO SCALE)

REVISIONS

REV	DESCRIPTION	DATE	BY
1	CHANGED ROUTE FROM BORE TO TRENCH	4/18/18	MM
2	CHANGED PROJECT NAME		

ALL CONSTRUCTION AND MATERIALS SHALL BE IN ACCORDANCE WITH THE "UNIFORM STANDARD SPECIFICATIONS FOR PUBLIC WORKS CONSTRUCTION OFF-SITE IMPROVEMENTS, CLARK COUNTY AREA NEVADA" LATEST ISSUE; THE "UNIFORM STANDARD DRAWINGS FOR PUBLIC WORKS CONSTRUCTION, CLARK COUNTY AREA NEVADA" LATEST ISSUE; AND OTHER APPLICABLE APPROVED STANDARDS ISSUED BY THE CONTROLLING AGENCY; ALL LOCAL CITY CODES AND ORDINANCES APPLICABLE.

APPROVED FOR CONSTRUCTION

THIS APPROVAL IS FOR WORK IN CLV RW OR CLV EASEMENT ONLY. OBTAINING PERMISSION OR EASEMENT FOR WORK SHOWN IN PRIVATE PROPERTY IS THE RESPONSIBILITY OF THE UTILITY.

APPROVAL DATE 9 2 18

PERMIT # 115120

DRAWN BY: WTB

DATE: 2-23-18

SCALE: 1:30

NODE: 115120

PROJECT #: 405201700000115120

TECH #: 702-296-7336

APPROVED BY: CHARLES TESTUT

CITY/ENTITY: CITY OF LAS VEGAS

333 N. RANCHO DRIVE

LAS VEGAS, NEVADA 89106

PHONE: (702) 545-1606

FAX: (702) 545-2606

PROJECT LOCATION: N EL CAPITAN WAY & MAGGIE AVE

SUB-CONTRACTOR: CLOVER

ENTITY NOTES: CLOVER

SHEET No: 1

SHEET 1 OF 1