
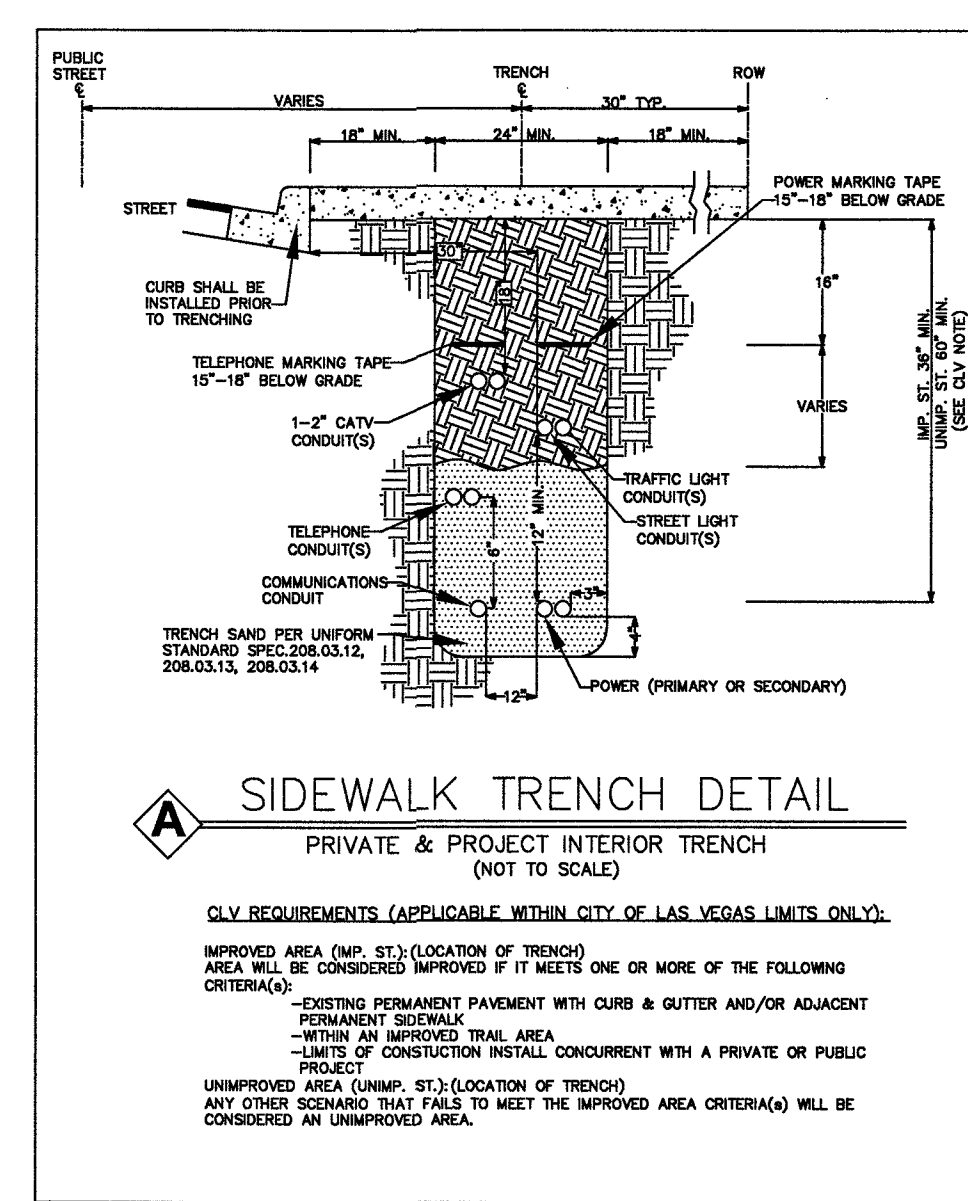


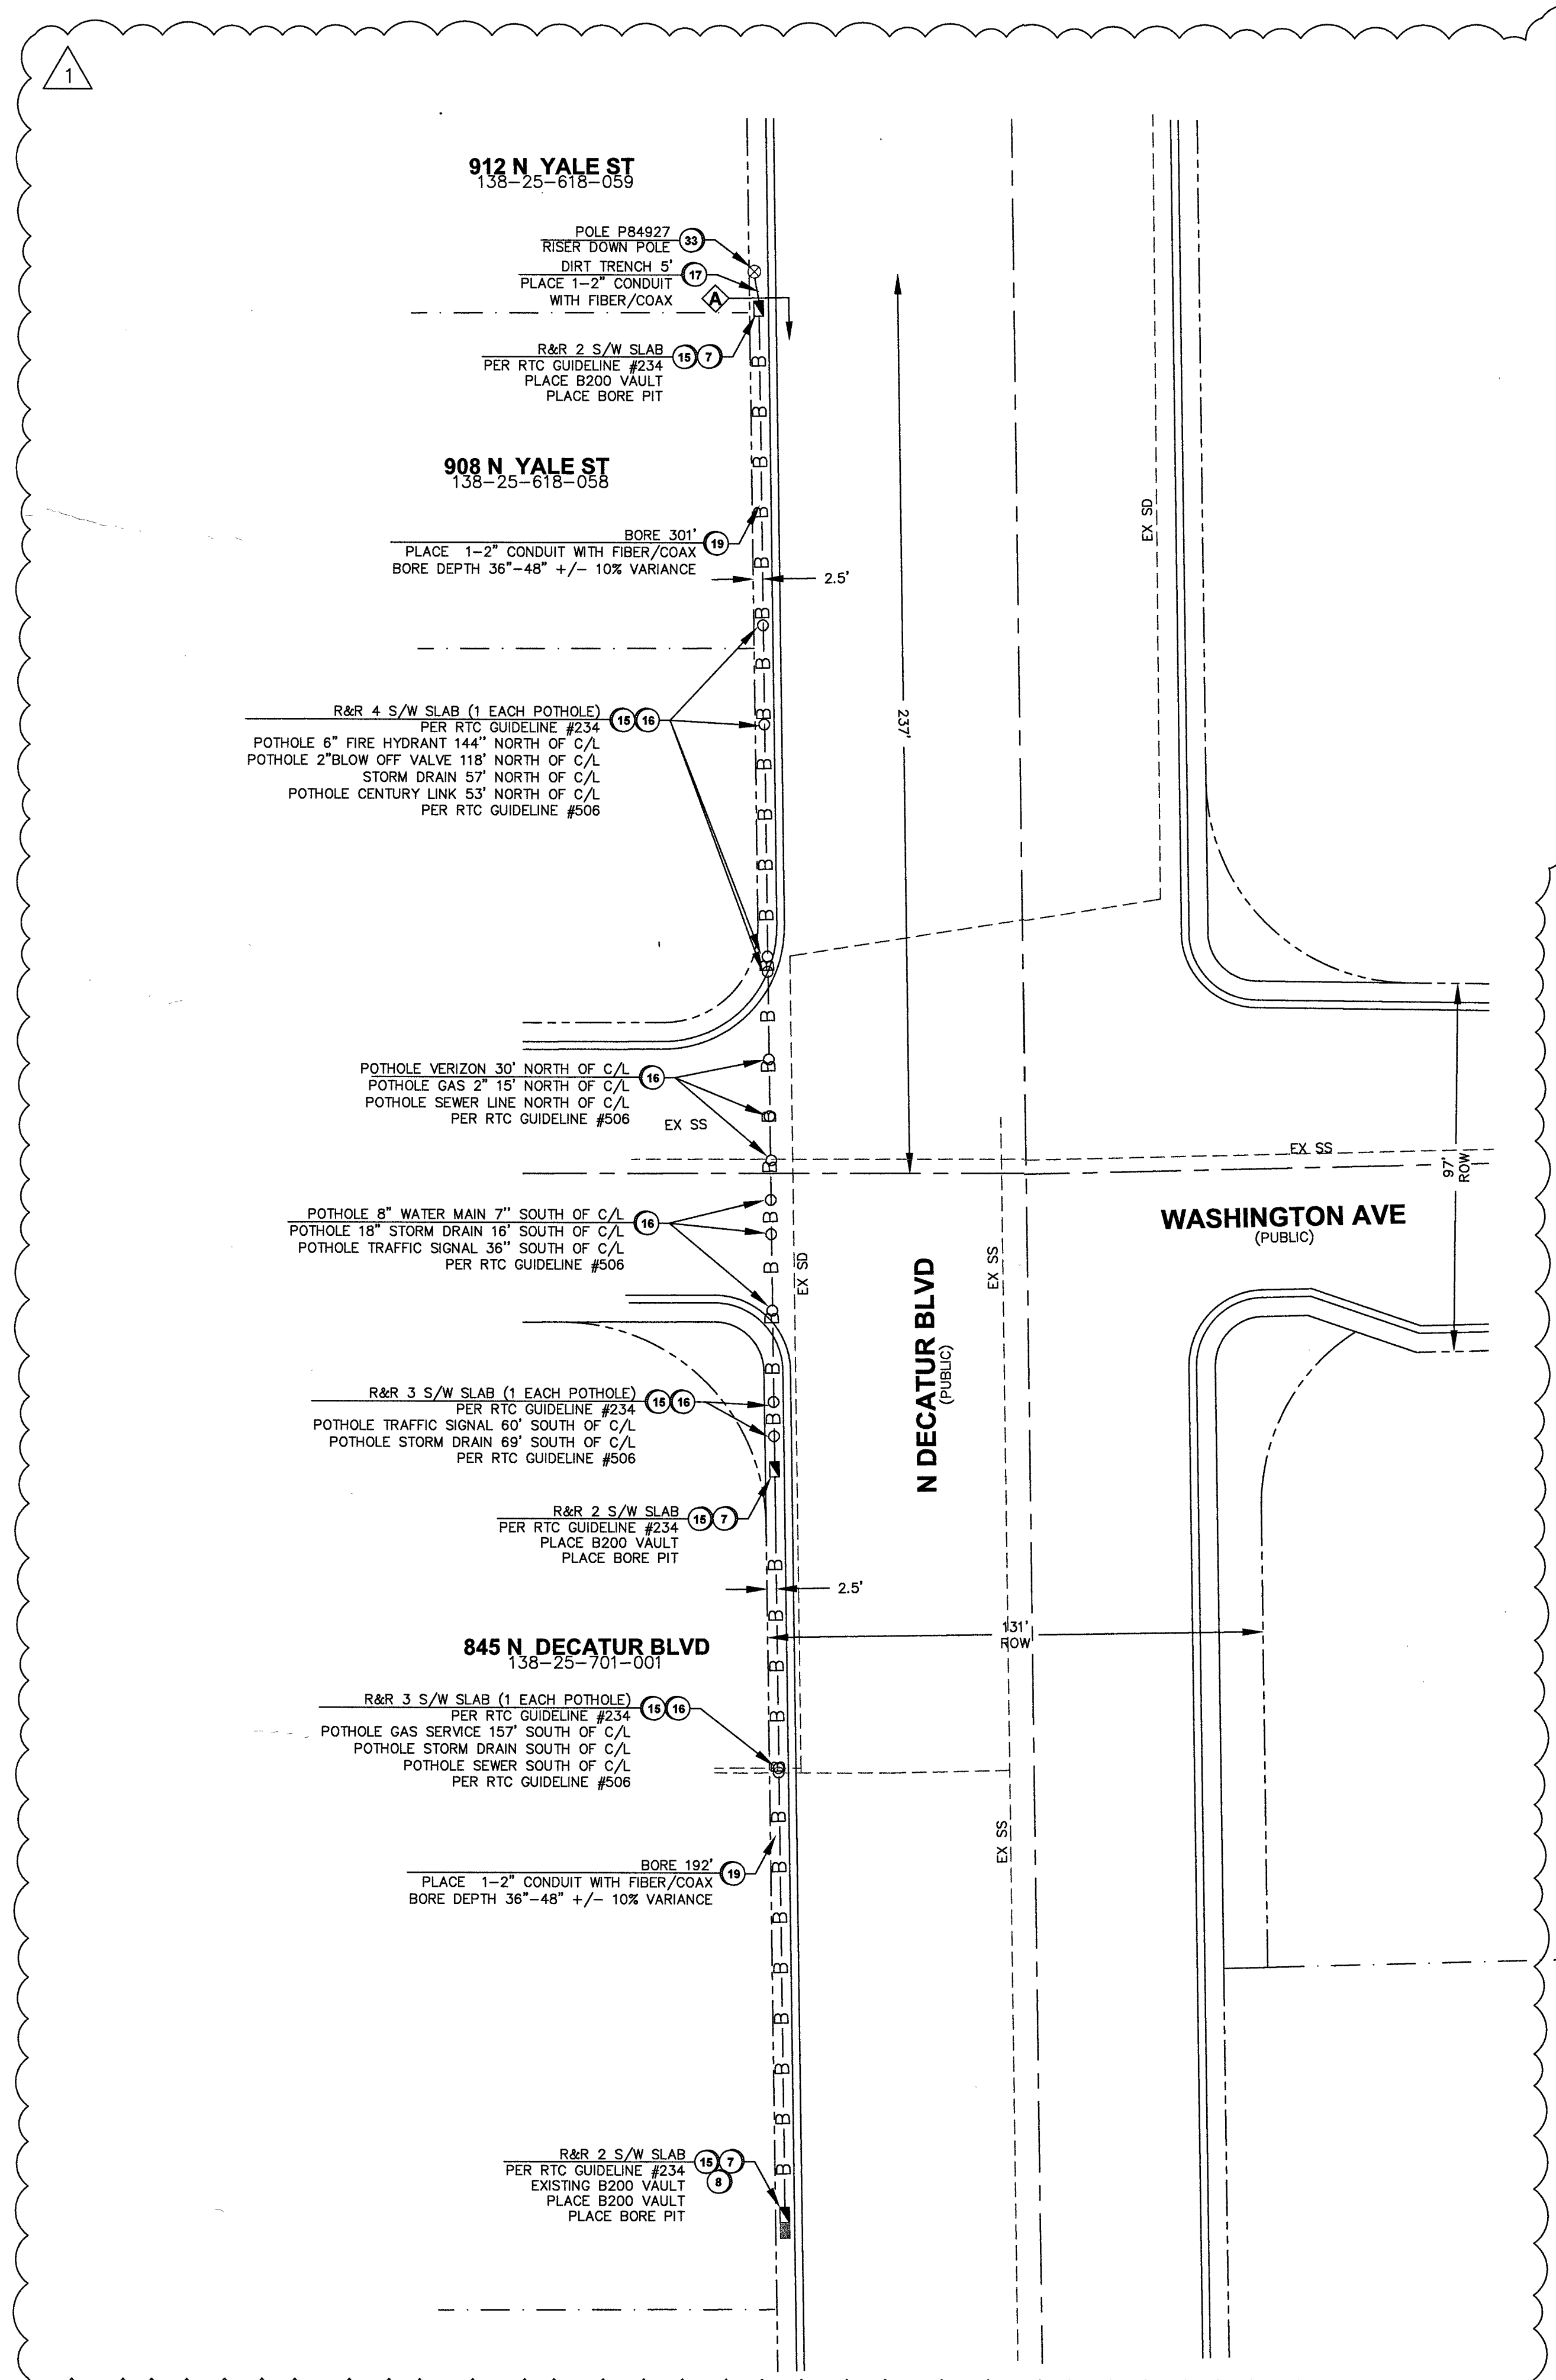

LEGEND	
1	INSTALL B-36 PULL BOX (24"x36"x24")
2	EXISTING B-36 PULL BOX (24"x36"x24")
3	INSTALL B-50 PULL BOX (13"x24"x24")
4	EXISTING B-50 PULL BOX (13"x24"x24")
5	INSTALL B-100 PULL BOX (24"x36"x24")
6	EXISTING B-100 PULL BOX (24"x36"x24")
7	INSTALL 1-200 CATV VAULT (30"x48"x36")
8	EXISTING 1-200 CATV VAULT (30"x48"x36")
9	INSTALL 1-400 CATV VAULT (36"x60"x36")
10	EXISTING 1-400 CATV VAULT (36"x60"x36")
11	INSTALL 1-600 CATV VAULT (48"x72"x36")
12	EXISTING 1-600 CATV VAULT (48"x72"x36")
13	INSTALL NEW CATV PEDESTAL
14	EXISTING CATV PEDESTAL
15	R&R S/W SLAB(S)
16	POTHOLE
17	SIDEWALK/DIRT TRENCH INSTALL WITH FIBER/COAX PULL
18	ASPHALT MITIGATION/STREET TRENCH WITH FIBER/COAX PULL
19	PROPOSED BORE WITH FIBER/COAX PULL
20	EXISTING CATV CONDUIT(S)
21	PROPOSED OVERHEAD FIBER OPTIC CABLE OR COAX INSTALL
22	EXISTING OVERHEAD FIBER OPTIC CABLE OR COAX
23	U.G. FIBER/COAX PULL THROUGH EXISTING CONDUIT
24	RIGHT OF WAY LINE
25	LOT/PROPERTY LINE
26	EDGE OF PAVEMENT/ SIDEWALK/CONCRETE
27	EXISTING NVE PULL BOX
28	EXISTING TELCO PULL BOX
29	EXISTING COMMUNICATION MANHOLE
30	EXISTING TELCO POLE
31	EXISTING NVE POLE
32	EXISTING NVE TRANSMISSION POLE
33	EXISTING JOINT POLE
34	EXISTING JOINT POLE WITH TRANSFORMER
35	POLE ANCHOR
36	EXISTING NVE TRANSFORMER TRANSFORMER PAD
37	SNWA TEST STATION
38	COX POWER SUPPLY (49"x24"x52")
39	CABINET (RHINO,ODN,OLM)
40	RISER POLE/QUADRANT DETAIL RISER OWNERSHIP NOTED
41	RAILROAD
42	EXISTING MANHOLE (SS),(SD)...ECT
43	1in CONDUIT LATERAL
44	STORMWATER ASSETS
45	

DISCLAIMER NOTE

UTILITY LOCATIONS SHOWN HEREON ARE APPROXIMATE ONLY. IT SHALL BE THE CONTRACTOR'S RESPONSIBILITY TO DETERMINE THE EXACT HORIZONTAL AND VERTICAL LOCATION OF ALL EXISTING UNDERGROUND AND OVERHEAD UTILITIES PRIOR TO COMMENCING CONSTRUCTION. NO REPRESENTATION IS MADE THAT ALL EXISTING UTILITIES ARE SHOWN HEREON. THE ENGINEER ASSUMES NO RESPONSIBILITY FOR UTILITIES NOT SHOWN OR UTILITIES NOT SHOWN IN THEIR PROPER LOCATIONS.

AVOID CUTTING UNDERGROUND UTILITY LINES. IT'S COSTLY.
CALL 811 BEFORE YOU DIG
OR 1-800-227-2600
UNDERGROUND SERVICE (USA)

AVOID OVERHEAD POWER LINE CONTACT
CALL BEFORE YOU OVERHEAD
1-702-227-2929
NEVADA POWER ENVIRONMENT AND SAFETY SERVICE DEPARTMENT

COX

BRINGING US CLOSER
1700 VEGAS DRIVE
LAS VEGAS, NEVADA 89106
PHONE: (702) 545-6006
FAX: (702) 545-2606

CITY OF LAS VEGAS

333 N. RANCHO DRIVE
LAS VEGAS, NEVADA 89106
(702) 229-6885

PROJECT LOCATION:

DECATUR BLVD & WASHINGTON AVE

SUB-CONTRACTOR:
CLOVER CABLE

ENTITY NOTES:
24 HOUR/EMERGENCY # FOR CLOVER CABLE: 702-210-7244

SHEET No:
1

Sheet 1 of 1

T20S R60E SEC25

REVISIONS

REV	DESCRIPTION	DATE	BY
1	ENTIRE ROUTE CHANGED FROM AERIAL TO UNDERGROUND	10-10-19	MM

ALL CONSTRUCTION AND MATERIALS SHALL BE IN ACCORDANCE WITH THE "UNIFORM STANDARD SPECIFICATIONS FOR PUBLIC WORKS CONSTRUCTION OFF-SITE IMPROVEMENTS, CLARK COUNTY AREA NEVADA" LATEST ISSUE; THE "UNIFORM STANDARD DRAWINGS FOR PUBLIC WORKS CONSTRUCTION, CLARK COUNTY AREA NEVADA" LATEST ISSUE; AND OTHER APPLICABLE APPROVED STANDARDS ISSUED BY THE CONTROLLING AGENCY; ALL LOCAL CITY CODES AND ORDINANCES APPLICABLE.

APPROVED FOR CONSTRUCTION

THIS APPROVAL IS FOR WORK IN CLV R/W OR CLV EASEMENT ONLY. OBTAINING PERMISSION OR EASEMENT FOR WORK SHOWN IN PRIVATE PROPERTY IS THE RESPONSIBILITY OF THE UTILITY.

APPROVAL *[Signature]* **DATE** 12-2-19

PERMIT # 149601
REV 1
DRAWN BY: MM
DATE: 10/10/2019
SCALE: 1:30
NODE: 149601
PROJECT #: 40520190000149601
TECH # N/A
APPROVED BY: YON HARRIS

COX

BRINGING US CLOSER
1700 VEGAS DRIVE
LAS VEGAS, NEVADA 89106
PHONE: (702) 545-6006
FAX: (702) 545-2606

CITY OF LAS VEGAS

333 N. RANCHO DRIVE
LAS VEGAS, NEVADA 89106
(702) 229-6885

PROJECT LOCATION:

DECATUR BLVD & WASHINGTON AVE

SUB-CONTRACTOR:
CLOVER CABLE

ENTITY NOTES:
24 HOUR/EMERGENCY # FOR CLOVER CABLE: 702-210-7244

SHEET No:
1

Sheet 1 of 1