

Memorandum

Department of Public Works
City Engineer Division
Survey Section
333 North Rancho Dr., 8th Floor
Las Vegas, Nevada 89106

Phone (702) 229-6217
Fax (702) 804-8582

To: Michael Cunningham, Manager
Building and Safety Department

From: Alan R. Riecki, PLS *MR*
City Surveyor

C: Verland K. Pierson, PLS
Actus

Tim Parks, P.E., Engineering Project Manager
Sanitary Sewers Section, Engineering Planning

Date: February 18, 2021

Re: Sanitary Sewer Final Location Map
DECATUR & DONALD I
(Drawing No. 107Y5067-1, L-Civil No. L17-00646)

The Survey Section has reviewed the Final Location Map and as far as our jurisdiction of this project is concerned, we find that the map is:

Acceptable: 02/17/21

MR

Signature

PLS: City Surveyor

Title

Public Works/Survey

Department/Division

ARR/OS:mj

CITY OF LAS VEGAS
BUILDING AND SAFETY DEPARTMENT

OFFSITE INSPECTION & TESTING
333 NORTH RANCHO DRIVE
LAS VEGAS, NV 89106
PHONE: (702) 229-6337
FAX: (702) 631-3000

DEVELOPER'S SUBMITTAL OF LOCATION COORDINATES

- Sewer Storm Drain
- Electronic Comma Delineated File
- Final Location Map (2 copies each for either sewer OR storm drain)


NOTE: THE TOP PART OF THIS FORM MUST BE FILLED OUT IN ITS ENTIRETY

PROJECT NAME: Decatur & Donald I UNIT: PHASE:
PROJECT LOCATION: N Decatur Lane and W Dorrell Lane
CLV PLAN #: L17-00646 CLV PROJECT # 107Y5067-1 SHEET NO. (S): 1 and 2
OF MANHOLES 7 PUB. SEWER/STORM DRAIN LIN. FT. 1893 # OF PRIVATE LATERALS 57

DEVELOPER: Beazer Homes Las Vegas PHONE: 702-802-4428 FAX:
SURVEY CO.: Actus PHONE: 702-586-9296 FAX:
CONTRACTOR: MT. Pine PHONE: 702-677-0452 FAX:
CONTRACTOR'S SUPERVISOR NAME: John Mackey MOBILE: 702-677-0452
DATE OF REQUEST: 01/14/2020

SUBMIT DIRECTLY TO THE OFFICE OF THE CITY SURVEYOR LOCATED ON THE 8th FLOOR OF THE DSC / 333 N Rancho, 89106

Please get a stamped copy of this form for your records.

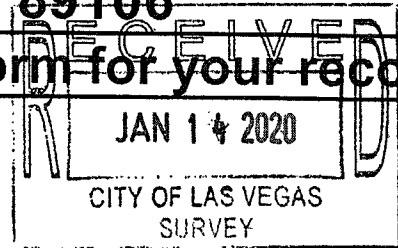

CITY USE ONLY

DATE AND INITIALS / RECEIVED BY THE CITY SURVEYOR

ACCEPTABLE BY CITY SURVEYOR DATE: 2/18/21 NOT ACCEPTABLE BY CITY SURVEYOR DATE

CLV SURVEYOR'S SIGNATURE: *MFL* DATE: 2/18/21

THE CITY OF LAS VEGAS RECOMMENDS THAT ALL DEFICIENCIES NOTED ON THE ATTACHED SURVEY REPORT BE CORRECTED PRIOR TO THE FINAL ACCEPTANCE.

Notes:

- ROUTING:**
- > Once "ACCEPTABLE"; SURVEY to forward a copy of this form to O.I.T. for the file.
 - > Final Location Maps to be forwarded to and retained by Flood Control or Sanitation Engineer respectively.

