

Call before you Dig
1-800-227-2600
Nevada Power Environment and Safety Services Department




Call before you Overhead
1-702-593-6111
Nevada Power Environment and Safety Services Department

NOTE: FINISHED GRADE ELEVATIONS FOR MANHOLES AND DROP INLETS ARE AT THE CENTER OF MANHOLE LIDS AND T.O.C. AT THE CENTER OF DROP INLETS. SET FINISHED GRADE ELEVATIONS FOR THE EDGES OF MANHOLE LIDS AND T.O.C. AT DROP INLETS PER STREET SLOPES.

NOTE: APPROVAL OF THESE PLANS FOR THE WATER STUBOUT INSTALLATION WILL NOT BE CONSTRUED AS A COMMITMENT FOR WATER SERVICE TO THIS PROPERTY.

SERVICE LATERAL KEYNOTES

- 1 INSTALL WATER SERVICE LATERAL, CAP AND BLOWOFF ASSEMBLY PER UDACS PLATE #6B AND #4A.
- 2 INSTALL 12"x8" TEE W/8" GATE VALVES AS SHOWN W/THRUST BLOCKS & ANCHOR BLOCKS PER UDACS PLATES 3# AND #5.
- 3 90° BEND PER UDACS PLATE #5.
- 4 REMOVE EXISTING BLOWOFF, CONNECT TO EXISTING WATERLINE.
- 5 NOT USED.
- 6 INSTALL PVC C-900 WATERLINE PER UDACS PLATE #6B.
- 7 INSTALL PVC SANITARY SEWER PER DETAIL 'D' DWG C330.
- 8 INSTALL 48" SANITARY SEWER MANHOLE TYPE I PER STD. DWG #403.
- 9 INSTALL 12"x6" TEE W/6" GATE VALVES AS SHOWN W/THRUST BLOCKS & ANCHOR BLOCKS PER UDACS PLATES 3# AND #5.
- 10 45° BEND PER UDACS PLATE #5.

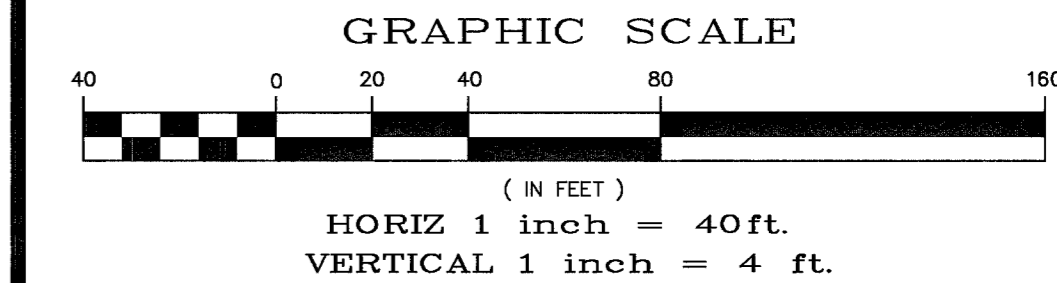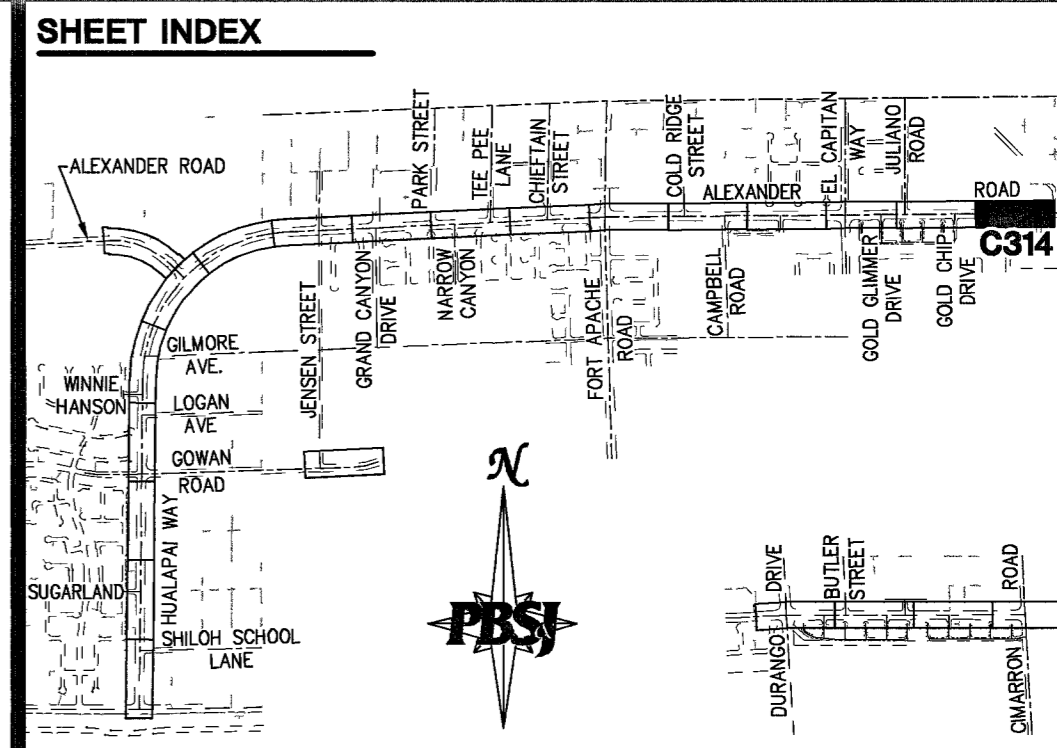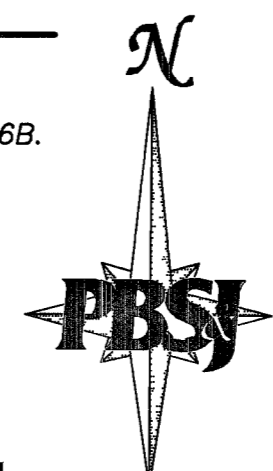


BASIS OF BEARING
THE BASIS OF BEARINGS FOR THIS PROJECT IS GRID NORTH AS DEFINED BY THE NEVADA COORDINATE SYSTEM OF 1983 (NCS83), EAST ZONE, (2701), DETERMINED BY GIS CONTROL POINTS "808" AND "877" AS SHOWN ON A RECORD OF SURVEY ON FILE IN THE CLARK COUNTY RECORDER'S OFFICE, IN FILE 88 OF SURVEYS, AT PAGE 53.

BENCHMARK
CITY OF LAS VEGAS BENCHMARK NO. 9LV00 7N4 - RIVET AND PLATE IN TOP OF CURB SOUTHEAST CORNER OF ALEXANDER ROAD AND GRAND CANYON DRIVE.
NAVD 1988 DATUM
ELEVATION = 792.858 METERS
2601.24 FEET

CAUTION:
EXISTING UTILITIES ARE LOCATED ON THE PLANS FROM A SEARCH OF AVAILABLE RECORDS. CONTRACTOR TO VERIFY LOCATIONS AND DEPTHS PRIOR TO CONSTRUCTION.

KEY NOTES


- 1 REMOVE EXISTING MANHOLE.
- 2 REMOVE EXISTING DROP INLET/BEEHIVE INLET.
- 3 REMOVE EXISTING 36" STORM DRAIN PIPE.
- 4 REMOVE EXISTING 66" STORM DRAIN PIPE.
- 5 ABANDON IN PLACE EXISTING 18" STORM DRAIN PIPE.
- 6 INSTALL TYPE I MANHOLE PER STD. DWG. #403.
- 7 INSTALL TYPE II MANHOLE PER STD. DWG. #405.
- 8 INSTALL TYPE III MANHOLE PER STD. DWG. #406.
- 9 INSTALL JUNCTION MANHOLE TYPE I PER DETAIL 'A', DWG. C327.
- 10 INSTALL PRECAST TEE W/48" RISER PER DETAIL 'B', DWG. C331 (W/30" MIN. ACCESS).
- 11 INSTALL TYPE 'CM' DROP INLET PER DETAIL 'A', DWG. C329.
- 12 INSTALL TYPE 'E' DROP INLET PER DETAIL 'A', DWG. C328.
- 13 INSTALL TYPE 'F' DROP INLET PER DETAIL 'A', DWG. C328.
- 14 INSTALL NDOT TYPE 3 DROP INLET WITH BACK WALL OPENING PER DETAIL 'D' AND DETAIL 'E', DWG. C332.
- 15 INSTALL SWALE INLET PER DETAIL 'B', DWG. C329.
- 16 CONSTRUCT NDOT TYPE II HEADWALL PER NDOT STANDARD PLAN SHEET B-20.1.4.
- 17 INSTALL AWWA 8" C900 DRAINLINE.
- 18 INSTALL AWWA 12" C900 DRAINLINE.
- 19 INSTALL 12" RCP SD PER TRENCH DETAIL 'B', DWG. C330.
- 20 INSTALL 18" RCP SD PER TRENCH DETAIL 'B', DWG. C330.
- 21 INSTALL 24" RCP SD PER TRENCH DETAIL 'B', DWG. C330.
- 22 INSTALL 30" RCP SD PER TRENCH DETAIL 'B', DWG. C330.
- 23 INSTALL 36" RCP SD PER TRENCH DETAIL 'B', DWG. C330.
- 24 INSTALL 42" RCP SD PER TRENCH DETAIL 'B', DWG. C330.
- 25 INSTALL 48" RCP SD PER TRENCH DETAIL 'B', DWG. C330.
- 26 INSTALL 54" RCP SD PER TRENCH DETAIL 'B', DWG. C330.
- 27 INSTALL 60" RCP SD PER TRENCH DETAIL 'B', DWG. C330.
- 28 INSTALL 72" RCP SD PER TRENCH DETAIL 'B', DWG. C330.
- 29 INSTALL 78" RCP SD PER TRENCH DETAIL 'B', DWG. C330.
- 30 INSTALL 78" RCP SD PER TRENCH DETAIL 'B', DWG. C330.
- 31 INSTALL 34"x53" HE RCP SD PER TRENCH DETAIL 'B', DWG. C330.
- 32 INSTALL 3' HIGH x 6' WIDE RCB SD PER TRENCH DETAIL 'B', DWG. C330.
- 33 INSTALL 5' HIGH x 6' WIDE RCB SD PER TRENCH DETAIL 'B', DWG. C330.
- 34 RELOCATE EXISTING WATERLINE PER DETAIL 'E', DWG. C330.
- 35 RELOCATE EXISTING GAS (BY OTHERS).
- 36 RELOCATE EXISTING UNDERGROUND POWER (BY NEVADA POWER COMPANY).
- 37 RELOCATE EXISTING UNDERGROUND TELEPHONE (BY SPRINT TELEPHONE COMPANY).
- 38 RELOCATE EXISTING UNDERGROUND CATV (BY COX COMMUNICATIONS LAS VEGAS, INC.).
- 39 CONCRETE ENCASMENT PER DETAIL 'A', DWG. C330.
- 40 PERMANENT ASPHALT PATCH PER DETAIL 'B', DWG. C330.
- 41 PIPE PENETRATION PER DETAIL 'A' DWG. C332.
- 42 CONNECT TO EXISTING STORM DRAIN PIPE PER DETAIL 'C', DWG. C330.

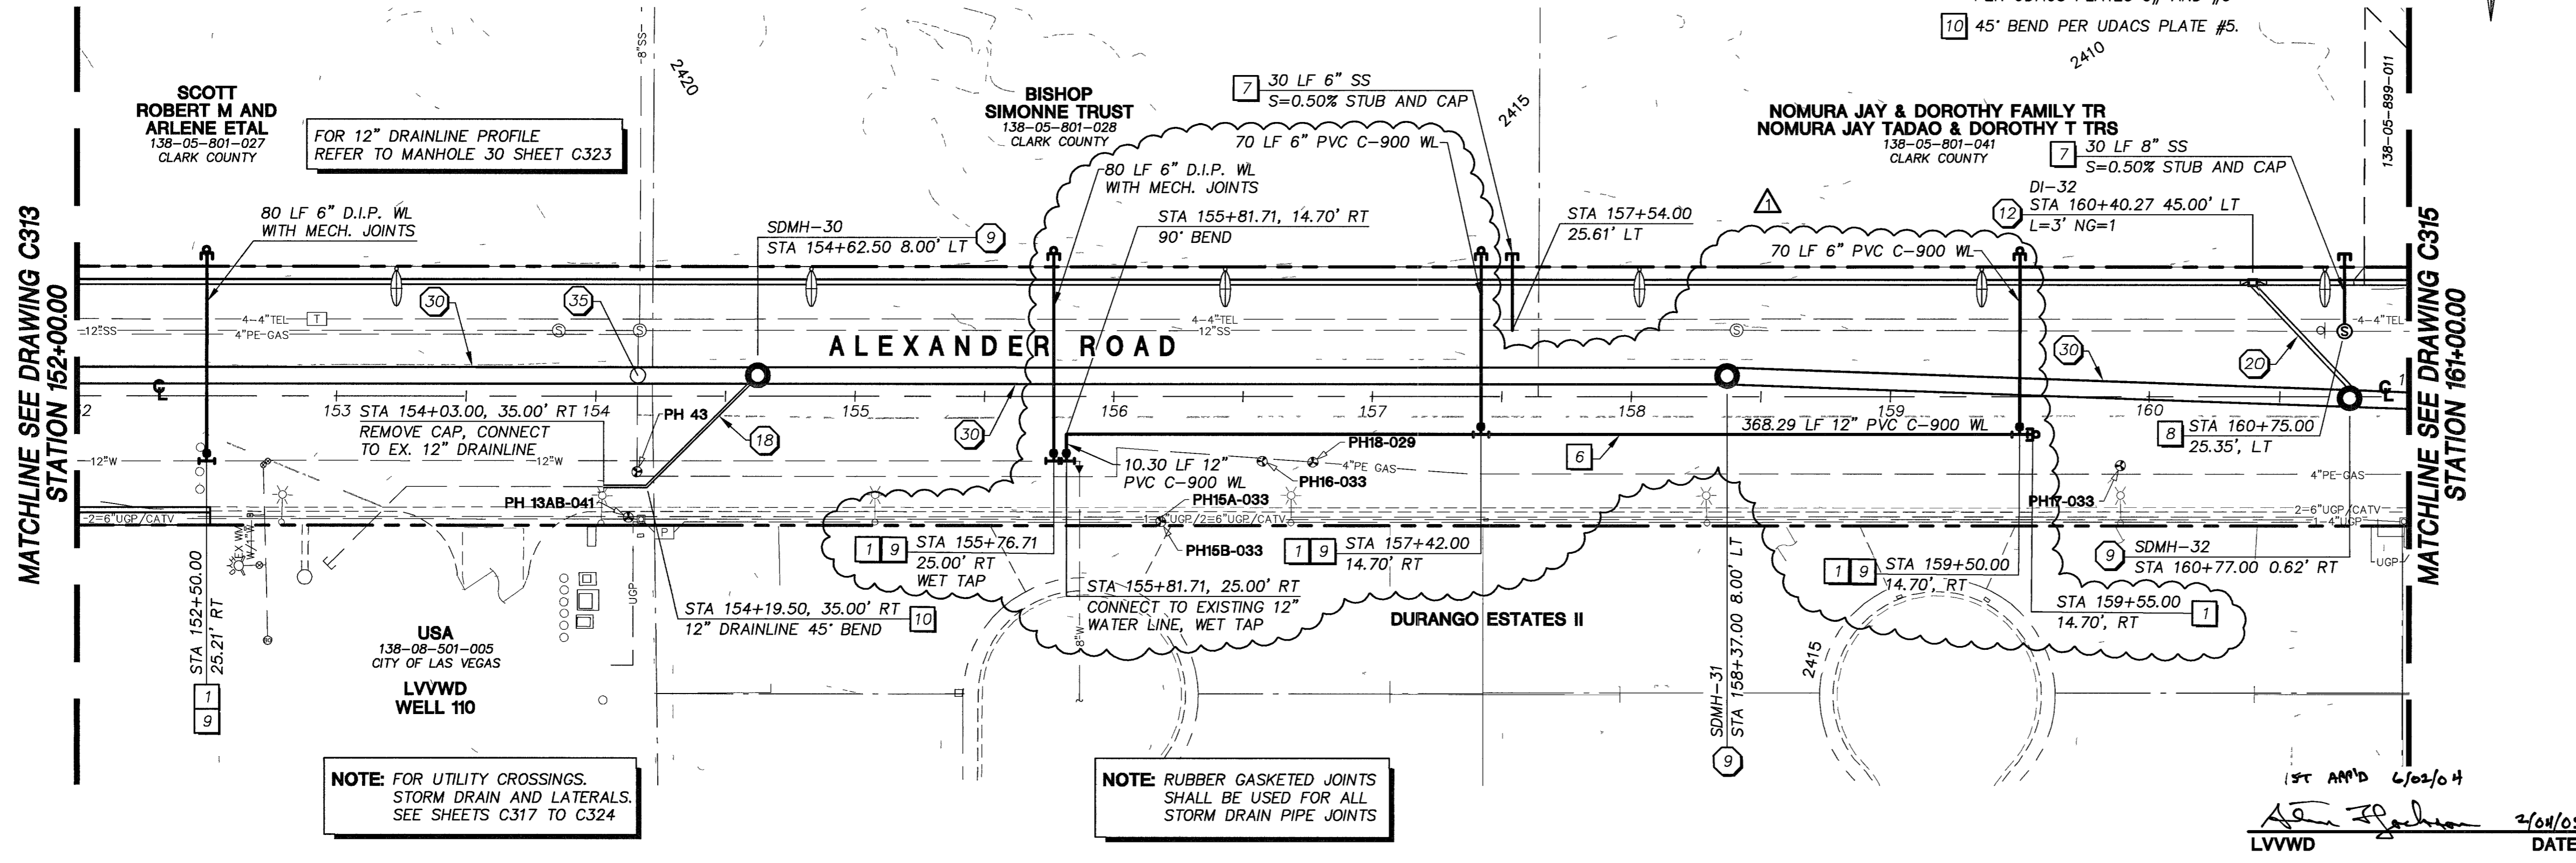

NOTE: FOR UTILITY CROSSINGS, STORM DRAIN AND LATERALS, SEE SHEETS C317 TO C324.

NOTE: RUBBER GASKETED JOINTS SHALL BE USED FOR ALL STORM DRAIN PIPE JOINTS.

1st APP'D 6/20/04
L.V.V.W.D.
DATE 2/04/05

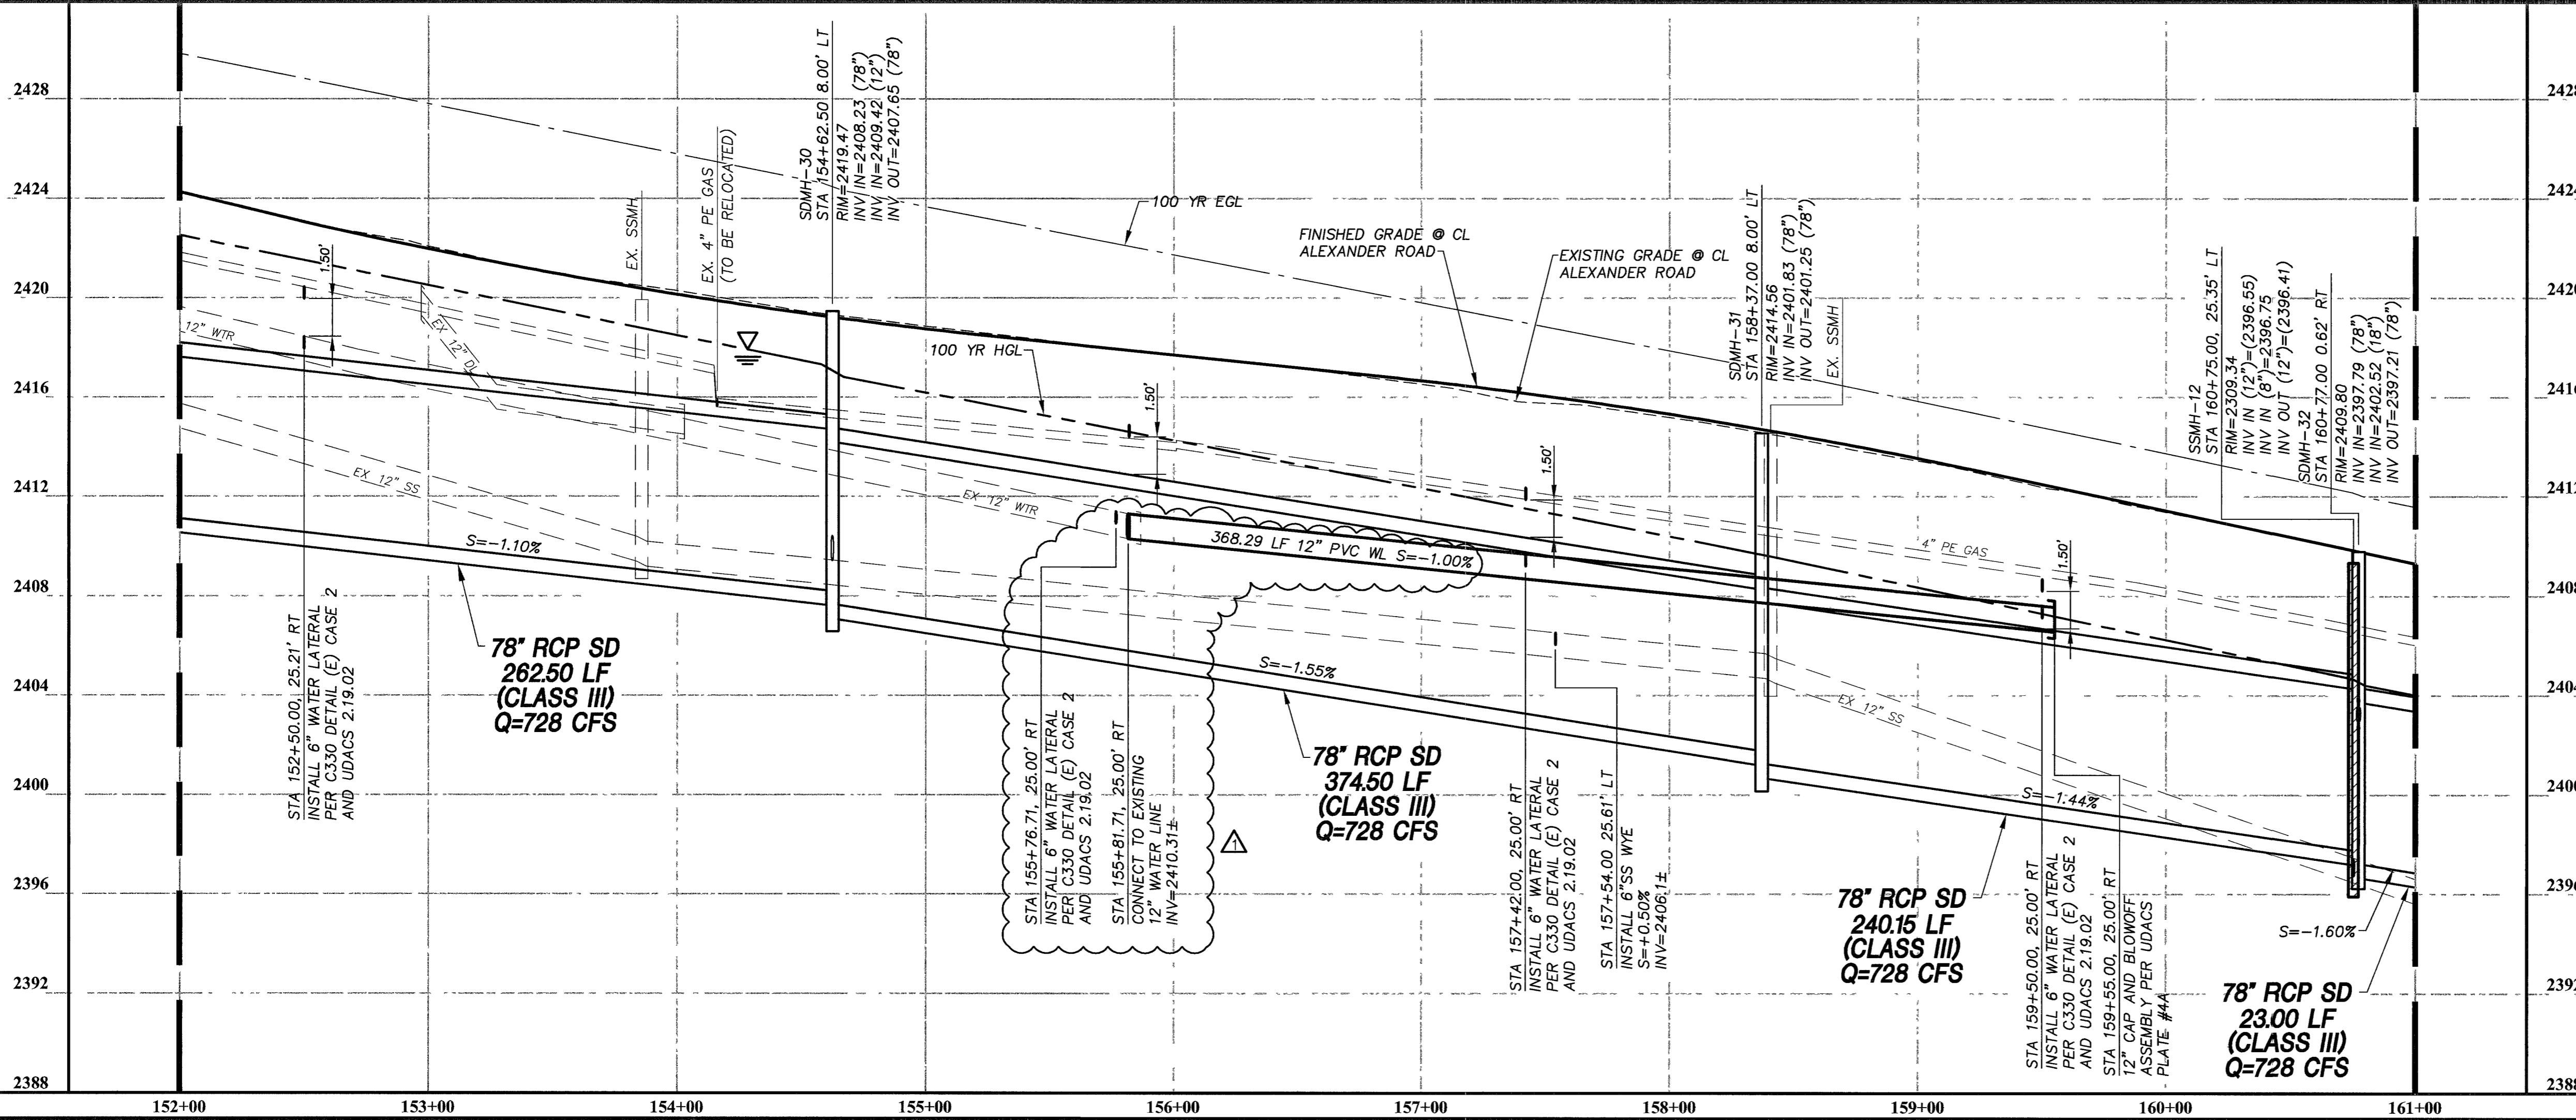

DEPARTMENT OF PUBLIC WORKS
ENGINEERING DESIGN SECTION

ALEXANDER ROAD/HUALAPAI WAY
ROAD IMPROVEMENTS PROJECT
CHEYENNE AVENUE TO DURANGO DRIVE

ALEXANDER ROAD STORM DRAIN PLAN
AND PROFILE, WATER AND SEWER LATERAL
STA 152+00.00 TO STA 161+00.00

PROJECT ENGINEER: CHARLES KAIKOWSKI, JR., P.E.
CITY PROJECT ENGINEER: MARVIN STINE, P.E.
PROJECT MANAGER: ALI ZENHARI, P.E.
DESIGN BY: W.H. WELLS
DRAWN BY: LSB/W.H.U.

CHECK BY: LSB
DATE: FEB. 11, 2004

19365

SHEET
C314
67 of 124
DRAWING#
107-V-3594

T:\projects\1400\C314-1400 01-26-05 *1-26-05 01:45pm USER: 11122 *XREFS: 1400-BRR; 1400-TP; 1400-MP 01-06-05; 1400-UT; 1400-PRG; 1400-D01-06-05; 1400-PPS 01-17-05; 1400-STLT; 1400-MPS 01-17-05; 1400-WFS 01-26-05; 1400-PFSL 01-26-05; 1400-GR