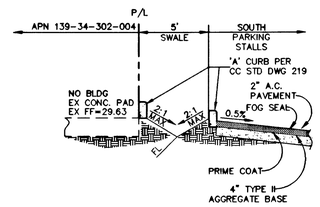

A / D1 **SECTION A**

NTS

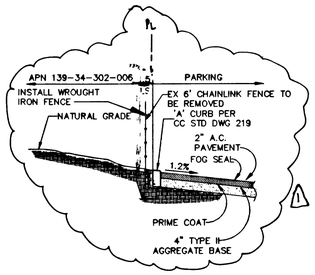

B / D1 **SECTION B**

NTS

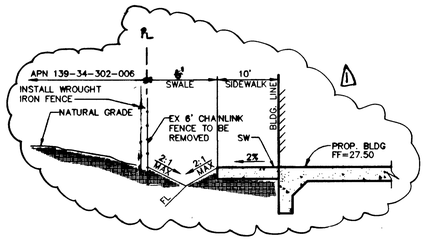

C / D1 **SECTION C**

NTS

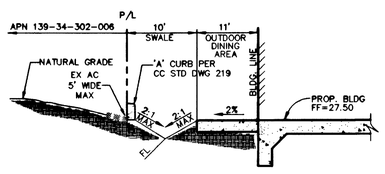

D / D1 **SECTION D**

NTS

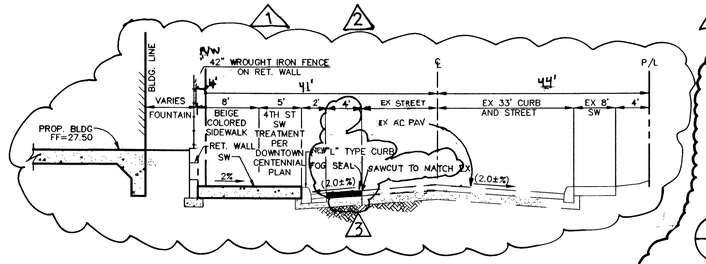

E / D1 **SECTION E**

NTS

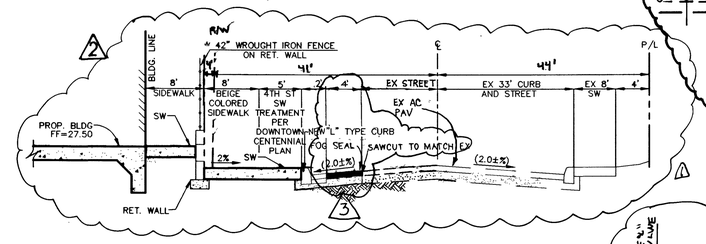

F / D1 **SECTION F**

NTS

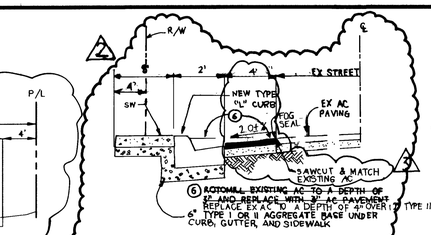

G / D1 **SECTION G**

NTS

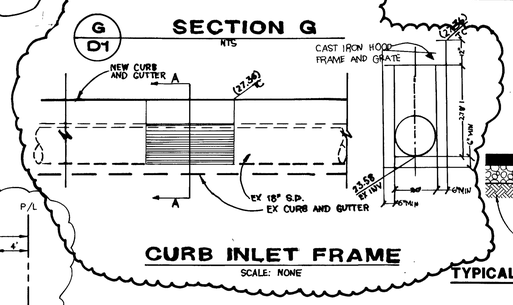

CURB INLET FRAME

SCALE: NONE

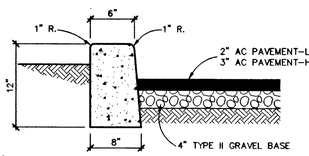

"A" TYPE CURB DETAIL

SCALE: NONE

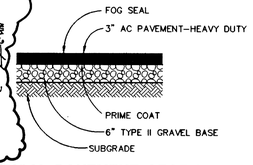

TYPICAL PAVEMENT SECTION

SCALE: NONE

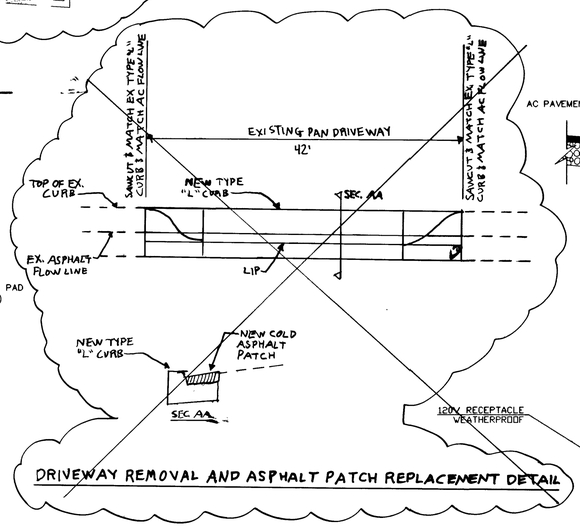

DRIVEWAY REMOVAL AND ASPHALT PATCH REPLACEMENT DETAIL

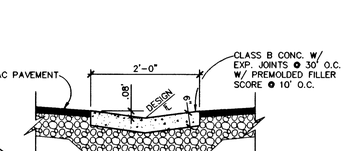

2' VALLEY GUTTER

SCALE: NONE

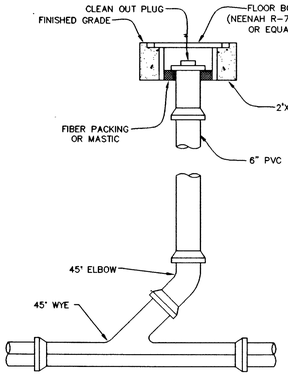

CLEANOUT BOX DETAIL

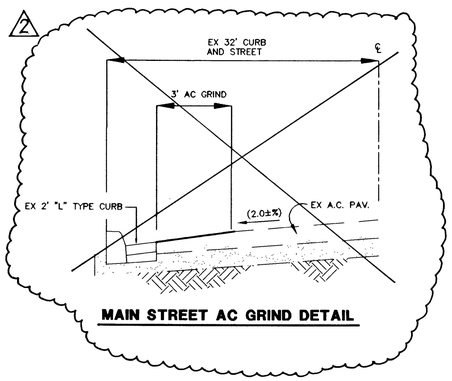

MAIN STREET AC GRIND DETAIL

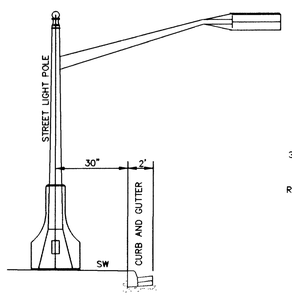

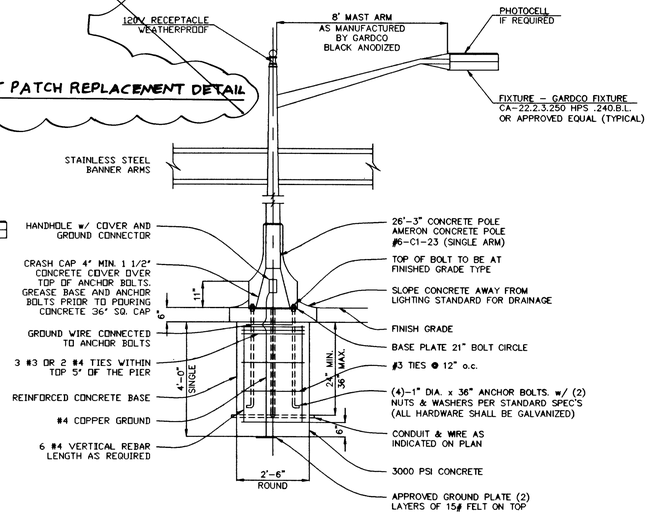

STREET LIGHT POLE BASE DIAGRAM

SCALE: NONE

BENCHMARK

CITY OF LAS VEGAS BENCHMARK NO. 6C0134SW6
RIVET & PLATE IN THE TOP OF CURB, EAST CURB LINE ON LIGHT BASE, 200' ± SOUTH OF BONNEVILLE AVE ON MAIN STREET

ELEVATION = 617.8070 METERS
(2027.25 U.S. SURVEY FEET) NAVD88 DATUM

METERS X $\left(\frac{3937}{1200}\right)$ = U.S. SURVEY FEET

1. THE ELEVATIONS SHOWN HEREON ARE BASED ON FEET.

BASIS OF BEARINGS

THE SOUTH LINE OF THE SOUTHEAST QUARTER (SE 1/4) OF SECTION 15, TOWNSHIP 20 SOUTH, RANGE 60 EAST, M.D.M., BEING THE CENTERLINE OF SMOKE RANCH ROAD, BEARS SOUTH 89°39'29" EAST AS SHOWN ON THE PLAT OF LAS VEGAS TECHNOLOGY CENTER, BOOK 38, PAGE 91 OF PLATS, OFFICIAL RECORDS OF CLARK COUNTY, NEVADA.

42786 44953 50927 51483
Ford Mast Round Mast 41'

REVISION	BY	DATE	REV
ADJUST DETAILS B, C, E, & F FOR PROPERTY LINE, ADJUSTMENT, APPARENT, ADD ASPHALT	MSP	11-24-02	1
REMOVE SW, CURB, GUTTER & PARKING AND REPLACE WITH ASPHALT, REMOVE TYPE "L" CURB AND GUTTER, ROTOMILL EX. AC AND REPLACE WITH NEW AC PAVEMENT, NEW TYPE "L" CURB AND GUTTER, NEW CURB INLET FRAME GRATE AND CURB BOX.	CGV	3-27-03	2
4" OVER A 12" TYPE II SAWCUT & MATCH EXISTING AC	CGV	4-16-08	3

JMB CONSTRUCTION, INC
1118 SHARP CIRCLE, STE E
NORTH LAS VEGAS, NEVADA 89030
(702) 642-3600

WRIGHT CIVIL ENGINEERS, INC
7310 SMOKE RANCH ROAD, SUITE F
LAS VEGAS, NEVADA 89128
TEL (702) 233-6400 FAX (702) 233-1164
CIVIL STRUCTURAL LAND SURVEYING

WRIGHT ENGINEERS

SHEET: DETAIL SHEET
TITLE: ICE HOUSE LOUNGE

DRAWN BY: SFC
DESIGNED BY: SFC
CHECKED BY:
PROJECT NO: CN2214701
SCALE: 1"=30'
6-01-02
6-01-02

PROFESSIONAL ENGINEER STATE OF NEVADA STEPHEN R. CREVOSERAM CIVIL No. 13688
07-16-02

SHEET D1
4 OF 67 SHEETS
DRAWING NO. 107-V3598