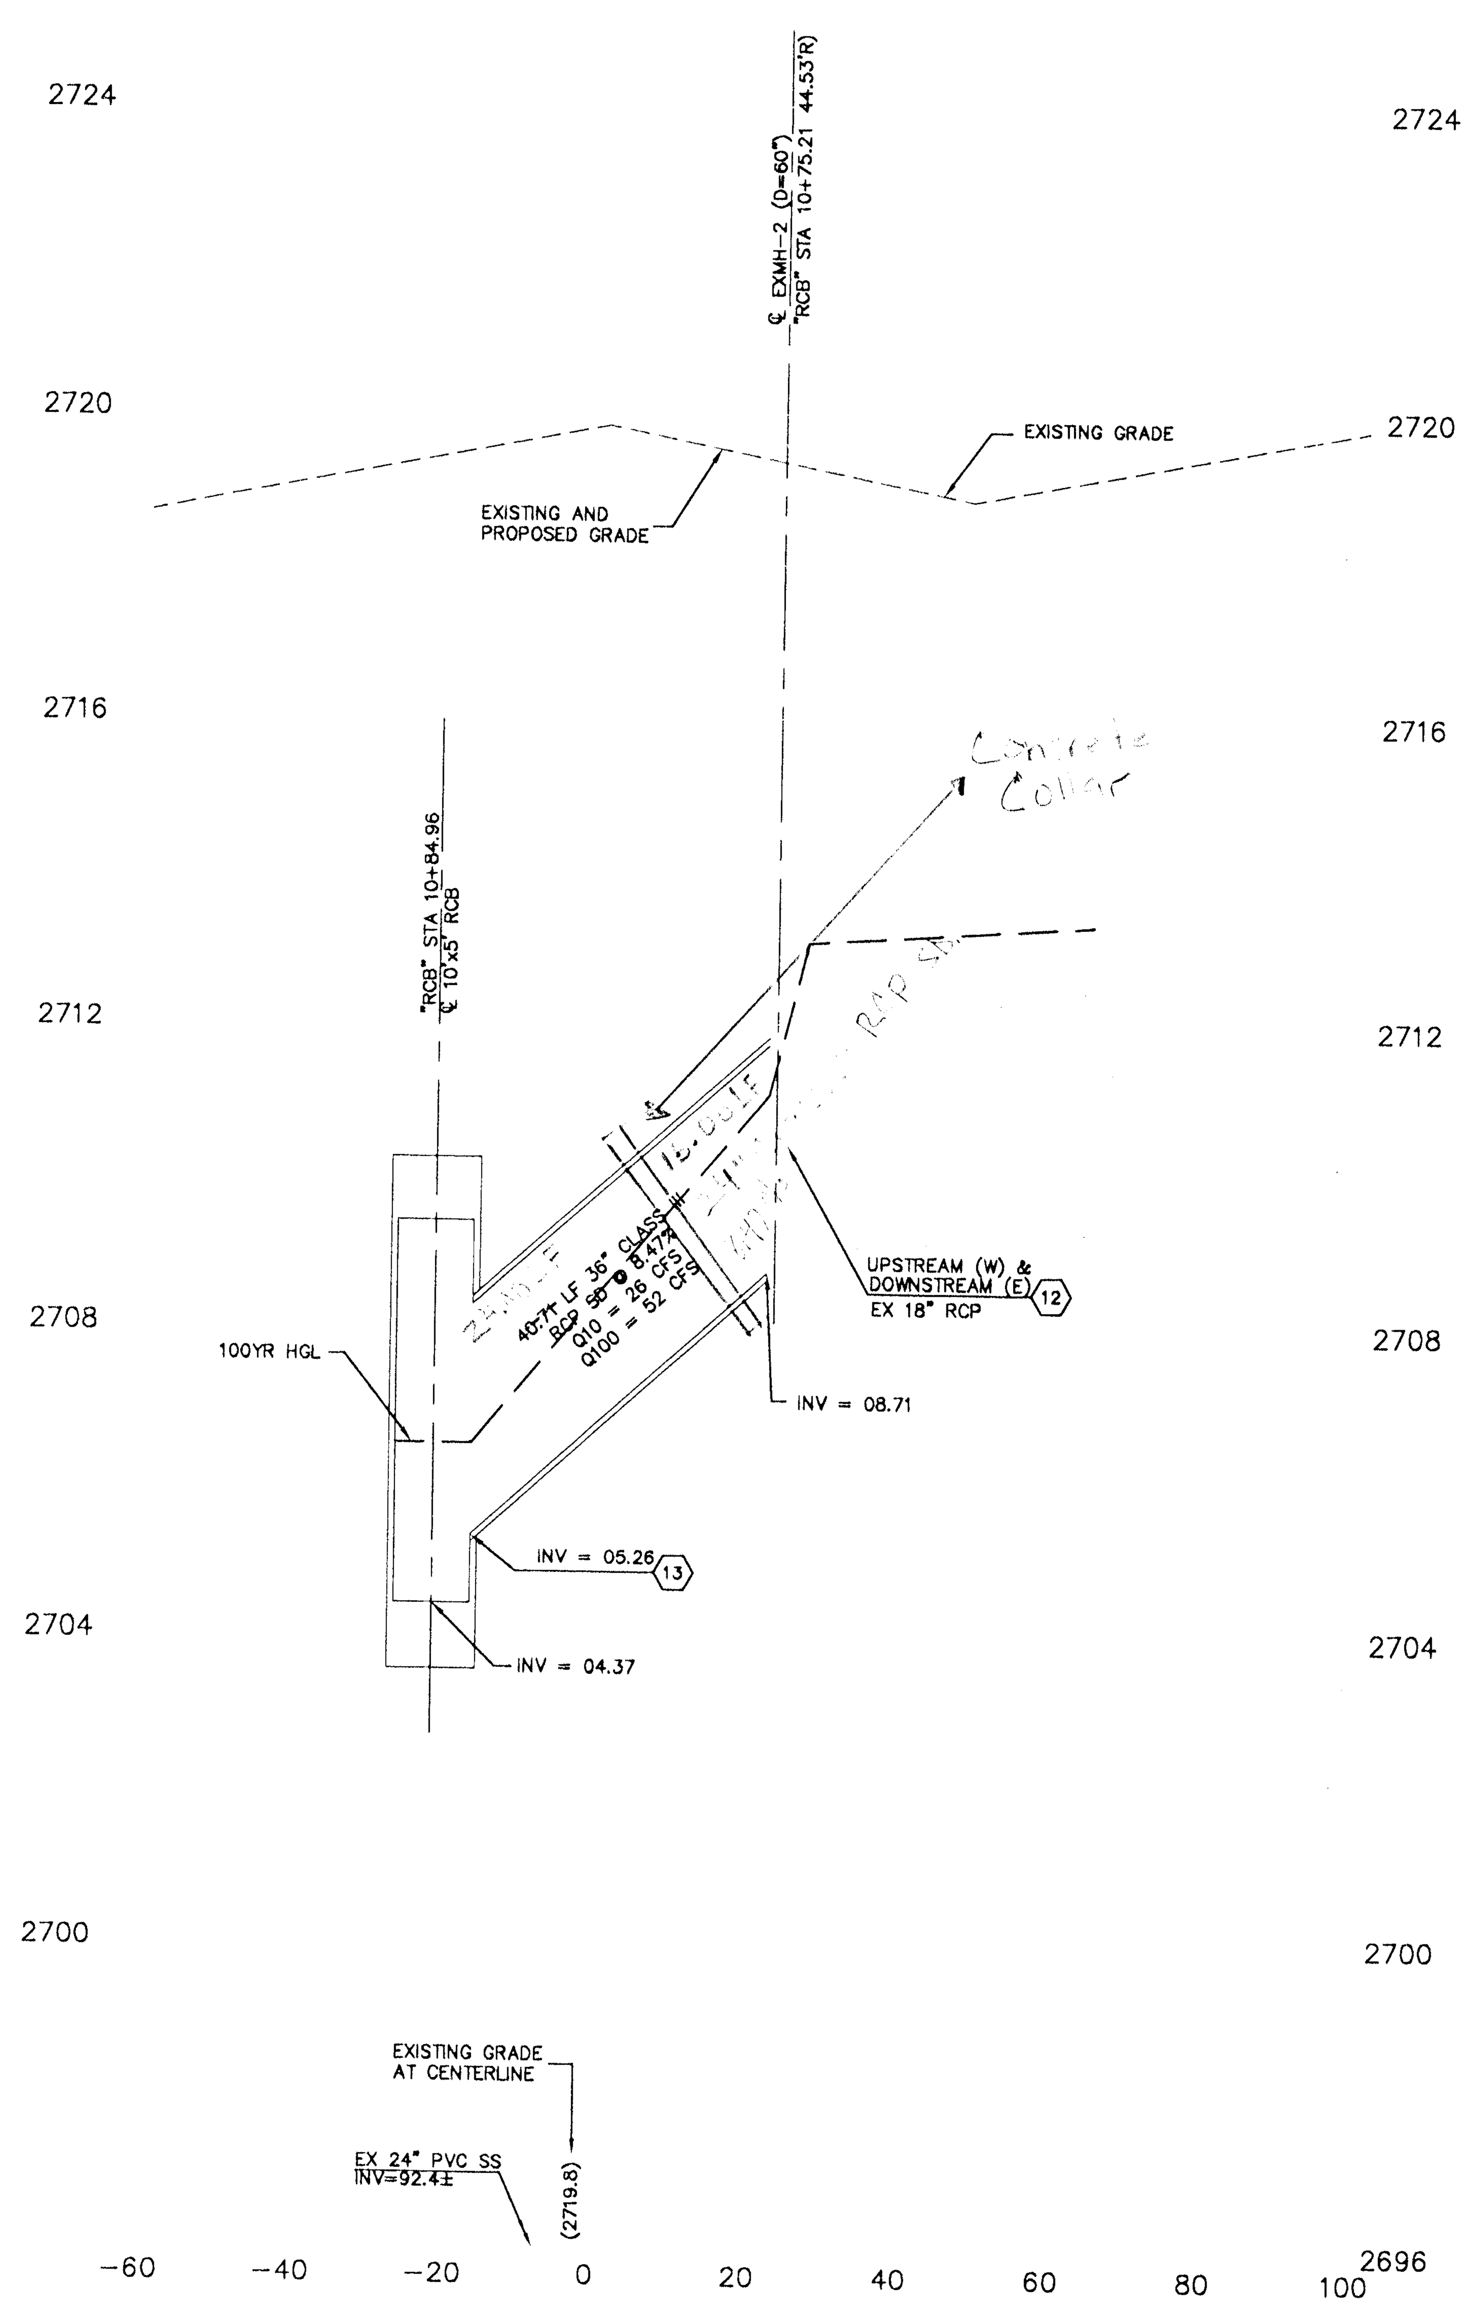

"RCB" STA 10+84.96 ℄ PIPE (XMH2 / SD1)

SCALE: 1"=20' H; 1"=2' V

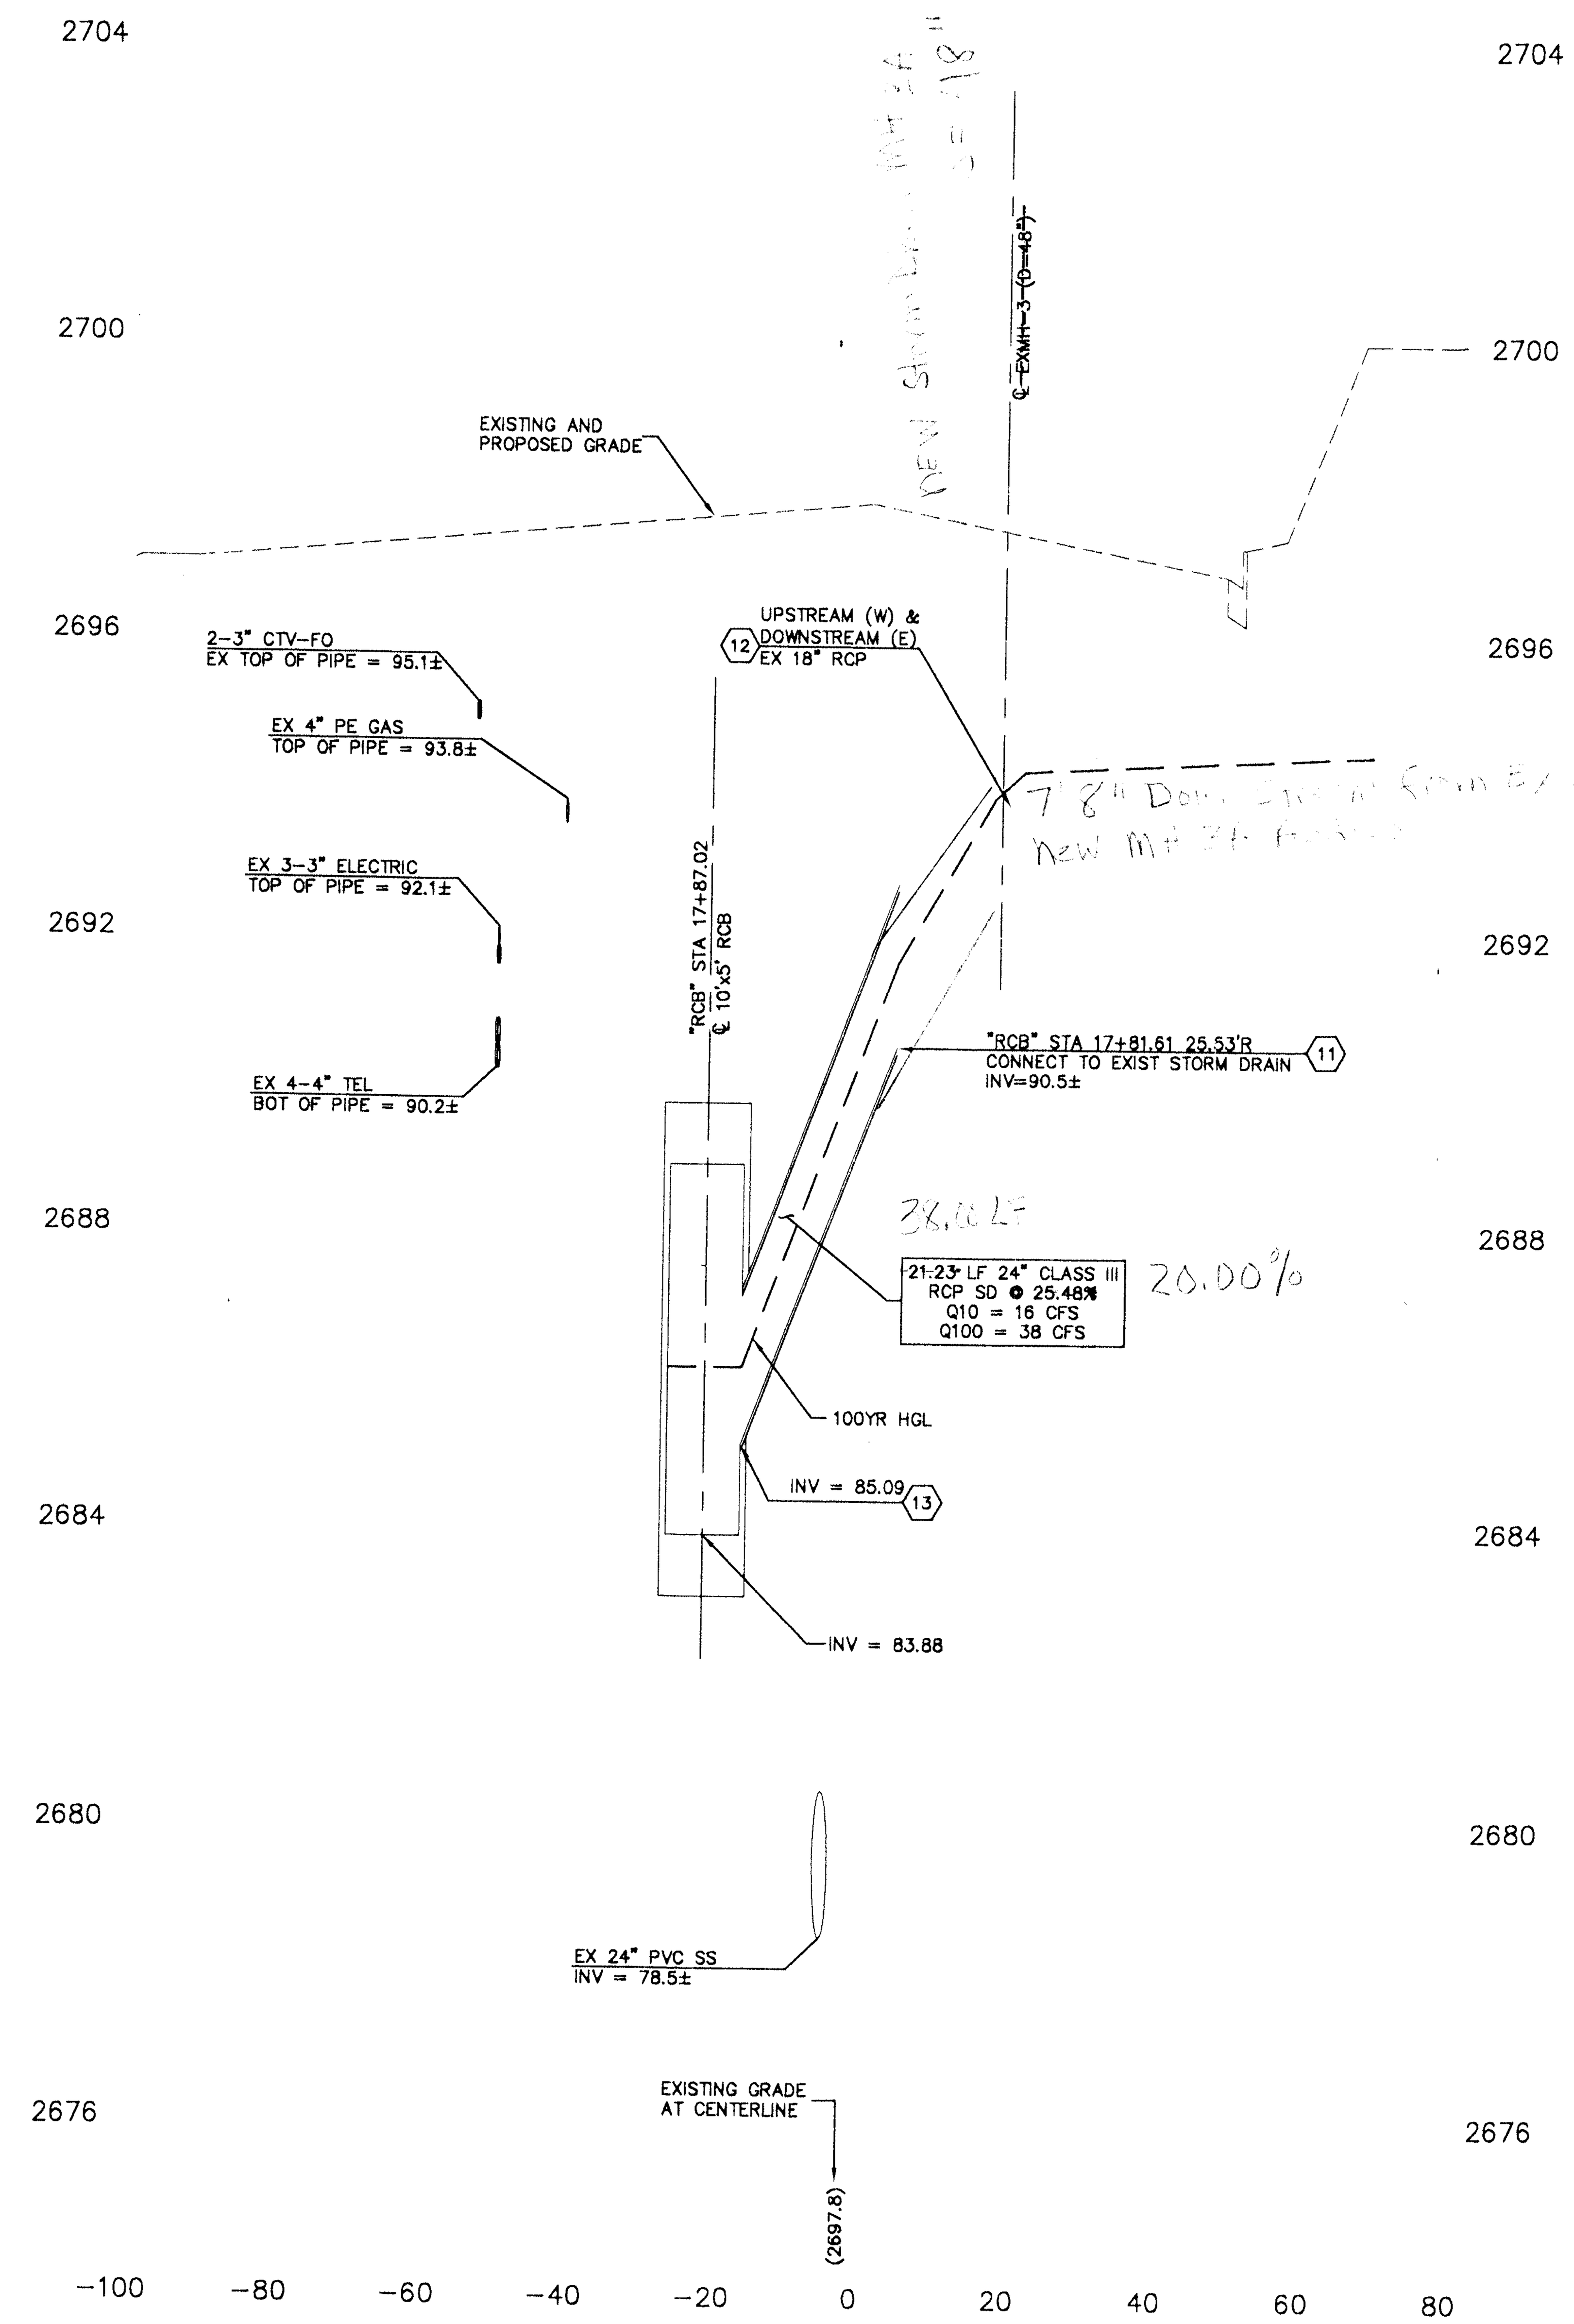

"RCB" STA 17+87.02 ℄ PIPE (XMH3 / SD1)

SCALE: 1"=20' H; 1"=2' V

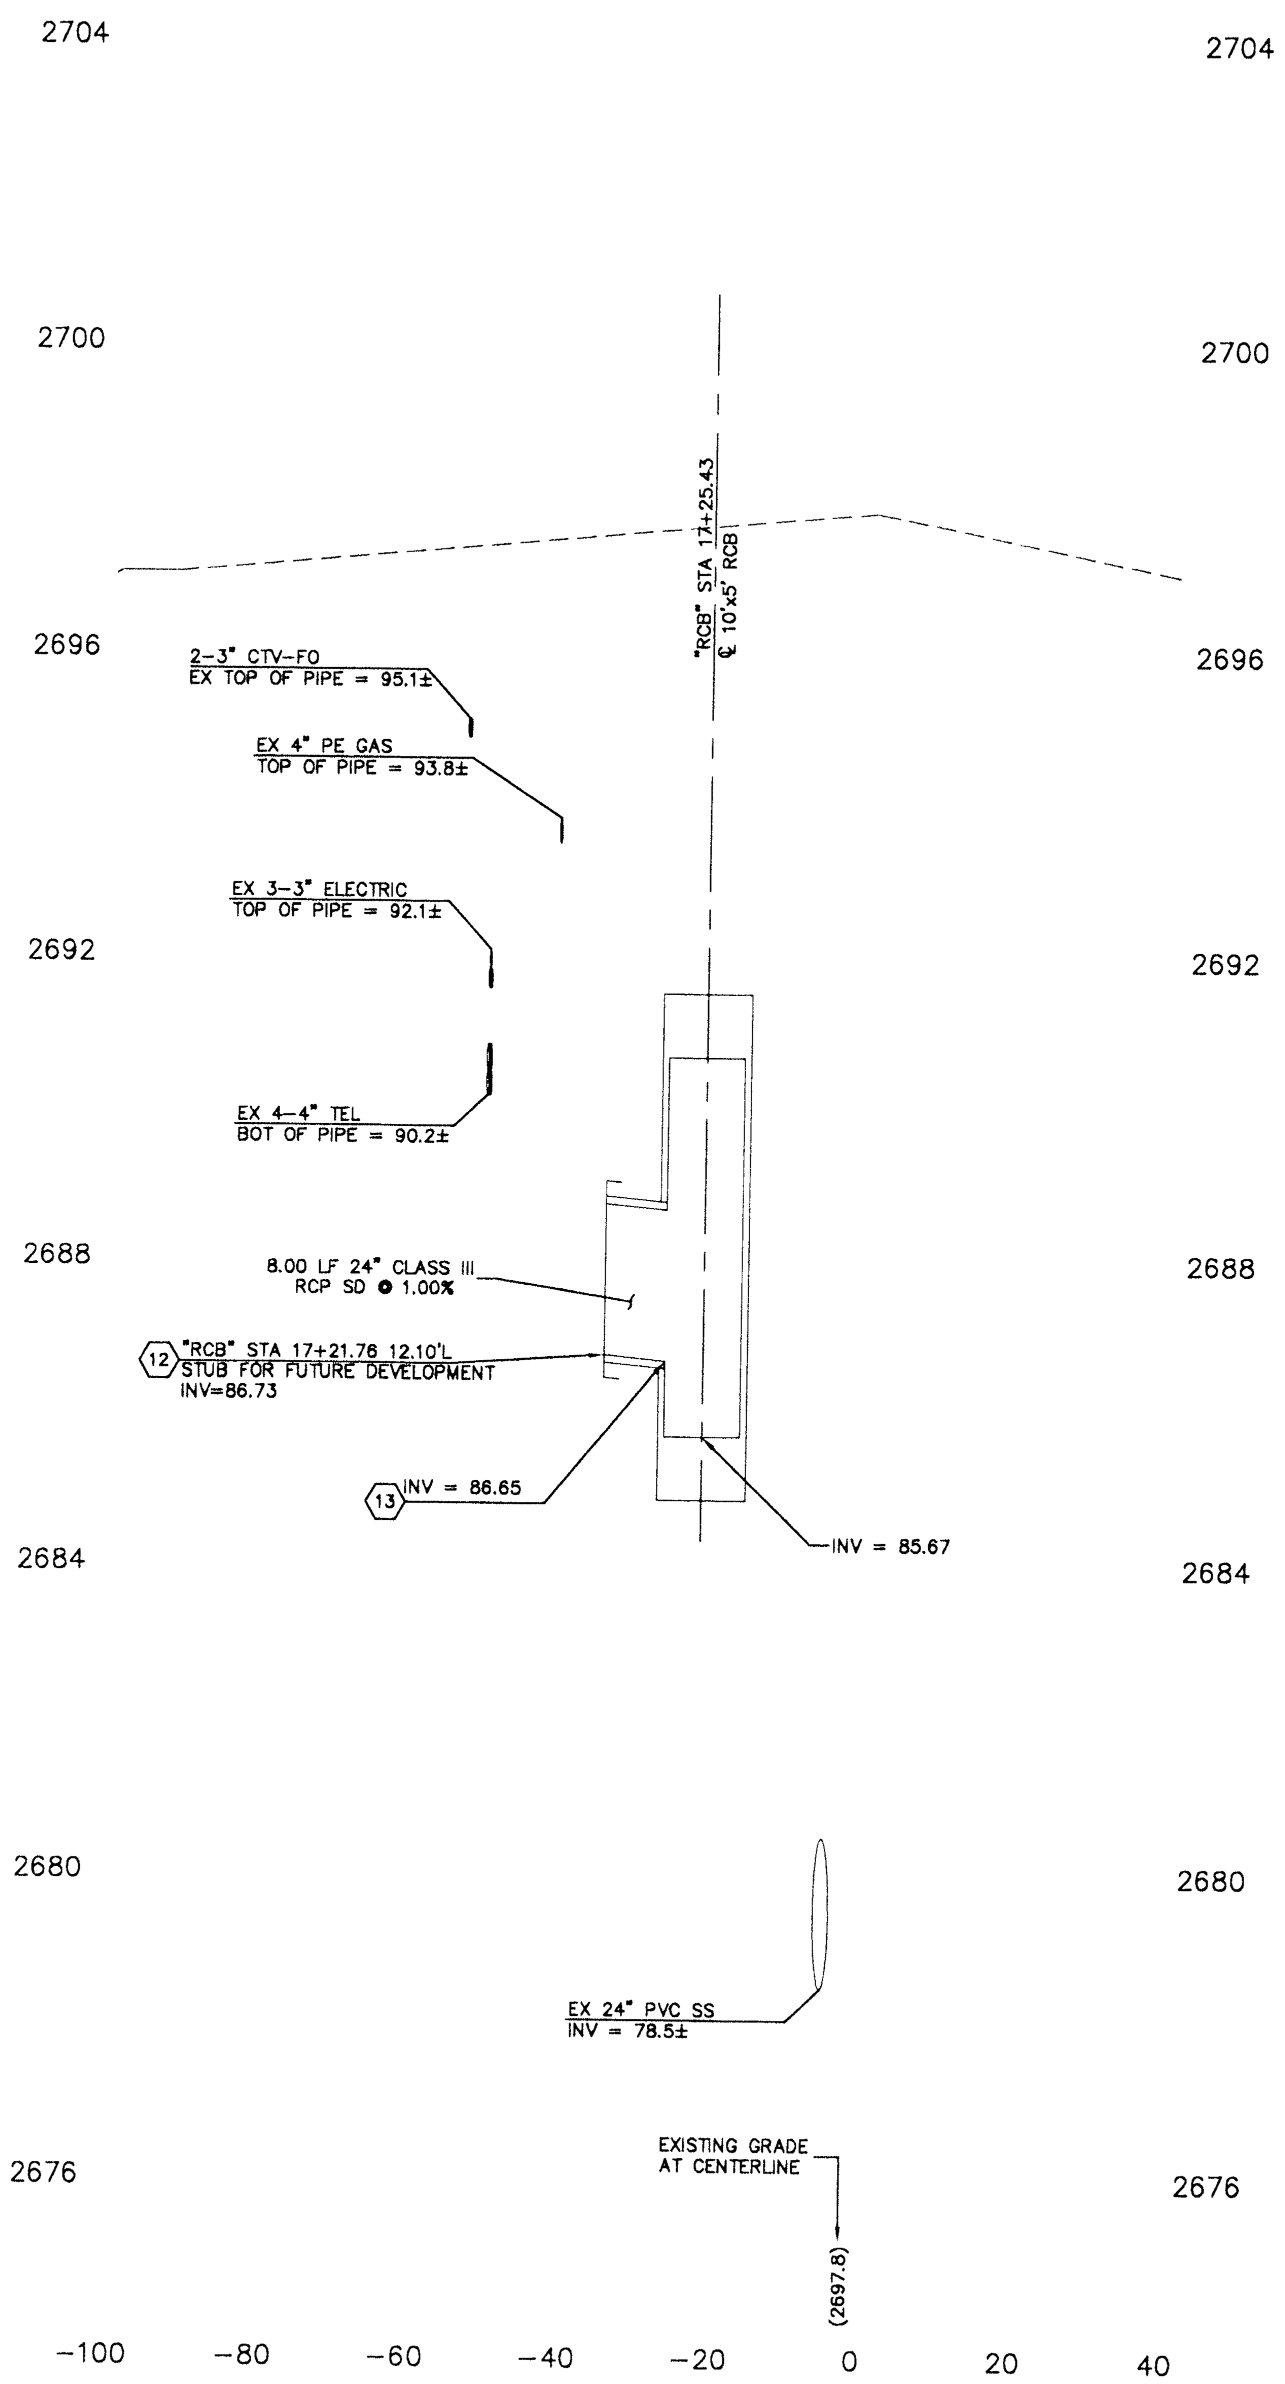

"RCB" STA 17+25.43 ℄ PIPE (SO1 / SD1)

SCALE: 1"=20' H; 1"=2' V

UTILITY NOTES

1. UTILITY LOCATIONS SHOWN HEREON ARE APPROXIMATE ONLY. IT SHALL BE THE CONTRACTORS RESPONSIBILITY TO DETERMINE THE EXACT VERTICAL AND HORIZONTAL LOCATION OF ALL EXISTING UNDERGROUND UTILITIES PRIOR TO COMMENCING CONSTRUCTION. NO REPRESENTATION IS MADE THAT ALL EXISTING UTILITIES ARE SHOWN HEREON. THE ENGINEER ASSUMES NO RESPONSIBILITY FOR UTILITIES NOT SHOWN OR UTILITIES NOT SHOWN IN THEIR PROPER LOCATION.
2. IT SHALL BE THE CONTRACTORS RESPONSIBILITY TO PROTECT ALL EXISTING UTILITIES DURING CONSTRUCTION. ANY UTILITIES DAMAGED DURING CONSTRUCTION MUST BE REPAIRED IMMEDIATELY AND TO THE OWNERS SATISFACTION AT THE CONTRACTORS EXPENSE.

STORM DRAIN NOTES

(11) CONSTRUCT ANGLED RCP CONNECTION. SEE DETAIL 2, SHEET SD-14

(12) BRICK AND MORTAR PLUG RCP PER DETAIL 4 SHEET SD-15

(13) PIPE PENETRATION OF RCB TO BE PER DETAIL 6 SHEET SD-14

GRAPHIC SCALE

20 0 10 20 40

(IN FEET)
1 inch = 20 ft.

Call before you Underground 1-702-455-7511 — Call before you Overhead 1-702-227-2929 — Call before you Dig 811 1-800-227-2600

HTE NO. 22726

123948

REVISIONS

NO.	DATE:	DESCRIPTION	APP'D

DEPARTMENT OF PUBLIC WORKS
400 EAST STEWART
LAS VEGAS, NEVADA 89101
(702) 229-6276

poggemeyer design group, inc.

TITLE: GRAND TETON DRIVE STORM DRAIN

SHEET: STORM DRAIN - LATERAL PROFILES EXMH-2, EXMH-3, AND SO1

DRAWN BY: AP	11/20/08	
DESIGNED BY: JMC	11/20/08	
CHECKED BY: JSL/JLW	11/20/08	
PROJECT NO: 03188-C	SCALE: 1"=20' HORIZ 1"=2' VERT	

PROFESSIONAL ENGINEER STATE OF NEVADA — JOSEPH L. WEED — EXP. 6-30-10 — CIVIL — No. 18559

Sheet SD-8

15 of 30

DRAWING NO. 107V3757

G:\03188 - Grand Teton Drive\CIVIL\SD8.dwg 11/26/2008 2:18:05 PM