
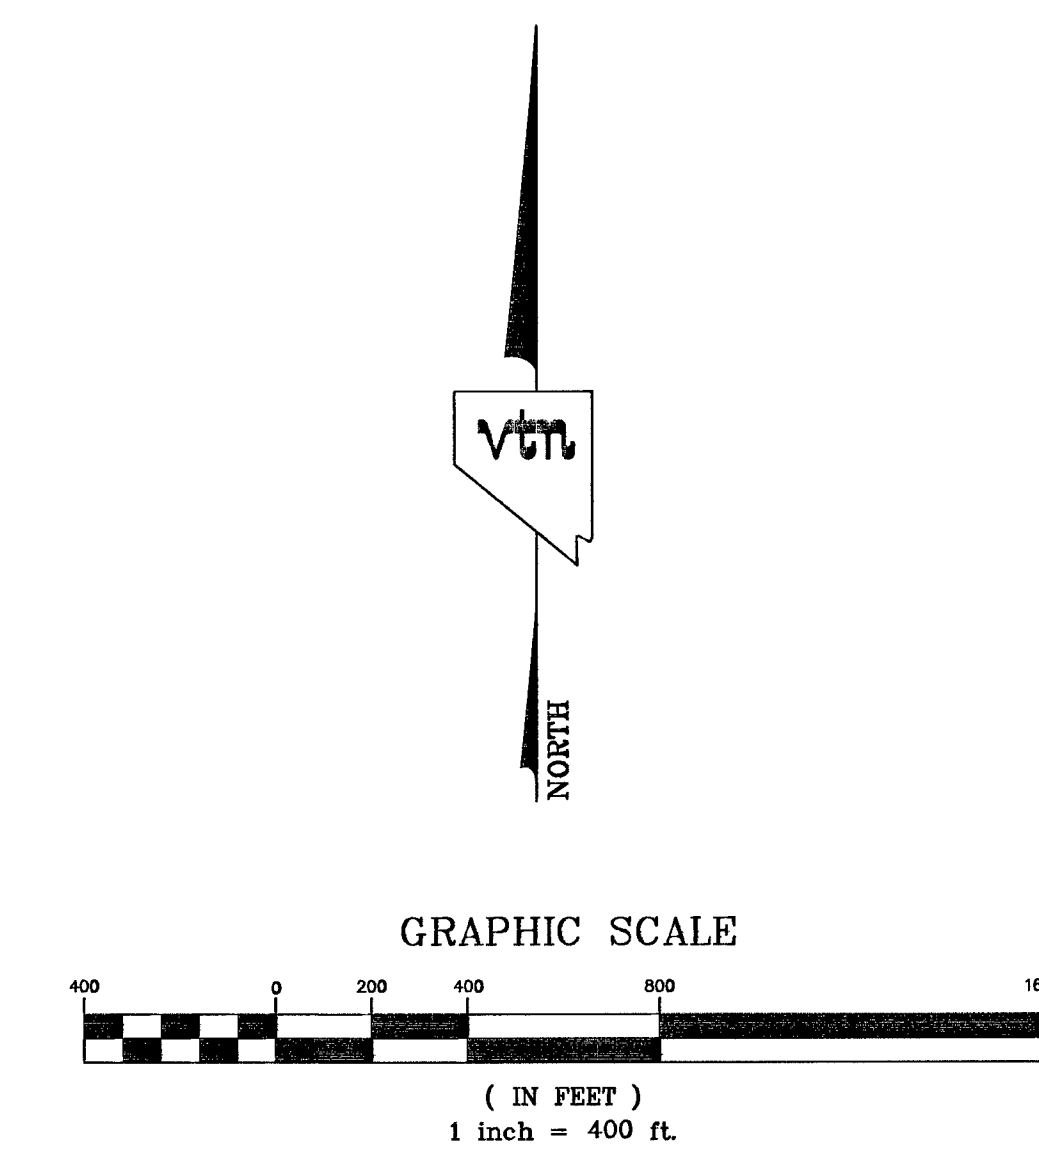


RECORD OF SURVEY

SECTIONS 7 AND 8, TOWNSHIP 19 SOUTH,
RANGE 60 EAST, M.D.M., CITY OF LAS VEGAS, CLARK COUNTY, NEVADA

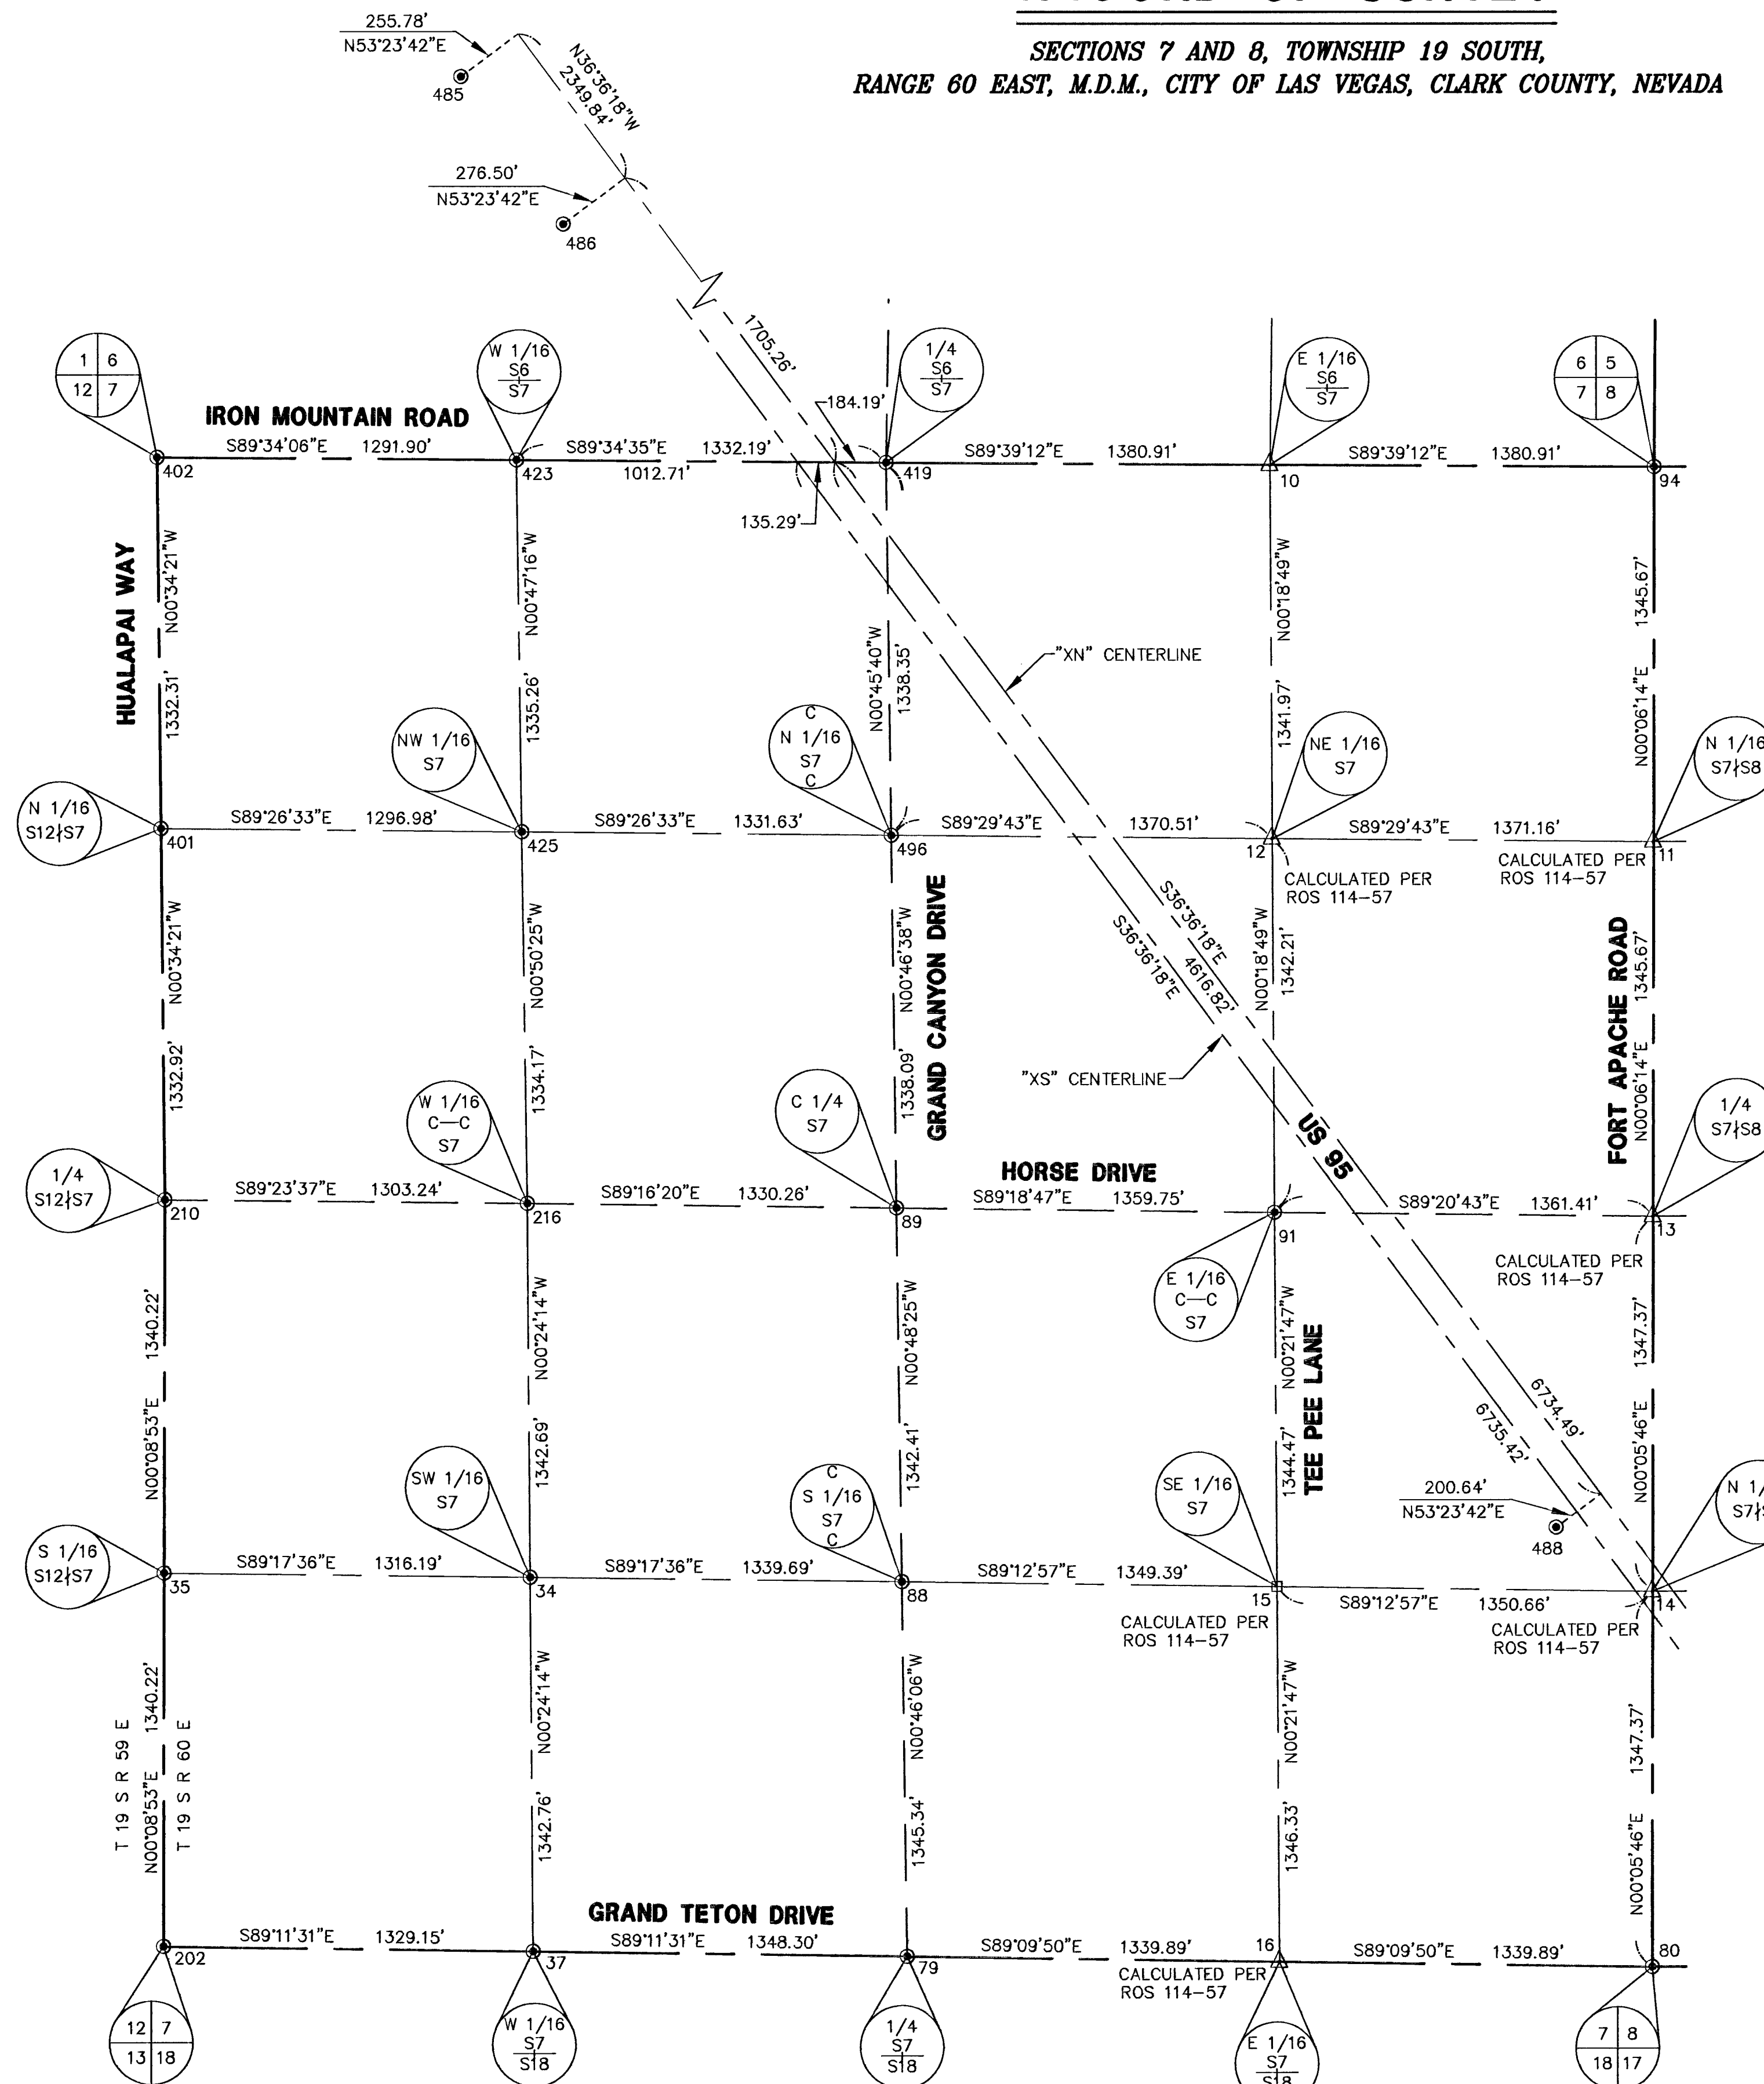

LEGEND

●	FOUND MONUMENT AS INDICATED
△	SET MONUMENT AS INDICATED
□	CALCULATED POINT
—	SECTION LINE
- - -	QUARTER SECTION LINE
- - - - -	SIXTEENTH SECTION LINE

vtm CONSULTING ENGINEERS • PLANNERS • LAND SURVEYORS
2727 SOUTH RAINBOW BOULEVARD
LAS VEGAS, NEVADA 89146
(702) 873-7550 FAX (702) 382-2597

RECORD OF SURVEY
FOR
THE CITY OF LAS VEGAS DEPARTMENT OF PUBLIC WORKS
SECTIONS 7 AND 8, TOWNSHIP 19 SOUTH,
RANGE 60 EAST, M.D.M., CITY OF LAS VEGAS, CLARK COUNTY, NEVADA

SCALE: 1"=400'	W.O.# 6093	NOV. 2003	SHEET	OF
FILE: 6093SRVY	DRN. BY: MSC	REV.:	2	3
CKD. BY: SL				

PUBLIC WORKS DEPARTMENT CITY OF LAS VEGAS, NV	
SURVEY CONTROL PLAN XI EMBEDDED RECORD OF SURVEY	HORSE DRIVE / US 95 INTERCHANGE
DRAWN BY: KAK	7/16/08
DESIGNED BY:	
CHECKED BY: VEL	7/16/08
PROJECT NO: 6500	SCALE: 1"=400'
	HORIZ. N/A
	VERT. N/A
SHEET SV11 12 OF 453 SHEETS	
CLV DRAWING NO. 107V3759	
REVISION	DATE BY

114187

G:\6500\6500CTRL_DWG\GR-SV-11