


**LEGEND:**

- DENOTES PBS (PLANTMIX BITUMINOUS SURFACE) SEE TYP CROSS SECTIONS
- DENOTES SAWCUT LINE FOR PBS (PLANTMIX BITUMINOUS SURFACE)
- "HD1" DENOTES NEW CL HORSE DR/FT APACHE RD RAMP 1
- EXIST NDOT RIGHT-OF-WAY

**CONSTRUCTION NOTES:**

- 3 INSTALL GALVANIZED GUARD RAIL (TRIPLE CORRUGATION); GUARD RAIL TERMINAL (FLARED) PER NDOT STD DWG NO. R-8.1.1. CONTRACTOR TO FIELD VERIFY HORIZONTAL & VERTICAL LOCATION OF ANY NEW AND/OR EXISTING UNDERGROUND FACILITIES PRIOR TO INSTALLATION OF GUARD RAIL
- 7 GRADING HINGE LINE (SEE TYP SECTIONS, STORM DRAIN & GRADING PLANS)

**NOTE:**  
 FOR STORM DRAIN REMOVAL, PROTECT IN PLACE & GRADING INFORMATION SEE SHEET SD1 THRU SD43

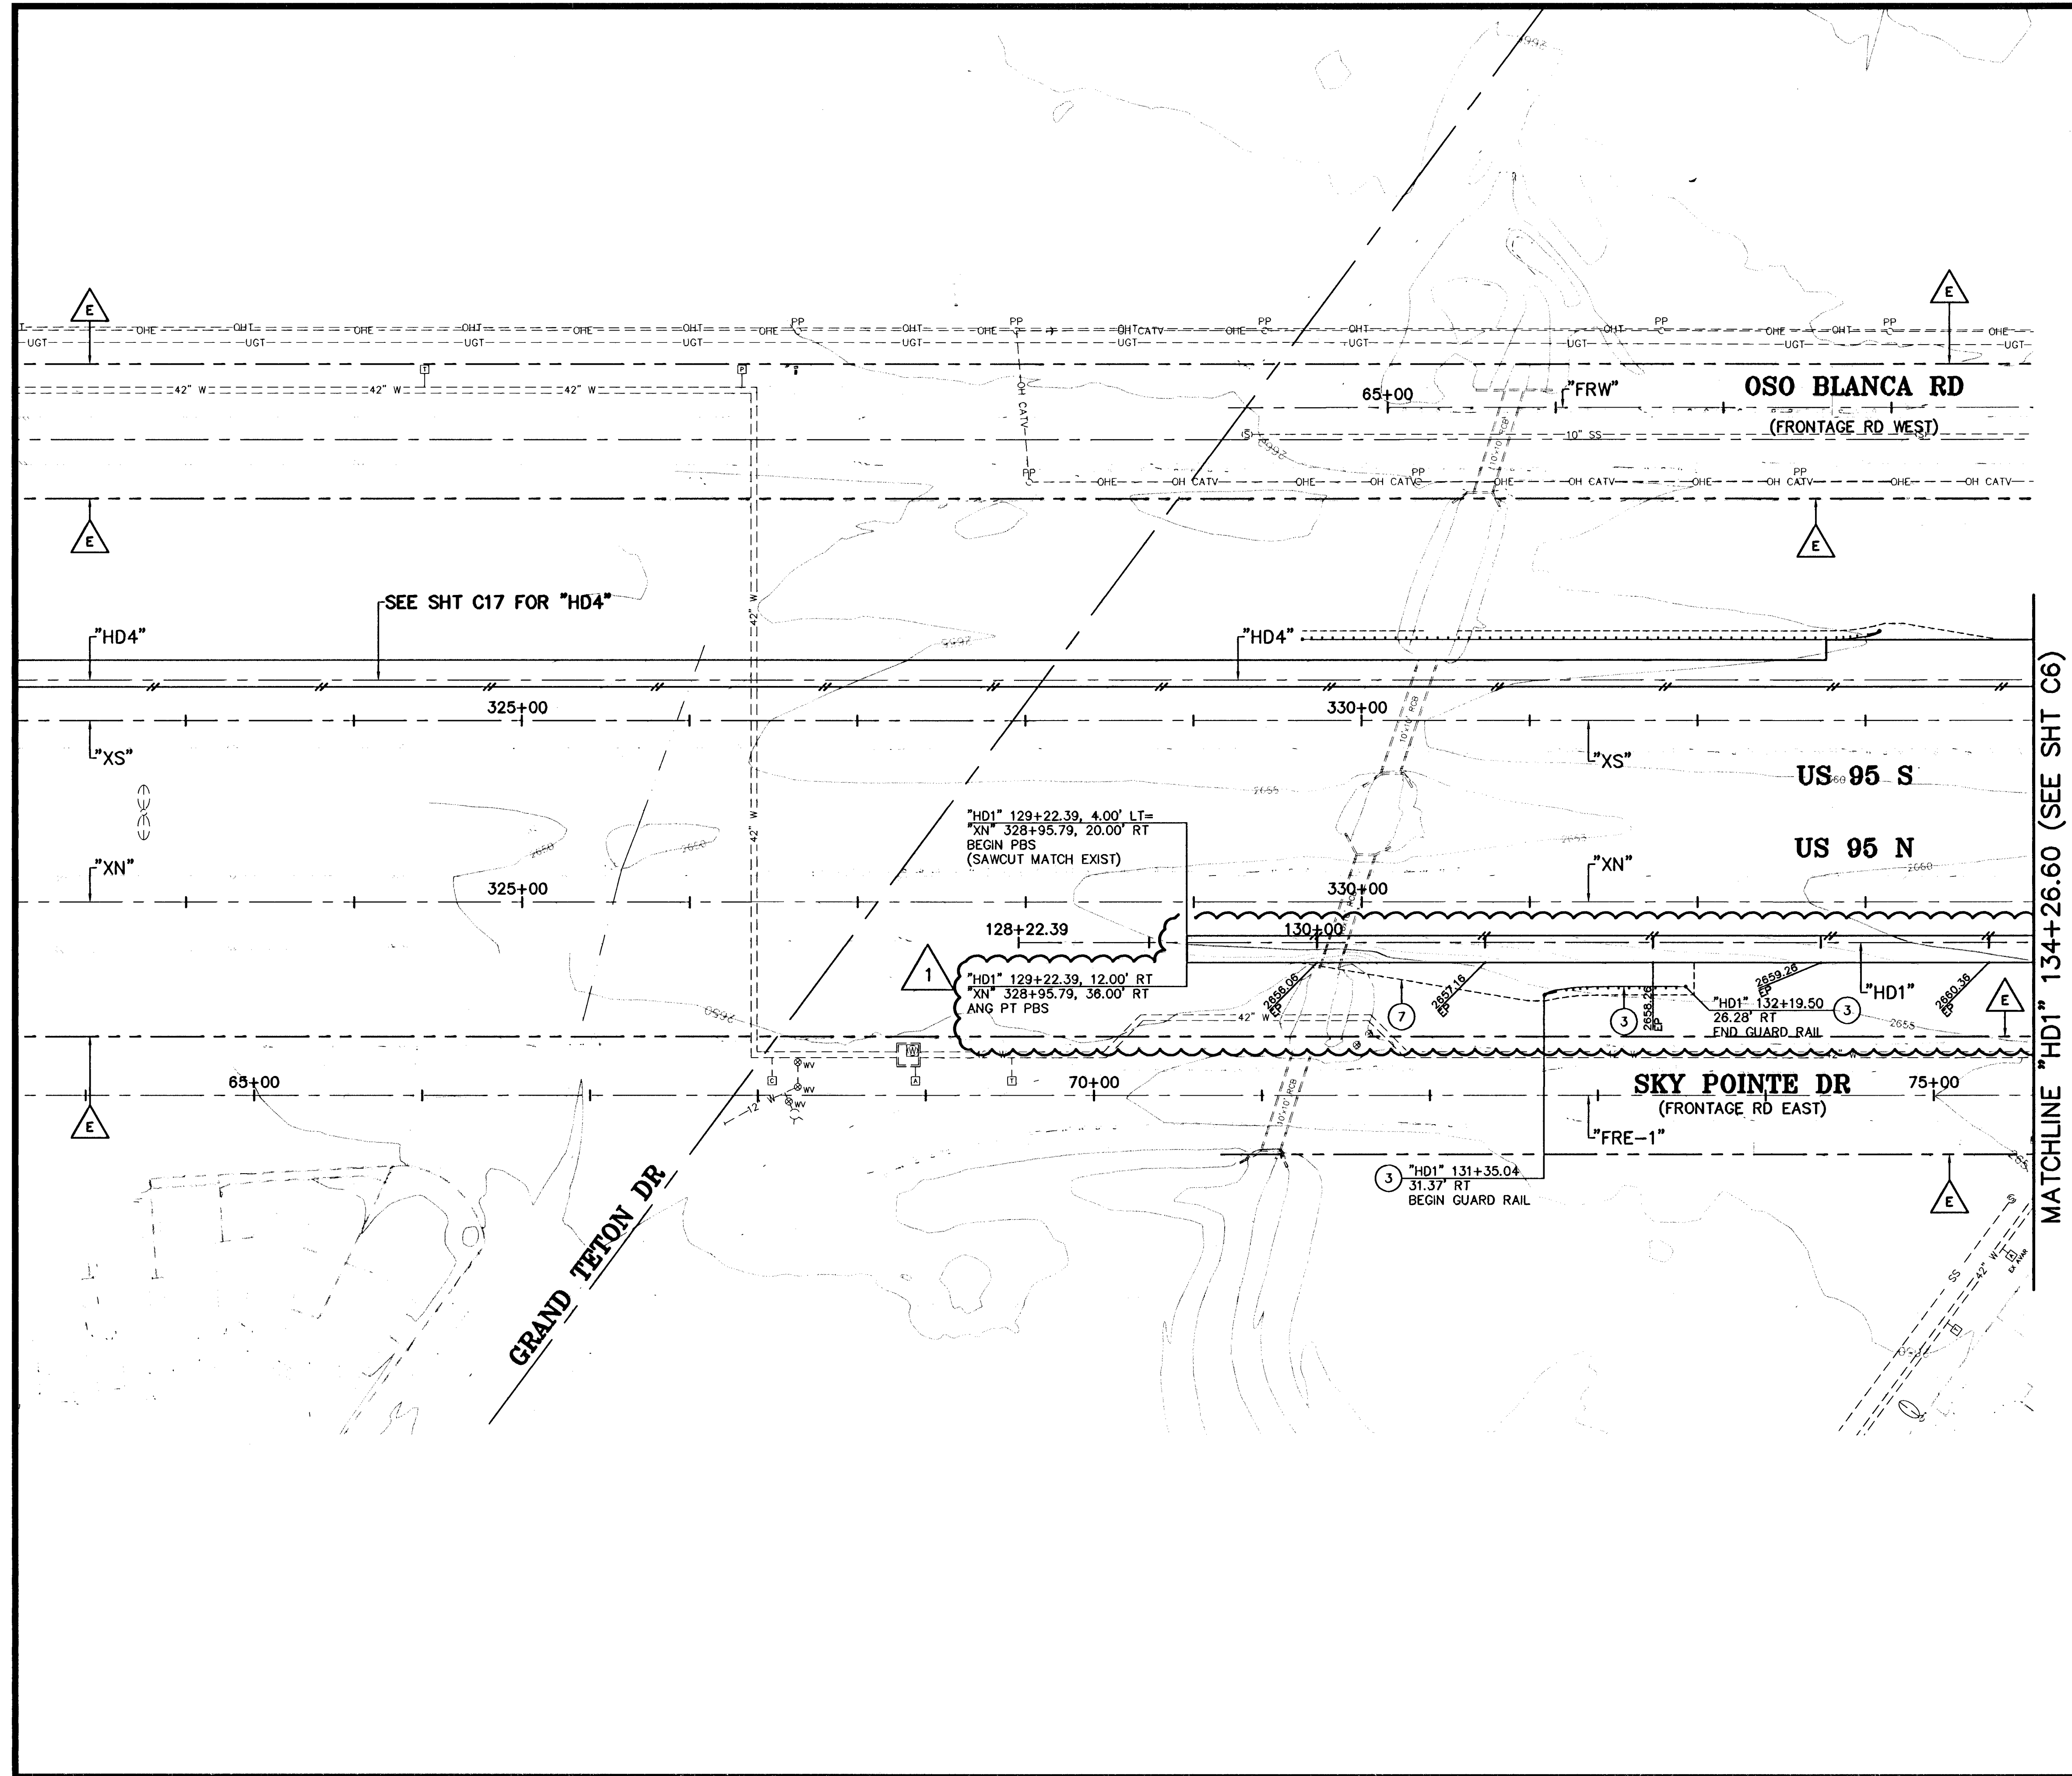

|  |                     |  |                            |
|--|---------------------|--|----------------------------|
| <b>PUBLIC WORKS DEPARTMENT</b>                             |                     | <b>CITY OF LAS VEGAS, NV</b>   |                            |
| 400 E. STEWART AVE.<br>LAS VEGAS, NV 89101<br>702-259-8272 |                     | 2727 SOUTH RAMPAGE BOULEVARD LAS VEGAS, NEVADA 89146-5146<br>PH: (702) 873-7559 FAX: (702) 362-2587  |                            |
| <b>ROADWAY PLAN</b>  |                     | <b>HORSE DRIVE / US 95 INTERCHANGE</b>   |                            |
| <b>"HDT" 128+22.39 TO "HDT" 134+26.60</b>                  |                     | <b>"HDT" 134+26.60 (SEE SHT C6)</b>  |                            |
| DRAWN BY:<br>DRF   | DESIGNED BY:<br>JAW | CHECKED BY:<br>JOC   | PROJECT NO.:<br>S500       |
| 06/20/2008   | 06/20/2008          | 06/20/2008   | SCALE: 1"=50'<br>VERT. N/A |
|  |                     | <b>Call before you Dig</b><br>Avoid cutting underground utility lines. It's costly.<br><b>Call 811</b><br>OR<br>1-800-227-2600<br>NEVADA POWER ENVIRONMENT AND SAFETY SERVICES DEPARTMENT<br>CLARK COUNTY TRAFFIC OPERATIONS<br>1-702-455-7544 |                            |
| SHEET<br><b>C5R</b>  |                     | DRAWING NO.<br><b>107V3759</b>   |                            |

115040