


LEGEND:

- DENOTES PBS (PLANTMIX BITUMINOUS SURFACE) SEE TYP CROSS SECTIONS
- DENOTES SAWCUT LINE FOR PBS (PLANTMIX BITUMINOUS SURFACE)
- "HD2" DENOTES NEW CL HORSE DR/FT APACHE RD RAMP 2
- EXIST NDOT RIGHT-OF-WAY

NOTE:
 FOR STORM DRAIN REMOVAL,
 PROTECT IN PLACE & GRADING
 INFORMATION SEE SHEET SD1
 THRU SD43

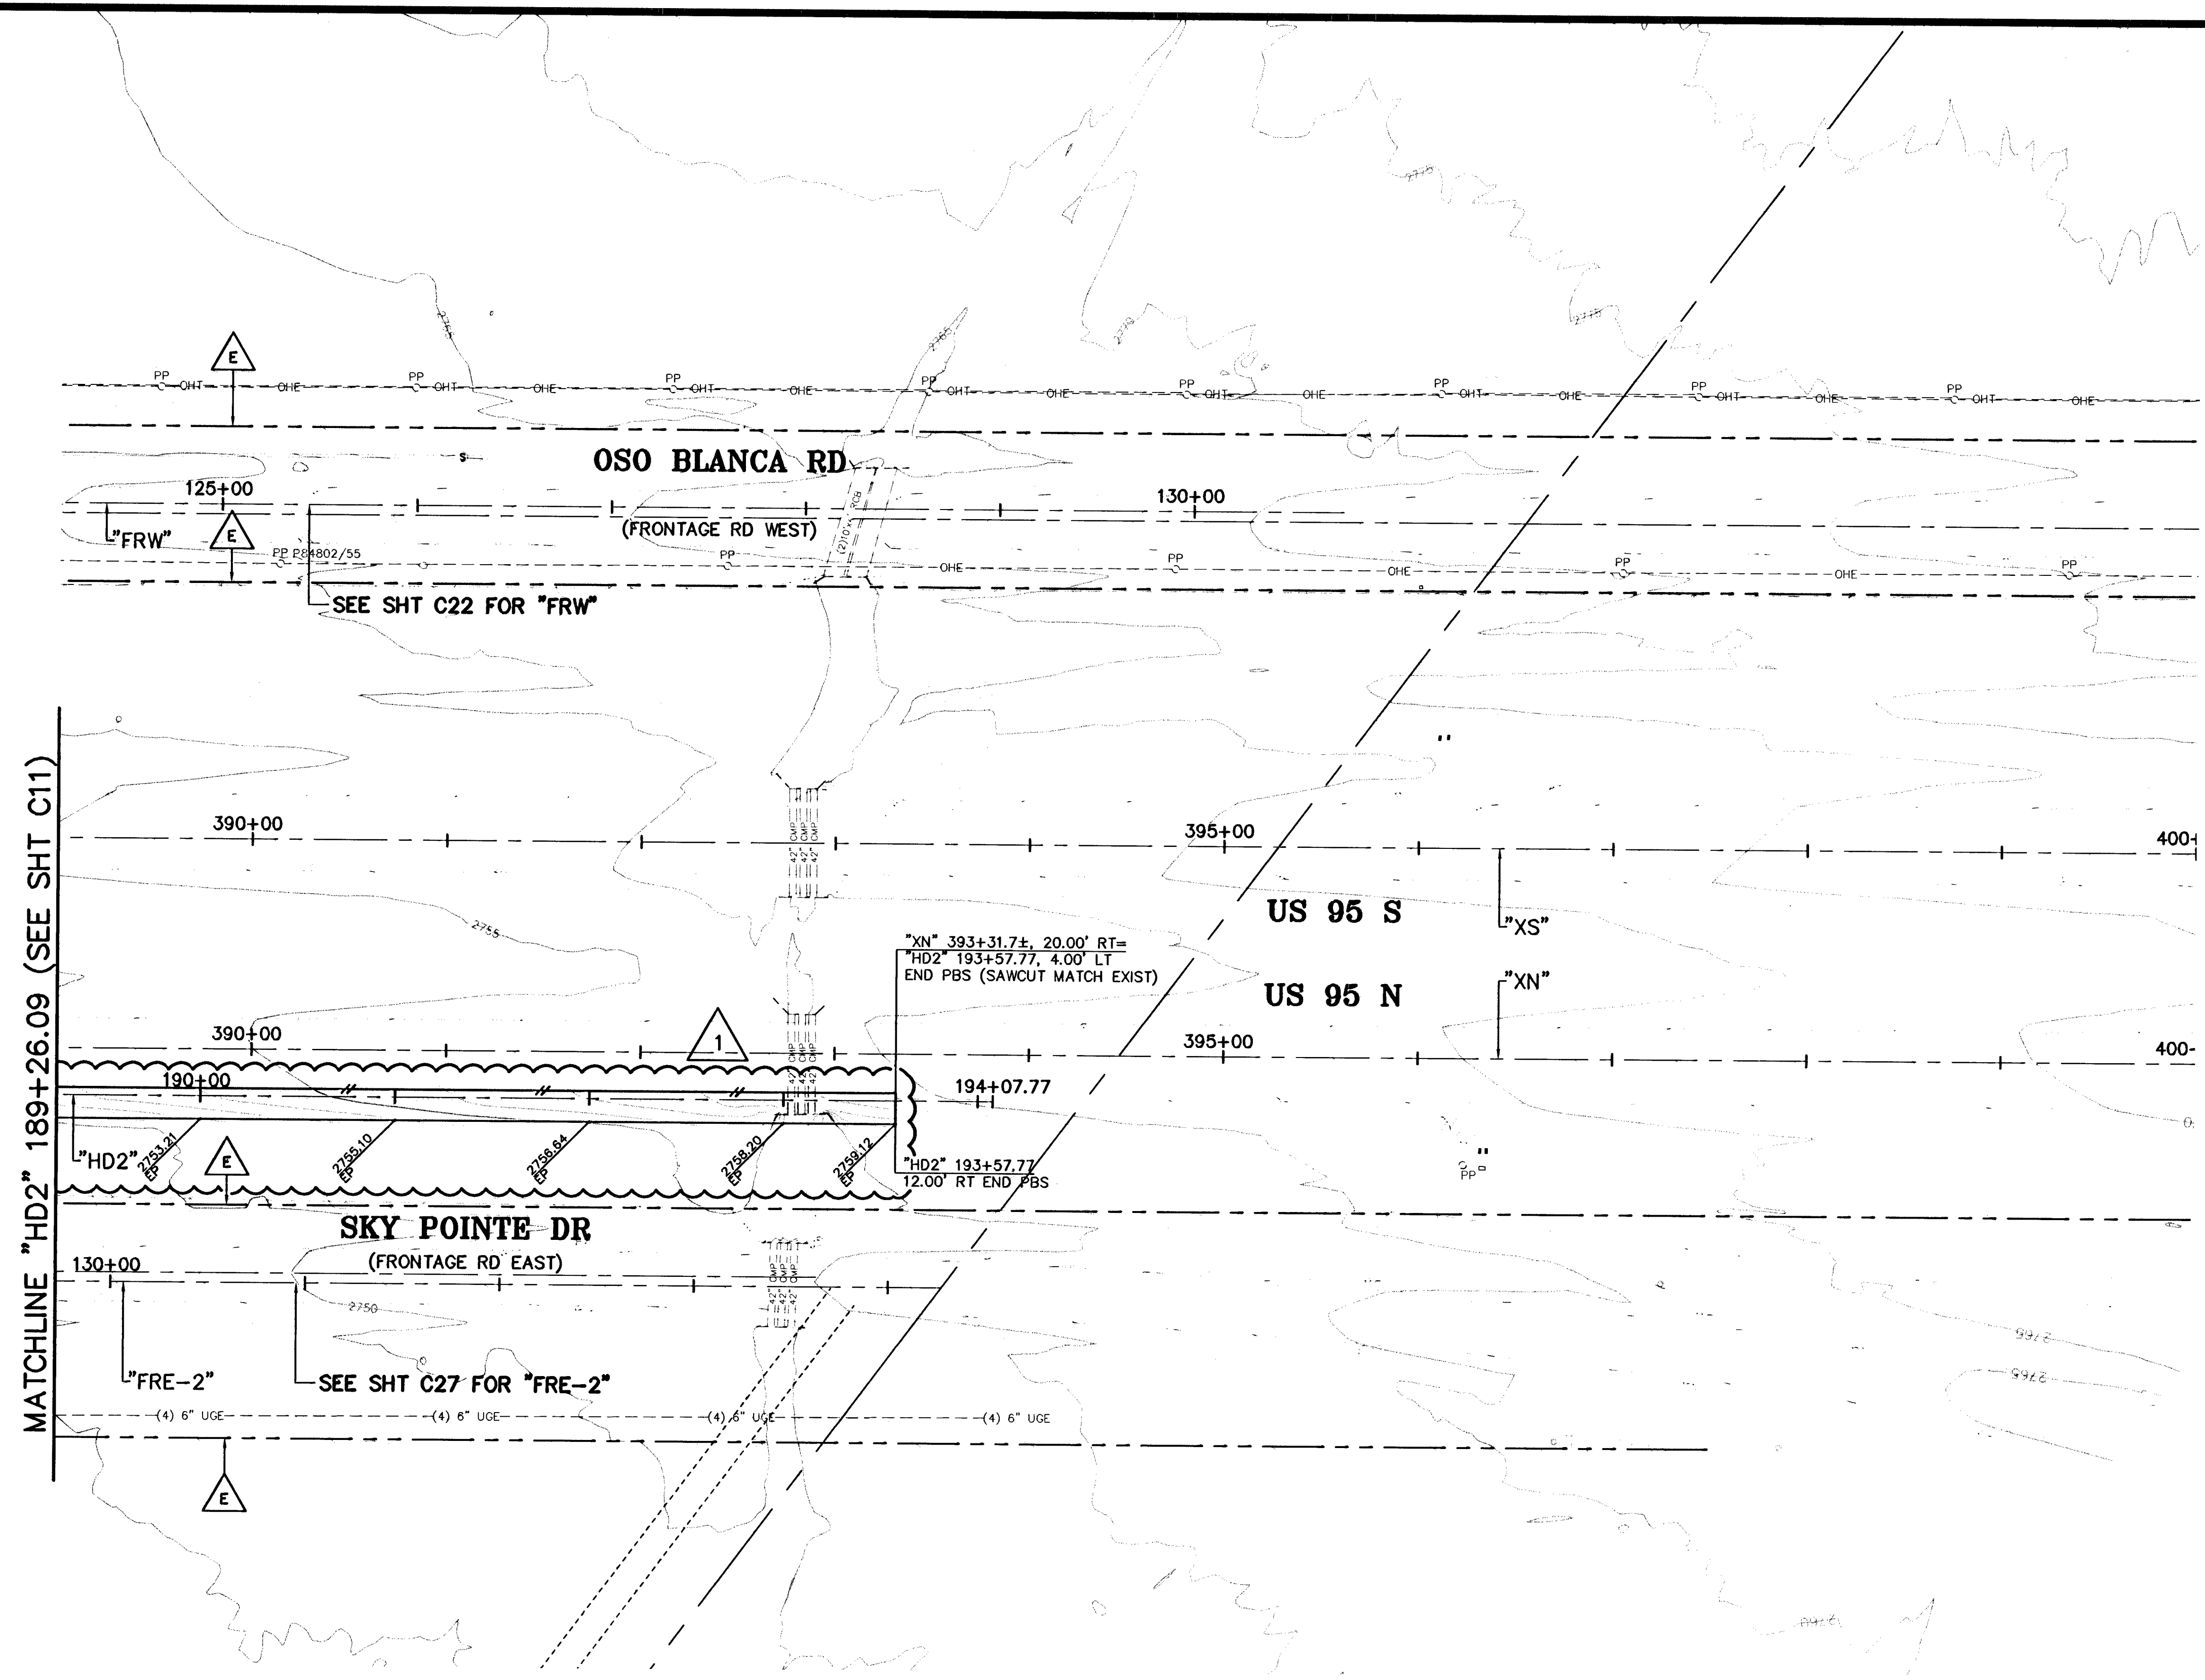

MATCHLINE "HD2" 189+26.09 (SEE SHT C11)

PUBLIC WORKS DEPARTMENT		CITY OF LAS VEGAS, NV	
ROADWAY PLAN		HORSE DRIVE / US 95 INTERCHANGE	
"HD2" 189+26.09 TO "HD2" 193+57.77			
DRAWN BY:	06/20/2008	CHECKED BY:	06/20/2008
DESIGNED BY:	LJM	PROJECT NO.:	6500
		SCALE:	1"=50' N/A
SHEET C12R		OF SHEETS	
DRAWING NO. 107V3769			

AVOID OVERHEAD POWER LINE CONTACT IT'S COSTLY

Call before you Overhead

1-702-227-2929

NEVADA POWER ENVIRONMENT AND SAFETY SERVICES DEPARTMENT

Call before you Dig

Avoid cutting underground utility lines. It's costly.

Call 811

1-800-227-2600

OR

702-455-7544

115045

1: V6000 (MVA) DESIGN (6500-D-RAMPS.dwg)