


LEGEND:

- DENOTES PBS (PLANTMIX BITUMINOUS SURFACE) SEE TYP CROSS SECTIONS
- DENOTES SAWCUT LINE FOR PBS (PLANTMIX BITUMINOUS SURFACE)
- "HD4" DENOTES NEW CL HORSE DR/FT APACHE RD RAMP 4
- EXIST NDOT RIGHT-OF-WAY

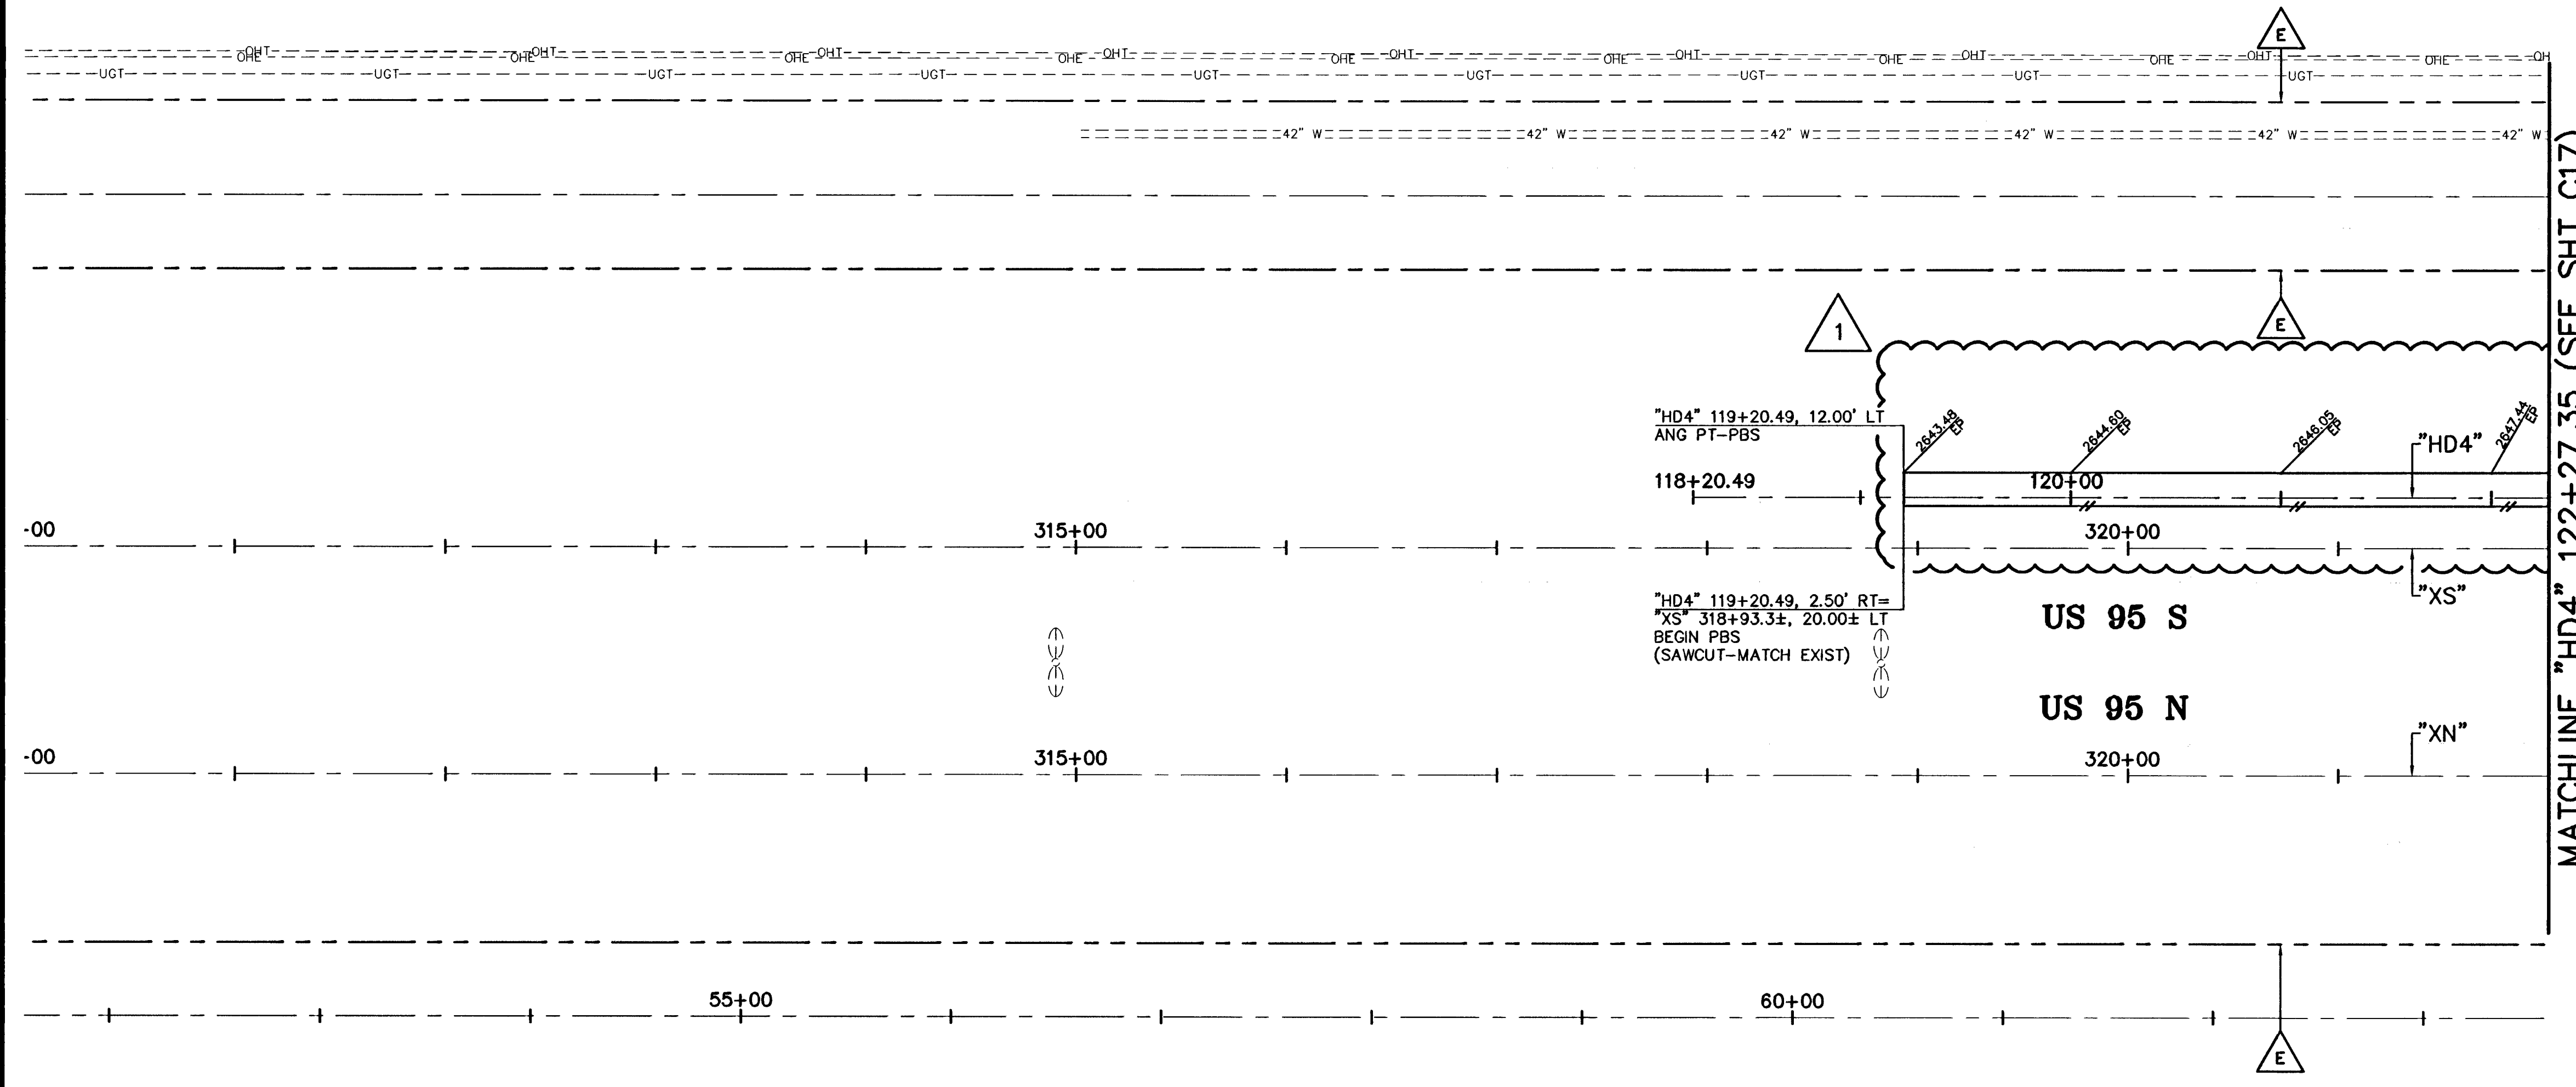

REV	DATE	BY	APP
1	11/2/2008	DRF	PER ADDENDUM No. 2


PUBLIC WORKS DEPARTMENT
 CITY OF LAS VEGAS, NV
 400 E STEWART AVE
 LAS VEGAS, NV 89101
 702-229-8272

VTM
 nevada CONSULTING ENGINEERS & PLANNERS • LAND SURVEYORS
 277 SOUTH RAINBOW BOULEVARD LAS VEGAS, NEVADA 89146-5146
 PH. (702) 877-7555 FAX (702) 262-2587

ROADWAY PLAN
 "HD4" 119+20.49± TO "HD4" 122+27.35

HORSE DRIVE / US 95 INTERCHANGE

DRAWN BY: DRF	06/30/2008
DESIGNED BY: LAW	06/30/2008
CHECKED BY: KDC	06/30/2008
PROJECT NO: 6500	SCALE: 1"=50' HORIZ. N/A VERT.

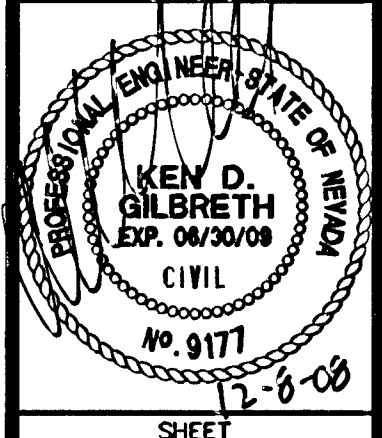

SHEET
C16R
 OF SHEETS

DRAWING NO.
107V3769

AVOID OVERHEAD POWER LINE CONTACT IT'S COSTLY

Call before you Dig
 Avoid cutting underground lines. It's costly.

Call 811

1-702-227-2929
 NEVADA POWER ENVIRONMENT AND SAFETY SERVICES DEPARTMENT

1-800-227-2800
 OR
 CLARK COUNTY 911 OPERATIONS
 1-702-251-7544
 1-702-455-7544

115047

© 2008 UMG DESIGN 6500-D-RAMP5.dwg