


58957

ORIGINAL SURVEY  
SURVEY  
NOTE BOOK  
AREAS CHECK

FINAL SURVEY  
SURVEY  
NOTE BOOK  
AREAS CHECK

DATE  
BY

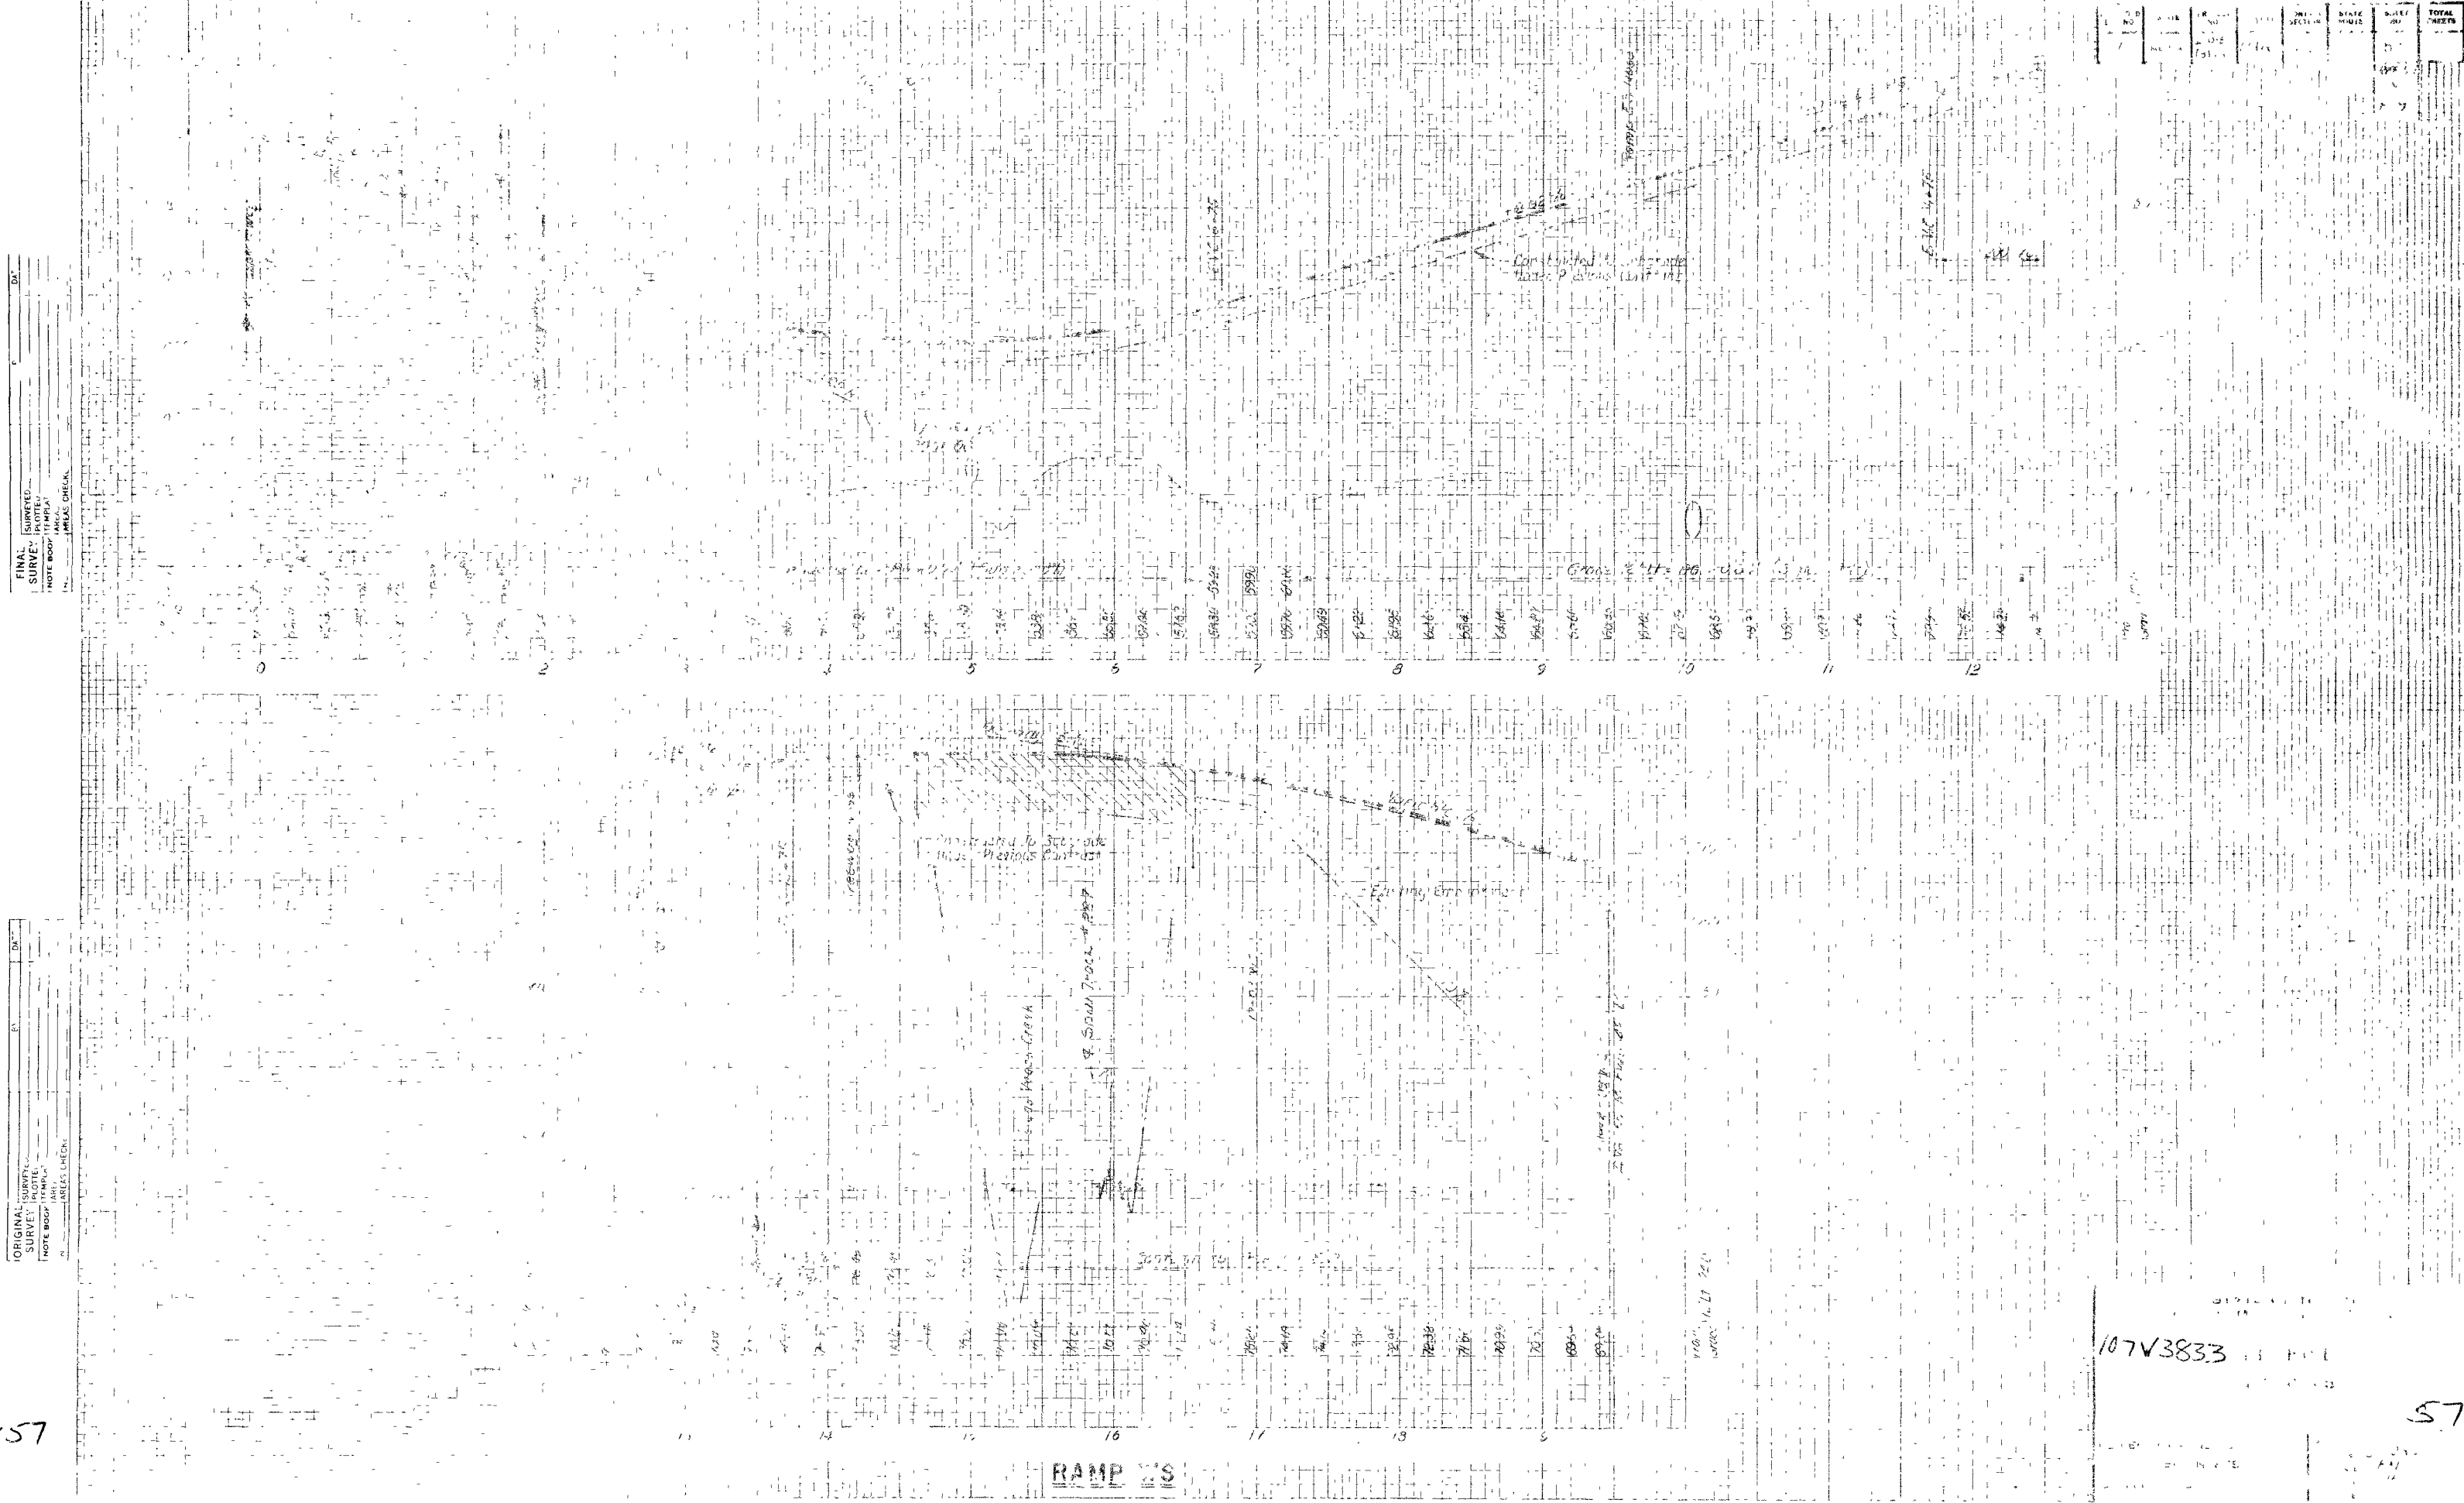

107V3833

57