



MONUMENTATION TIE MAP FOR
FOX FIRE RANCH UNIT 5

SURVEYOR'S CERTIFICATE

I, J. EDWARD LEAVITT, A PROFESSIONAL LAND SURVEYOR IN THE STATE OF NEVADA,
DO HEREBY CERTIFY THAT THE MONUMENTS HAVE BEEN SET AND THE TIE DISTANCES
WERE ESTABLISHED AS SHOWN HEREON.


THIS SURVEY WAS COMPLETED ON SEPTEMBER 17, 1998

J. EDWARD LEAVITT, PLS 5878

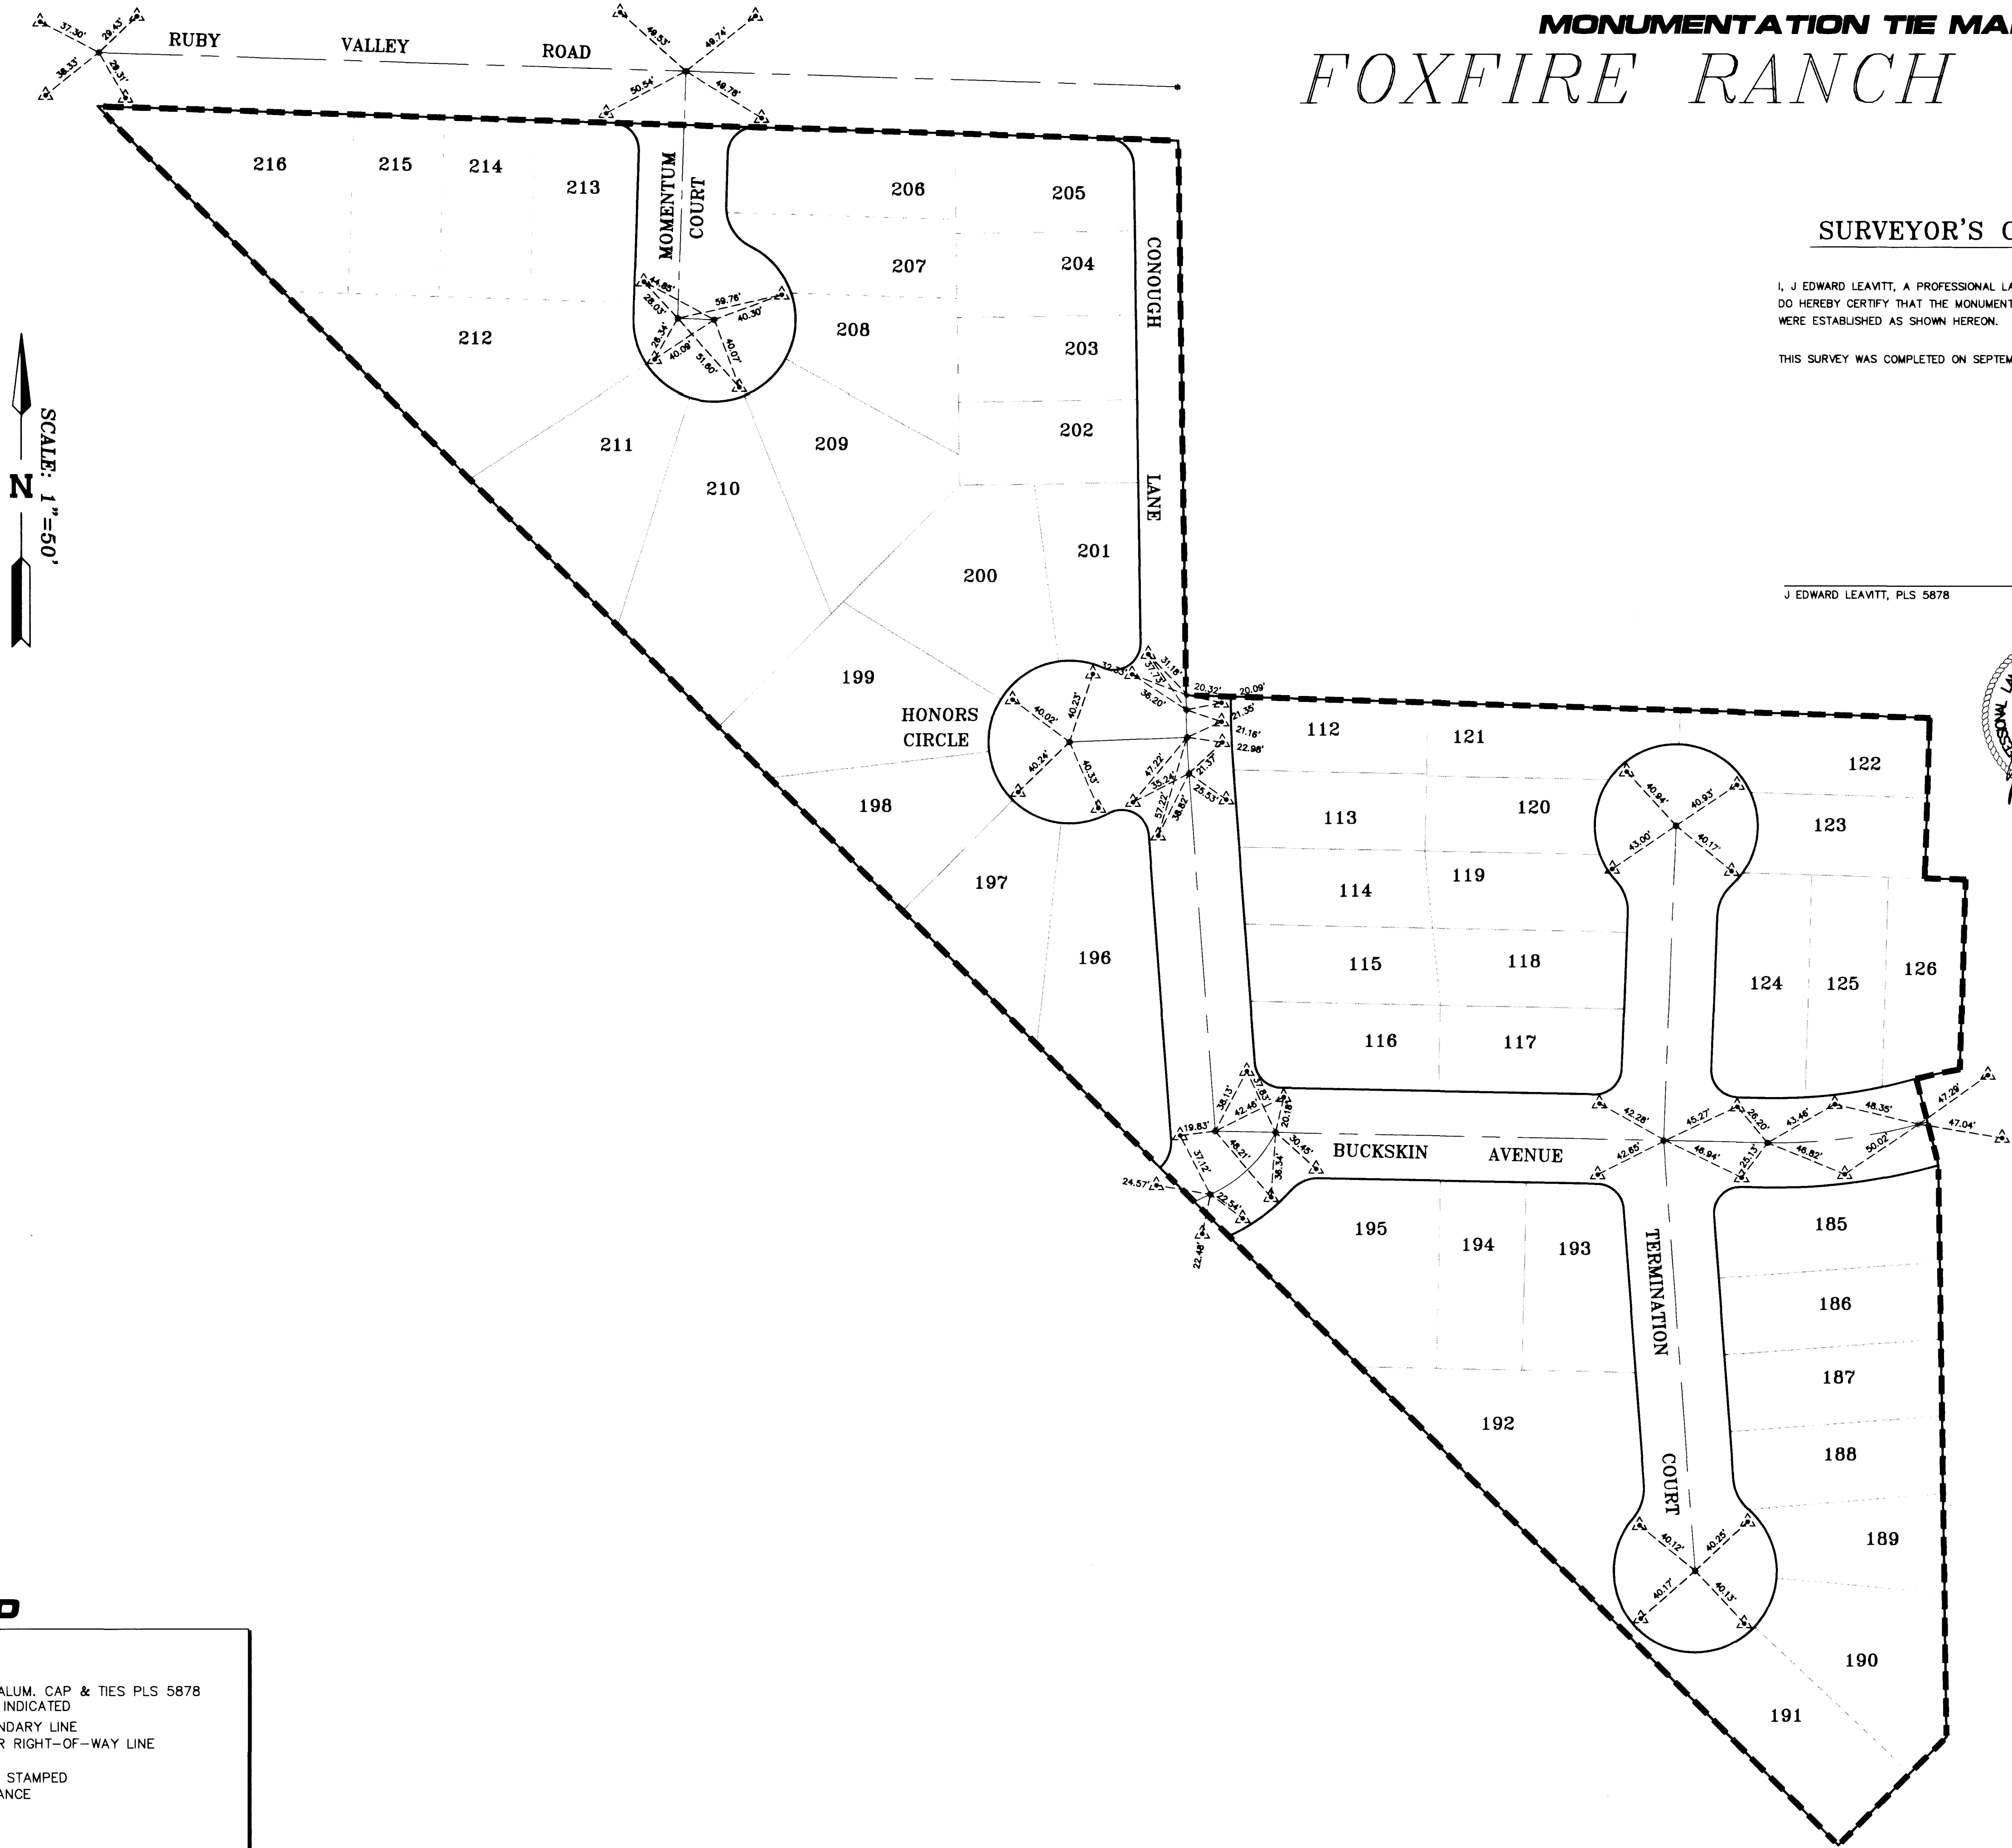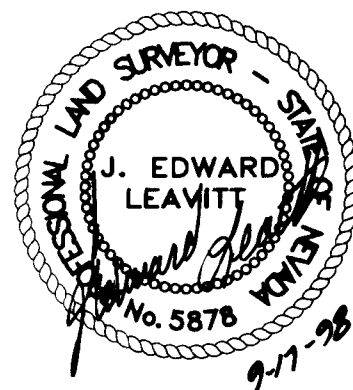

SCALE: 1"=50'
N

LEGEND

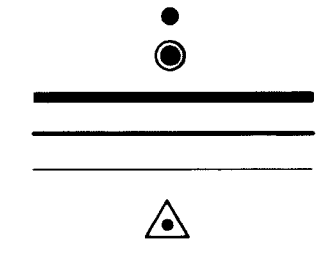

SET 5/8" REBAR W/ ALUM. CAP & TIES PLS 5878
FOUND MONUMENT AS INDICATED
OVERALL PARCEL BOUNDARY LINE
INTERIOR PROPERTY OR RIGHT-OF-WAY LINE
STREET CENTERLINE
REFERENCE MONUMENT STAMPED
"PLS 5878" WITH DISTANCE

SHEET		9/17/98	
DRAWN BY:		SMD	
DESIGNED BY:			
CHECKED BY:			
PROJECT NO:		507621	
SCALE:		1"=50'	
SHEET		1	
OF 1 SHEETS			
DRAWING NO.		058-4288-5	
PULTE HOMES CORP.		ENGINEERING COMPANY	
1635 VILLAGE CENTER CIR LAS VEGAS, NV 89107 (702)256-7900		50 So. Jones #202, Las Vegas, NV 89107 Telephone: (702) 877-1300	
MONUMENTATION TIE MAP		FOX FIRE RANCH UNIT 5	
TITLE		ALPHA &	