


SEAL STAMPED
BACK

TRAILWOOD DRIVE (PUBLIC)

WHEEL STREET DESIGNATED PKR
PER BOOK 59, PAGE 11 OF PLATS

EXISTING 22 FOOT WIDE
UTILITY EASEMENT GRANTED
PER BOOK 59, PAGE 11
OF PLATS

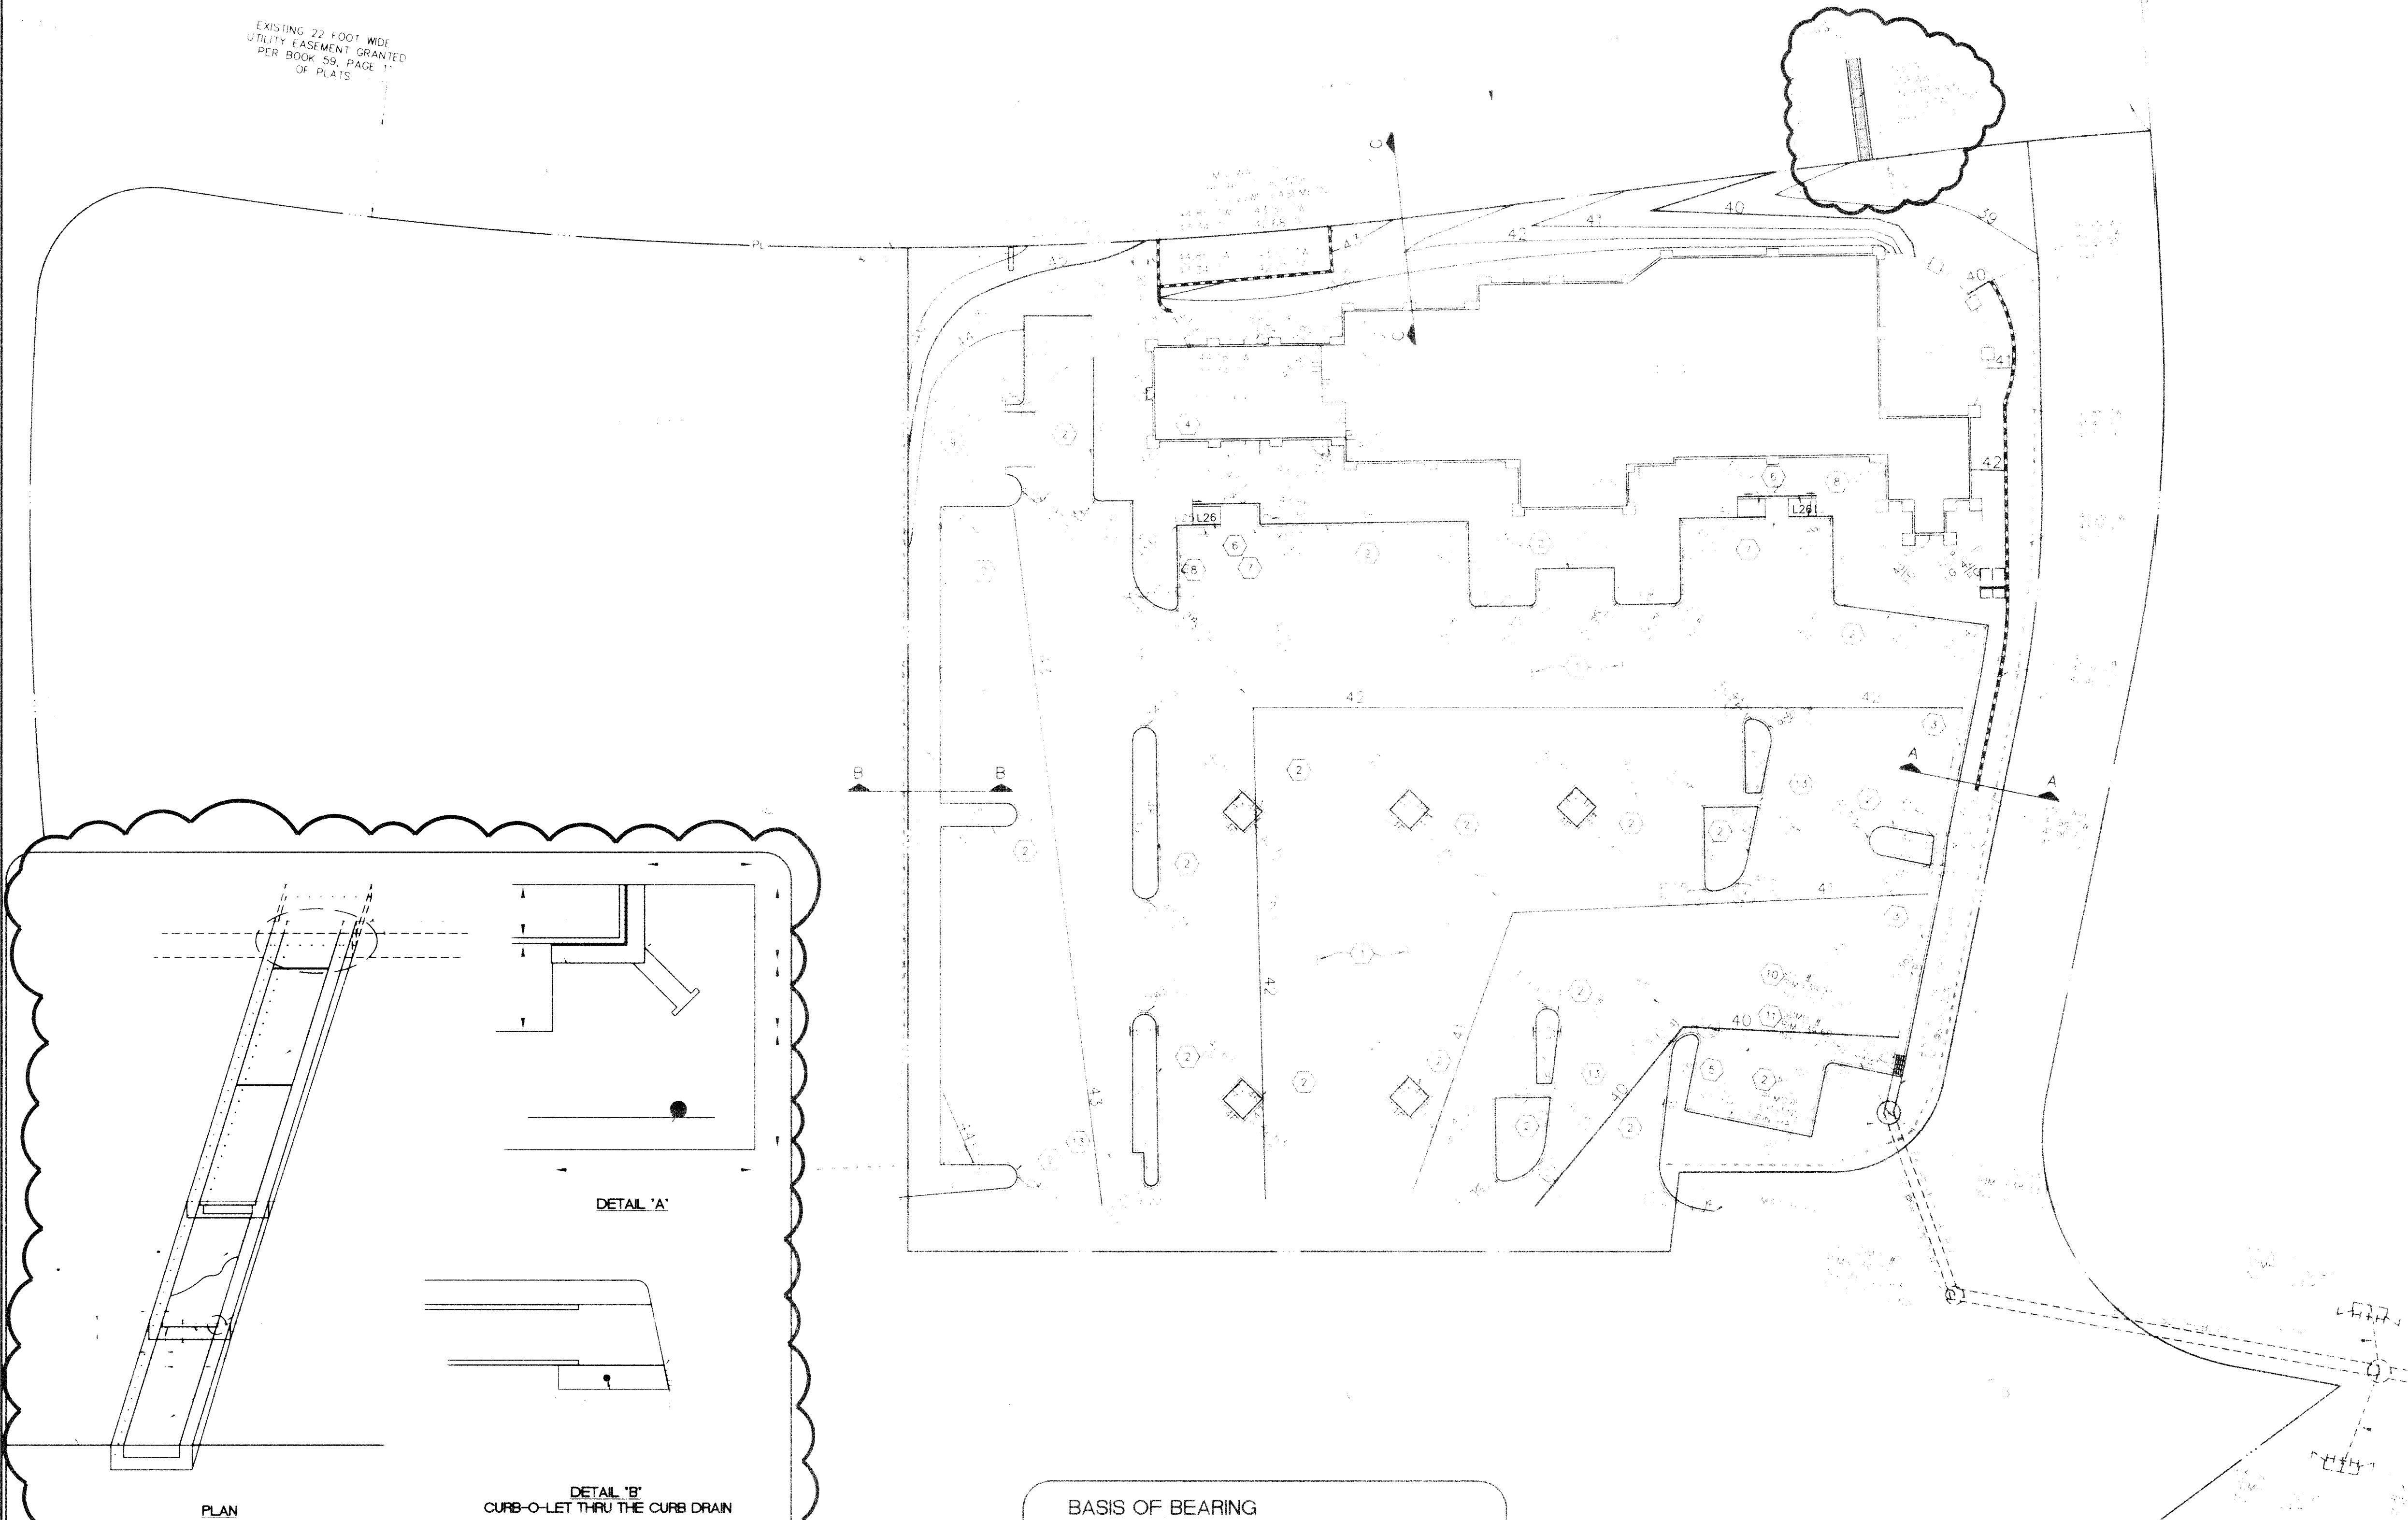


DETAIL "A"

DETAIL "B"
CURB-O-LET THRU THE CURB DRAIN

CONSTRUCTION NOTES

BASIS OF BEARING

BENCHMARK

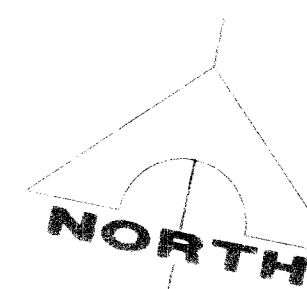

SCALE
20 40
FEET

Call
before you
Dig.
1-800-227-2600
UNDERGROUND SERVICE (USA)

CALL BEFORE
YOU DO
OVERHEAD
1-702-593-6111

DRAINAGE CERTIFICATION

TYPICAL PAVING SECTION

1

MODIFIED A" CURB

2

CONCRETE VALLEY GUTTER DETAIL

NOT TO SCALE

3

SECTION A-A

SECTION B-B

SECTION C-C


IHOP ON TRAILWOOD DRIVE

TONY KOUBA

GRADING PLAN/DETAIL SHEET

C-4

CLV DRAWING # 10719452

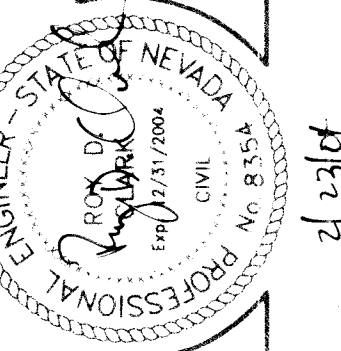

PROGRESS PRINT

G.C. WALLACE, INC.
Engineers Planners Surveyors
