


SURVEYOR'S CERTIFICATE

I, GERALD L. WIRTHLIN, A PROFESSIONAL LAND SURVEYOR IN THE STATE OF NEVADA, DO HEREBY CERTIFY THAT:

1. THIS PLAT REPRESENTS THE RESULTS OF A SURVEY CONDUCTED UNDER MY DIRECT SUPERVISION AT THE INSTANCE OF LAS VEGAS PAVING CORP.
2. THE LANDS SURVEYED LIE WITHIN THE NORTHEAST 1/4 OF SECTION 34, TOWNSHIP 20 SOUTH, RANGE 61 EAST, M.D.M., CITY OF LAS VEGAS, CLARK COUNTY, NEVADA
3. THIS PLAT COMPLIES WITH THE APPLICABLE STATE STATUTES AND ANY LOCAL ORDINANCES IN EFFECT ON THE DATE THAT THE GOVERNING BODY GAVE ITS FINAL APPROVAL.
4. THE MONUMENTS DEPICTED ON THE PLAT WILL BE OF THE CHARACTER SHOWN, OCCUPY THE POSITIONS INDICATED BY 07/20/2007
5. THIS SURVEY WAS COMPLETED ON 07/20/2007
6. CERTIFY THAT THE MONUMENTS HAVE BEEN SET AND THE TIE DISTANCES ESTABLISHED AS SHOWN HEREON

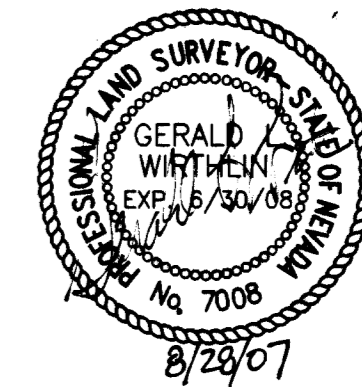



GERALD L. WIRTHLIN
PROFESSIONAL LAND SURVEYOR
NEVADA CERTIFICATE No. 7008

BASIS OF BEARINGS

THE BASIS OF BEARINGS FOR THIS SURVEY IS THE CENTERLINE OF FREMONT STREET AS SHOWN IN FILE 67, PAGE 79 OF RECORDED SURVEYS, OFFICIAL RECORDS, CLARK COUNTY, NEVADA.
SAID LINE BEARS S62°04'40"E.

LEGEND

- FND/SET MONUMENT AS INDICATED
- SET TYPE IV REFERENCE MONUMENT
- CURB LINE
- - - CENTERLINE
- BOUNDARY LINE
- TIE LINE

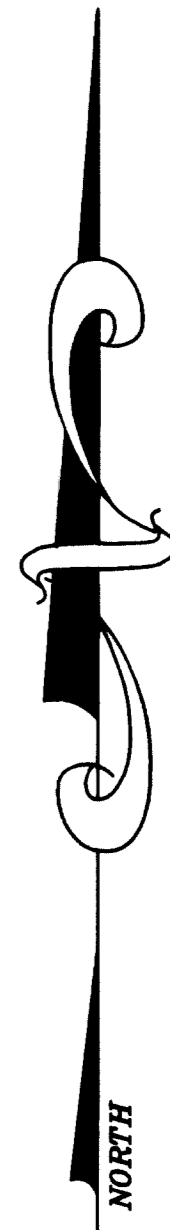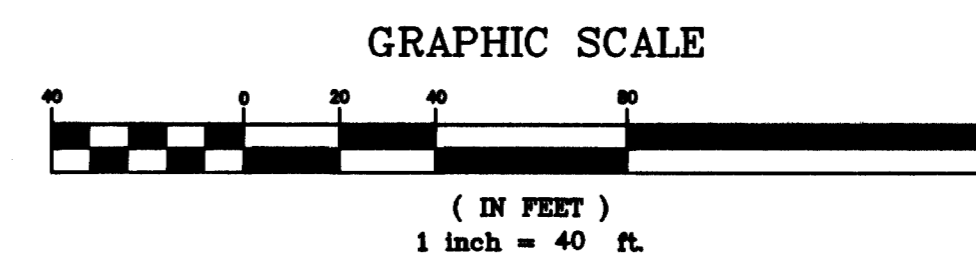

RECORDER'S NOTE

ANY SUBSEQUENT CHANGES TO THIS MAP SHOULD BE EXAMINED AND MAY BE DETERMINED BY REFERENCE TO THE COUNTY RECORDER'S CUMULATIVE MAP INDEX. N.R.S. 278.5695

107V4568

<p>RECORD OF SURVEY FREMONT STREET PEDESTRIAN IMPROVEMENTS A PORTION OF THE NORTHEAST 1/4 OF SECTION 34, TOWNSHIP 20 SOUTH, RANGE 61 EAST, M.D.M., CITY OF LAS VEGAS, CLARK COUNTY, NEVADA</p>		No. _____ FILED AT THE REQUEST OF: <p style="text-align: center;">LAS VEGAS PAVING CORP.</p> DATE: _____ AT _____ M. FILE: _____ PAGE: _____ OF SURVEYS OFFICIAL RECORDS BOOK No. _____
<p>LAS VEGAS PAVING CORPORATION</p>		CLARK COUNTY, NEVADA RECORDS DEBBIE CONWAY, RECORDER FEEL: _____ DEPUTY: _____
<p>LAS VEGAS PAVING CORP. GERALD "CROCKETT" WIRTHLIN PLS #7008</p>		<p style="text-align: right;">649-0009 OFFICE 379-9362 MOBILE</p> <p style="text-align: right;">107V4568-1-Tie</p>