



date: 08/15/05
 job #: 1064.00
 design by: D. MALPASS, P.E.
 drawn by: B. BORJA


GREATER LAS VEGAS REALTORS ASSOCIATION
 CIVIL IMPROVEMENT PLANS
 DETAIL SHEET

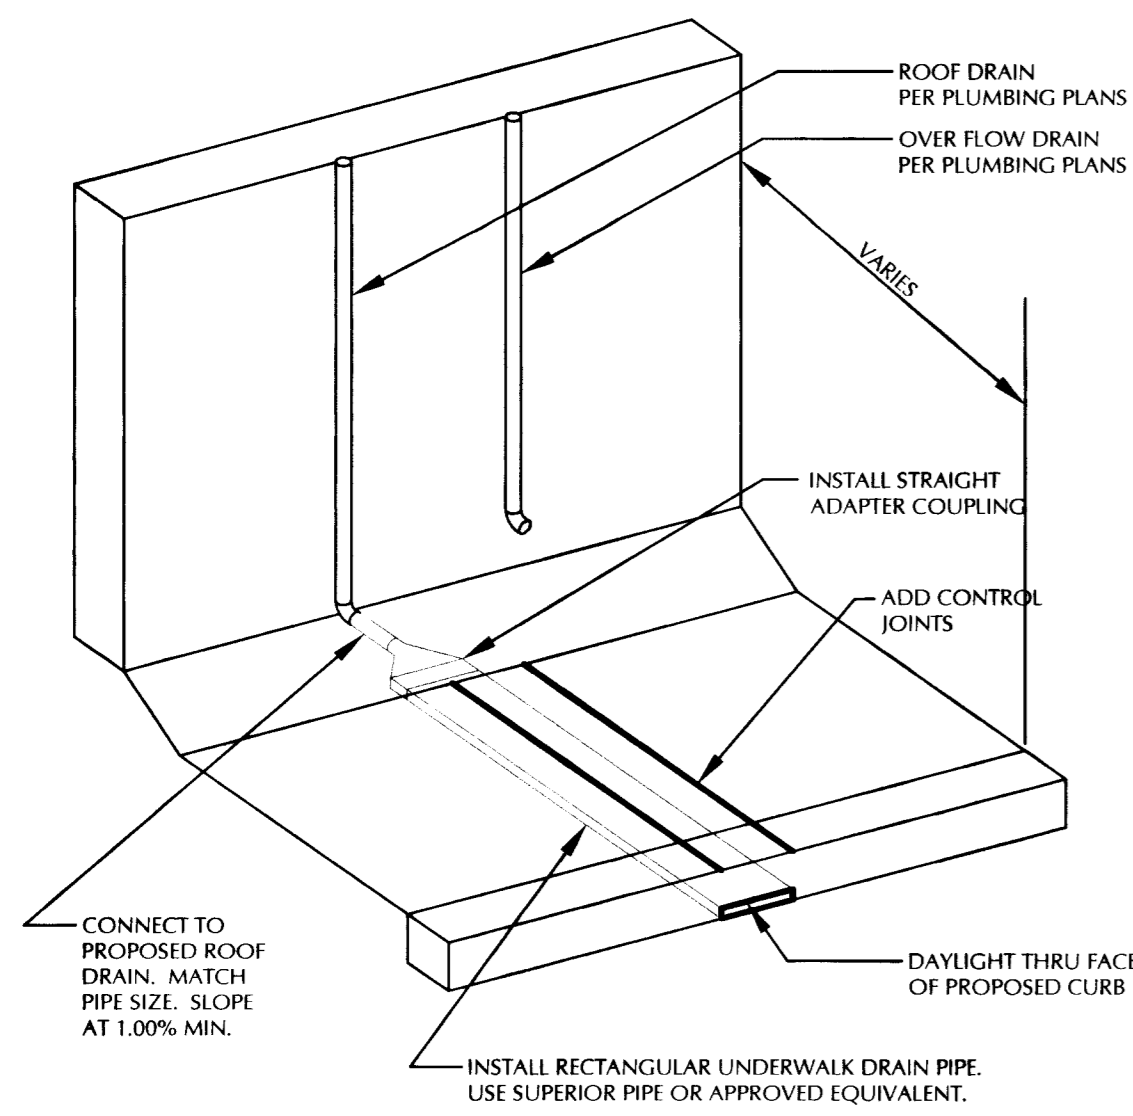


1
C8.01
 ROOF DRAIN
 NOT TO SCALE

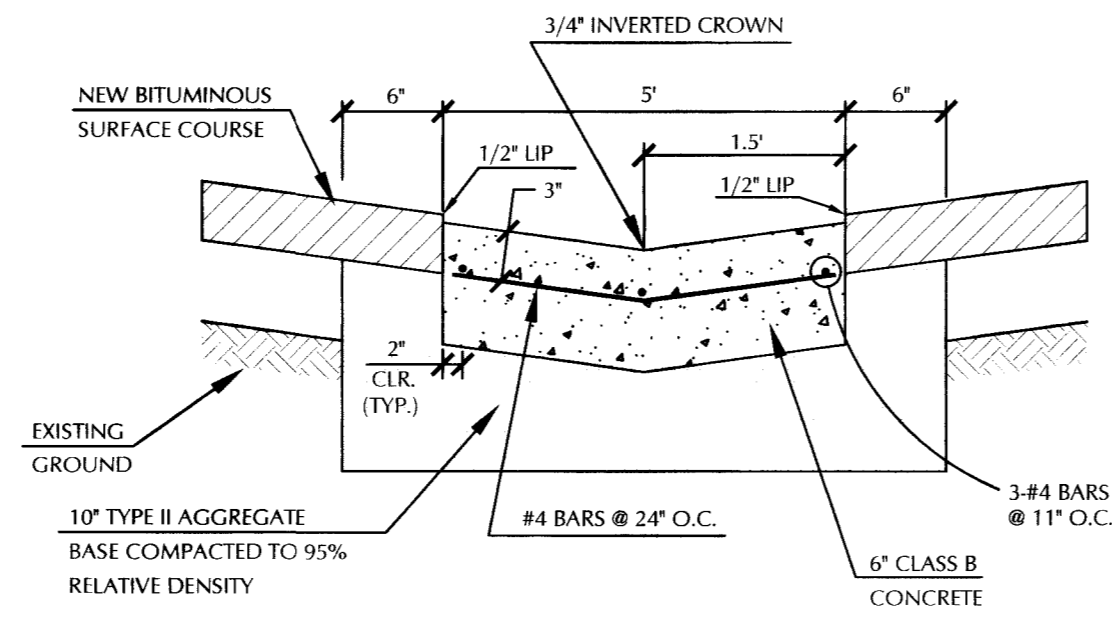


2
C8.01
 5' VALLEY GUTTER
 NOT TO SCALE

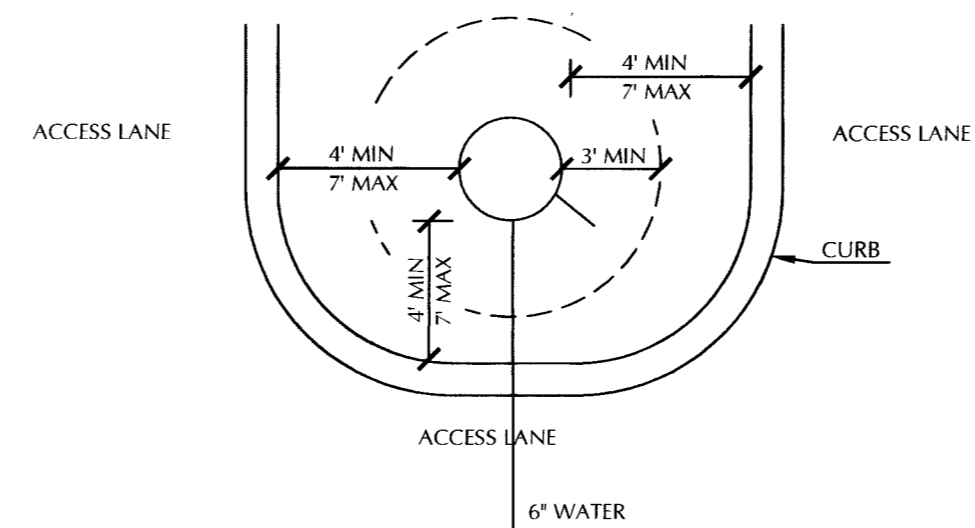


3
C8.01
 FIRE HYDRANT DETAIL
 NOT TO SCALE

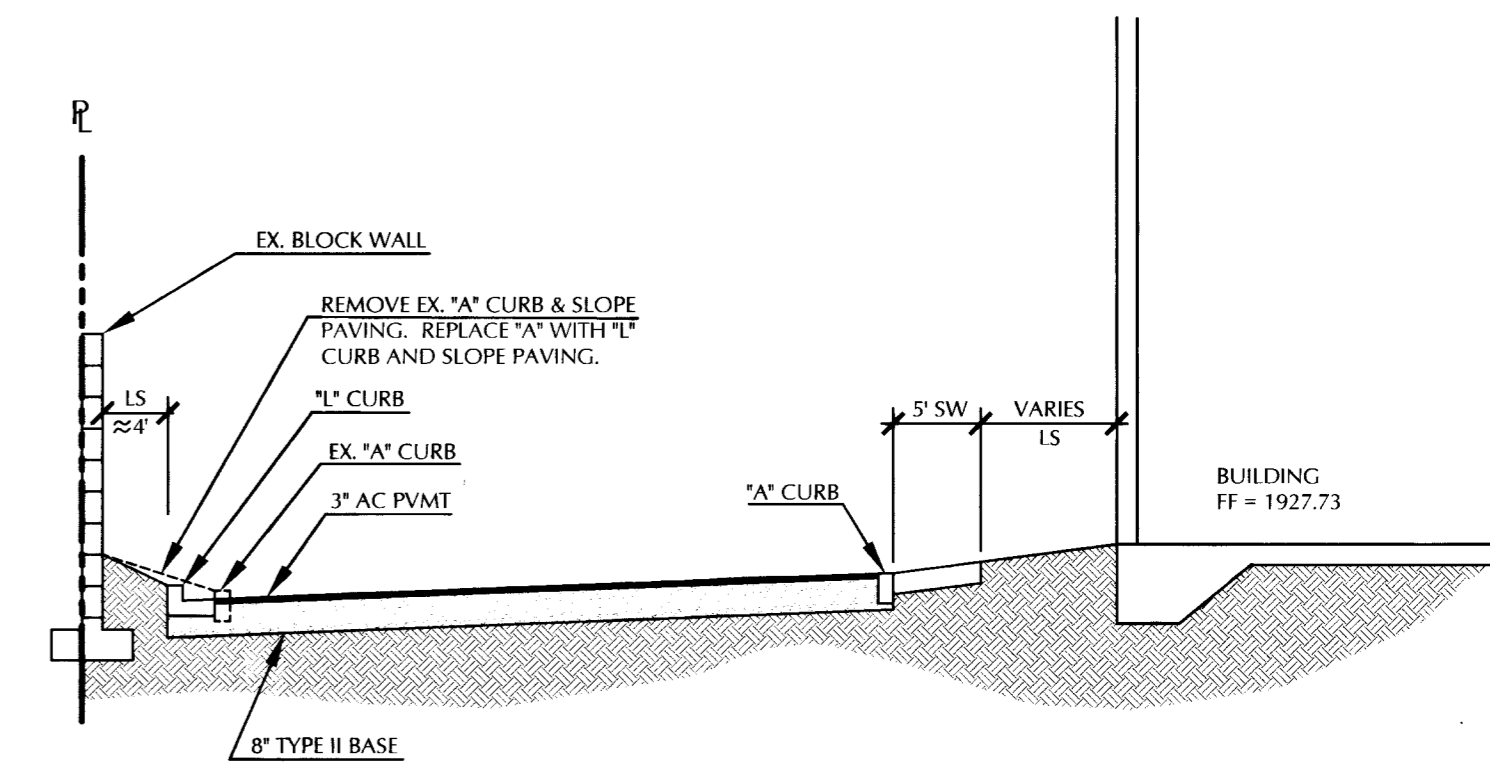


4
C8.01
 WEST SECTION
 NOT TO SCALE

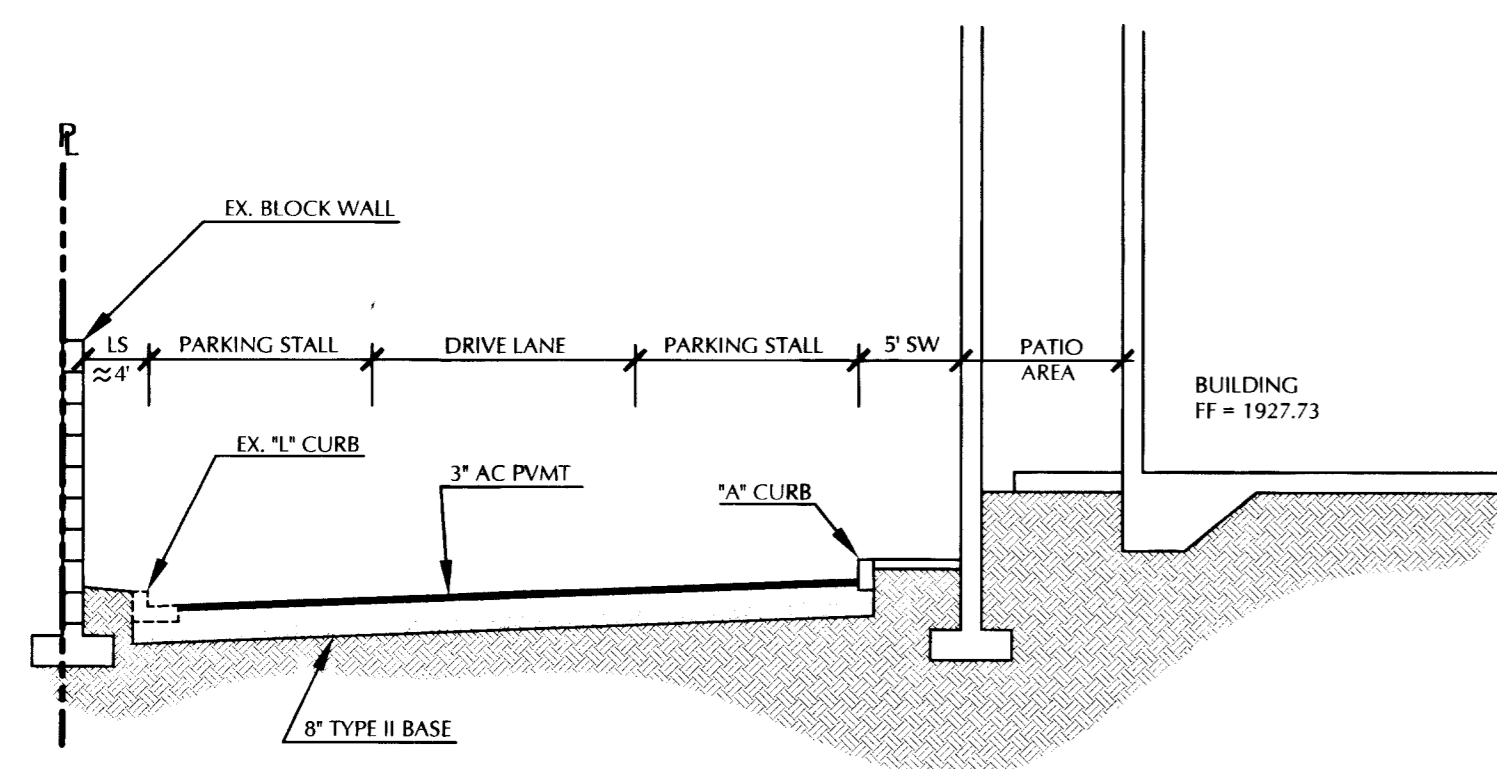


5
C8.01
 NORTH SECTION
 NOT TO SCALE

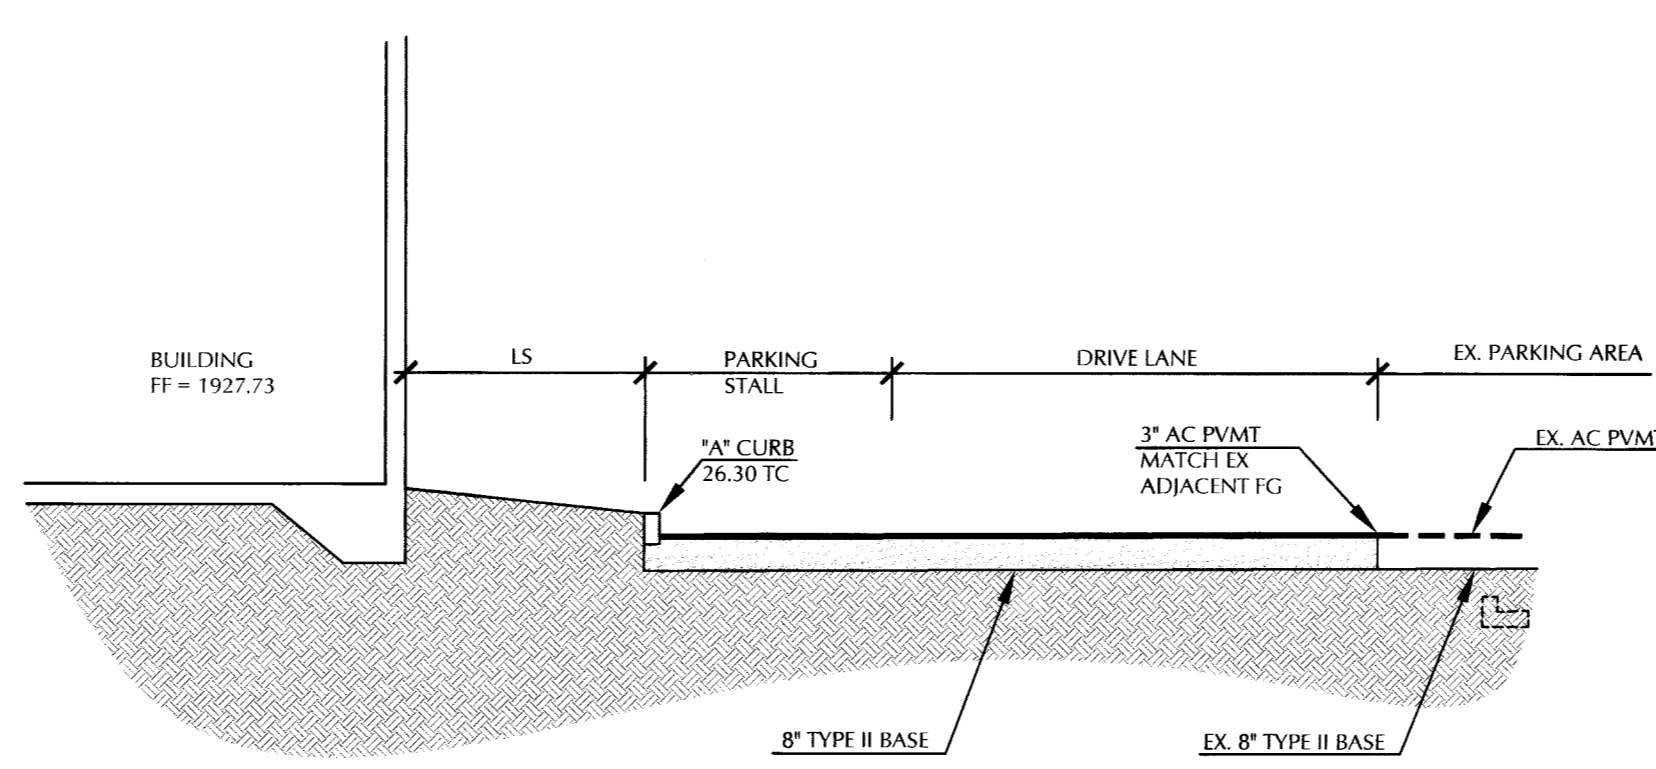


6
C8.01
 SOUTH SECTION
 NOT TO SCALE

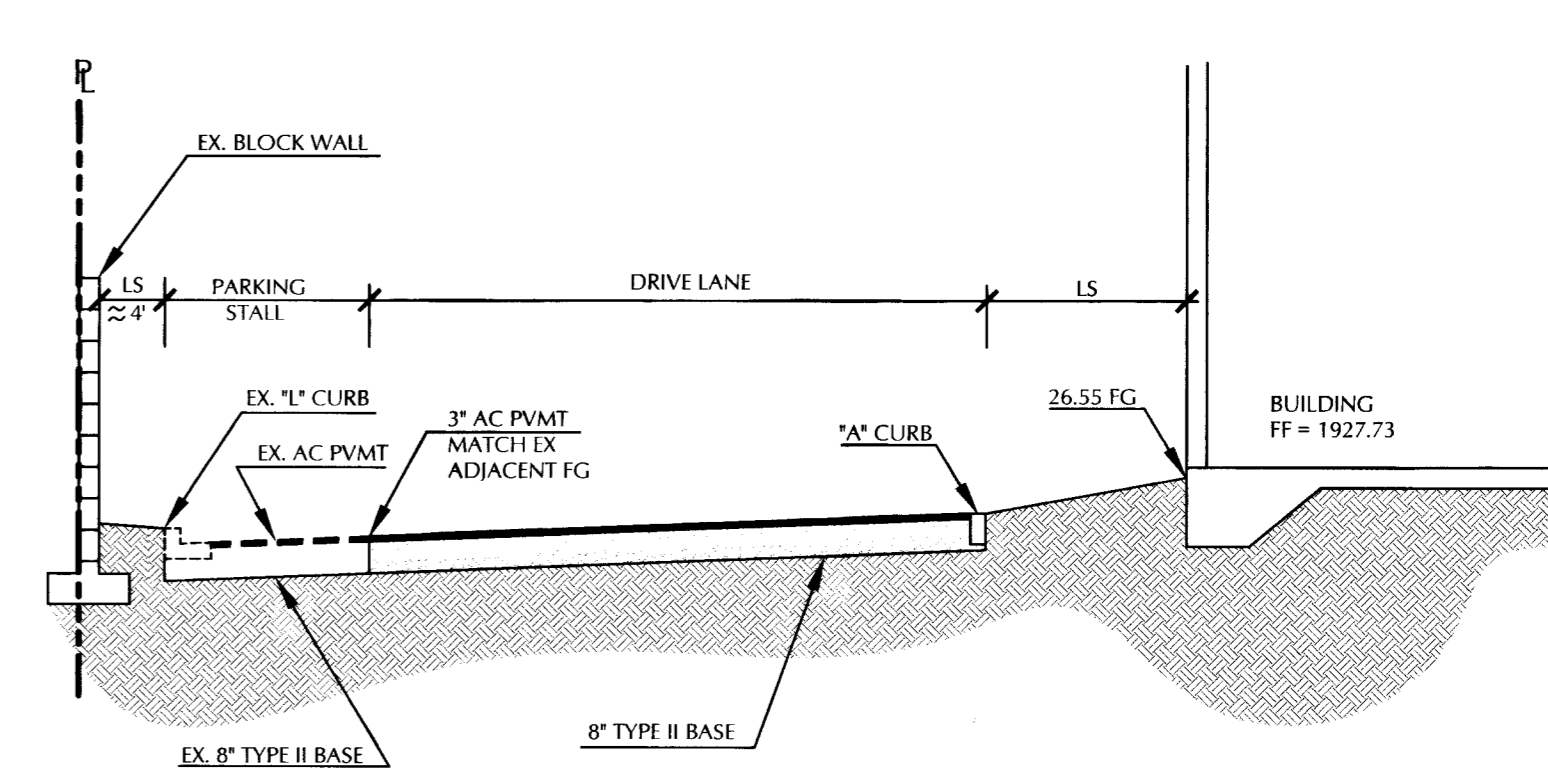


7
C8.01
 EAST SECTION
 NOT TO SCALE

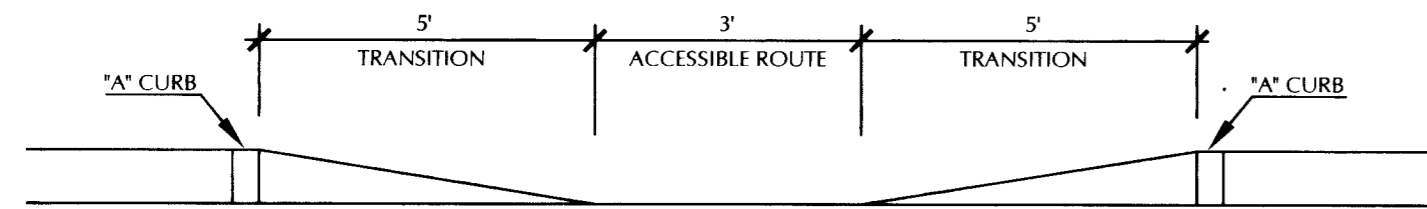

8
C8.01
 CURB TRANSITION DETAIL
 NOT TO SCALE

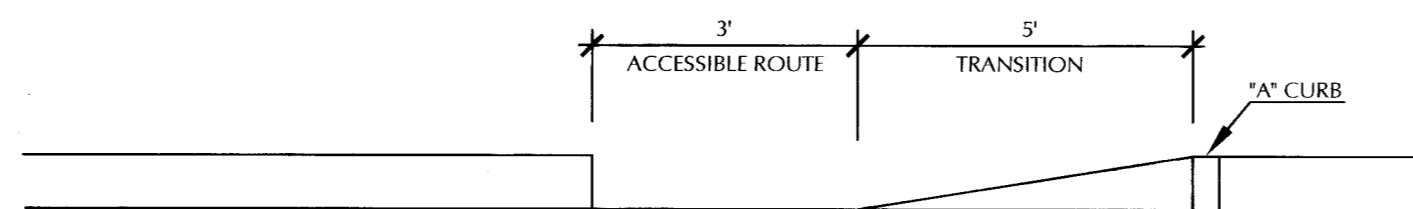

9
C8.01
 CURB TRANSITION DETAIL
 NOT TO SCALE

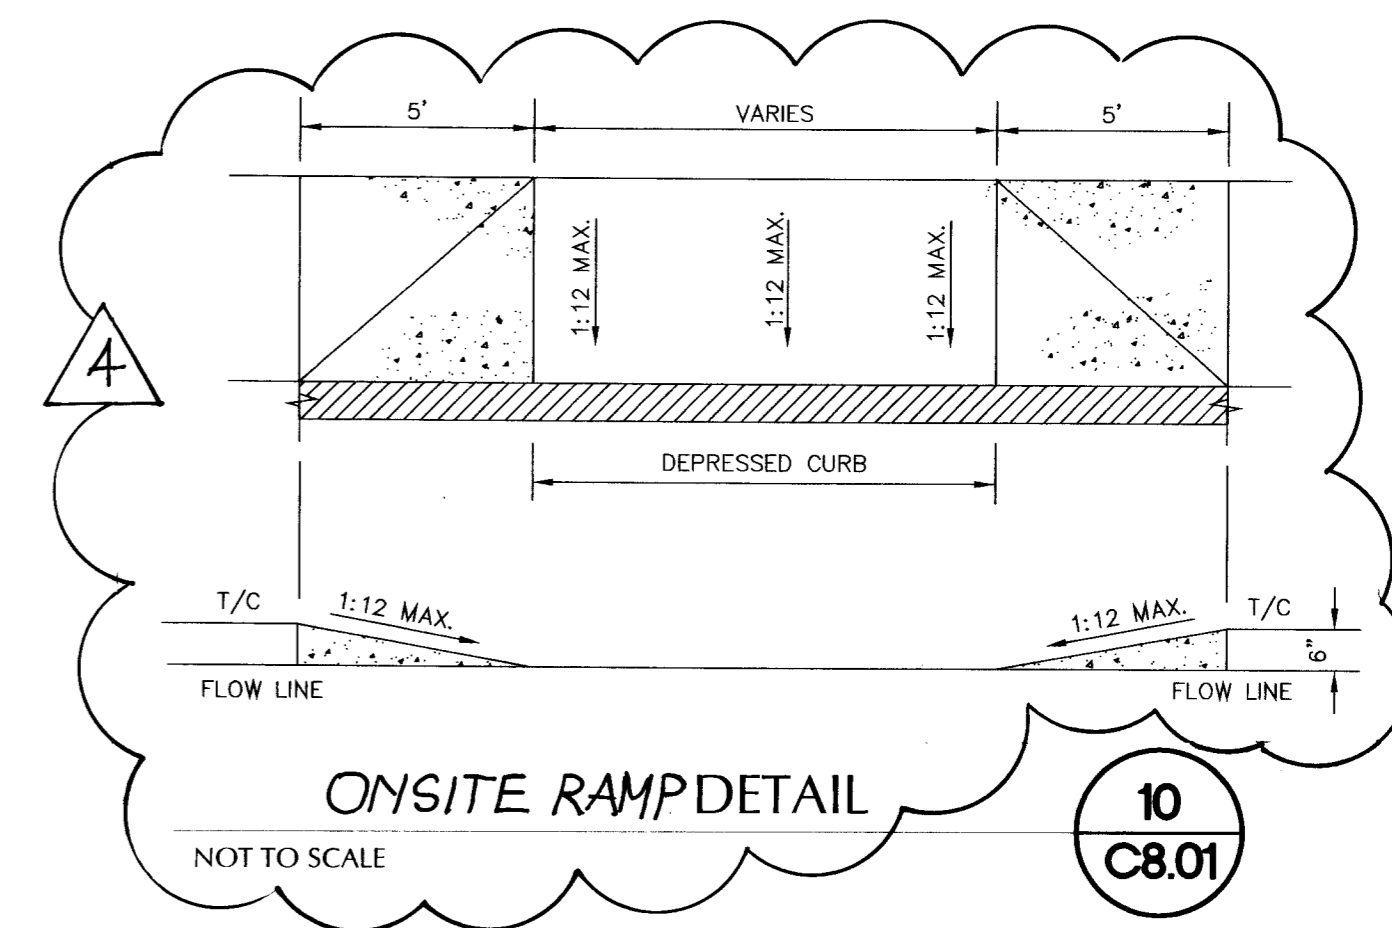

10
C8.01
 ONSITE RAMP DETAIL
 NOT TO SCALE

S:\proj\1064\Drawings\DETAILS\04_CIVIL\NOTES.dwg 11/20/2005 8:06:45 AM PST

105002
 8882-6

CLV# 107V4578
 DRAWING No. 9683

no.	description of revisions	date	name
1	REVISED DETAIL TO ONSITE RAMP	10/3/07	SB

sheet number
C8.01
 SHEET 7 OF 7