



MONUMENTATION TIE MAP

FORT APACHE / ALEXANDER (BOOK 83, PAGE 13)

BEING THE NORTHEAST QUARTER (NE 1/4) OF THE NORTHEAST QUARTER (NE 1/4) OF THE NORTHEAST QUARTER (NE 1/4) OF SECTION 7, TOWNSHIP 20 SOUTH, RANGE 60 EAST, M.D.M., CITY OF LAS VEGAS, CLARK COUNTY, NEVADA.

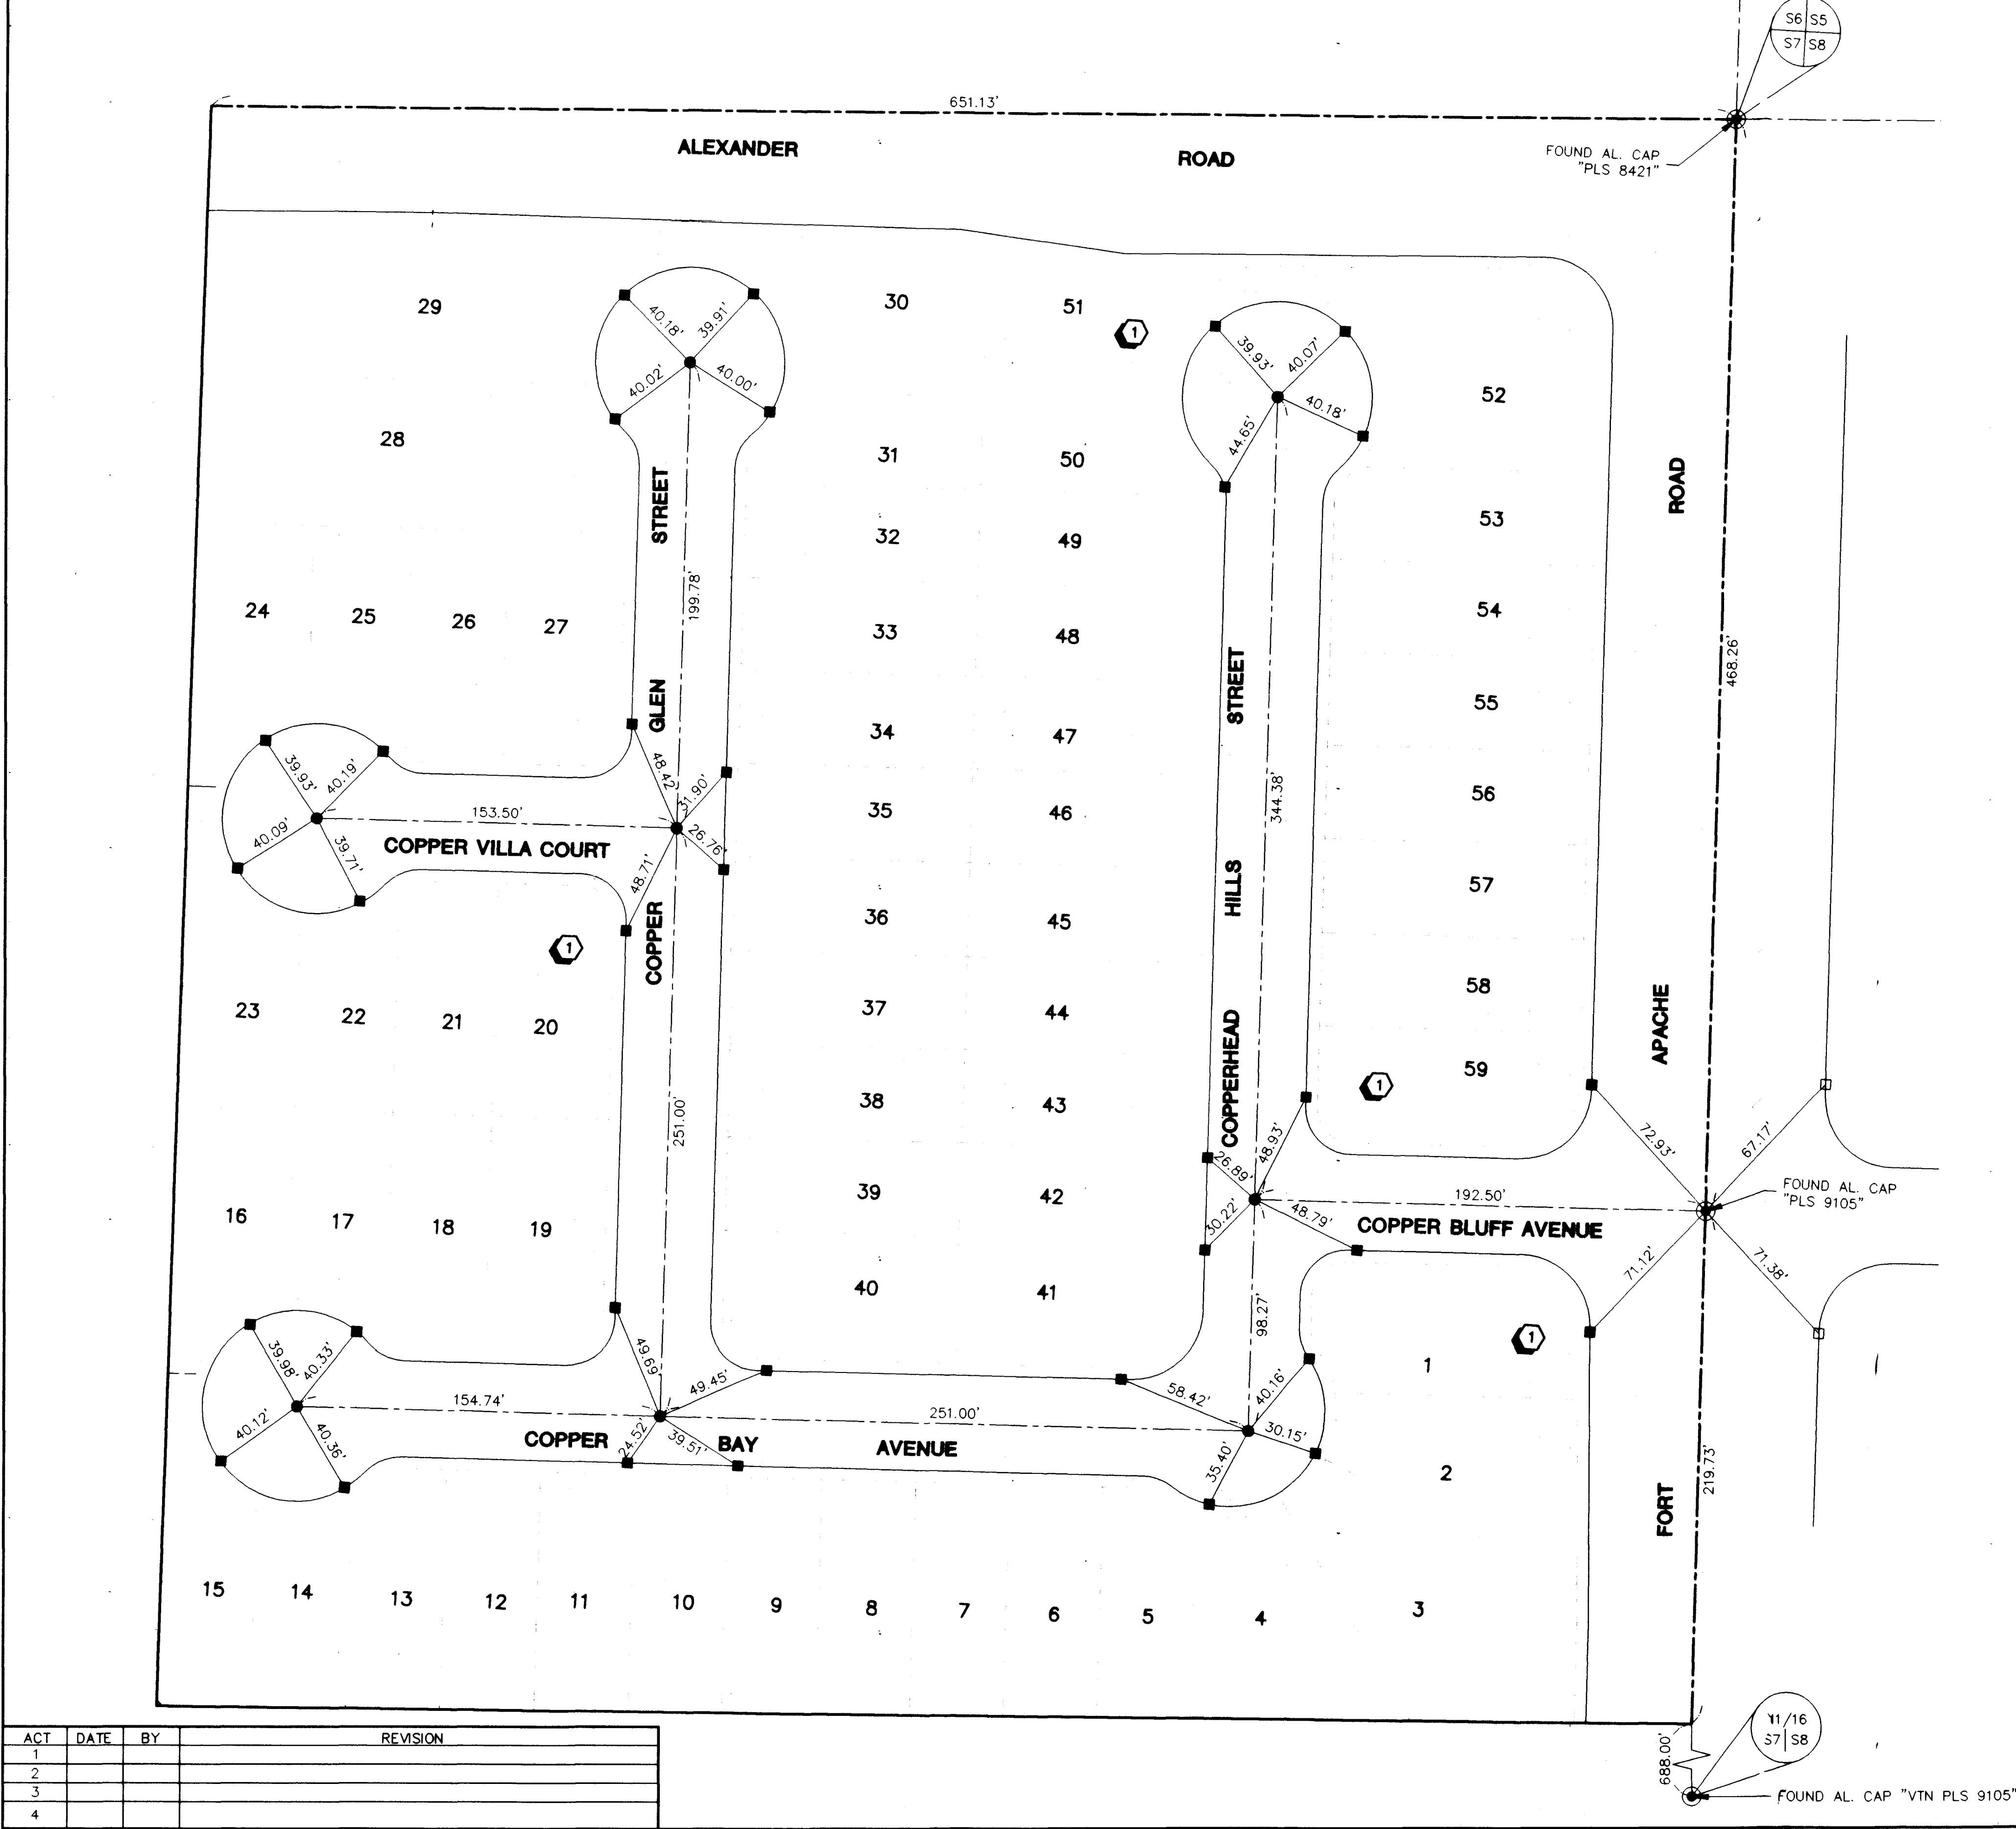

I, ANTHONY ZICARI, A PROFESSIONAL LAND SURVEYOR LICENSED IN THE STATE OF NEVADA, DO HEREBY CERTIFY THAT THE MONUMENTS HAVE BEEN SET AND THE TIE DISTANCES ESTABLISHED AS SHOWN HEREON. THIS SURVEY WAS COMPLETED ON 1-7-2000.

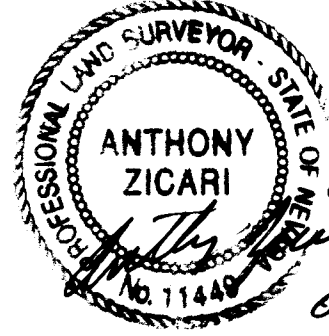


ANTHONY ZICARI, P.L.S.
NEVADA LICENSE NO. 11449

LEGEND

- 2 LOT NUMBER
- 2 BLOCK NUMBER
- BOUNDARY
- RIGHT OF WAY
- LOT LINES
- STREET CENTERLINE
- BACK OF CURB LINE
- MONUMENTS AS DESCRIBED
- SET TYPE III MONUMENT, AL. CAP AND REBAR - "VTN PLS 11449"
- SET TYPE IV-A REFERENCE MONUMENTS "VTN PLS 11449" IN TOP OF CURB
- FOUND TYPE IV-A REFERENCE MONUMENTS "VTN PLS 9105" IN TOP OF CURB

NOTES

SEE FINAL MAP: BOOK 83, PAGE 13, FOR BEARINGS AND DISTANCES.

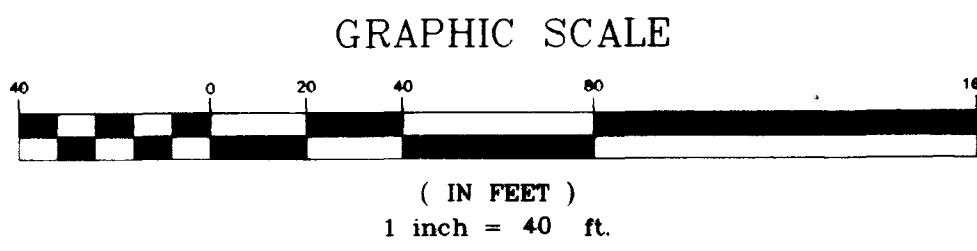

CONSULTING ENGINEERS • PLANNERS • LAND SURVEYORS					
2727 SOUTH RAINBOW BOULEVARD					
LAS VEGAS, NEVADA 89102-5148					
(702) 873-7550 FAX (702) 362-2597					
SCALE: 1" = 40'	W.O.# 5200	DATE: 1-7-2000	SHEET	OF	
FILE: 5200MTM	DRN. BY: CZ	REV.:	1	1	
	CKD. BY:				

058-4527