


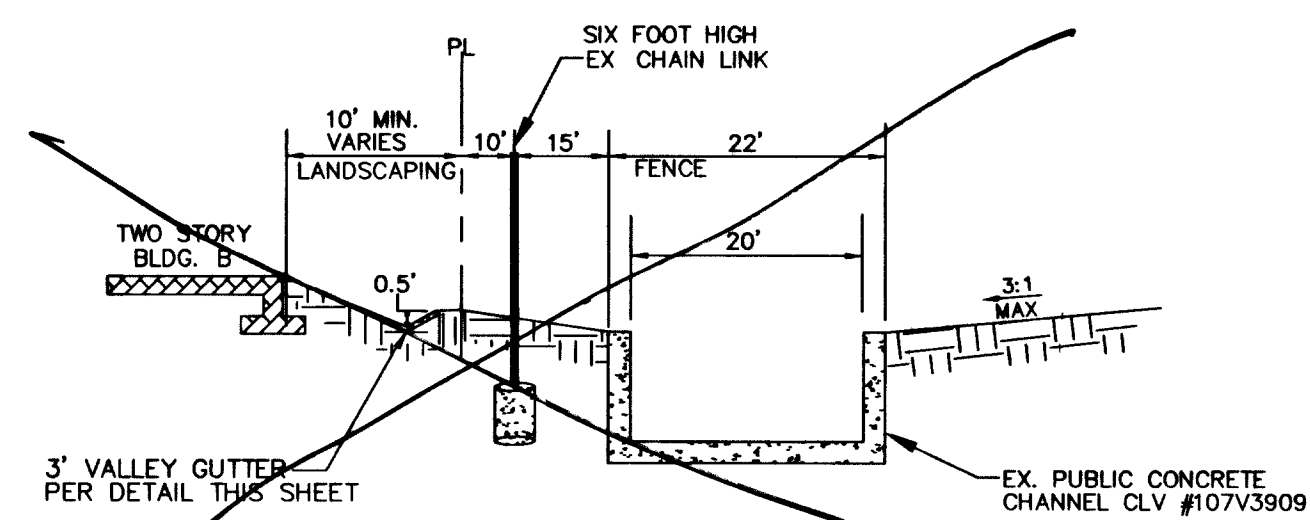


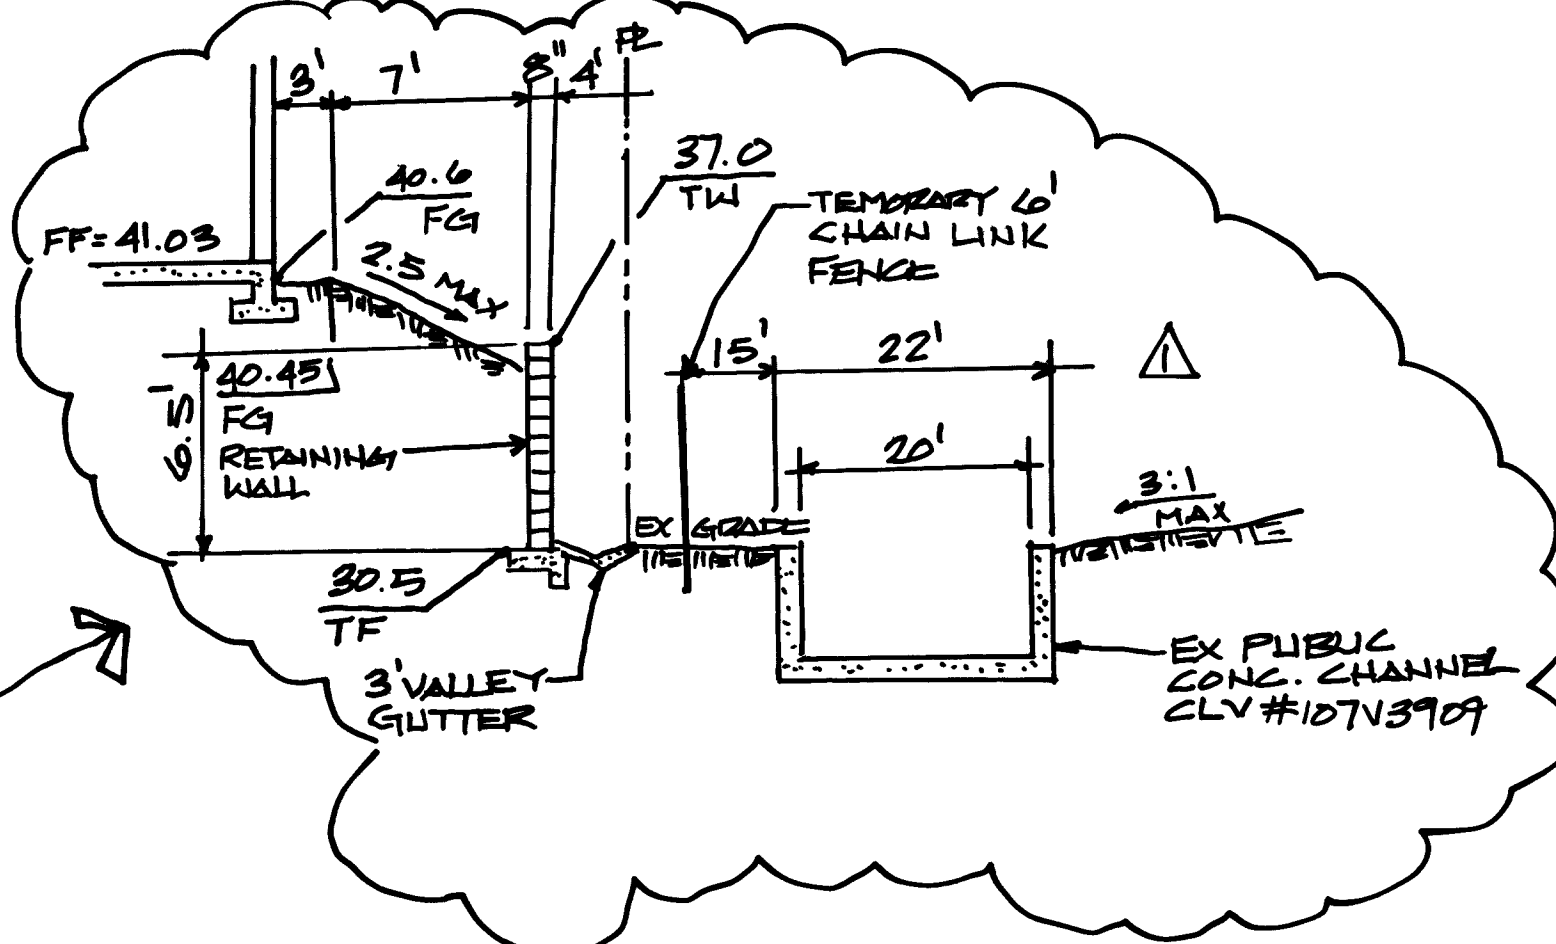


SECTION 1
1
C4

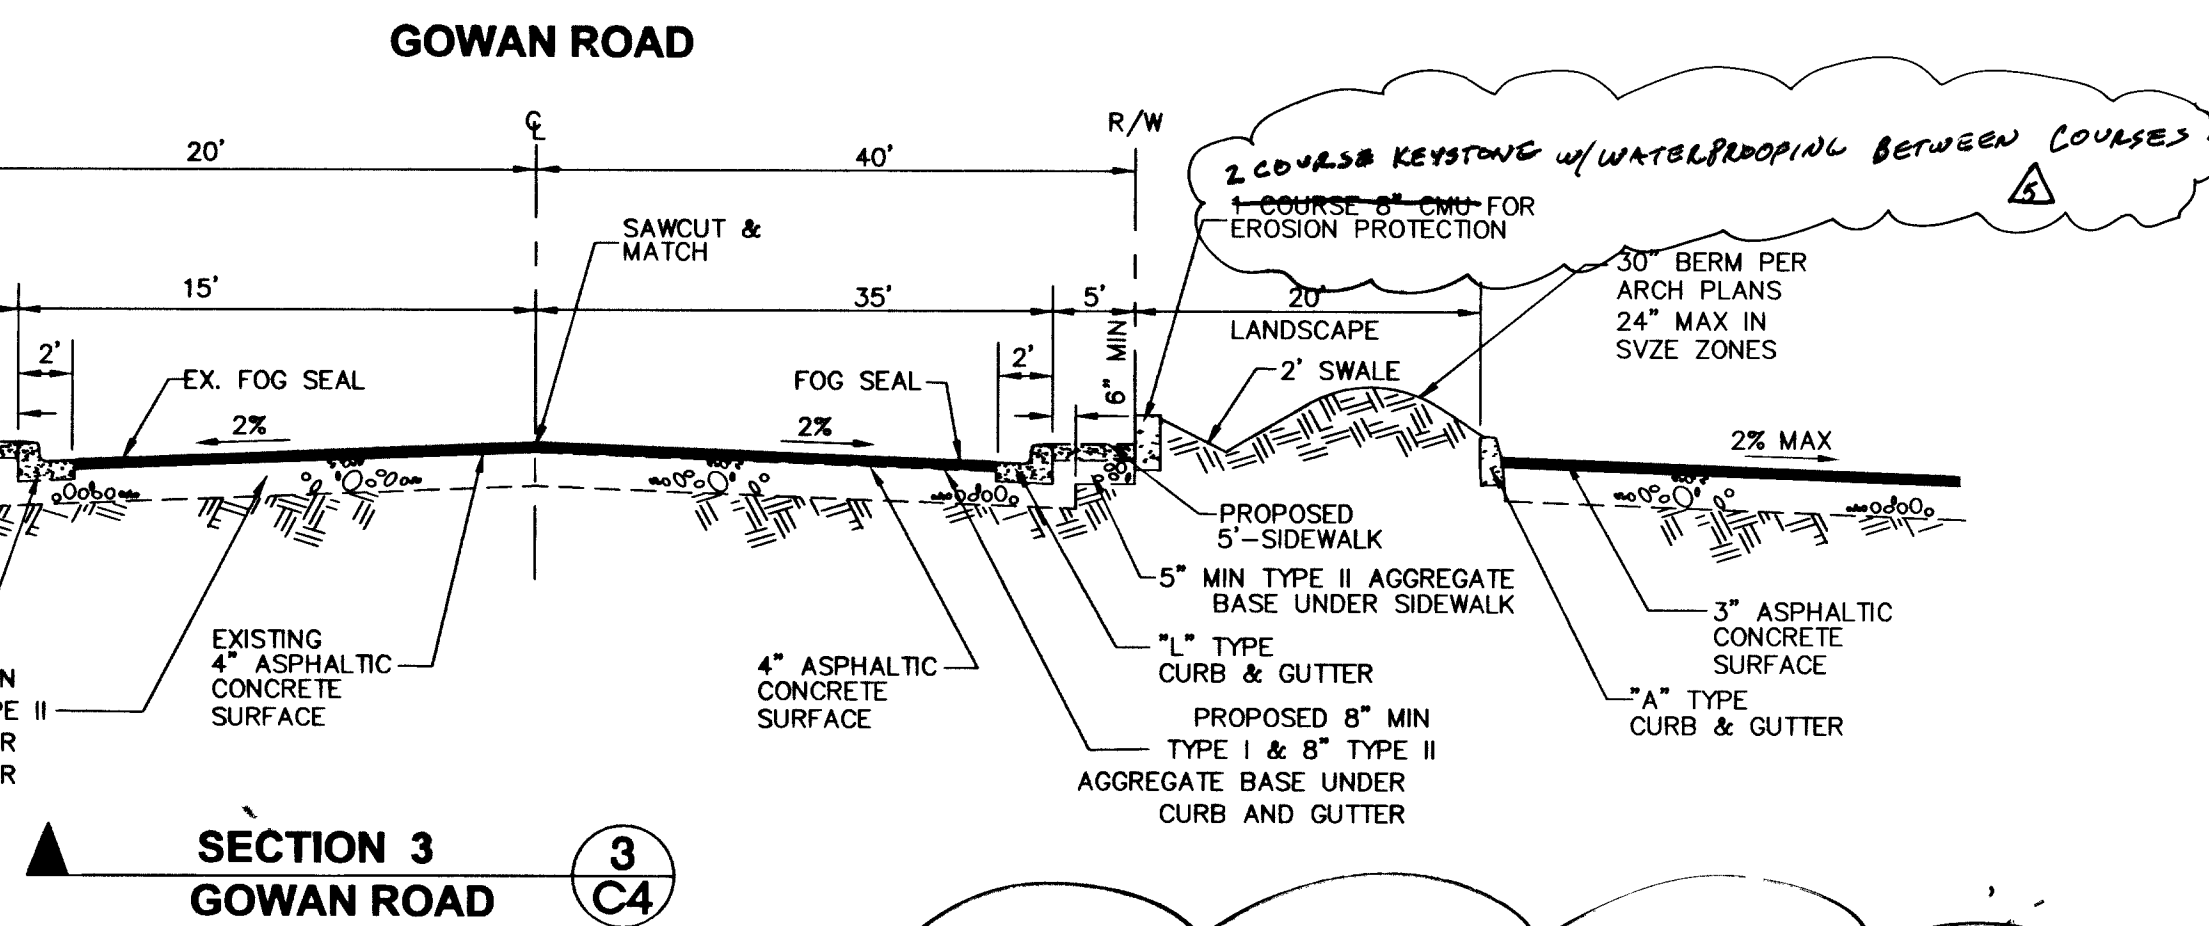


SECTION 2
2
C4

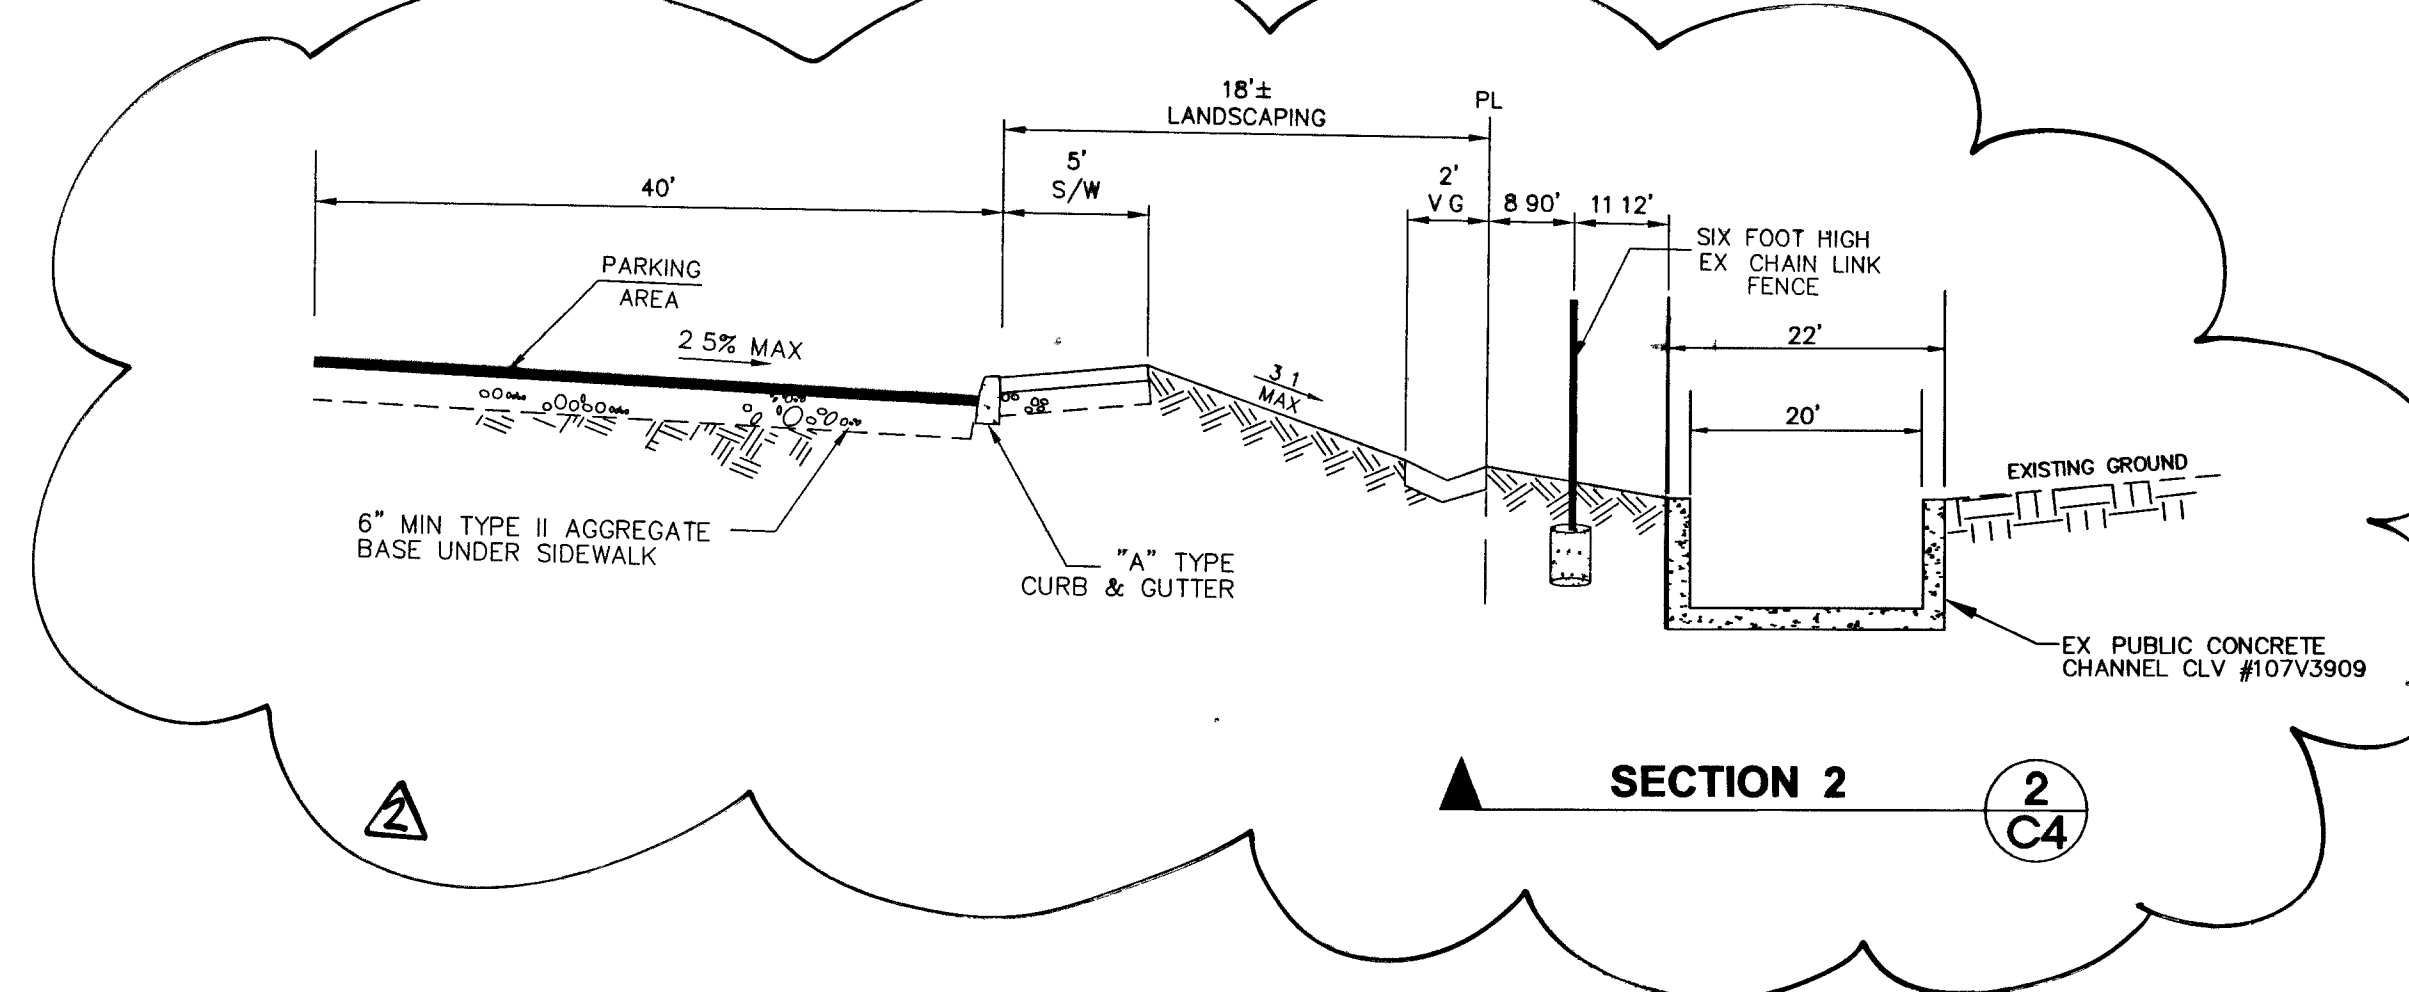


SECTION 3
3
C4

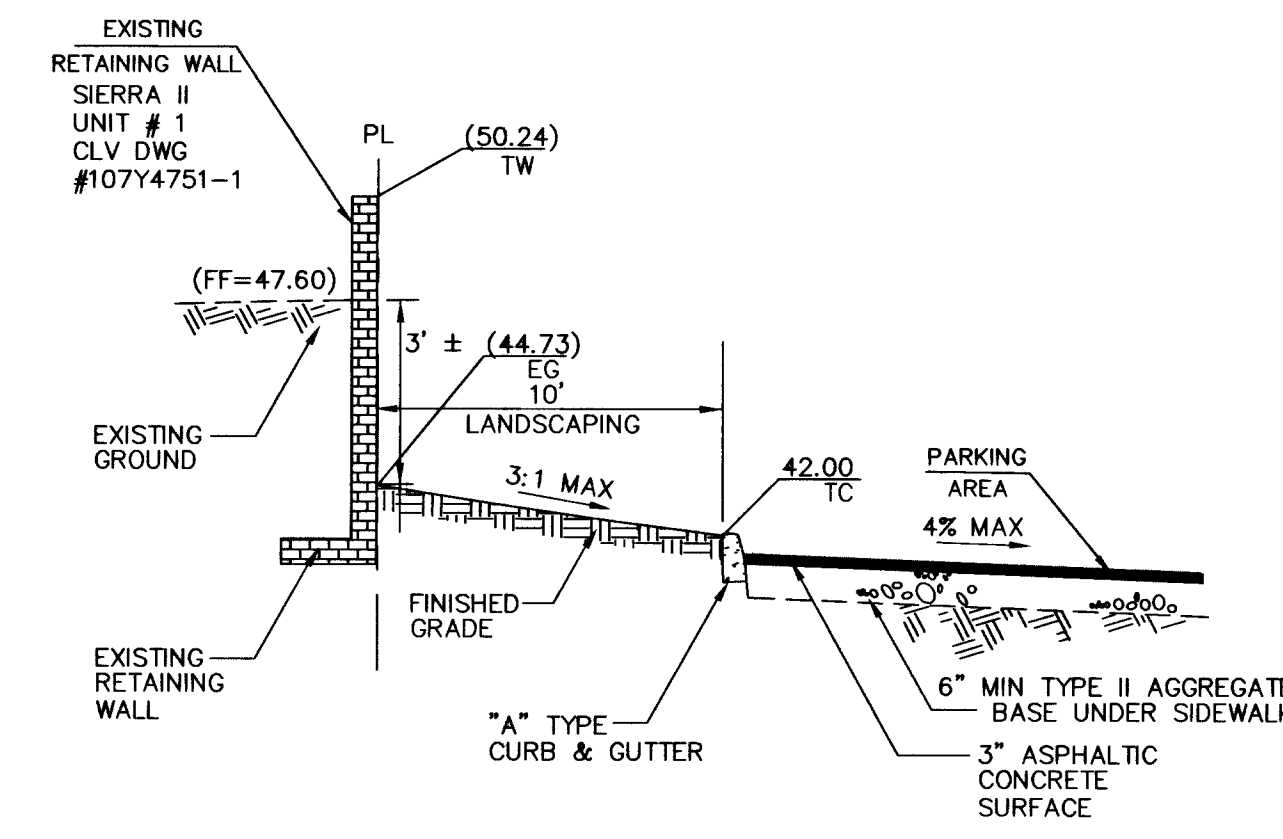


SECTION 4
4
C4

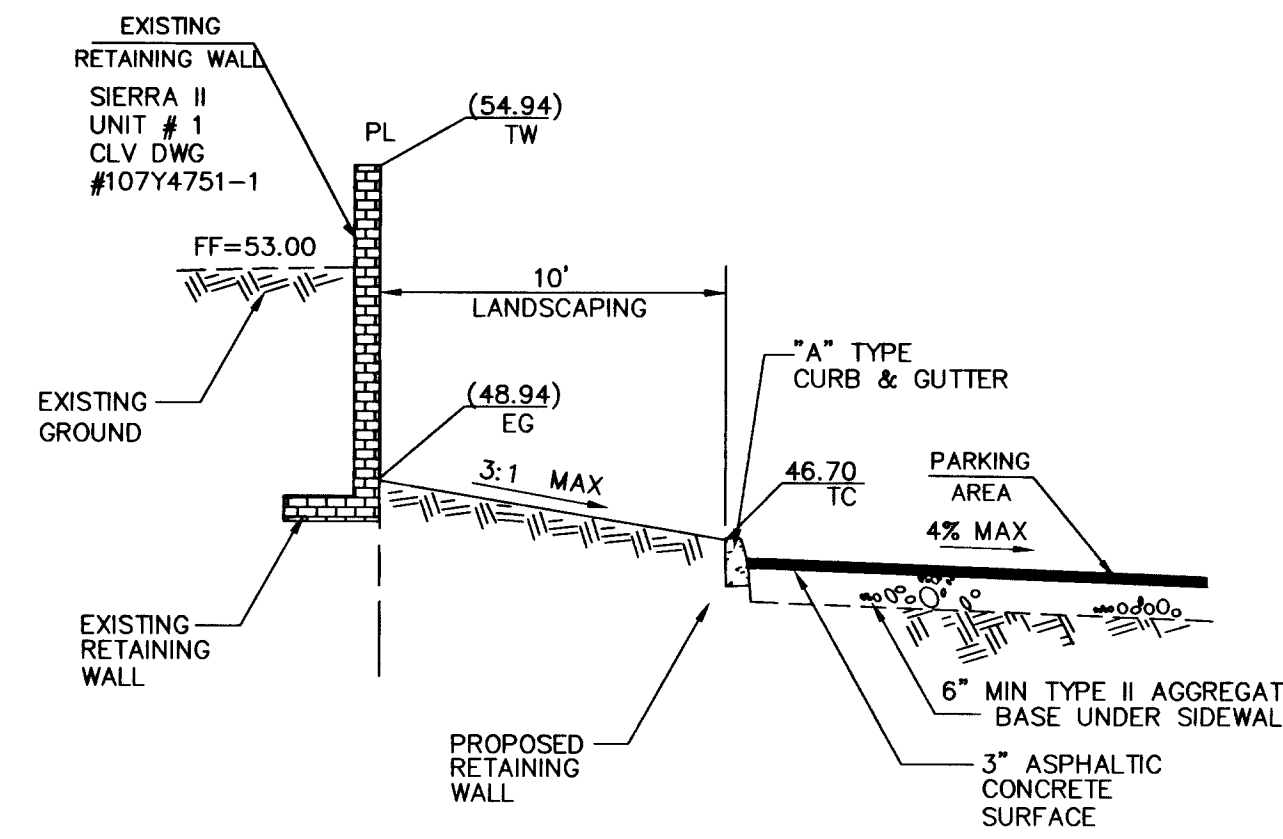


SECTION 5
5
C4

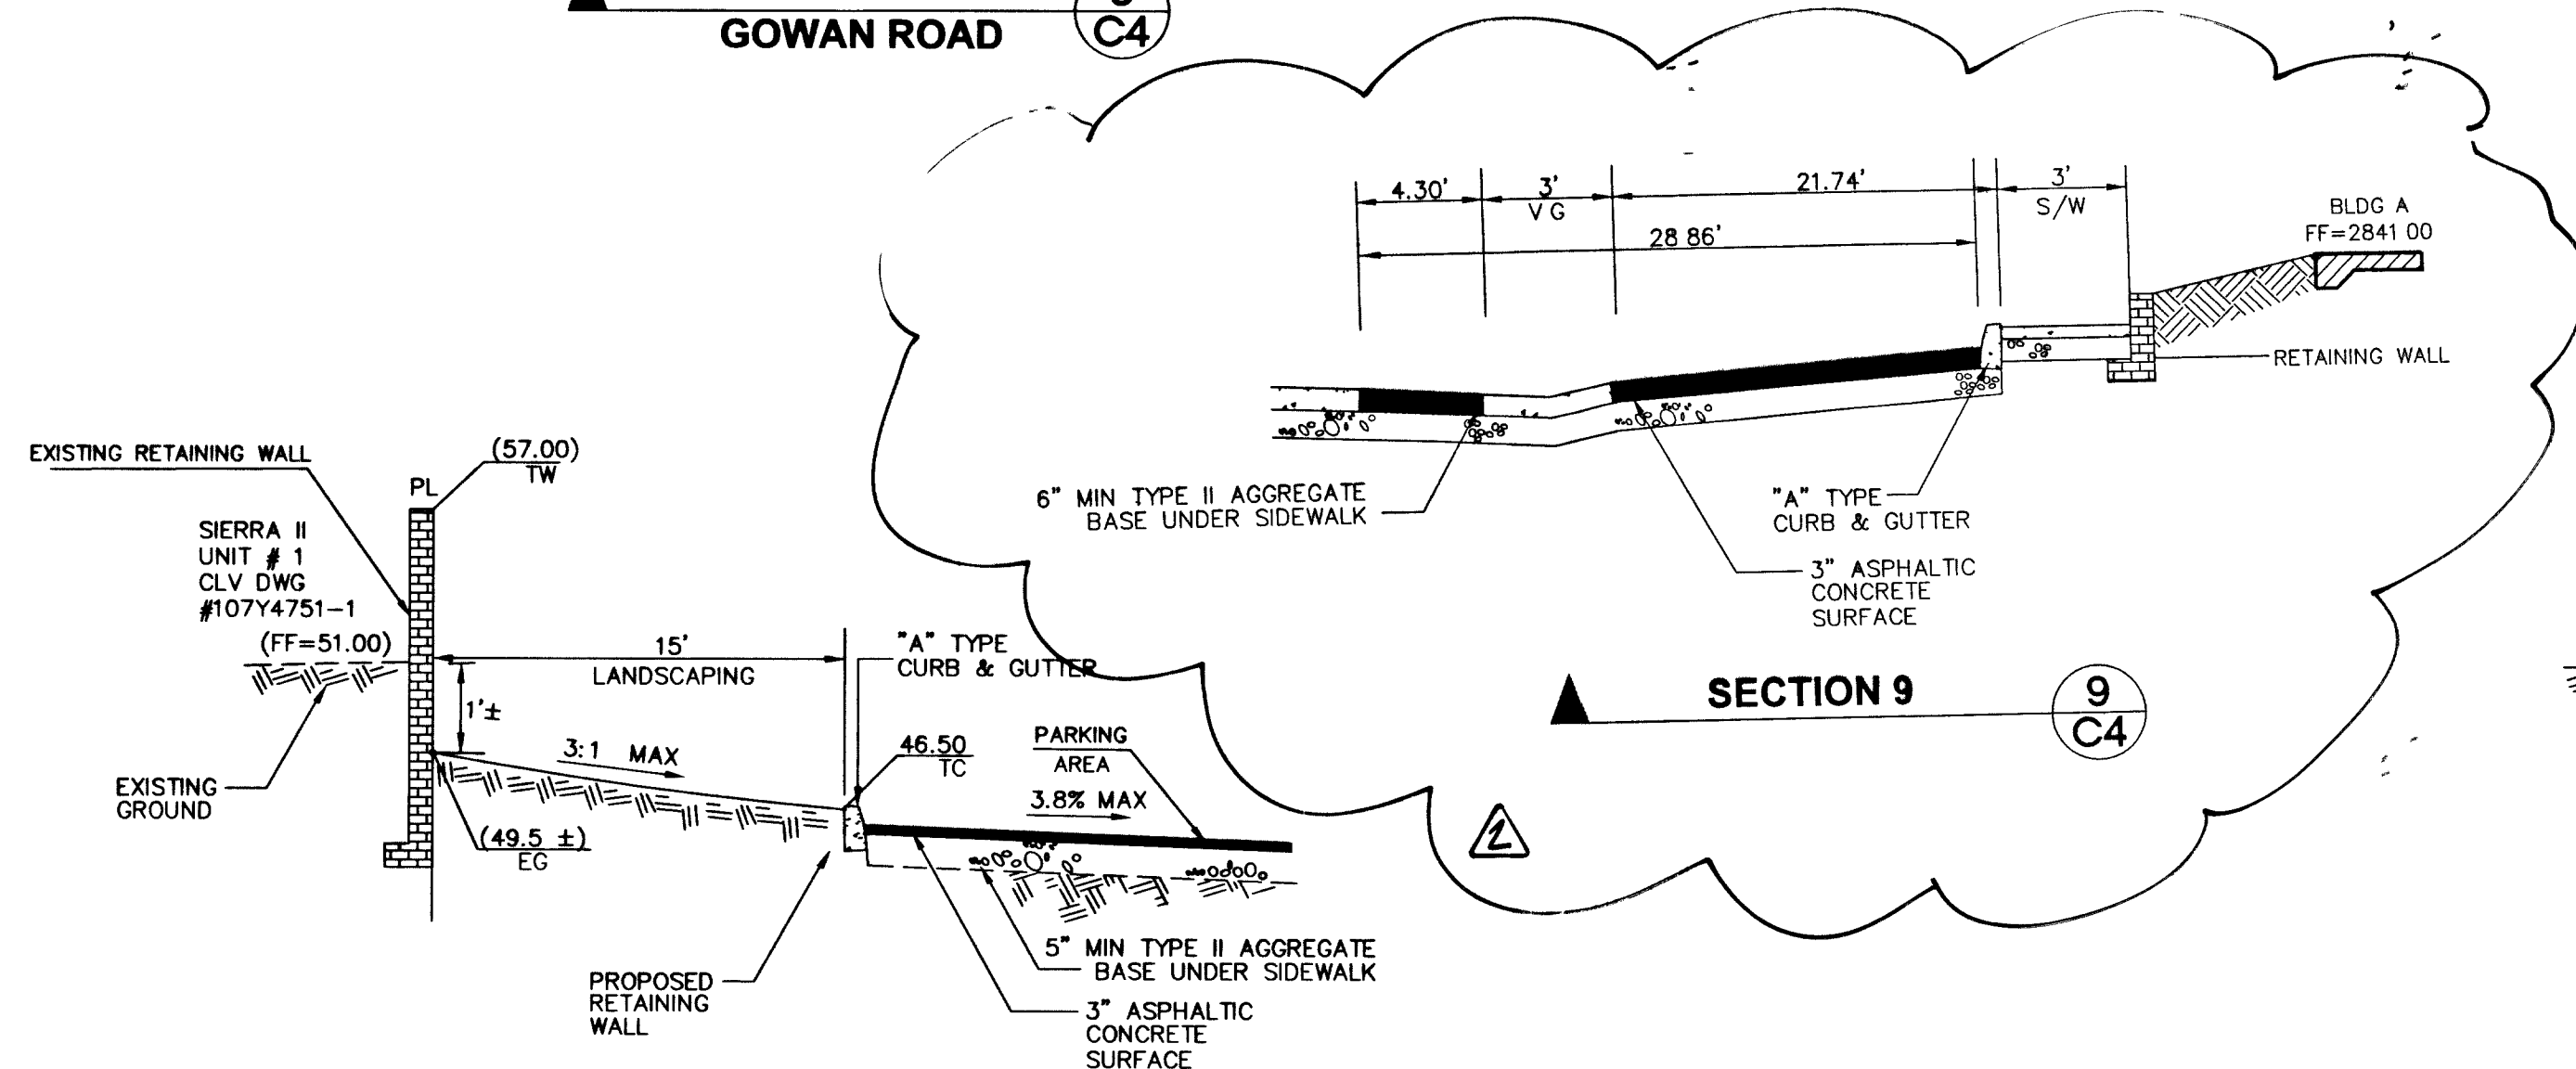


SECTION 6
6
C4

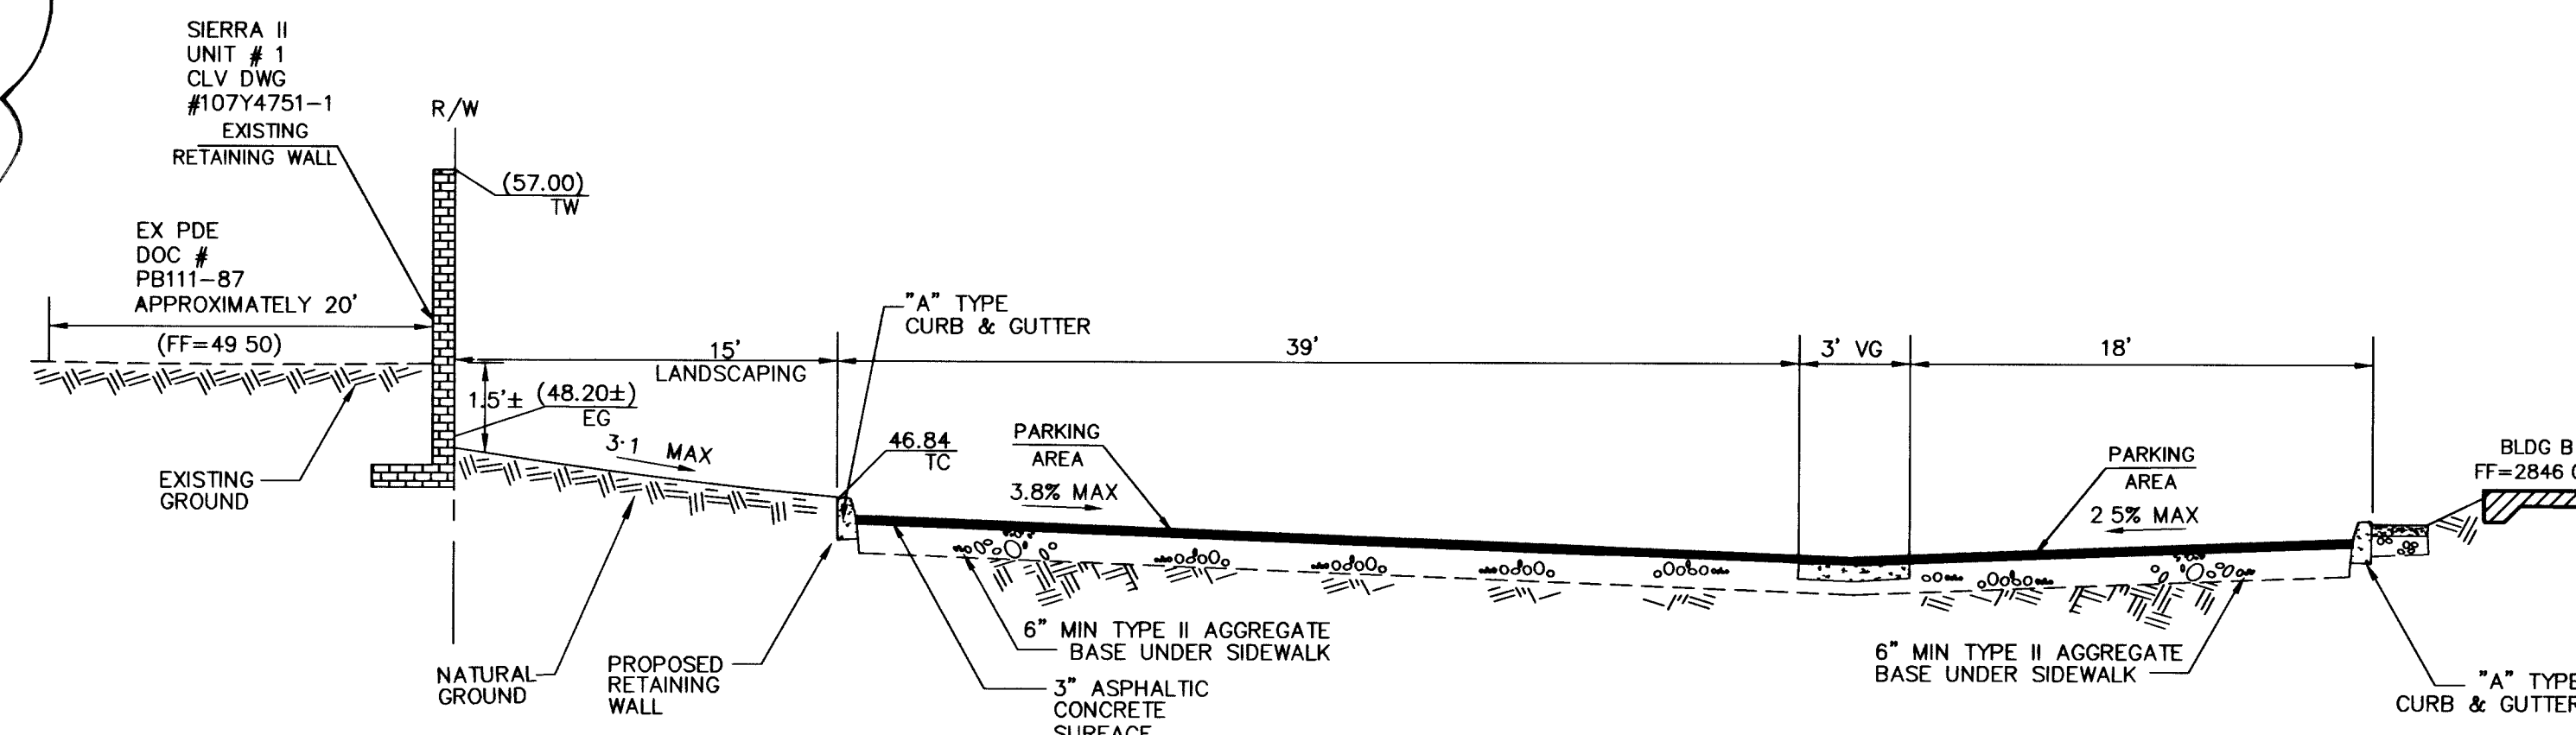


SECTION 7
7
C4

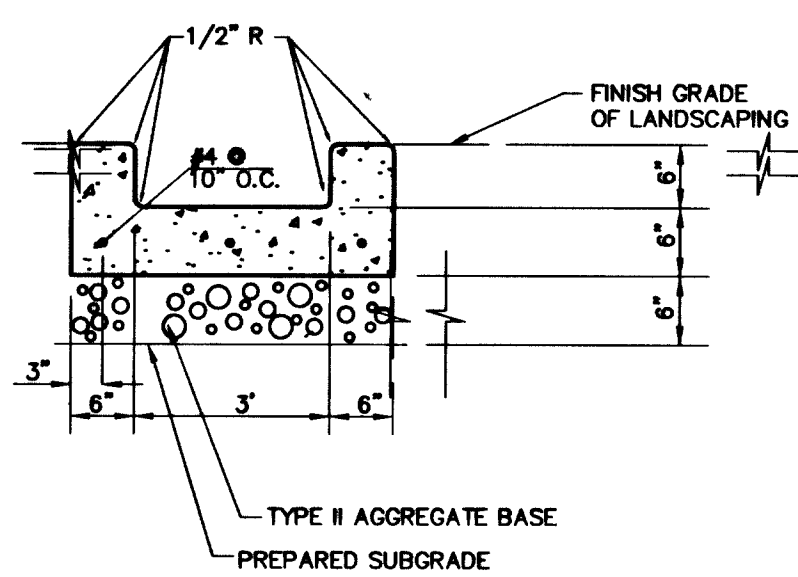

3 FOOT U-GUTTER DETAIL

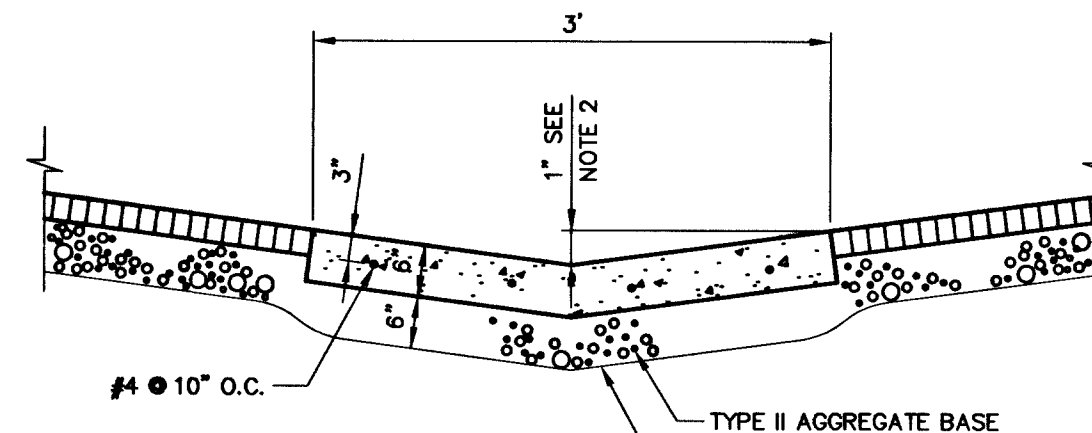

3' VALLEY GUTTER
NTS

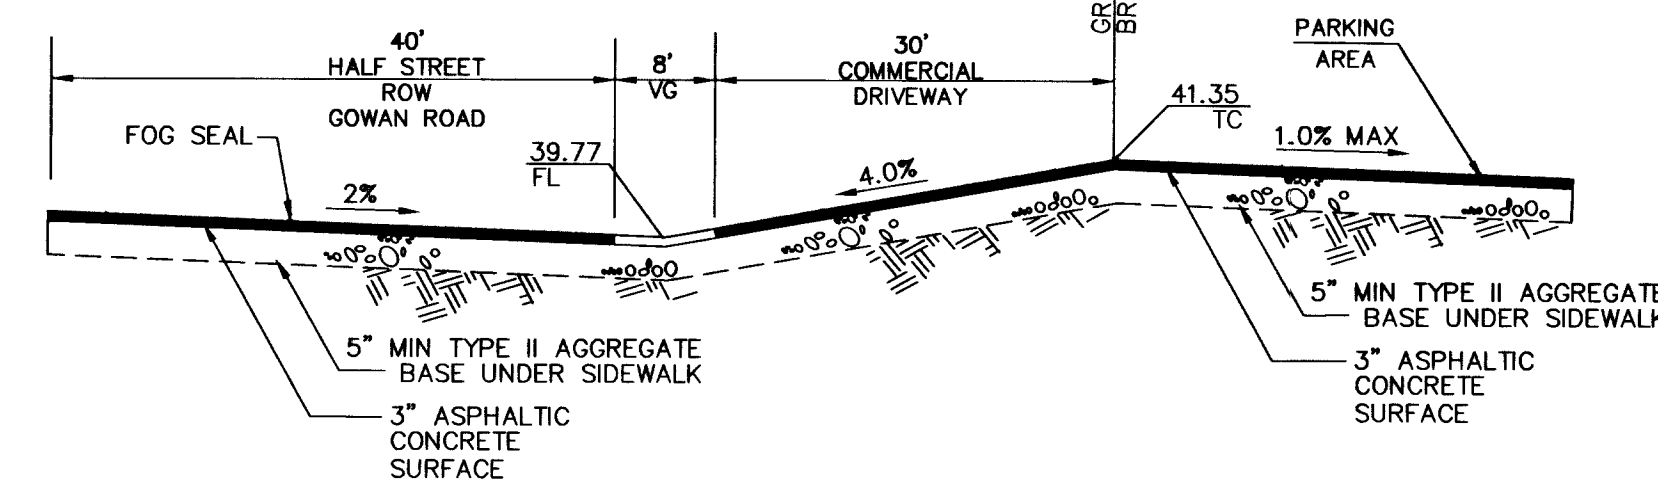

SECTION 8
8
C4


Call before you Dig.
1-800-227-2600
UNDERGROUND SERVICE (USA)

CALL BEFORE YOU DIG
1-702-227-2929

H* 11691

WEST GOWAN OFFICE PARK

GRADING DETAIL SHEET

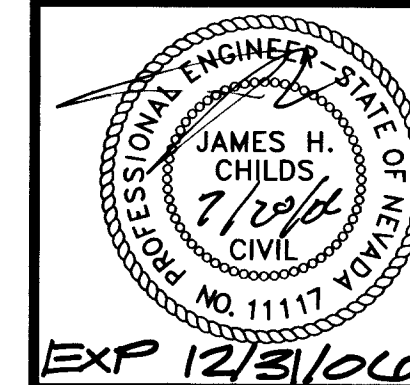

SHEET
C4
4 OF 9 SHEETS
DRAWING NO
107V4689

SCALE:	N/A
DRAWN BY:	JHC
DESIGNED BY:	JHC
CHECKED BY:	JHC
SUBMITTAL DATE:	21 JUL 06
REVISIONS:	
DATE:	
BY:	
DESCRIPTION:	
REVISION APPROVAL BLOCK:	

OWNER/DEVELOPER
WEST GOWAN LLC
7490 WEST SAHARA AVENUE
LAS VEGAS - 89117

5333 S. Arville St. Suite 104
Las Vegas, Nevada 89120
Ph: (702)788-8545
FAX: (702)788-8636

THE CW GROUP
CIVIL ENGINEERS

112119
46133 99000 103844