



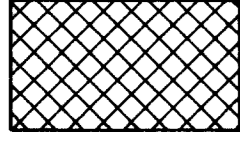

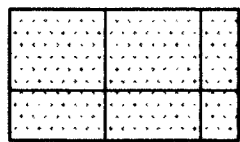


N:\2006\06-093 CLV Hoover Casino Troia\Draw\L06-093.dwg 07/06/2007 10:32

HARDSCAPE LEGEND





SYMBOL	DESCRIPTION
	PAVERS PER DOWNTOWN CENTENNIAL PLAN. SEE DETAIL 'C', SHEET L4.01.
	NATURAL GRAY CONCRETE SCORE IN 5X5' PATTERN WITH MEDIUM BROOM FINISH. PATTERN TO ALIGN WITH TREE GRATES. SEE CIVIL DRAWINGS.
	ADA ACCESS RAMPS. SEE CIVIL DRAWINGS. (TYP.).
	CURB AND GUTTER. SEE CIVIL DRAWINGS. (TYP.).

HARDSCAPE LEGEND

SYMBOL	DESCRIPTION
	TREE GRATE TO MATCH EXISTING TREE GRATES ON HOOVER STREET: NEENAH R-2706-1A WITH FRAME, AVAILABLE THROUGH NEENAH FOUNDRY COMPANY. CONTACT: RITA CHIHANIK (502) 284-9468. TREE GRATES TO BE INSTALLED PER MANUFACTURERS RECOMMENDATION AND SPECIFICATION. SEE DETAILS 'A' & 'B', SHEET L4.01.
	INSTALL CONCRETE TRASH RECEPTACLE PER MODEL #G5-PS2532W-A21, T1-SMOOTH STAINED CONCRETE WITH STANDARD GLOSS SEALER, CAST AND PAINTED CITY OF LAS VEGAS TEXT (SCRIPT LETTERS, 2 1/2" HIGH, ONE SIDE ONLY), STEEL LIDS INCLUDING CABLE AND BOLTS, Q-GL27 GALVANIZED 30 GALLON LINER, WITH STANDARD 2" DIA. DRAIN HOLE BY QUICK CRETE PRODUCTS TELEPHONE: 1.909.737.6240, OR EQUAL. GLUE DOWN WITH EPOXY. (TYP. OF 1 TRASH RECEPTACLE ALONG HOOVER AVE.).
	INSTALL CONCRETE BENCH PER MODEL #Q1-VIC-84B, SMOOTH FINISH WITH GLOSS SEALER, BY QUICK CRETE PRODUCTS TELEPHONE: 1.909.737.6240 OR EQUAL. GLUE DOWN WITH EPOXY. (TYP. OF 1 TRASH RECEPTACLE ALONG HOOVER AVE.).

NOTES


- 1) SEE SHEET L4.01 FOR HARDSCAPE DETAILS.
- 2) CONTRACTOR TO COORDINATE ALL UTILITIES, UTILITY VAULTS, CONCRETE WORK AND SLEEVING WITH CIVIL DRAWINGS.

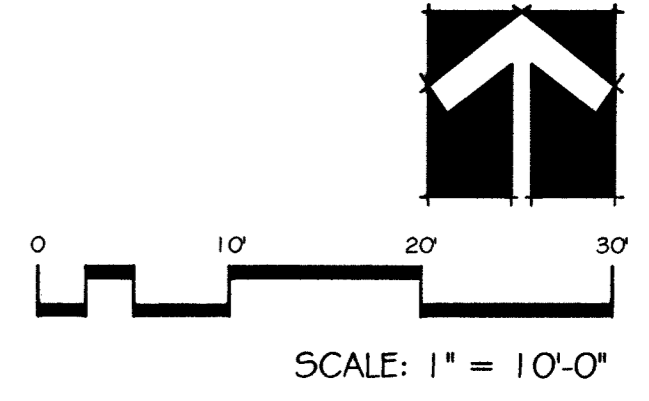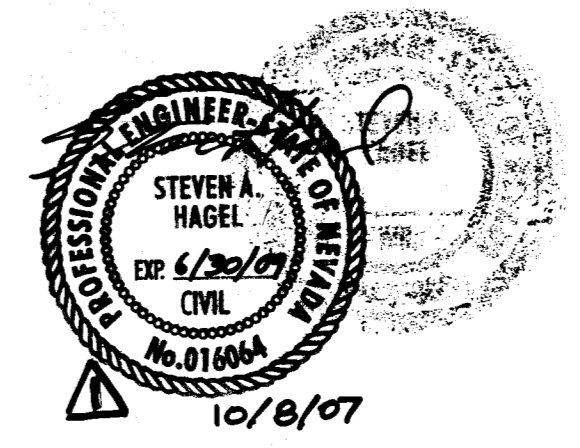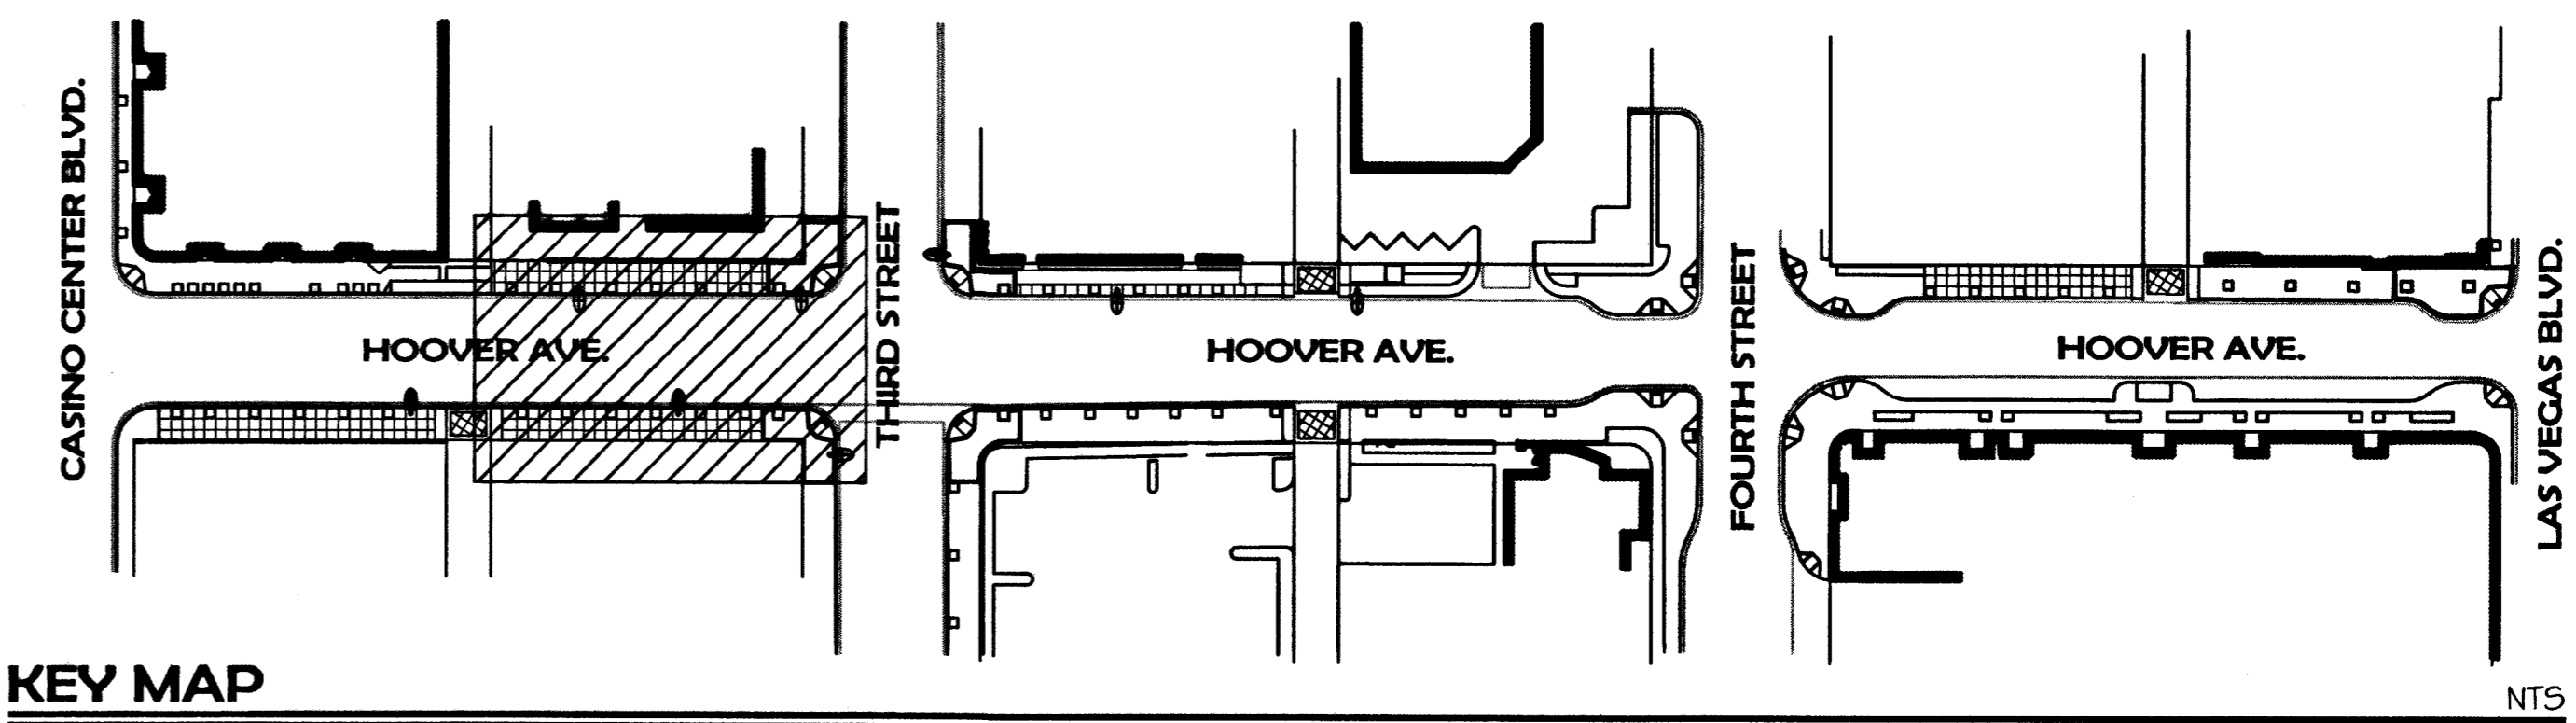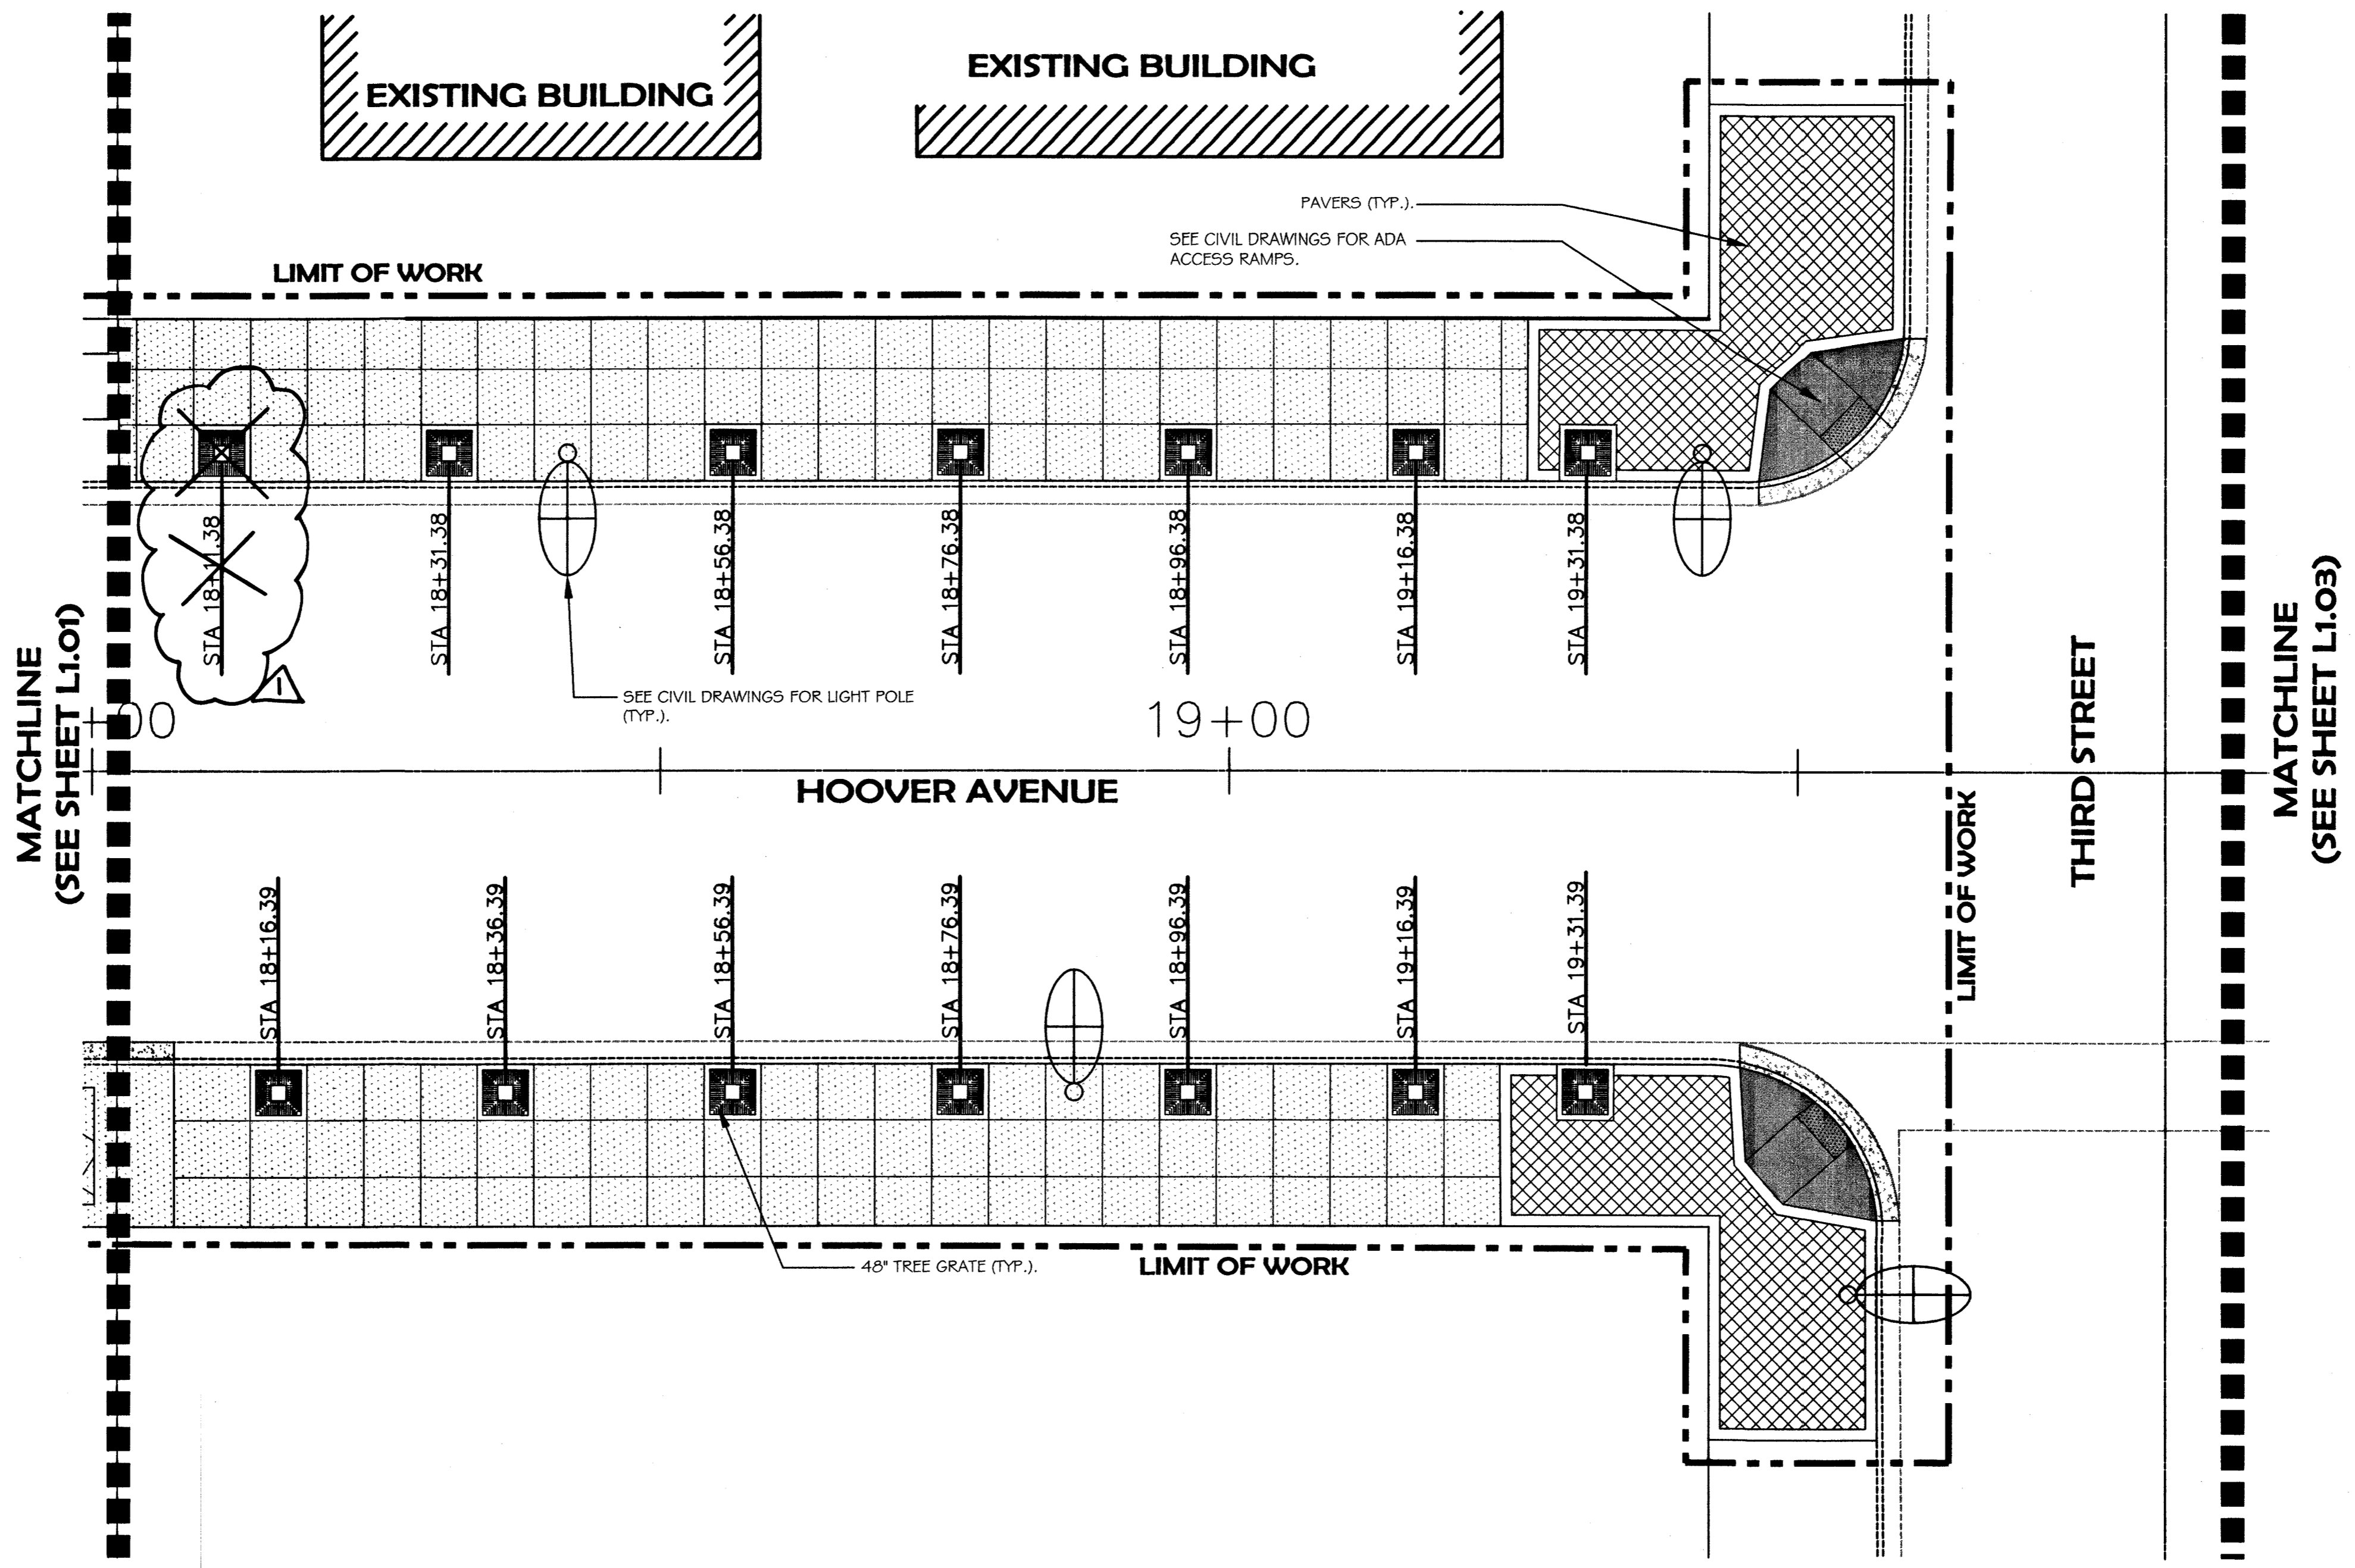

104690
105899

HOOVER AVE. AND CASINO CENTER BLVD. STREETScape IMPROVEMENTS
HARDSCAPE PLAN
HOOVER AVENUE

TITLE:
SHEET:

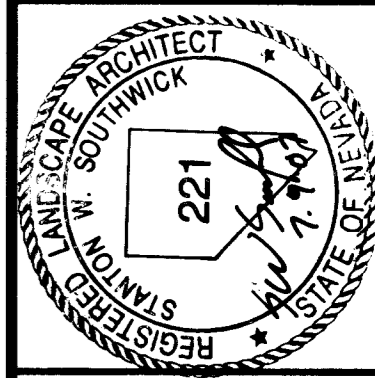


SHEET: **L102**
29 of **57**
DRAWING NO.
107V4812

DEPARTMENT OF PUBLIC WORKS



702.597.3108
12 Commerce Center Drive
Henderson, NV 89014
www.southwickla.com

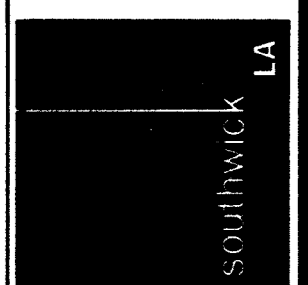

ENGINEERING DESIGN SECTION
CITY ENGINEER: JORGE CERVENIKES, P.E., P.T.O.E.
PROJECT MANAGER: ROSA CORTEZ, P.E.
DESIGNED BY: SEW
DRAWN BY: SEW
CHECKED BY: SWS
DATE: 07/05/2007

REVISIONS

NO.	DATE	DESCRIPTION
1	10/8/07	RMV. TREE GRATE

APPVD