IRON MOUNTAIN RANCH–VILLAGE 10 – UNIT 2

MONUMENTATION TIE MAP

(A COMMON INTEREST COMMUNITY)
LOCATED IN THE NORTHEAST QUARTER (NE 1/4) OF THE NORYHWEST QUATER (1/4)
OF SECTION 12, TOWNSHIP 19 SOUTH, RANGE 60 EAST, M.D.M.,
CITY OF LAS VEGAS, CLARK COUNTY, NEVADA.

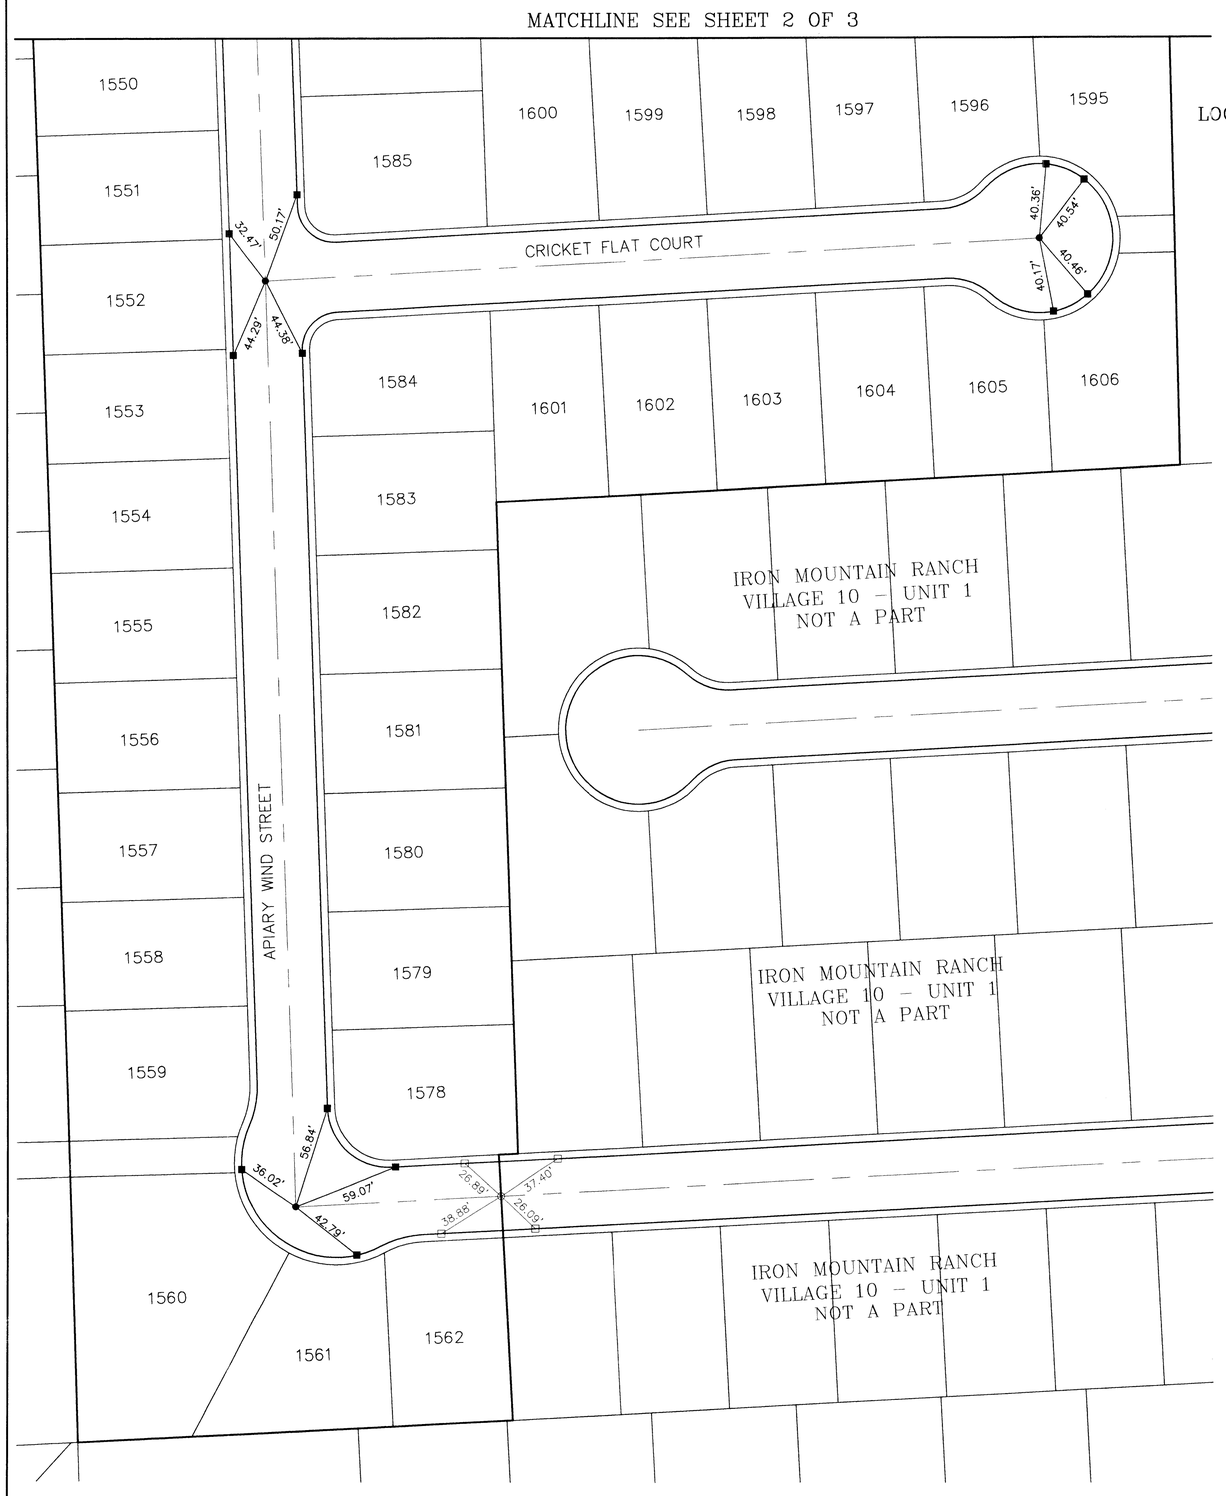

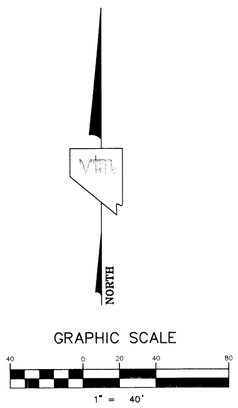

NOTES

SEE FINAL MAP FOR BEARING AND DISTANCES.
(BOOK 114, PAGE 0099)

LEGEND

2	LOT NUMBER
———	RIGHT OF WAY
———	LOT LINES
———	UNIT BOUNDARY
— — —	STREET CENTERLINE
———	BACK OF CURB LINE
●	TYPE III MONUMENT – 5/8" REBAR AND AL. CAP STAMPED "VTN PLS 11449" WITH REFERENCE MONUMENTS IN TOP OF CURB
■	TYPE IV–A REFERENCE MONUMENTS STAMPED "VTN PLS 11449" IN TOP OF CURB
○	TYPE III MONUMENT – 5/8" REBAR AND AL. CAP STAMPED "VTN PLS 11449" WITH REFERENCE MONUMENTS IN TOP OF CURB PER BOOK 111, PAGE 11
□	TYPE IV–A REFERENCE MONUMENTS STAMPED "VTN PLS 11449" IN TOP OF CURB PER BOOK 111, PAGE 11
⊙	MONUMENT AS NOTED