


IRON MOUNTAIN RANCH-VILLAGE 10 - UNIT 2
MONUMENTATION TIE MAP

(A COMMON INTEREST COMMUNITY)
 LOCATED IN THE NORTHEAST QUARTER (NE 1/4) OF THE NORTHWEST QUATER (NW 1/4) OF SECTION 12
 TOWNSHIP 19 SOUTH, RANGE 60 EAST, M.D.M., CITY OF LAS VEGAS, CLARK COUNTY, NEVADA.

MATCHLINE SEE SHEET 2 OF 3



TYPE I MONUMENT - 2" BRASS CAP IN CONCRETE
 WELL MONUMENT STAMPED "VTN PLS 11449"
 WITH REFERENCE MONUMENTS IN TOP OF CURB

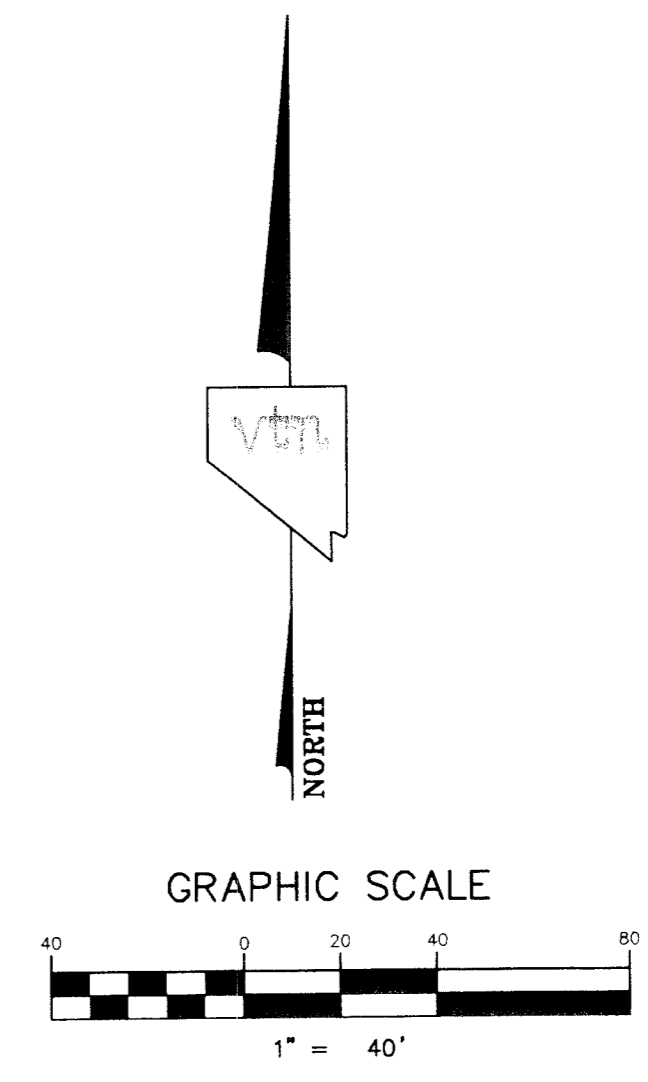

NOTES

SEE FINAL MAP FOR BEARING AND DISTANCES.
 (BOOK 114, PAGE 0099)

LEGEND

- 2 LOT NUMBER
- RIGHT OF WAY
- LOT LINES
- UNIT BOUNDARY
- STREET CENTERLINE
- BACK OF CURB LINE
- TYPE III MONUMENT - 5/8" REBAR AND AL. CAP STAMPED "VTN PLS 11449" WITH REFERENCE MONUMENTS IN TOP OF CURB
- TYPE IV-A REFERENCE MONUMENTS STAMPED "VTN PLS 11449" IN TOP OF CURB
- ⊙ MONUMENT AS NOTED