
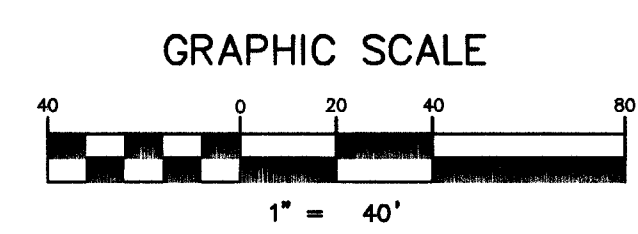


IRON MOUNTAIN RANCH-VILLAGE 5-UNIT 1
MONUMENTATION TIE MAP

(A COMMON INTEREST COMMUNITY)
BEING A SUBDIVISION OF A PORTION OF THE EAST HALF (E 1/2)
OF THE SOUTHEAST QUARTER (SE 1/4) OF SECTION 12,
TOWNSHIP 19 SOUTH, RANGE 60 EAST, M.D.M., CITY OF LAS VEGAS,
CLARK COUNTY, NEVADA

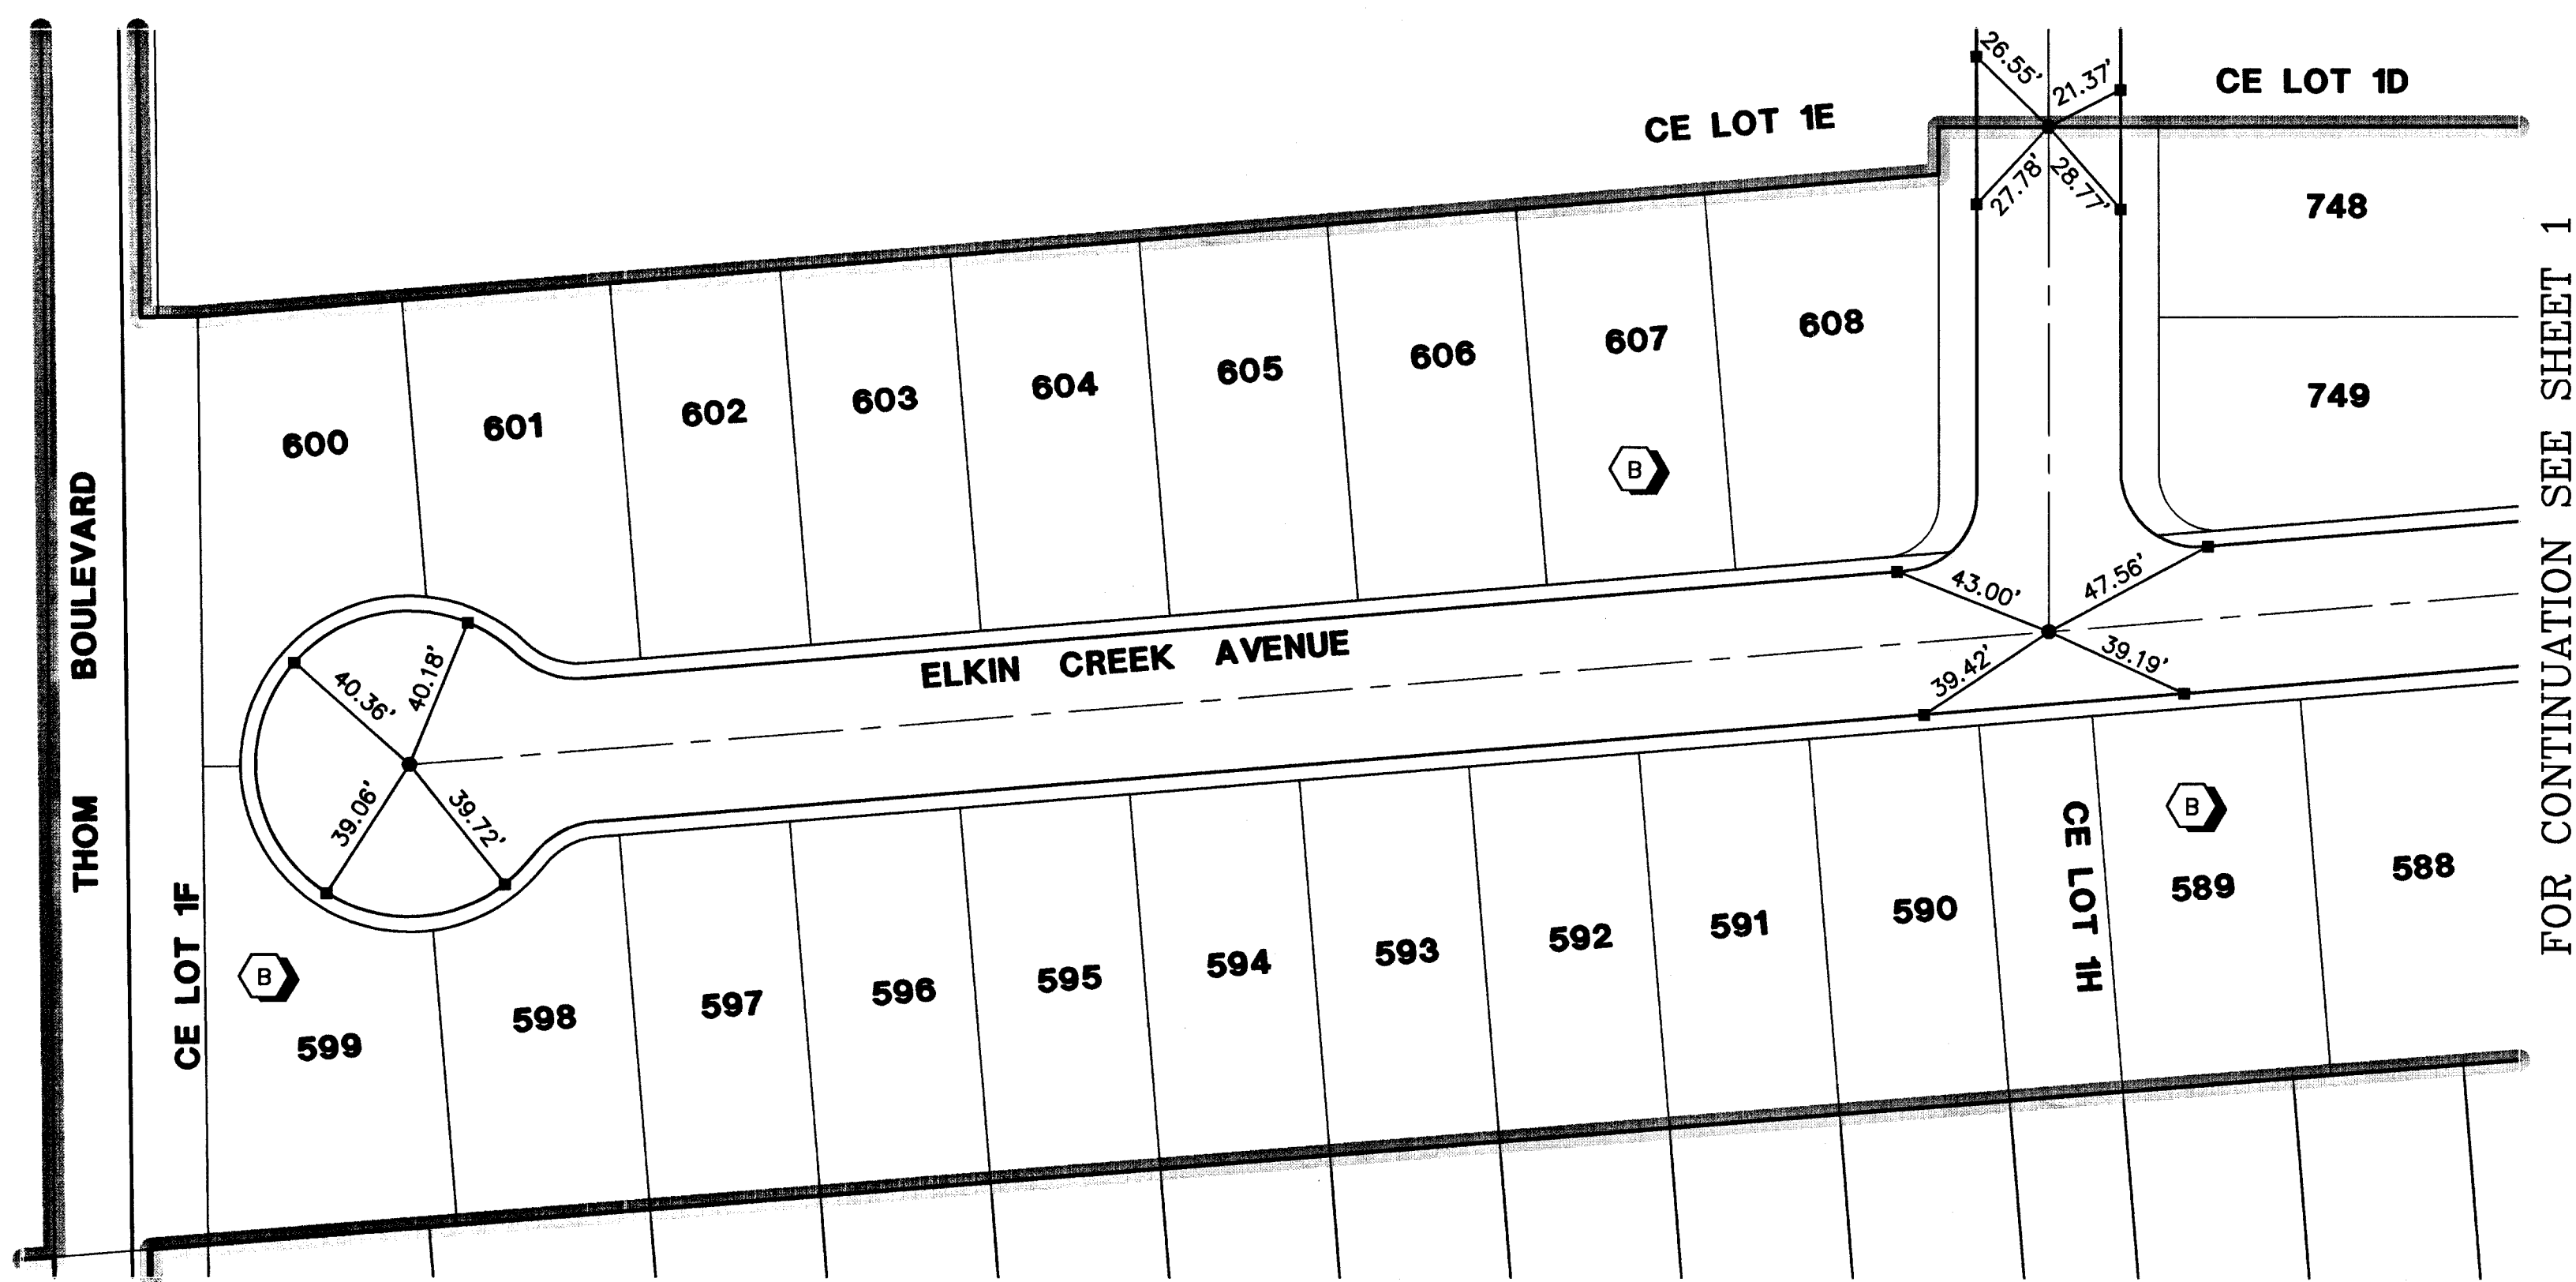

NOTES

SEE FINAL MAP FOR BEARING AND DISTANCES.
(BOOK 108, PAGE 37)

LEGEND

- 2 LOT NUMBER
- (X) BLOCK NUMBER
- RIGHT OF WAY
- LOT LINES
- UNIT BOUNDARY
- STREET CENTERLINE
- BACK OF CURB LINE
- SET TYPE III MONUMENT - 5/8" REBAR AND AL. CAP STAMPED "VTN PLS 11449" WITH REFERENCE MONUMENTS IN TOP OF CURB
- SET TYPE IV-A REFERENCE MONUMENTS STAMPED "VTN PLS 11449" IN TOP OF CURB