


IRON MOUNTAIN RANCH-VILLAGE 5-UNIT 2
MONUMENTATION TIE MAP

(A COMMON INTEREST COMMUNITY)
BEING A SUBDIVISION OF A PORTION OF THE NORTHEAST QUARTER (NE 1/4)
OF THE SOUTHEAST QUARTER (SE 1/4) OF SECTION 12,
TOWNSHIP 19 SOUTH, RANGE 60 EAST, M.D.M., CITY OF LAS VEGAS,
CLARK COUNTY, NEVADA

FOR CONTINUATION SEE SHEET 2

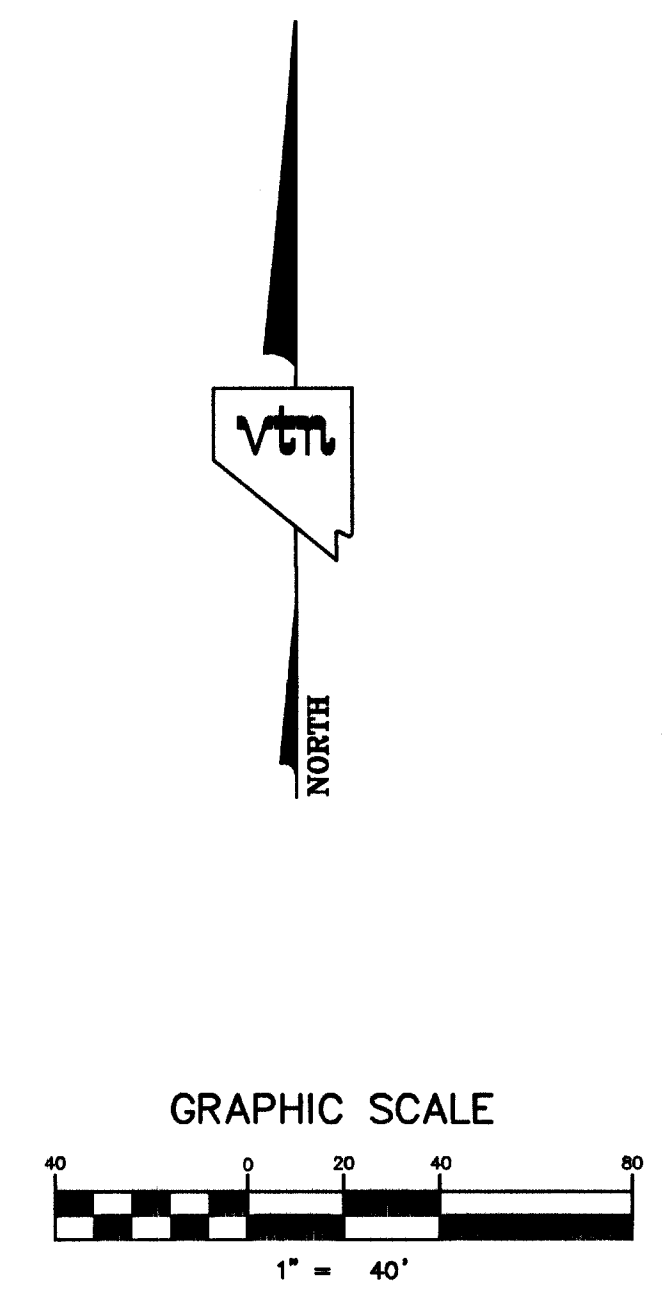

NOTES
SEE FINAL MAP FOR BEARING AND DISTANCES.
(BOOK 108, PAGE 0084)

- LEGEND**
- 2 LOT NUMBER
 - (X) BLOCK NUMBER
 - RIGHT OF WAY
 - LOT LINES
 - UNIT BOUNDARY
 - STREET CENTERLINE
 - BACK OF CURB LINE
 - SET TYPE III MONUMENT - 5/8" REBAR AND AL. CAP STAMPED "VTN PLS 11449" WITH REFERENCE MONUMENTS IN TOP OF CURB
 - SET TYPE IV--A REFERENCE MONUMENTS STAMPED "VTN PLS 11449" IN TOP OF CURB
 - △ TYPE III MONUMENT - 5/8" REBAR & AL. CAP STAMPED "VTN PLS 11449" PER "IRON MOUNTAIN RANCH - VILLAGE 5 - UNIT 1", BOOK 108, PAGE 37