

LINE	BEARING	DISTANCE
L1	N63°54'35"W	59.46'
L2	S32°21'47"W	43.14'
L3	N85°25'58"E	51.33'
L4	S01°41'37"W	22.00'
L5	S54°36'56"E	117.31'
L6	S26°12'38"E	30.52'
L7	S19°02'45"E	44.34'
L8	N76°38'27"W	63.50'
L9	S37°00'00"E	70.62'


CURVE	DELTA	RADIUS	LENGTH	TANGENT
C1	22°49'11"	300.00'	119.48'	60.54'
C2	11°37'32"	280.50'	56.92'	28.56'
C3	1°32'14"	1185.50'	31.81'	15.90'
C4	13°31'18"	800.80'	188.99'	94.93'
C5	27°15'24"	300.00'	142.72'	72.73'
C6	171°52"	4500.00'	94.07'	47.04'
C7	122°1'48"	500.00'	107.89'	54.16'
C8	17°36'56"	300.00'	92.24'	46.48'
C9	28°24'18"	350.00'	173.52'	88.58'
C10	14°28'42"	1000.00'	252.70'	127.02'
C11	12°24'37"	1694.50'	367.03'	184.24'
C12	12°11'38"	1000.00'	212.82'	106.81'
C13	27°7'04"	1000.00'	39.87'	19.94'
C14	4°07'22"	1694.50'	121.93'	60.99'
C15	8°17'16"	1694.50'	245.11'	122.77'
C16	17°04'26"	300.00'	89.40'	45.03'
C17	5°44'45"	300.00'	30.09'	15.06'
C18	18°37'27"	500.00'	162.53'	81.99'

SURVEYOR'S CERTIFICATE

I, SCOTT R. LANDERMAN, A PROFESSIONAL LAND SURVEYOR REGISTERED IN THE STATE OF NEVADA, AS AGENT FOR G.C. WALLACE, INC., CERTIFY THAT:

- THIS PLAT REPRESENTS THE RESULTS OF A SURVEY CONDUCTED UNDER MY SUPERVISION AT THE INSTANCE OF WILLIAM LYON HOMES, INC., A CALIFORNIA CORPORATION.
- THE LAND SURVEYED LIES WITHIN SECTION 34, TOWNSHIP 20 SOUTH, RANGE 59 EAST, AND SECTION 03, TOWNSHIP 21 SOUTH, RANGE 59 EAST, M.D.M., CITY OF LAS VEGAS, CLARK COUNTY, NEVADA, AND THE SURVEY WAS COMPLETED ON MARCH 09, 2007.
- THIS PLAT COMPLIES WITH APPLICABLE STATUTES OF THIS STATE AND ANY LOCAL ORDINANCES IN EFFECT ON THE DATE THAT THE SURVEY WAS COMPLETED, AND THE SURVEY WAS CONDUCTED IN ACCORDANCE WITH CHAPTER 625 OF THE NEVADA ADMINISTRATION CODE.
- THE MONUMENTS DEPICTED ON THE PLAT ARE OF THE CHARACTER SHOWN, OCCUPY THE POSITIONS INDICATED, AND ARE OF SUFFICIENT DURABILITY.

SCOTT R. LANDERMAN
PROFESSIONAL LAND SURVEYOR
NEVADA LICENSE NO. 8187

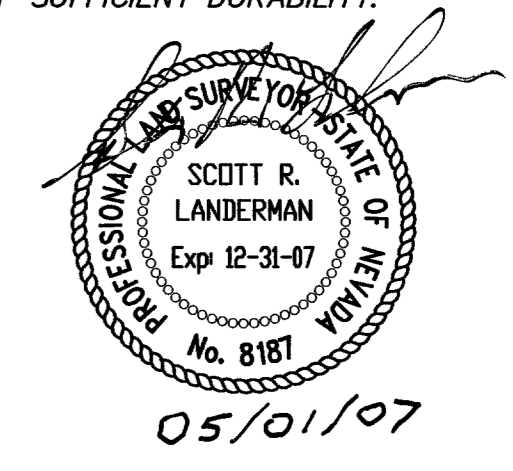

LEGEND

- LOCATION OF MONUMENT SET PER BOOK 108, PAGE 29 OF PLATS
- SET TYPE III MONUMENT, 2" ALCAP STAMPED PLS 8187
- FOUND TYPE III MONUMENT, 1-1/2" ALCAP STAMPED PLS 15977 (UNLESS OTHERWISE INDICATED)
- 10 LOT NUMBER
- 1 BLOCK NUMBER
- STREET CENTERLINE
- LOT LINE
- EXISTING PARCEL/LOT LINE

BASIS OF BEARINGS

NORTH 04°34'02" WEST, BEING THE BEARING OF THE CENTERLINE OF ENCORVADO STREET, AS SHOWN BY MAP THEREOF ON FILE IN BOOK 112, PAGE 54 OF PLATS IN THE CLARK COUNTY, NEVADA RECORDER'S OFFICE, LYING WITHIN SECTION 34, TOWNSHIP 20 SOUTH, RANGE 59 EAST, M.D.M., CITY OF LAS VEGAS, CLARK COUNTY, NEVADA.

CITY OF LAS VEGAS REFERENCE
FMP-2491 "GRANADA AT SUMMERLIN - UNIT 1" (BOOK 112, PAGE 54)

COUNTY RECORDER'S NOTE

ANY SUBSEQUENT CHANGES TO THIS MAP SHOULD BE EXAMINED AND MAY BE DETERMINED BY REFERENCE TO THE COUNTY RECORDER'S CUMULATIVE MAP INDEX. N.R.S. 278.5695

**MONUMENT TIE MAP
RECORD OF SURVEY**

FOR
**WILLIAM LYON HOMES, INC.,
A CALIFORNIA CORPORATION**

CENTERLINE AND REFERENCE MONUMENTS FOR "GRANADA AT SUMMERLIN - UNIT 1" (BOOK 112, PAGE 54 OF PLATS) LYING WITHIN SECTIONS 34, TOWNSHIP 20 SOUTH, RANGE 59 EAST, AND SECTION 03, TOWNSHIP 21 SOUTH, RANGE 59 EAST, M.D.M., CITY OF LAS VEGAS, CLARK COUNTY, NEVADA.

G.C. WALLACE, INC.
Engineers/Planners/Surveyors
6655 SOUTH CIMARRON ROAD, LAS VEGAS, NEVADA 89113

471.009
MONUMENT TIE MAP
GRANADA AT SUMMERLIN - UNIT 1

INSTRUMENT NO. _____
OFFICIAL RECORDS
BOOK NO. _____
FILED AT THE REQUEST OF
G.C. WALLACE INC.
DATE _____ AT _____
FILE _____ PAGE _____
OF SURVEYS
CLARK COUNTY, NEVADA RECORDS
CHARLES HARVEY, RECORDER
058-4765-1
FEE \$ _____ DEPUTY