


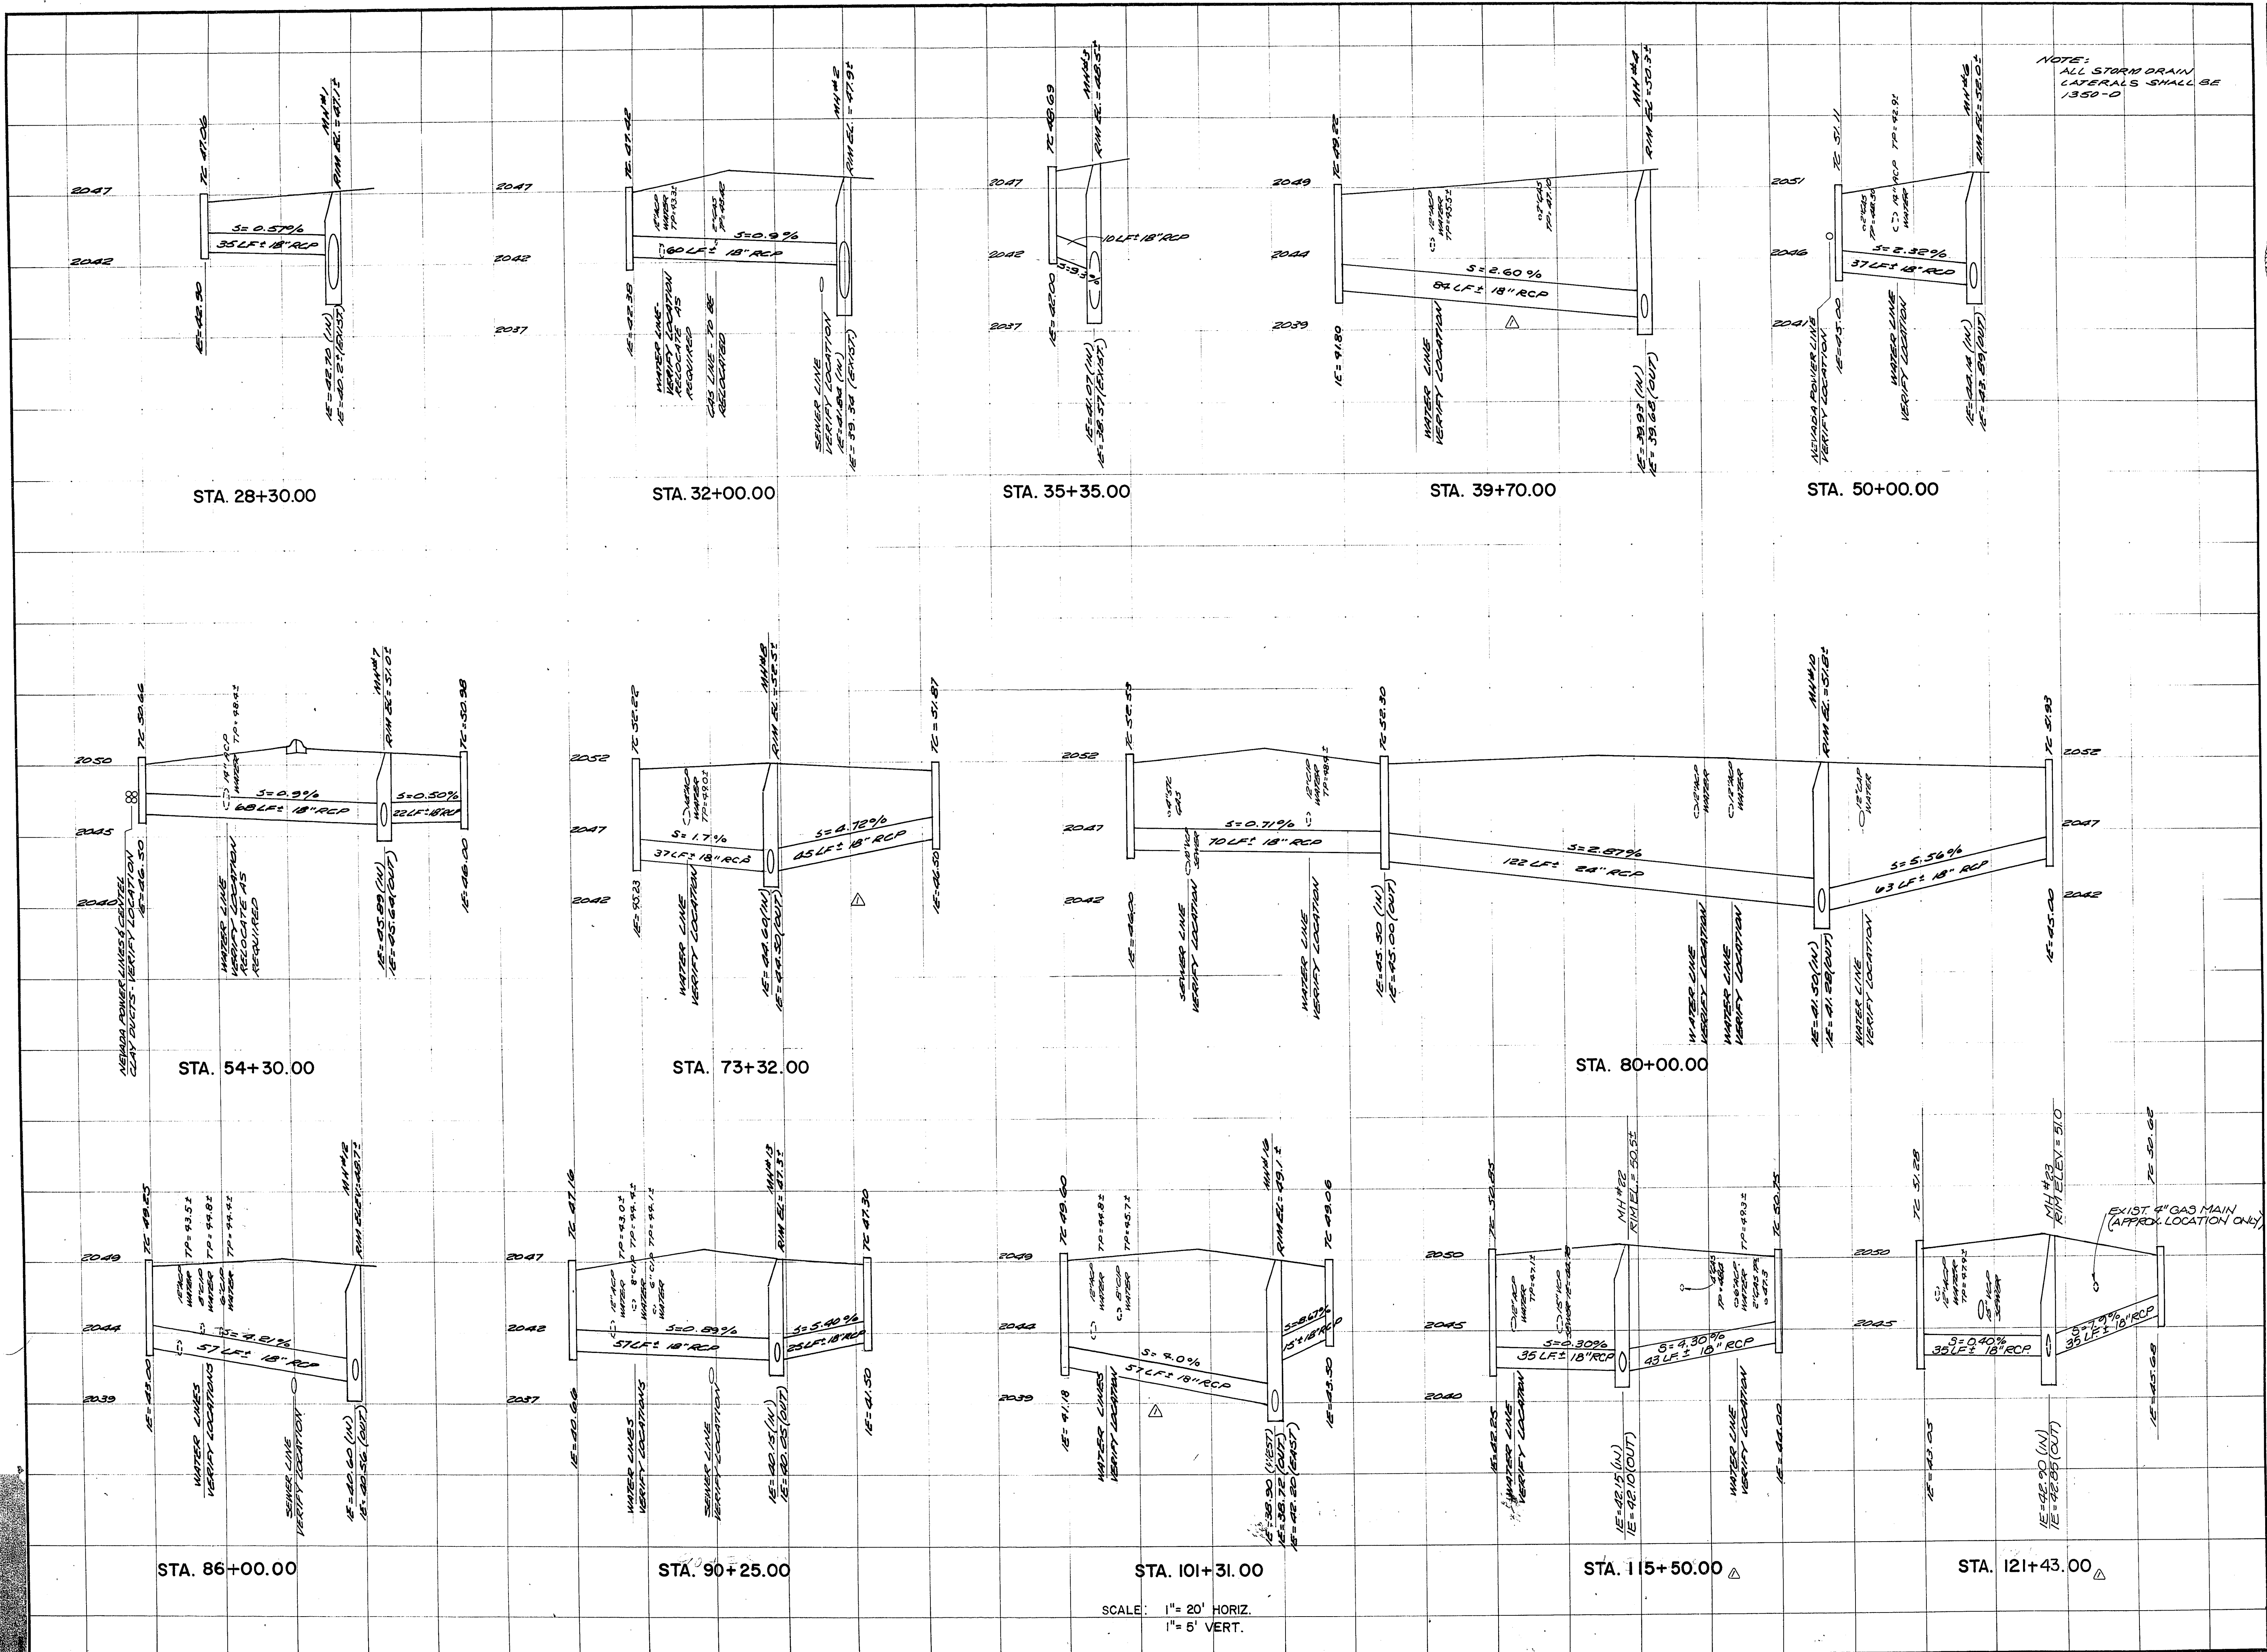

| REVISIONS |                  |
|-----------|------------------|
| NO.       | DESCRIPTION/DATE |
| 1         | REVISION 1/24/84 |

FRANK W. SMITH  
No. 00088  
STATE OF NEVADA  
1/24/84

**SPARKS, NEVADA**  
LAS VEGAS, NEVADA  
SEATTLE, WASHINGTON

**incorporated**  
**S&P**  
ENGINEERS/PLANNERS

CITY OF LAS VEGAS  
**HIGHLAND DRIVE**  
CHARLESTON BOULEVARD TO CAREY AVENUE

**STORM DRAIN LATERAL PROFILES**

|                        |
|------------------------|
| JOB NO. 2-0241-004-821 |
| DESIGNED DFP           |
| DRAWN TAM              |
| COMP.                  |
| CHECKED                |
| DATE DECEMBER, 1982    |

**44**

44 OF 75 SHEETS

19-1-169 107-V850A