


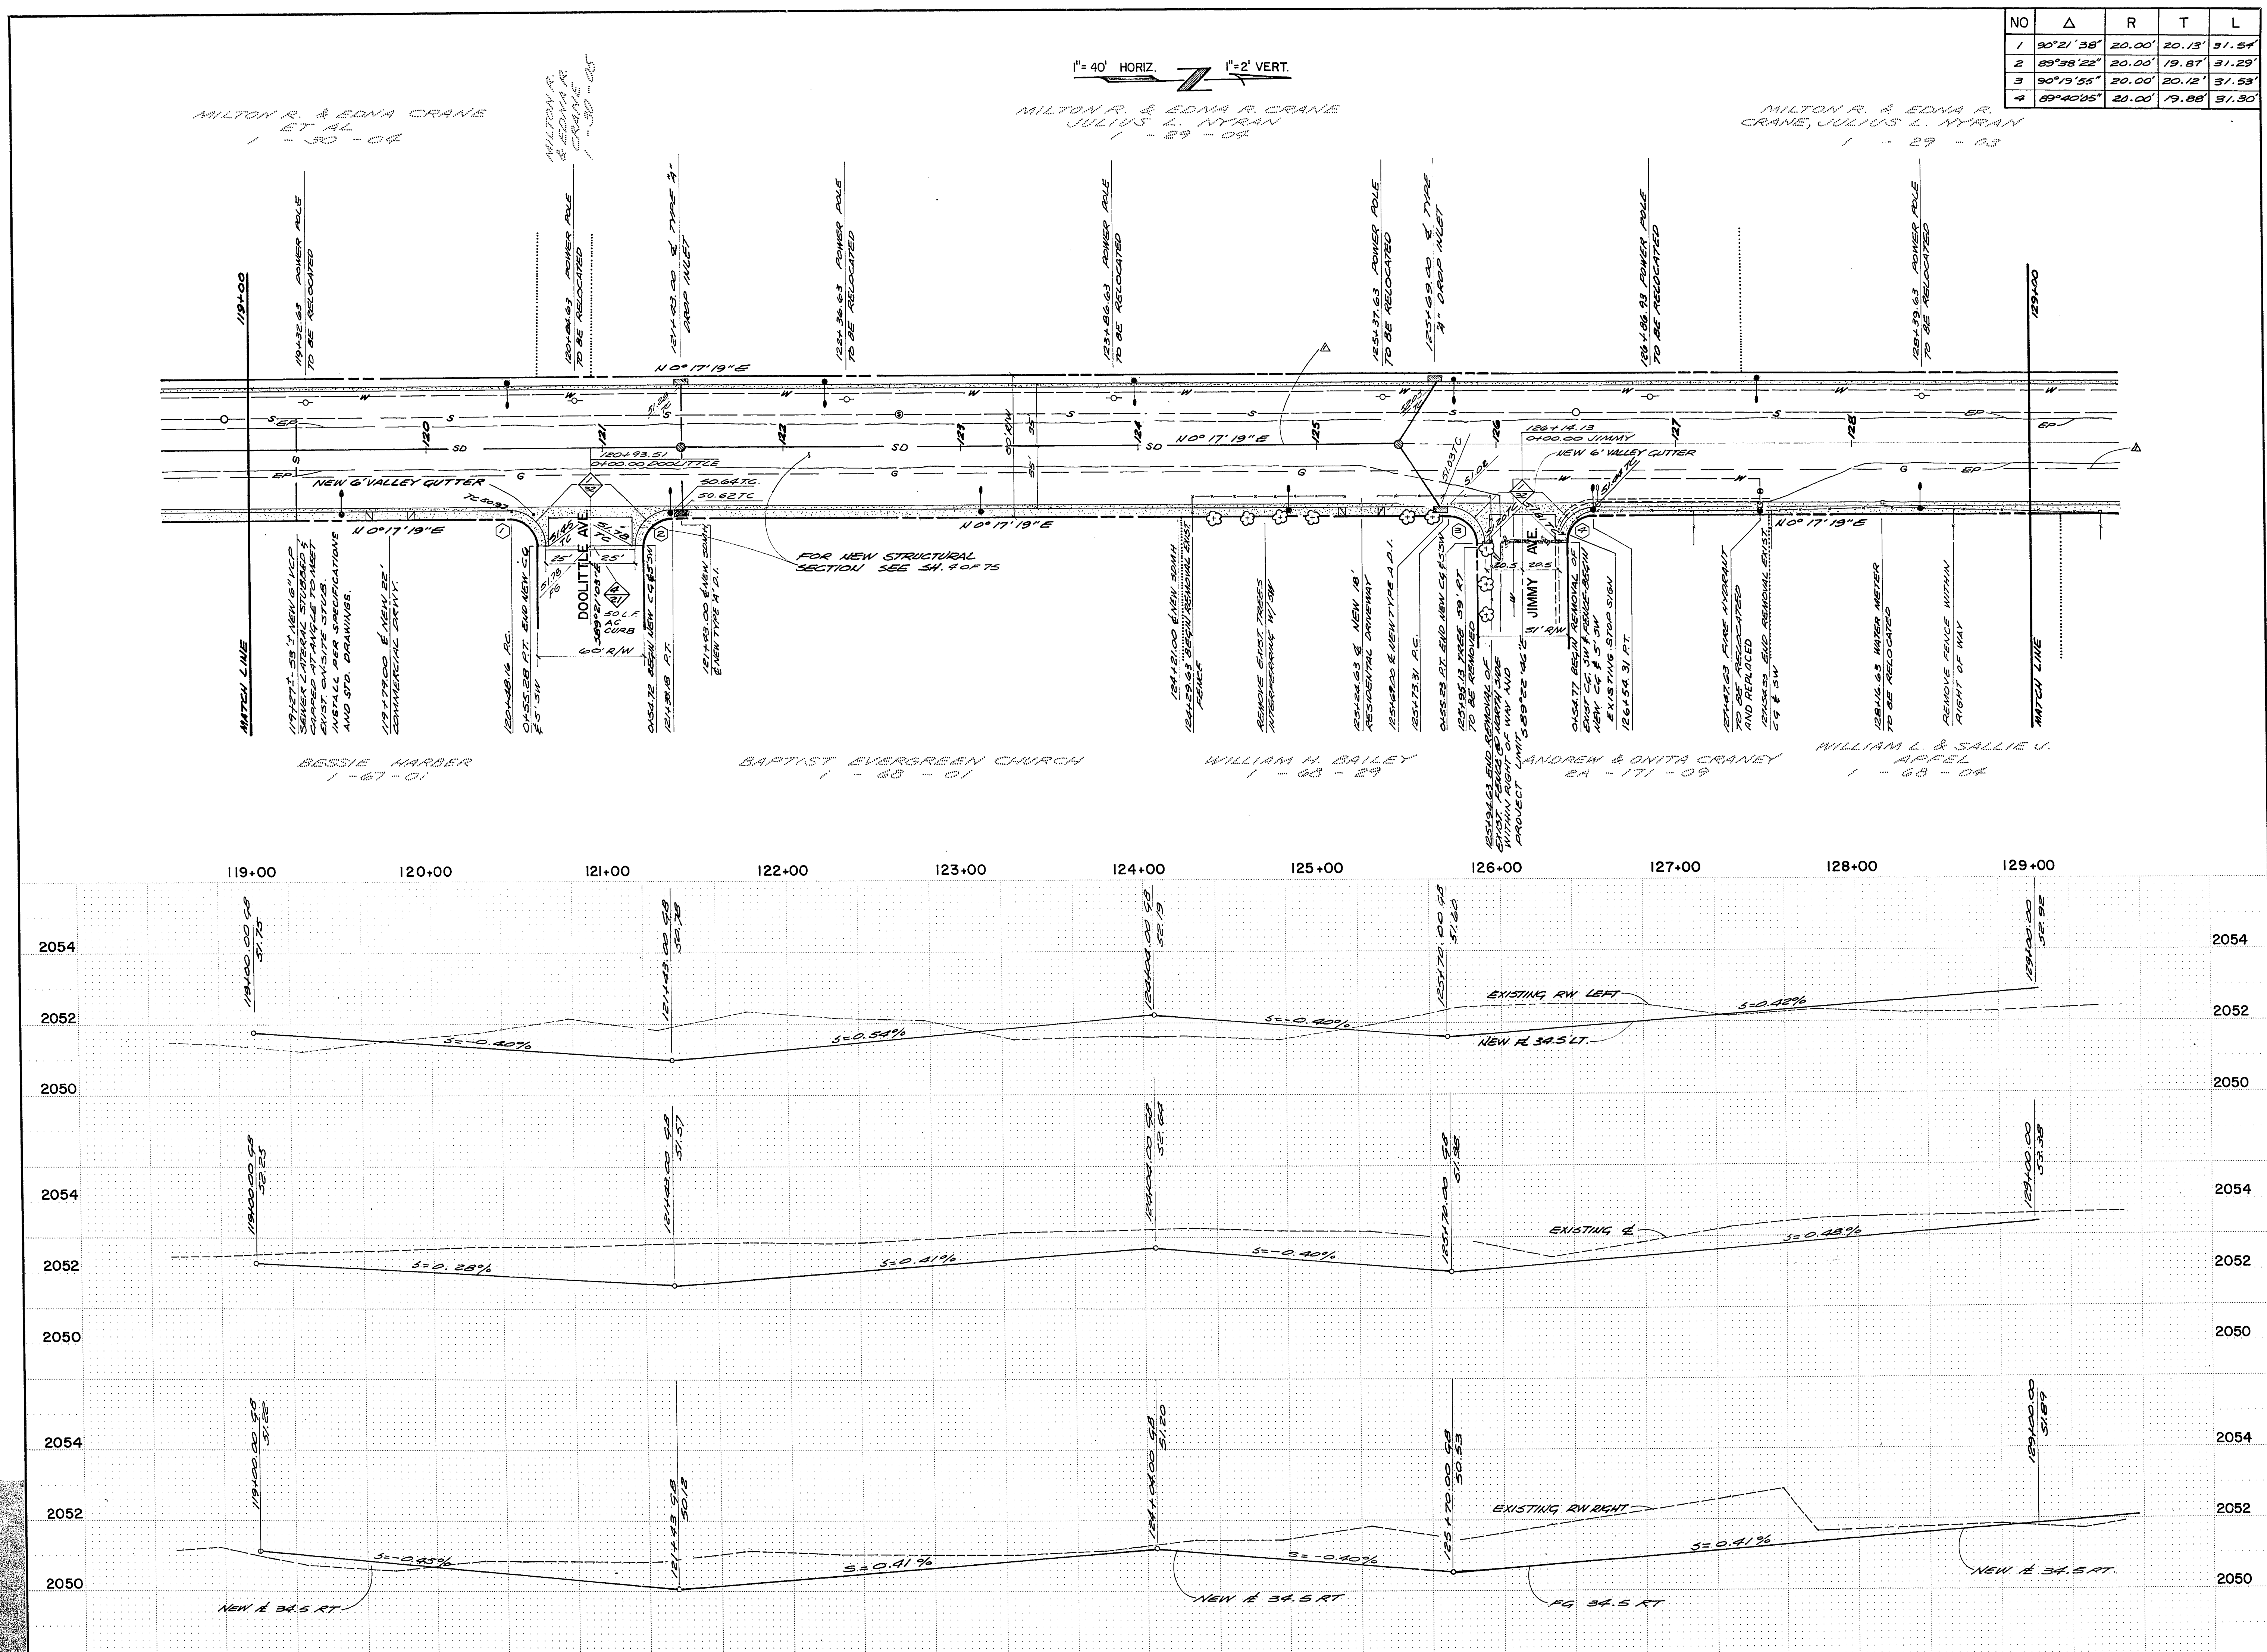

NO	Δ	R	T	L
1	90°21'38"	20.00'	20.13'	31.54'
2	89°58'22"	20.00'	19.87'	31.29'
3	90°19'55"	20.00'	20.12'	31.53'
4	89°40'05"	20.00'	19.88'	31.30'

REVISIONS

NO.	DESCRIPTION/DATE	BY
1	RELOCATE STORM 15" DRAINAGE BASE LINE	JL

PROFESSIONAL ENGINEER

SPARKS, NEVADA

LAS VEGAS, NEVADA

SEATTLE, WASHINGTON

INCORPORATED

ENGINEERS/PLANNERS

CITY OF LAS VEGAS

HIGHLAND DRIVE

CHARLESTON BOULEVARD TO CAREY AVENUE

PLAN AND PROFILE

119+00 TO 129+00

JOB NO. 2-0241-004-821

DESIGNED DFP

DRAWN TAM, PBW & SLE

COMP.

CHECKED

DATE DECEMBER, 1982

17

17 OF 75 SHEETS

107-1850A

MILTON R. & EDNA CRANE
ET AL
1 - 30 - 04

MILTON R. & EDNA R. CRANE
JULIUS L. NYRAN
1 - 29 - 08

MILTON R. & EDNA R. CRANE,
JULIUS L. NYRAN
1 - 29 - 03

BESSIE HARBER
1 - 67 - 01

BAPTIST EVERGREEN CHURCH
1 - 68 - 01

WILLIAM H. BAILEY
1 - 63 - 29

ANDREW & ONITA CRANEY
2A - 171 - 09

WILLIAM L. & SALLIE V. APPEL
1 - 59 - 04