
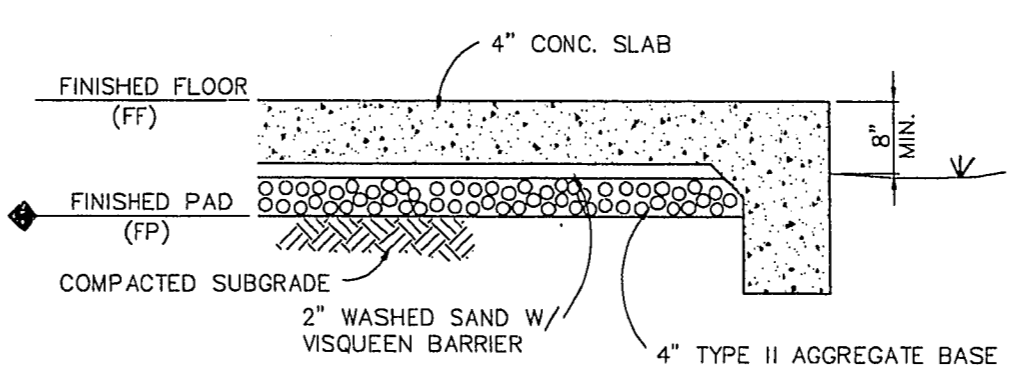


Call before you Dig
1-800-227-2600

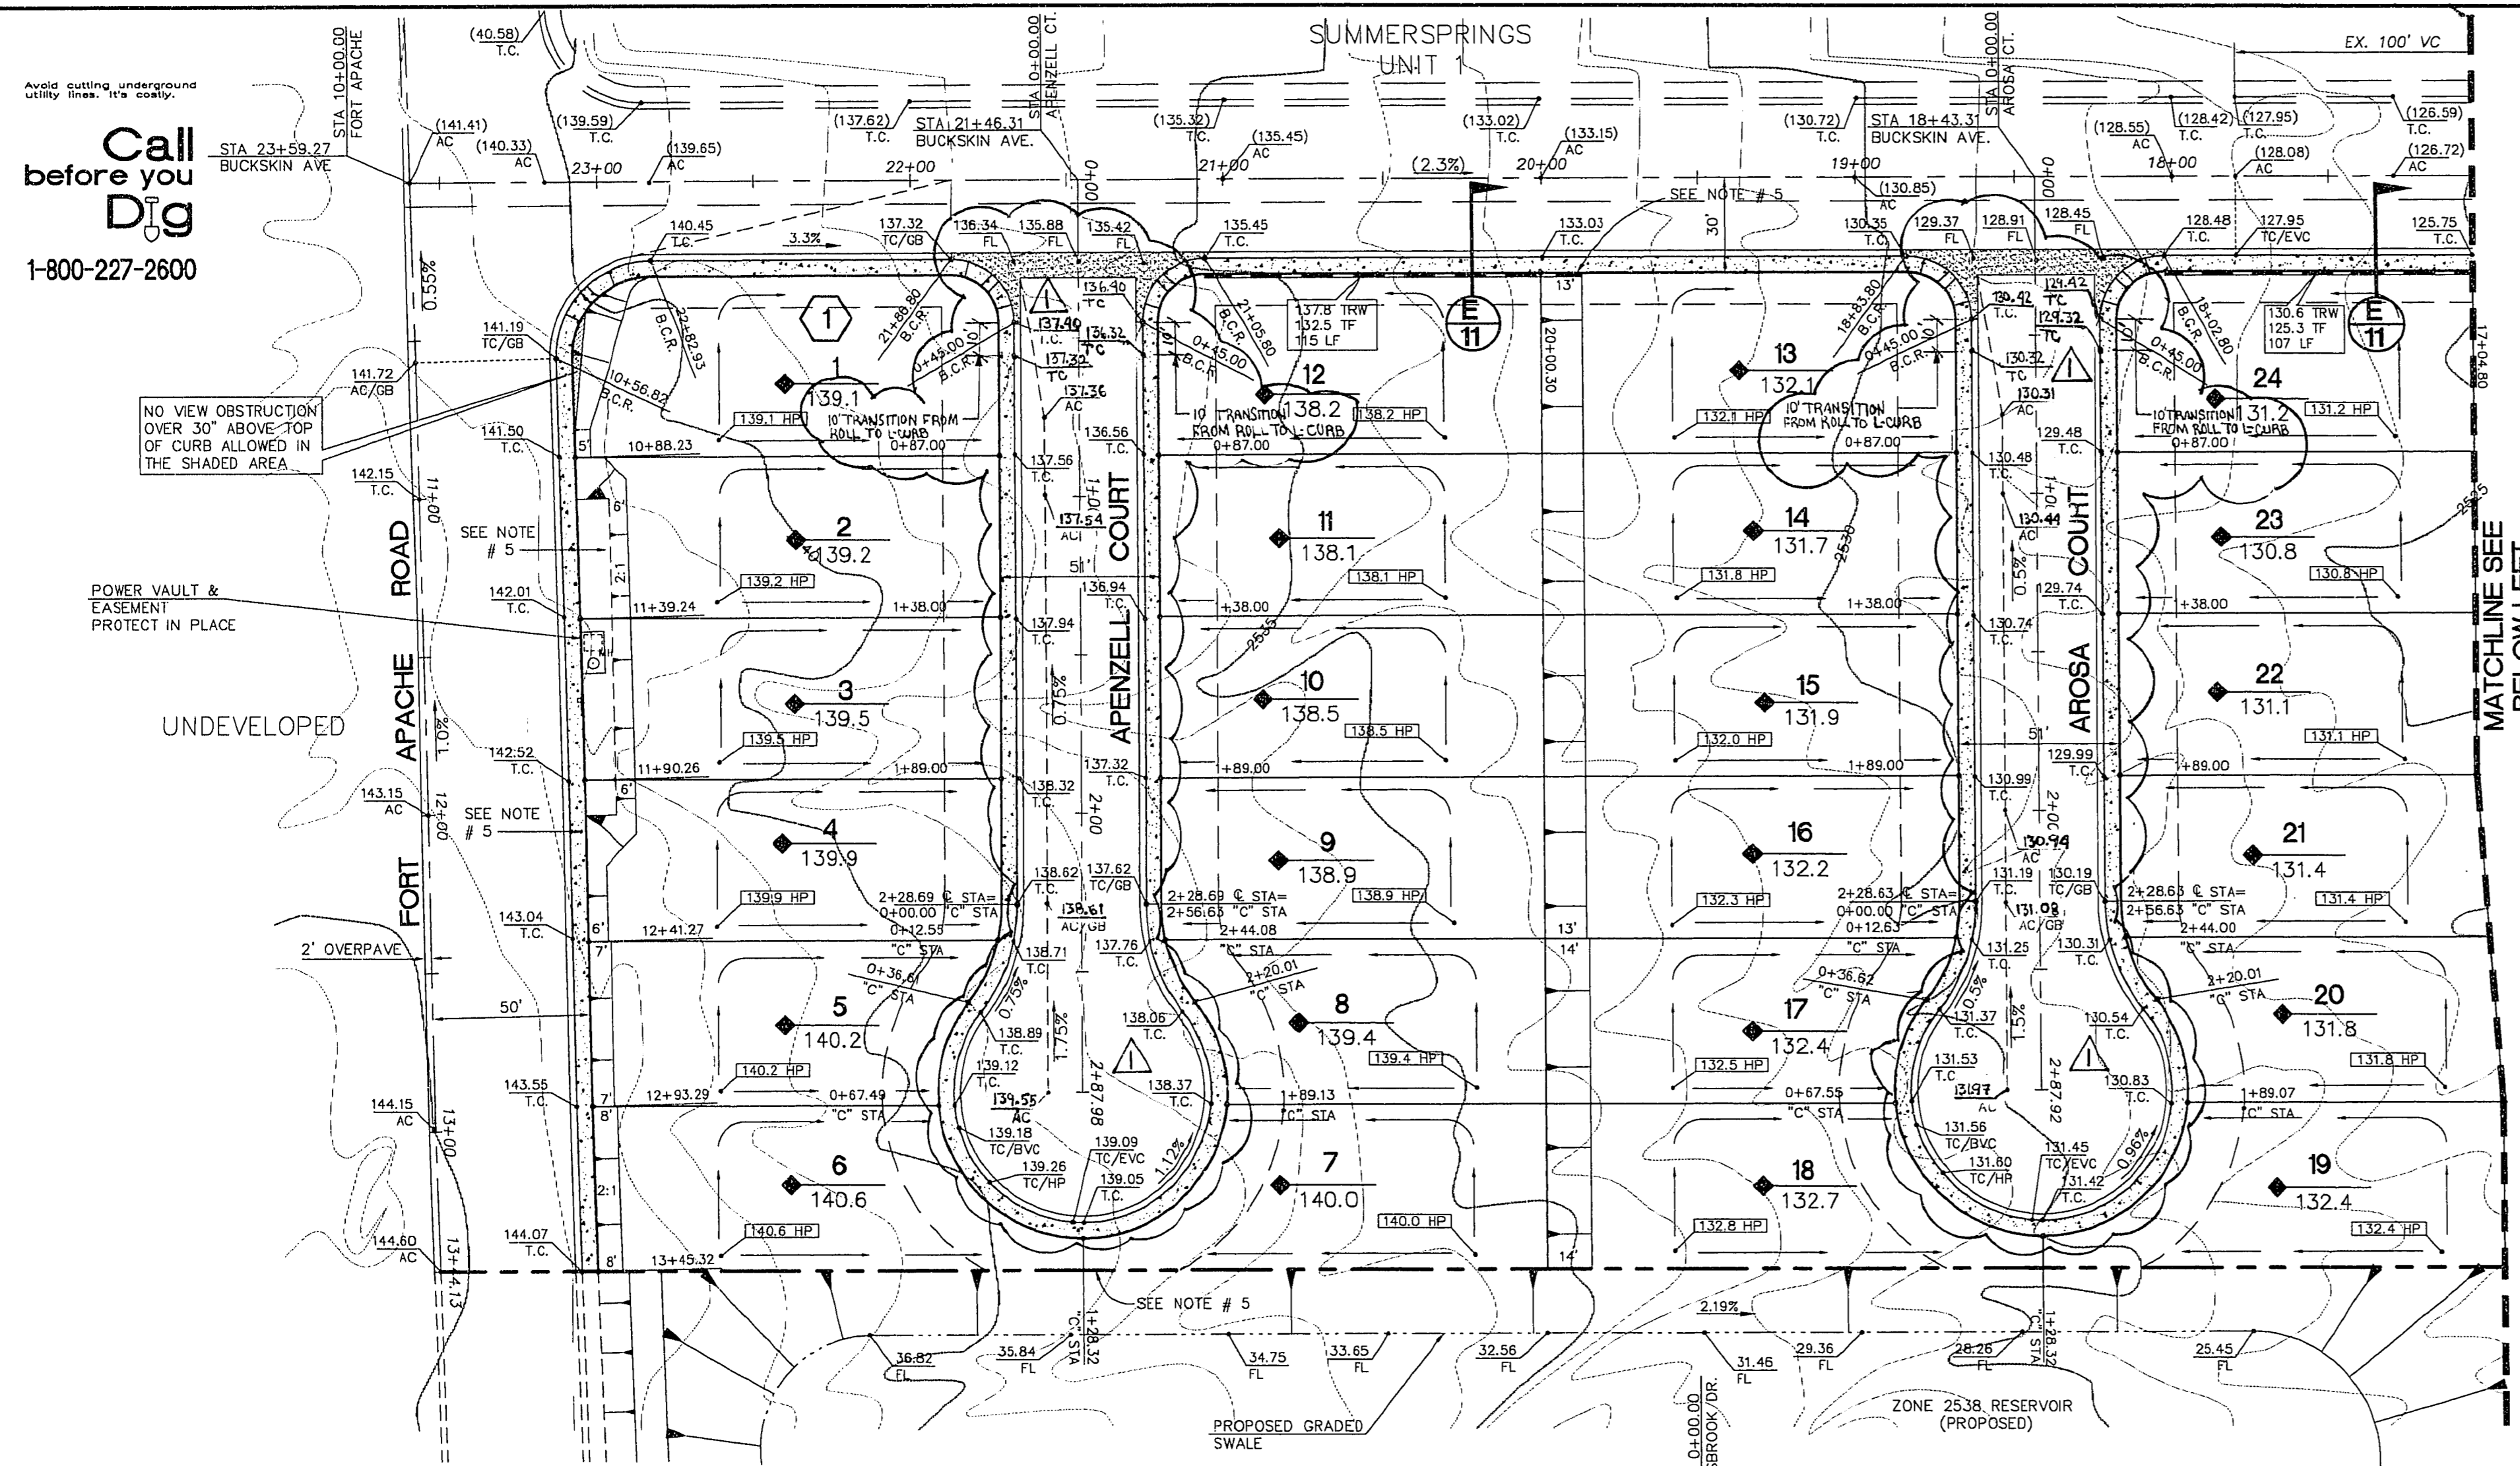


NOTE: THE FLOOR SECTION SHALL COMPLY WITH THE SOILS REPORT.
TYPICAL FLOOR SECTION
N.T.S.

BENCHMARK
OLV00 17NES
RIVET IN PLATE IN TOP OF CURB,
SW RETURN CHEYENNE AVE.
AND RAMPART BLVD.
ELEVATION = 2448.333


LEGEND

- EXISTING CONTOUR
- RETAINING WALL
- 14 LOT #
- 79.4 PAD ELEV
- 1 BLOCK NUMBER
- 00.00 ELEVATION DESCRIPTION
- 1.0% PERCENTAGE AND DIRECTION OF SLOPE

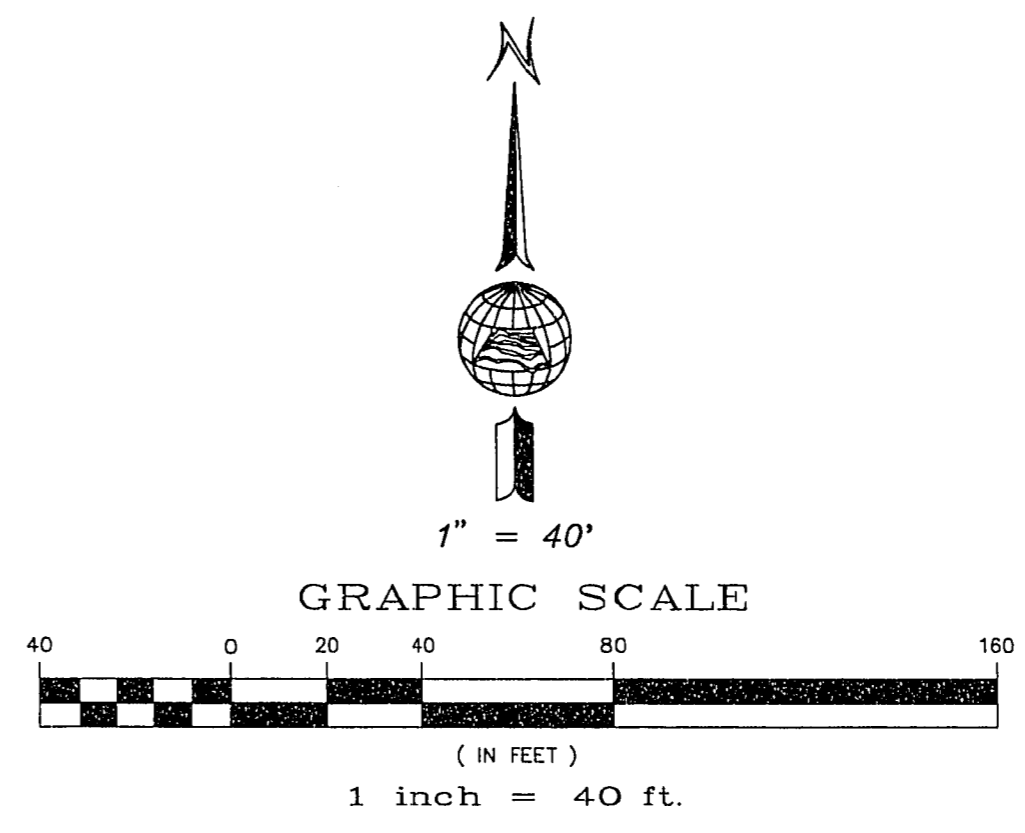


GENERAL NOTES



- ADD 2400' TO PLAN VIEW ELEVATIONS.
- ALL STATIONING IS CENTERLINE STATIONING UNLESS OTHERWISE NOTED.
- "C" STA INDICATES CUL-DE-SAC STATIONING AT BACK OF CURB.
- SEE SOILS REPORT FOR ADDITIONAL INFORMATION.
- CONSTRUCT A SIX FOOT HIGH MASONRY WALL ALONG ALL PROPERTY LINES WHERE HOMES DO NOT FRONT THE EXTERIOR STREETS AS REQUIRED BY THE DEPARTMENT OF COMMUNITY PLANNING AND DEVELOPMENT. THE WALL ALONG FORT APACHE ROAD SHALL BE DECORATIVE.

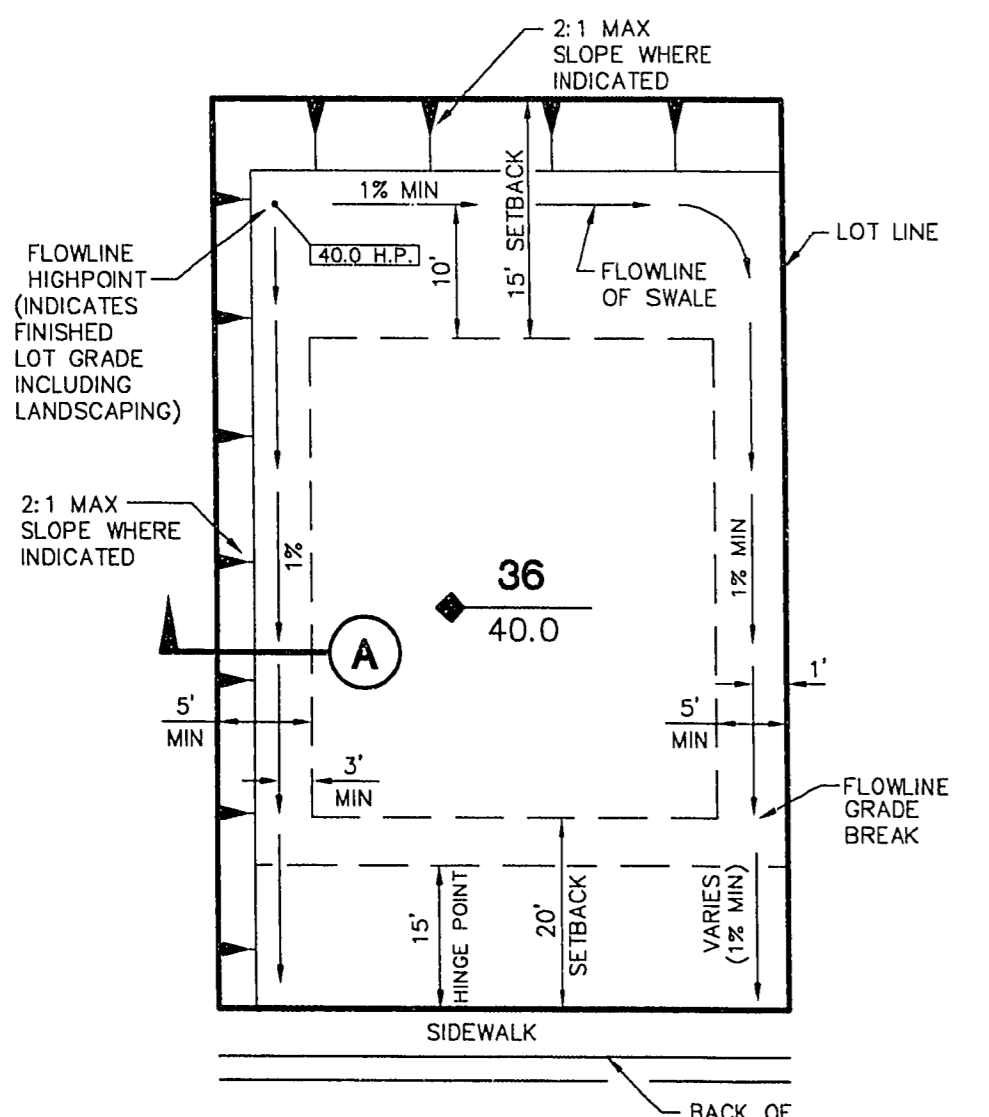

TYPICAL LOT GRADING SCHEMATIC
N.T.S.

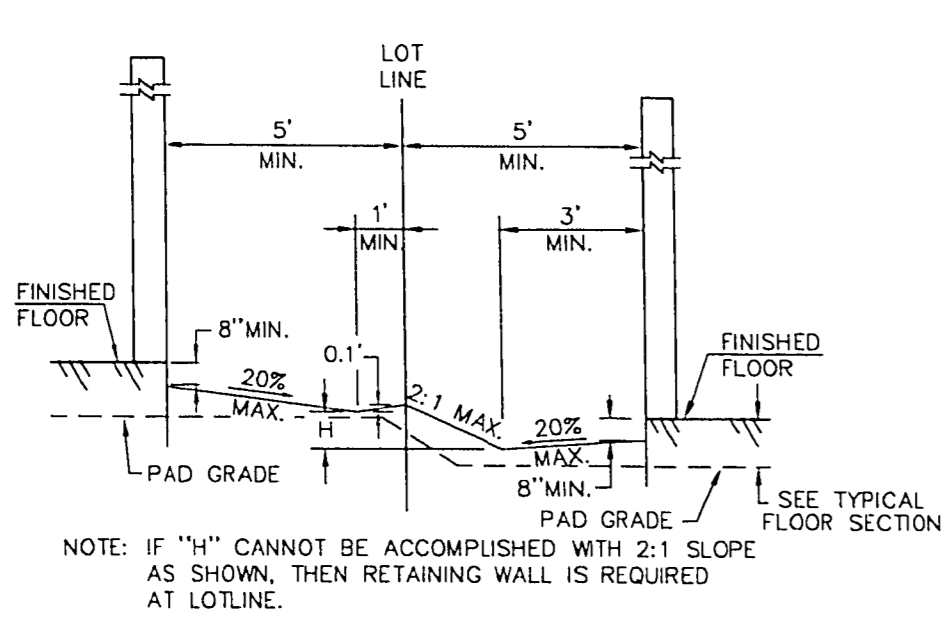

SECTION A
Not to scale

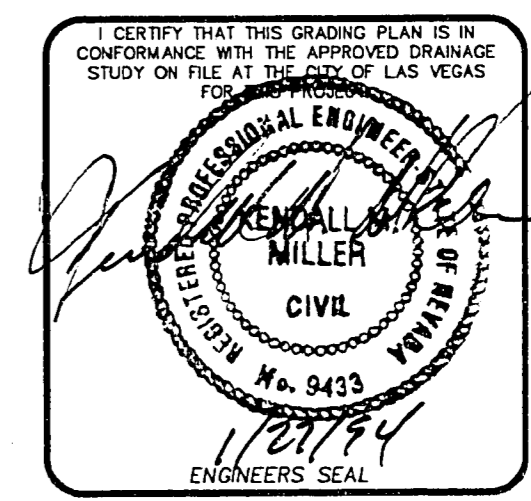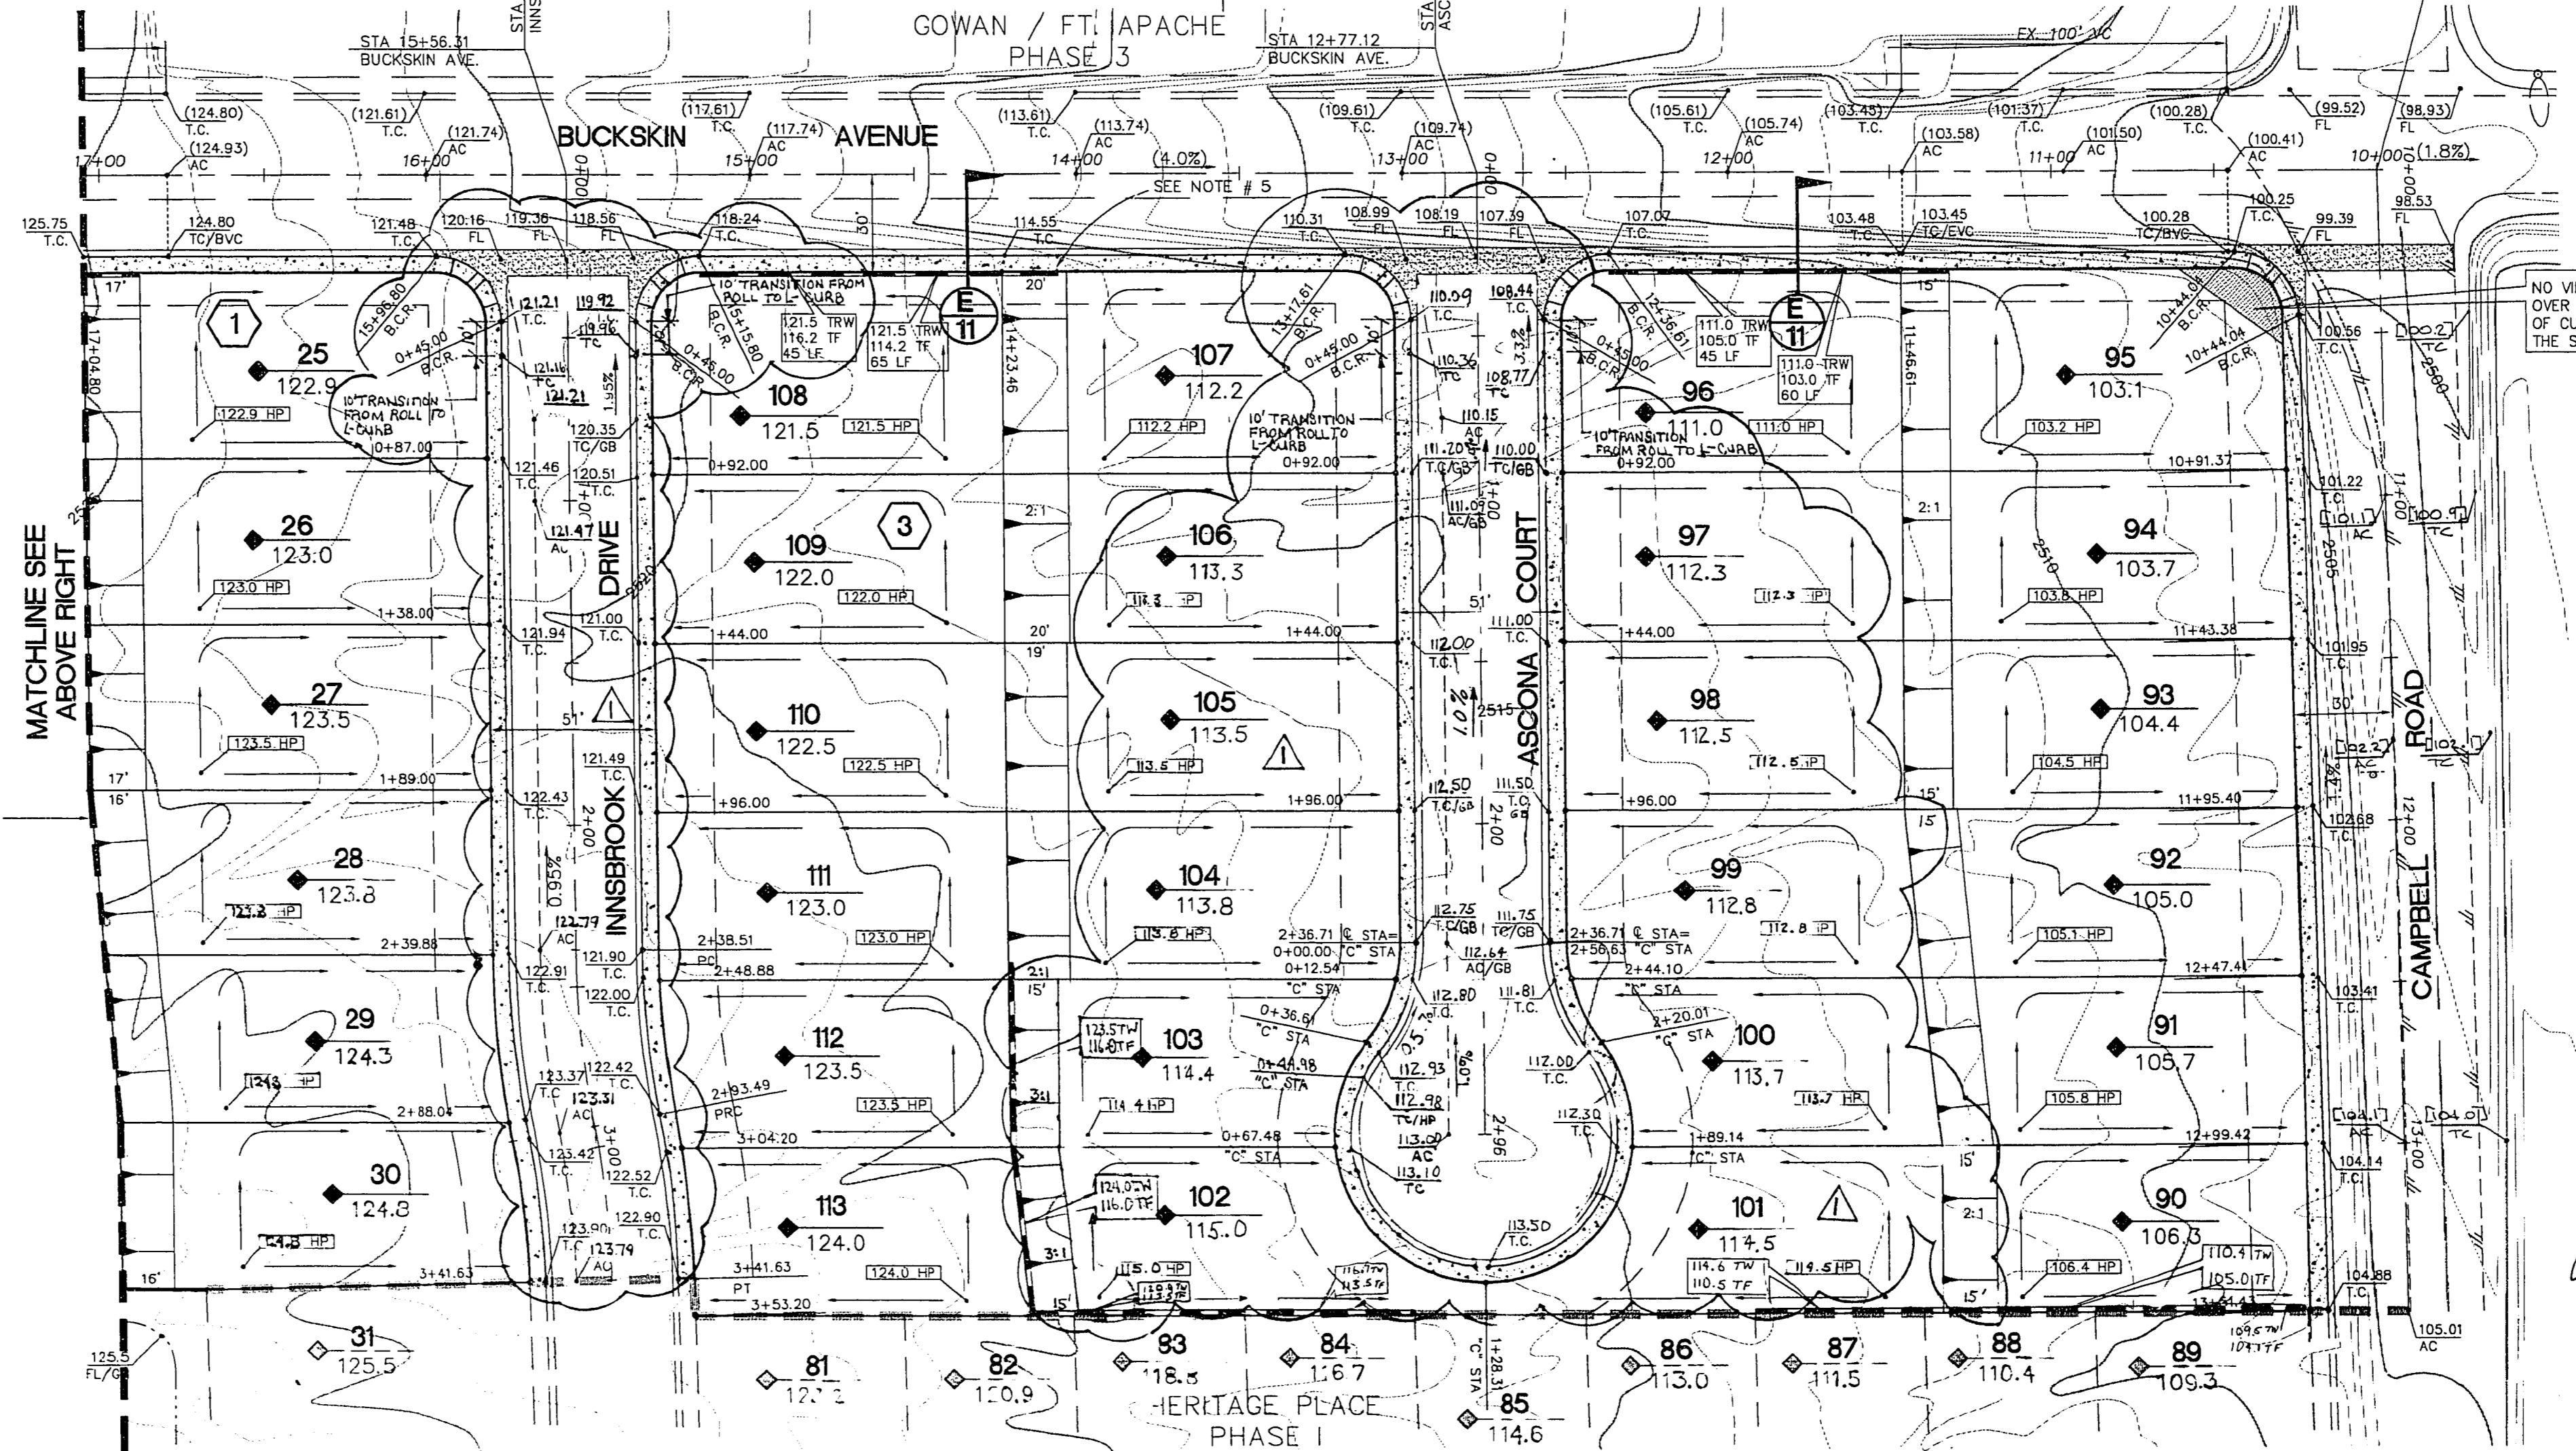

Job Number	7214-573	Scale	1" = 40'
Checked by	MM	Drawn by	MM
Date	NOV. 30, 1993	Plot No.	573IMP
Sheet Number	4 OF 11	PHASE II	GRADING PLAN
DATE	NOV. 30, 1993	PHASE I	GRADING PLAN
REVISIONS	No.	Date	Appr.
REVISIONS	No.	Date	Appr.

C:\LMS\5231321-04 The Jan 27 15:30:00 1994 Church Engineering - Steve

11-10-1-10

1077-4303-1