


PRIVATE FLOOD CONTROL IMPROVEMENTS:

PRIVATE FLOOD CONTROL IMPROVEMENT	QUANTITY
20-FOOT DRAINAGE EASEMENT	178 S.F.
1 COURSE SOLID GROUTED WALL	993 L.F.

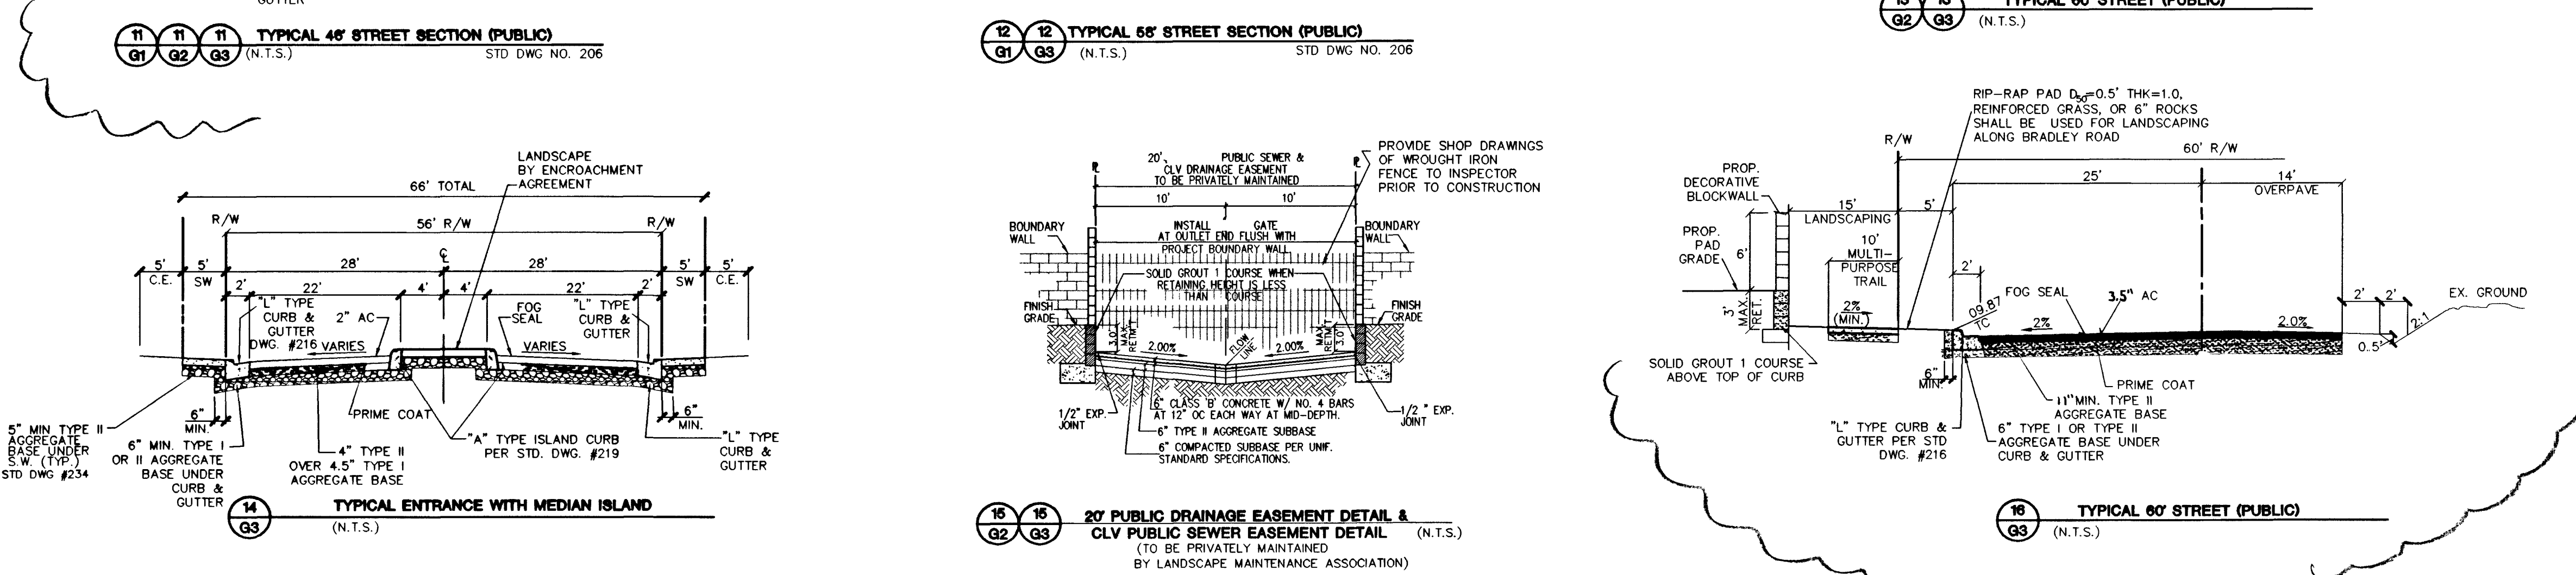

CITY OF LAS VEGAS		2727 SOUTH RAINBOW BOULEVARD LAS VEGAS, NEVADA 89146-5148 PH. (702) 873-7550 FAX (702) 362-2597	
KB HOME		750 PILOT ROAD, SUITE F LAS VEGAS, NV 89119 (702) 614-2500	
GRADING DETAILS AND STREET SECTION		IRON MOUNTAIN RANCH VILLAGE 10 UNIT 1	
DRAWN BY: R.M.S.	MARCH '03	CHECKED BY: KFN	MARCH '03
DESIGNED BY: R.M.S.	MARCH '03	PROJECT NO: 5978-1	SCALE: NA
		SHEET G4 11 OF 25 SHEETS DRAWING NO. 1074-4604-16-1	

50508 54/46