




1 1 BLOCK WALL SECTION DETAIL
(N.T.S.)

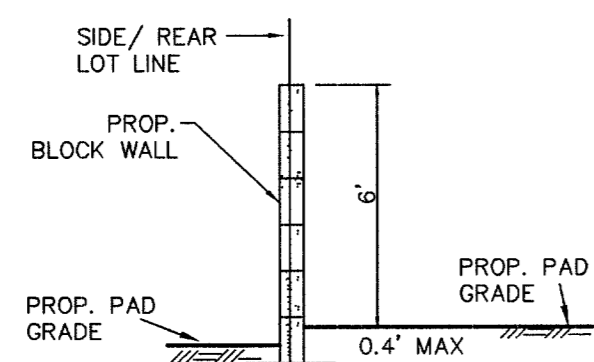


2 2 BLOCK WALL SECTION DETAIL
(N.T.S.)

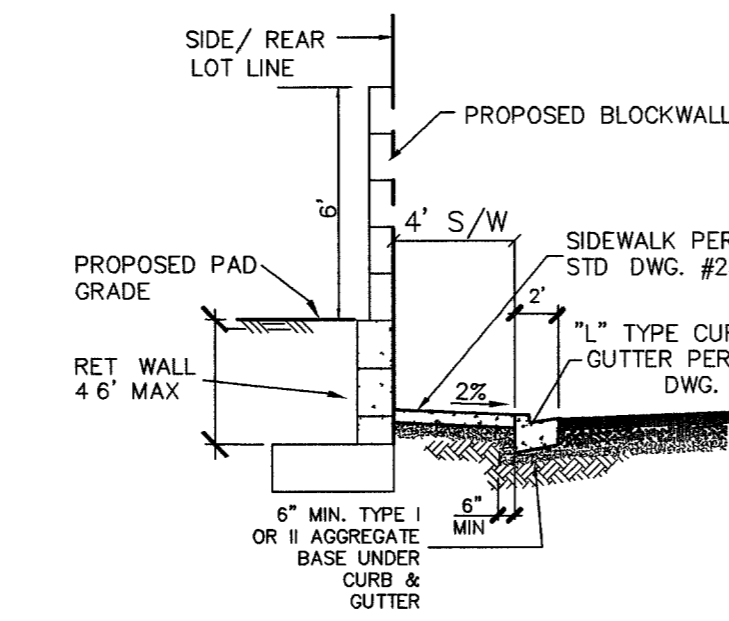


3 3 RETAINING WALL SECTION DETAIL
(N.T.S.)

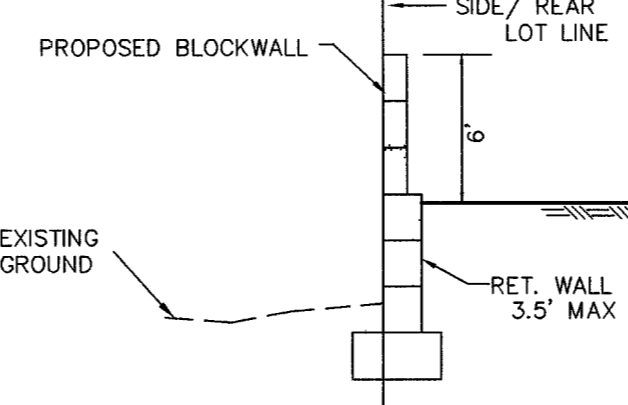


4 4 BLOCK WALL SECTION DETAIL
(N.T.S.)

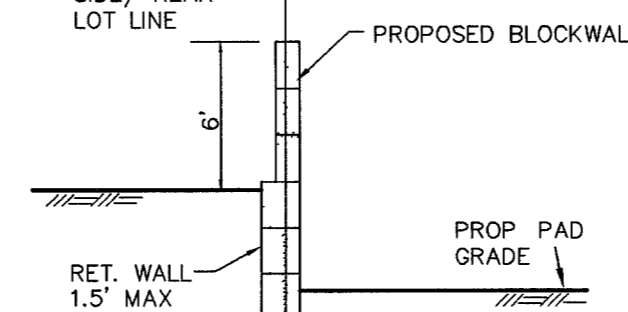


5 5 BLOCK WALL SECTION DETAIL
(N.T.S.)

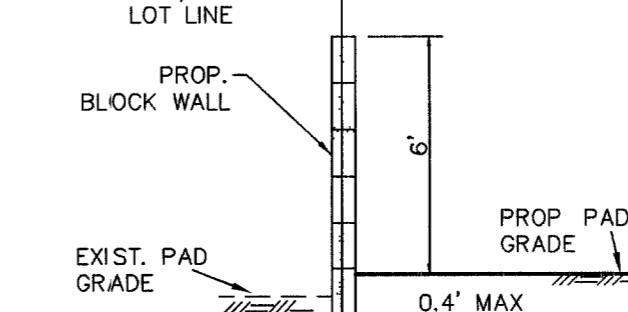


6 6 BLOCK WALL SECTION DETAIL
(N.T.S.)

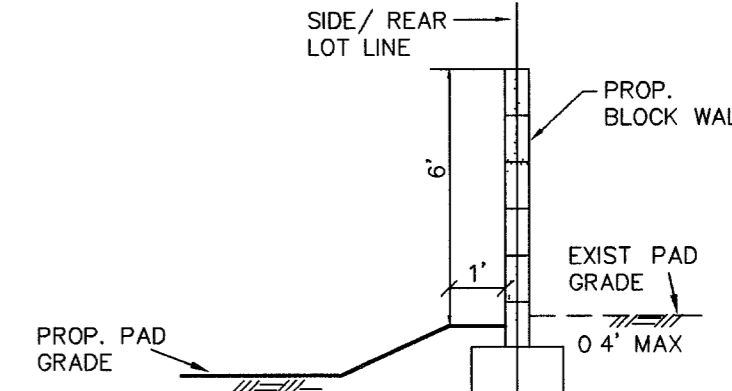


7 7 BLOCK WALL SECTION DETAIL
(N.T.S.)

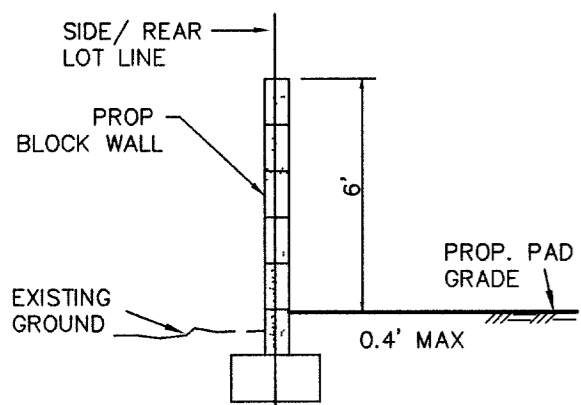


8 8 BLOCK WALL SECTION DETAIL
(N.T.S.)

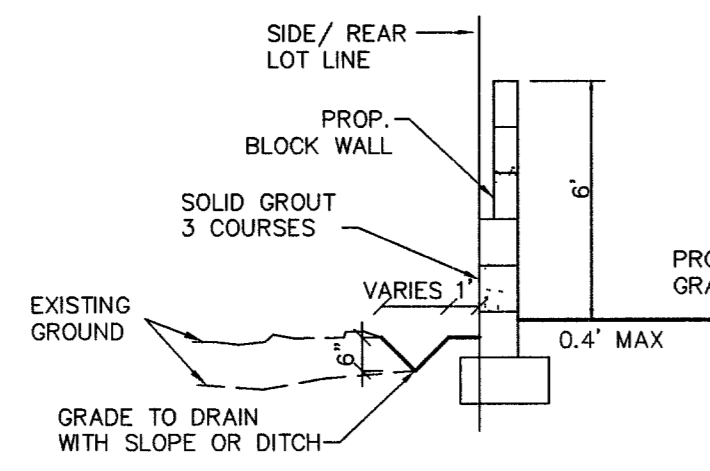


9 9 BLOCK WALL SECTION DETAIL
(N.T.S.)

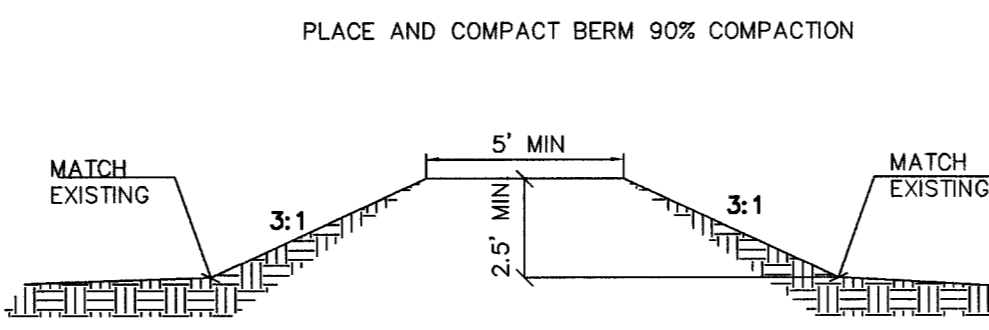


10 10 BERM SECTION
(N.T.S.)

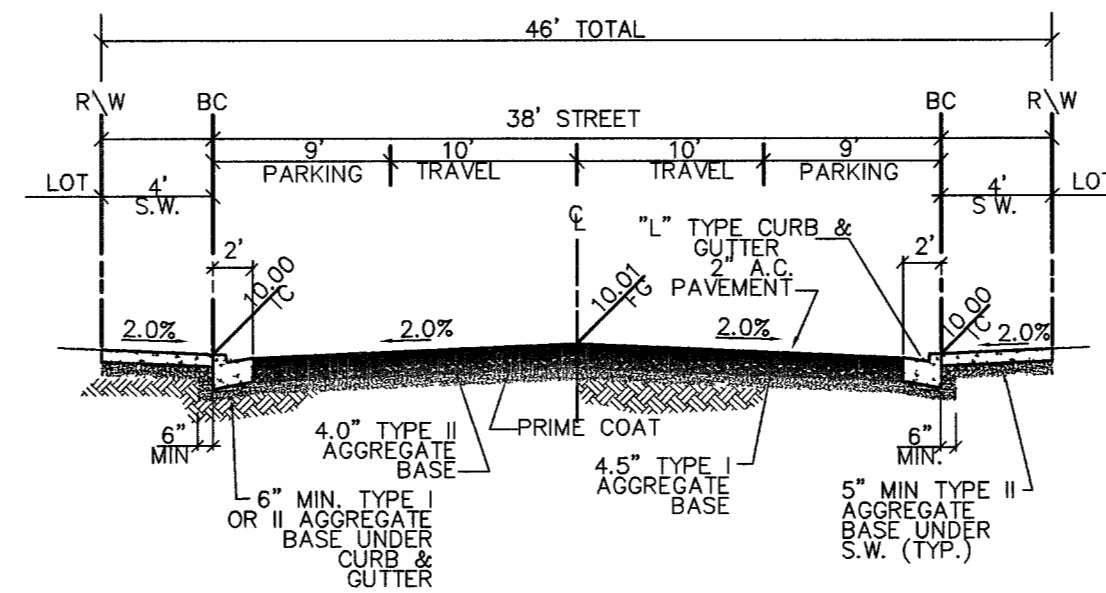


11 11 TYPICAL 46' STREET SECTION (PUBLIC)
(N.T.S.)

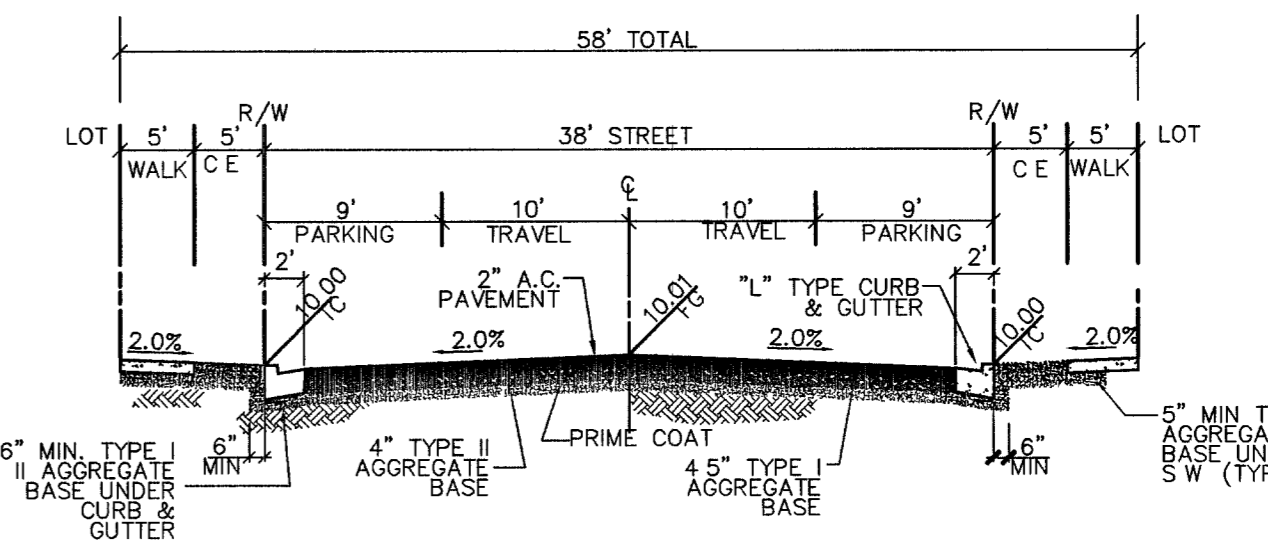


12 12 TYPICAL 68' STREET SECTION (PUBLIC)
(N.T.S.)

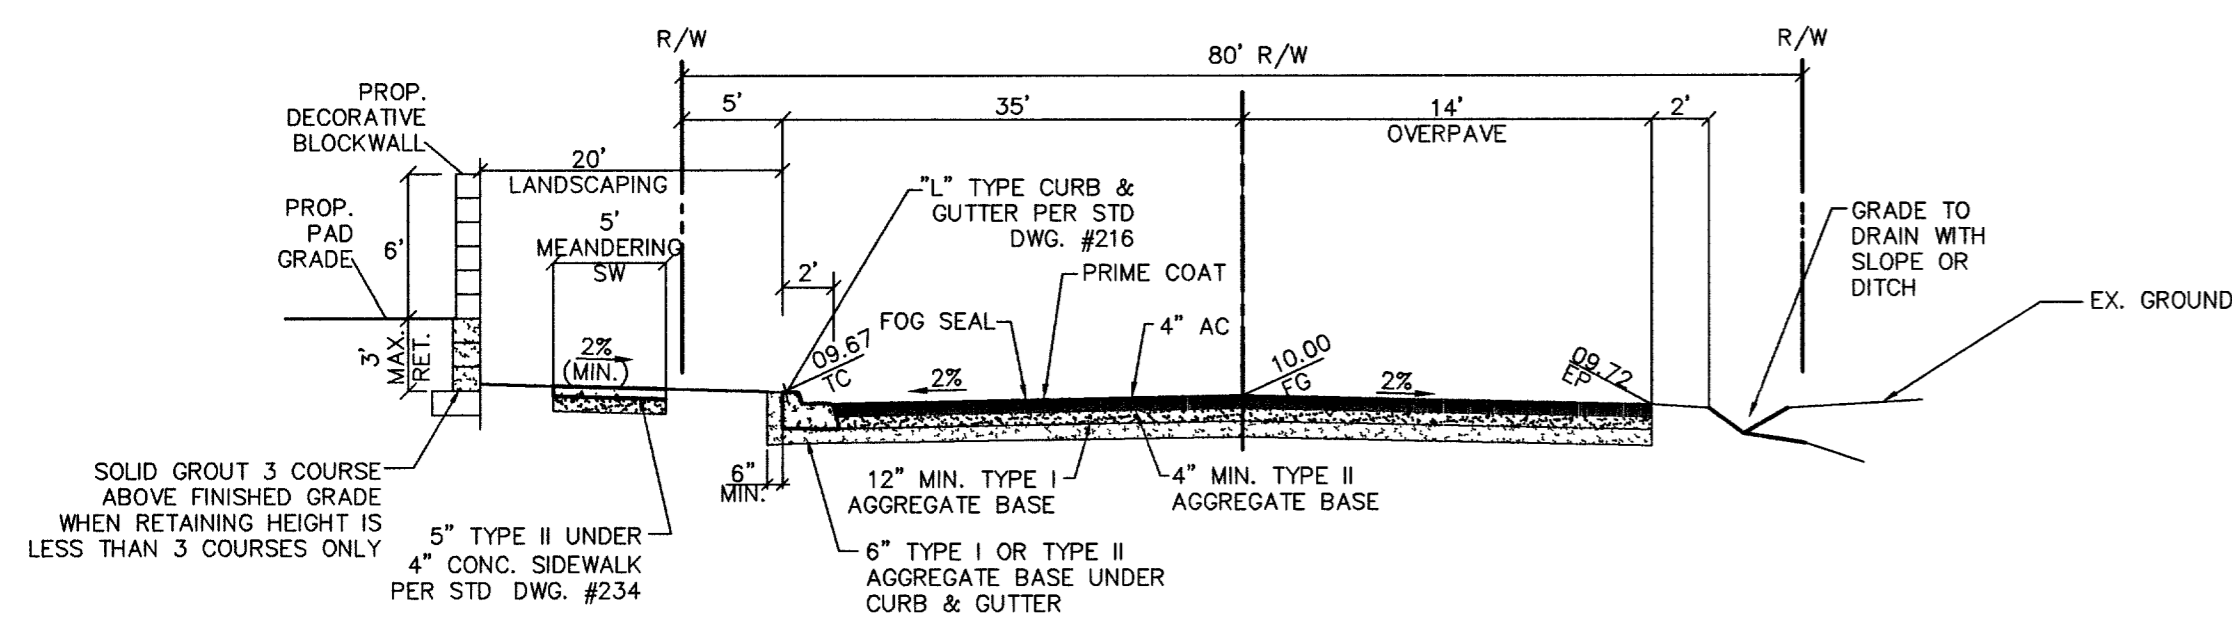


13 13 TYPICAL 80' HALF STREET (PUBLIC)
(N.T.S.)

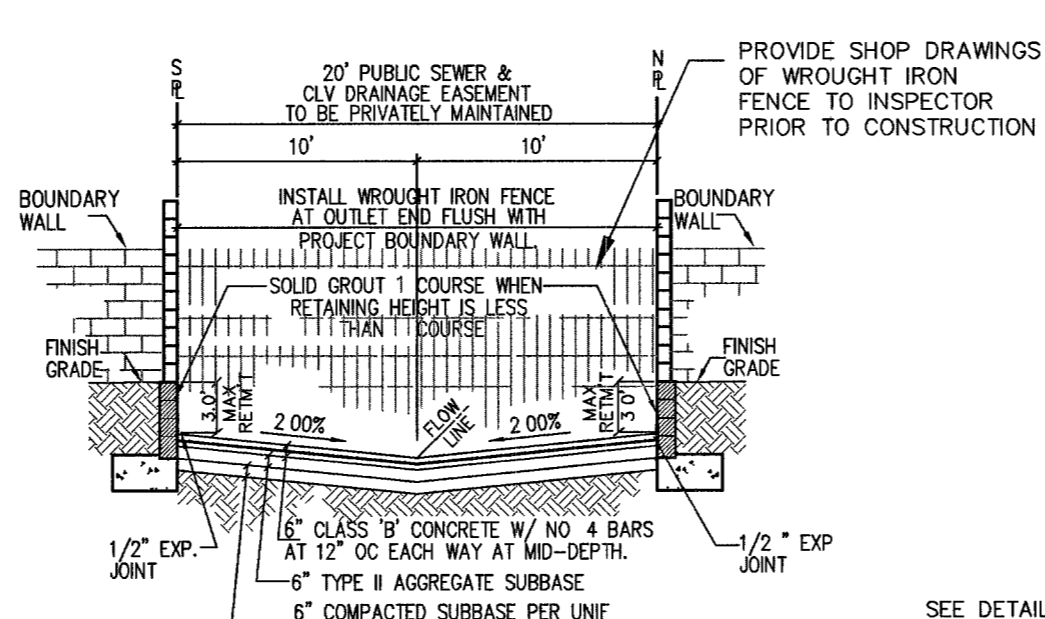


14 14 20' PUBLIC DRAINAGE EASEMENT DETAIL & CLV PUBLIC SEWER EASEMENT DETAIL
(TO BE PRIVATELY MAINTAINED) (N.T.S.)

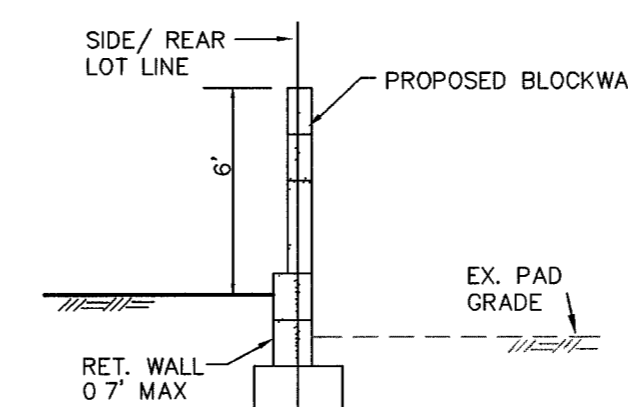

15 15 BLOCK WALL SECTION DETAIL
(N.T.S.)

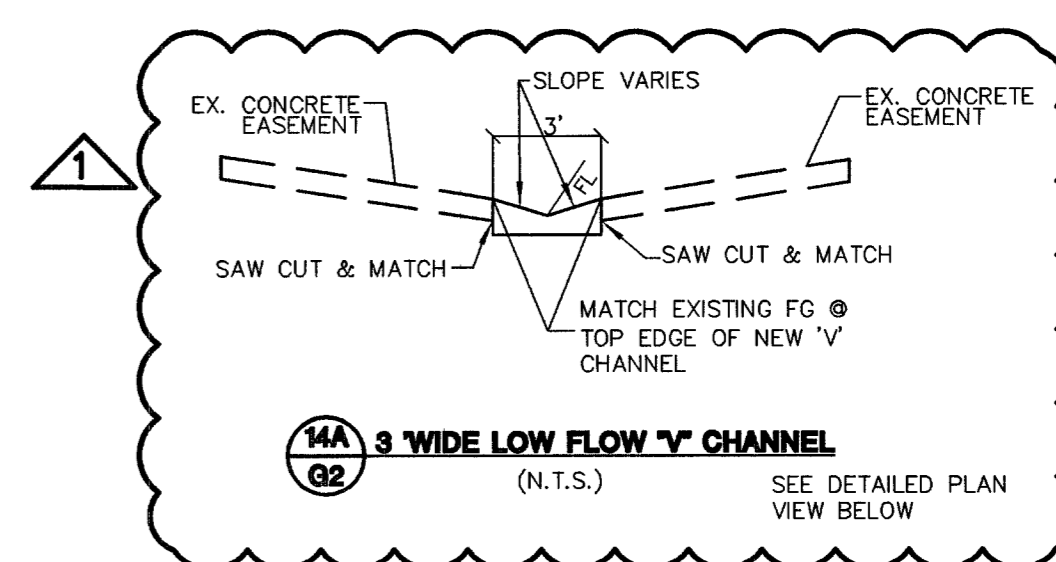

(N.T.S.)

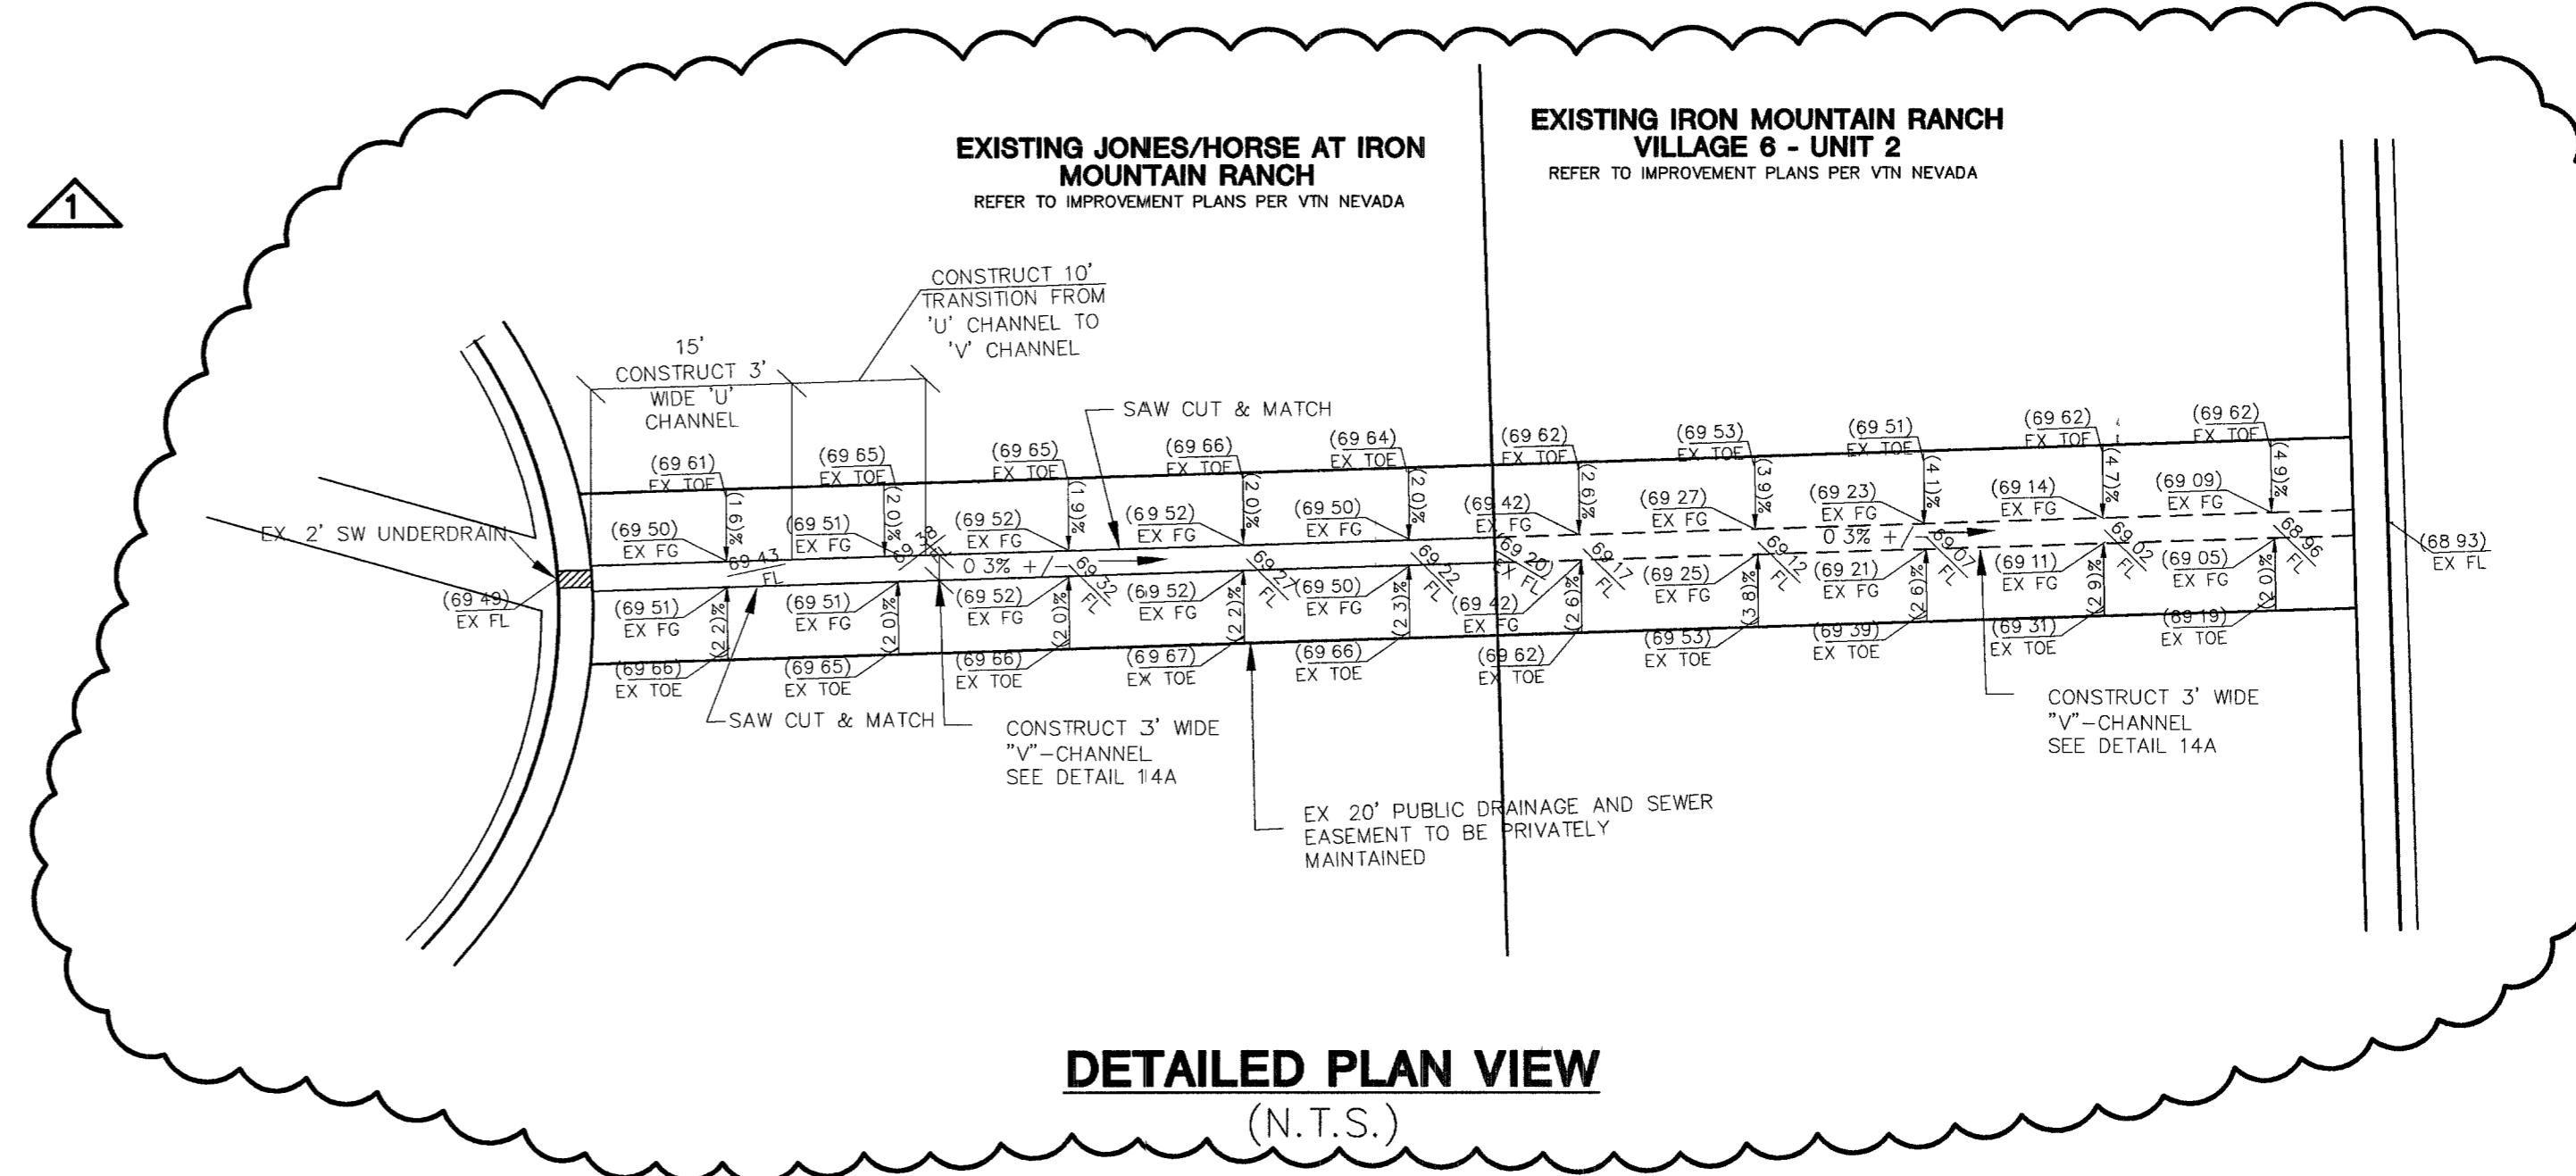

DETAILED PLAN VIEW
(N.T.S.)

93216

7	8	9	10	11	12	13	14	15	16	17	18	19	20	21	22	23	24	25	
CITY OF LAS VEGAS										2727 SOUTH RAINBOW BOULEVARD LAS VEGAS, NEVADA 89146-5148 PH. (702) 873-7550 FAX (702) 382-2587					REVISION				
KB HOME										750 PILOT ROAD, SUITE F LAS VEGAS, NV 89119 (702) 614-2500					S.B. REV. DATE BY				
DETAIL SHEET										IRON MOUNTAIN RANCH VILLAGE 6 UNIT 2					PLANNERS • LAND SURVEYORS				
DRAWN BY: R.M.S.										DESIGNED BY: R.M.S.					CHECKED BY: KEN				
JAN. '02										JAN. '02					JAN. '02				
PROJECT NO: 5874-2										SCALE: 1"=40' HORIZ. 1"=10' VERT.					NA				
PROFESSIONAL ENGINEER										KENNETH W. NICHOLSON					CIVIL				
EXPIRES 12-31-07										SHEET 10 OF 25 SHEETS					DRAWING NO. 107Y4604-6-2				