


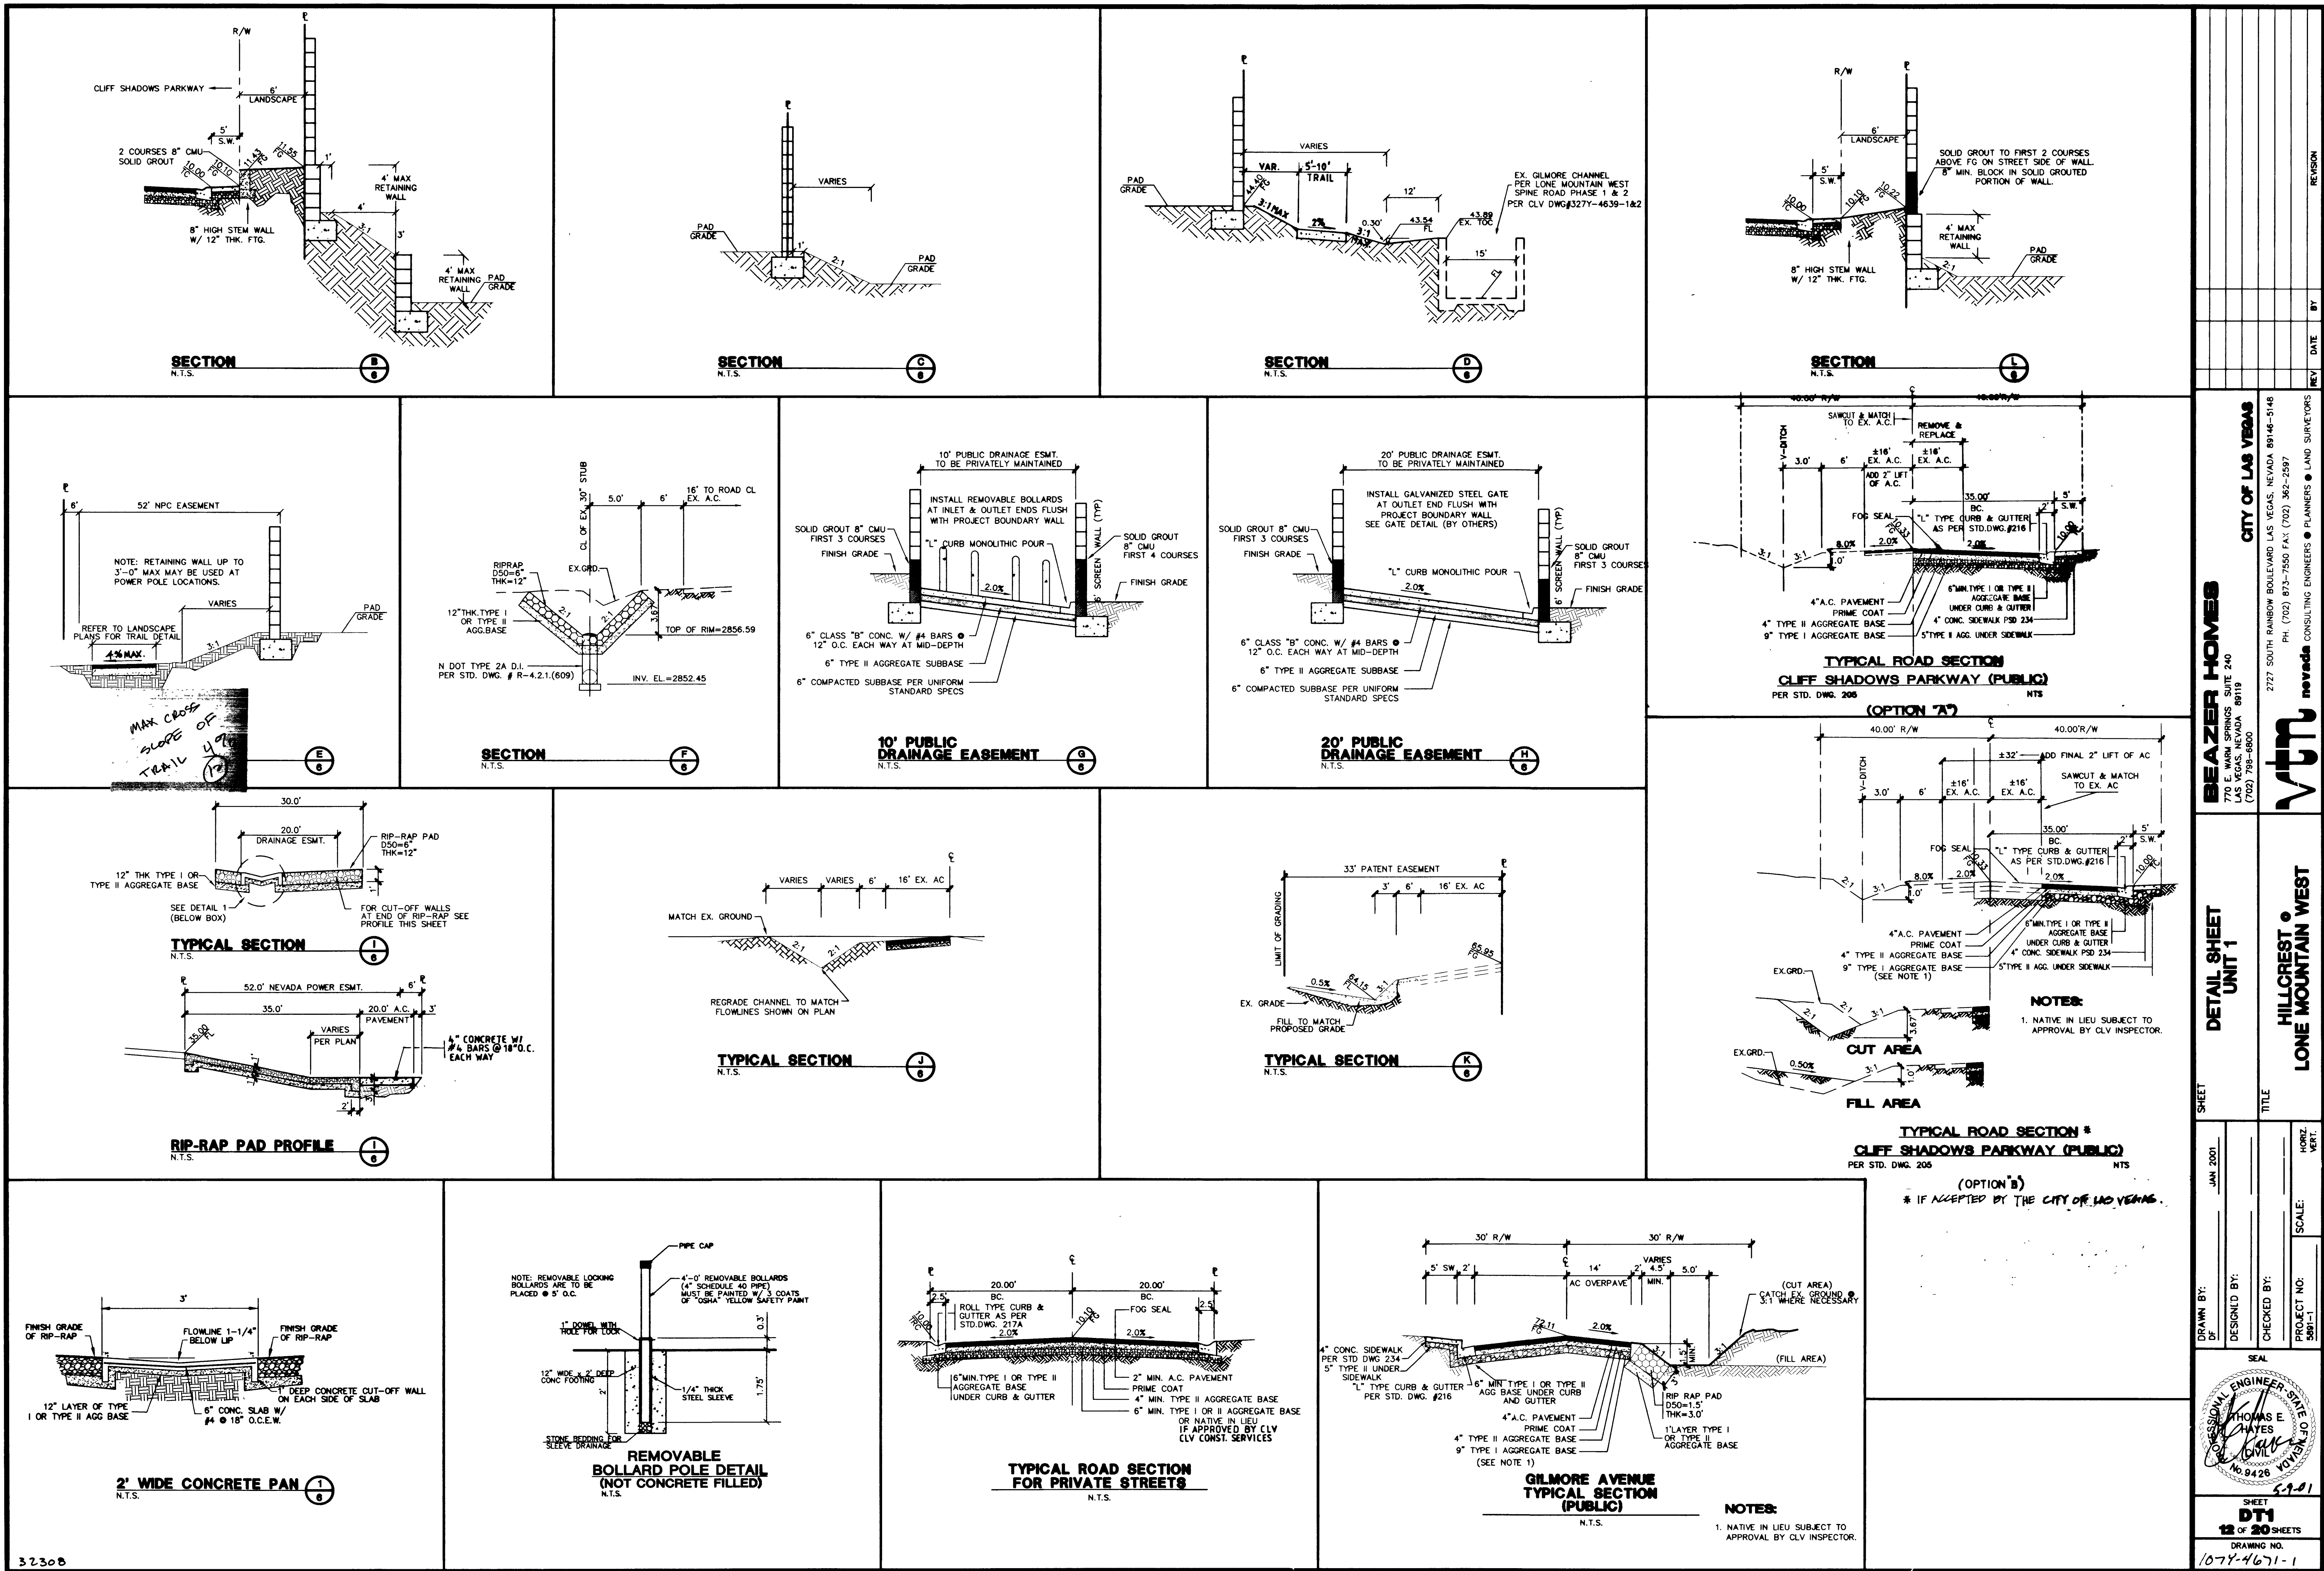

CITY OF LAS VEGAS		770 E. WARM SPRINGS SUITE 240 LAS VEGAS, NEVADA 89119 (702) 798-6800	
BEAZER HOMES		HILLCREST • LONE MOUNTAIN WEST	
DETAIL SHEET UNIT 1		TITLE	
SHEET		JAN 2001	
DRAWN BY:		DESIGNED BY:	
CHECKED BY:		PROJECT NO: 5801-1	
SCALE:		SCALE:	
SEAL		SEAL	
THOMAS E. HAYES Professional Engineer, State of Nevada No. 9426		THOMAS E. HAYES Professional Engineer, State of Nevada No. 9426	
SHEET DT1		SHEET DT1	
12 OF 20 SHEETS		12 OF 20 SHEETS	
DRAWING NO.		DRAWING NO.	
1074-4671-1		1074-4671-1	