
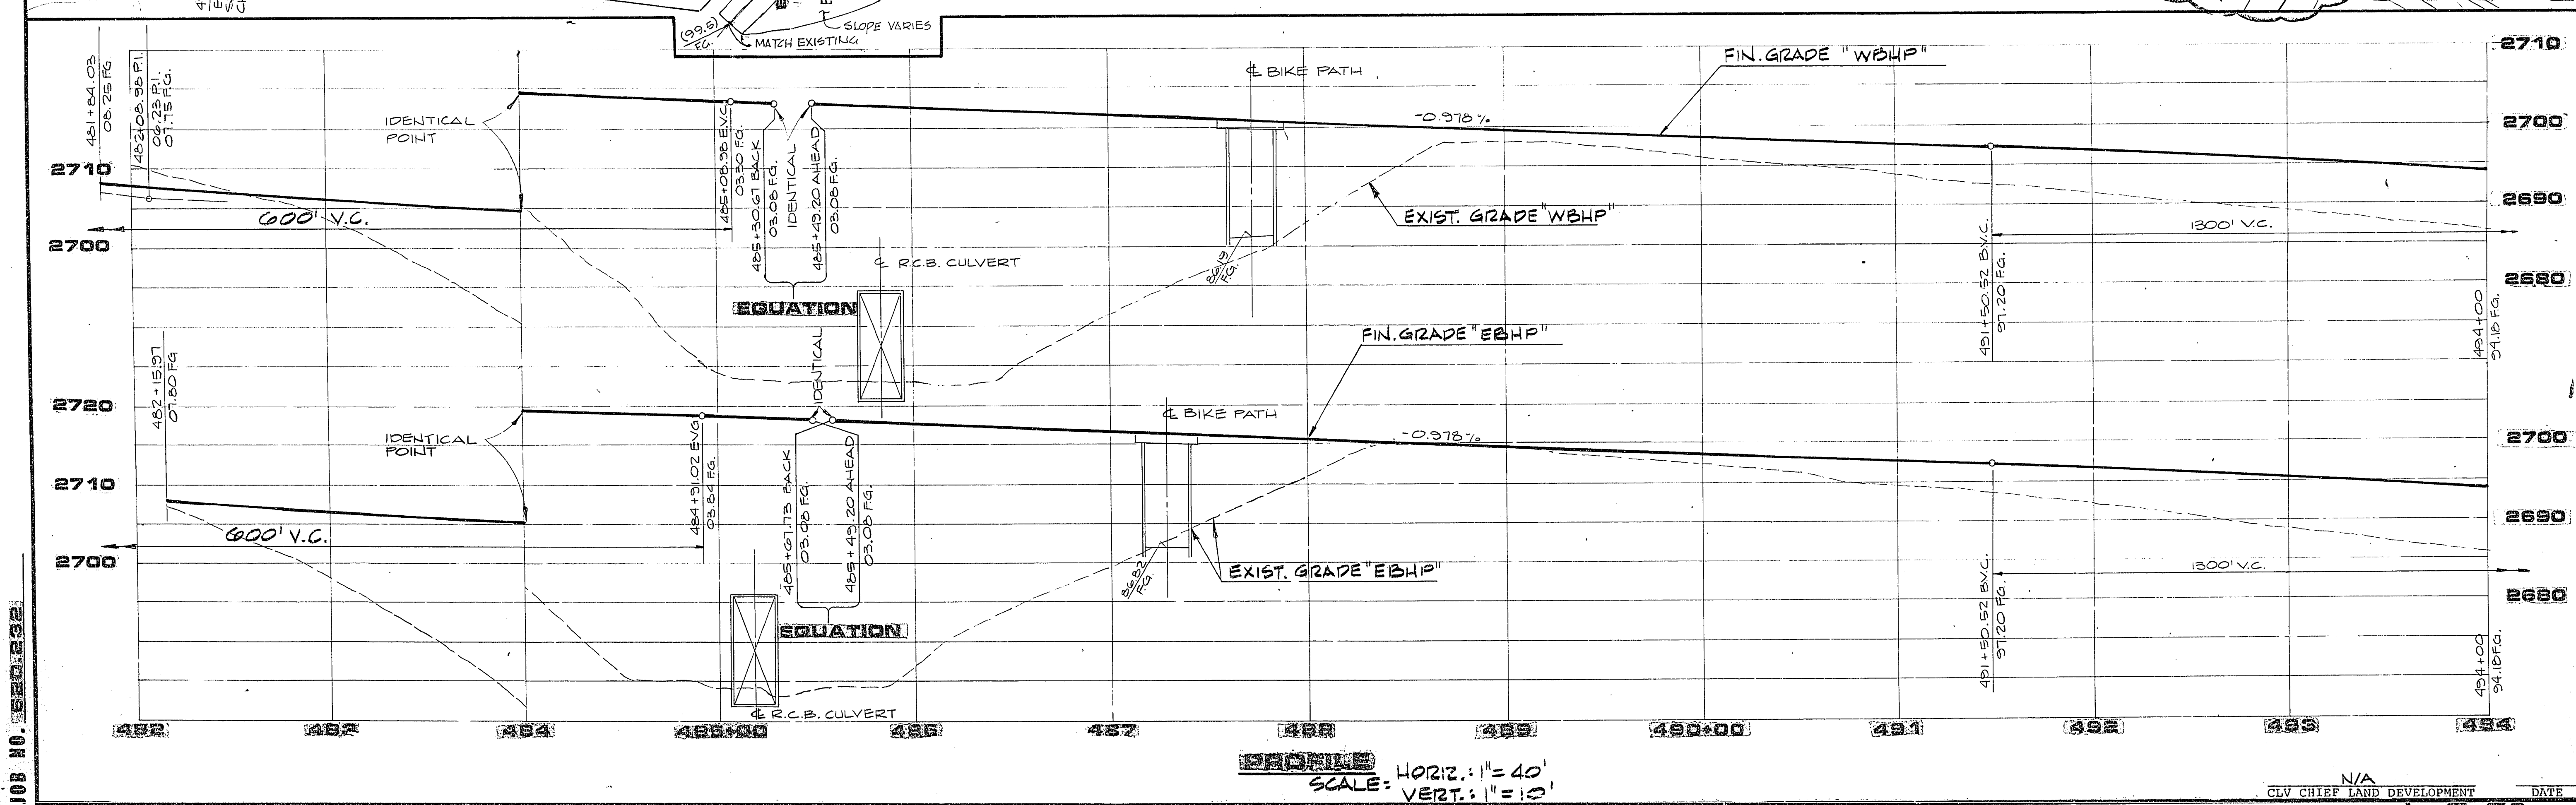


JOB NO. 1520-232

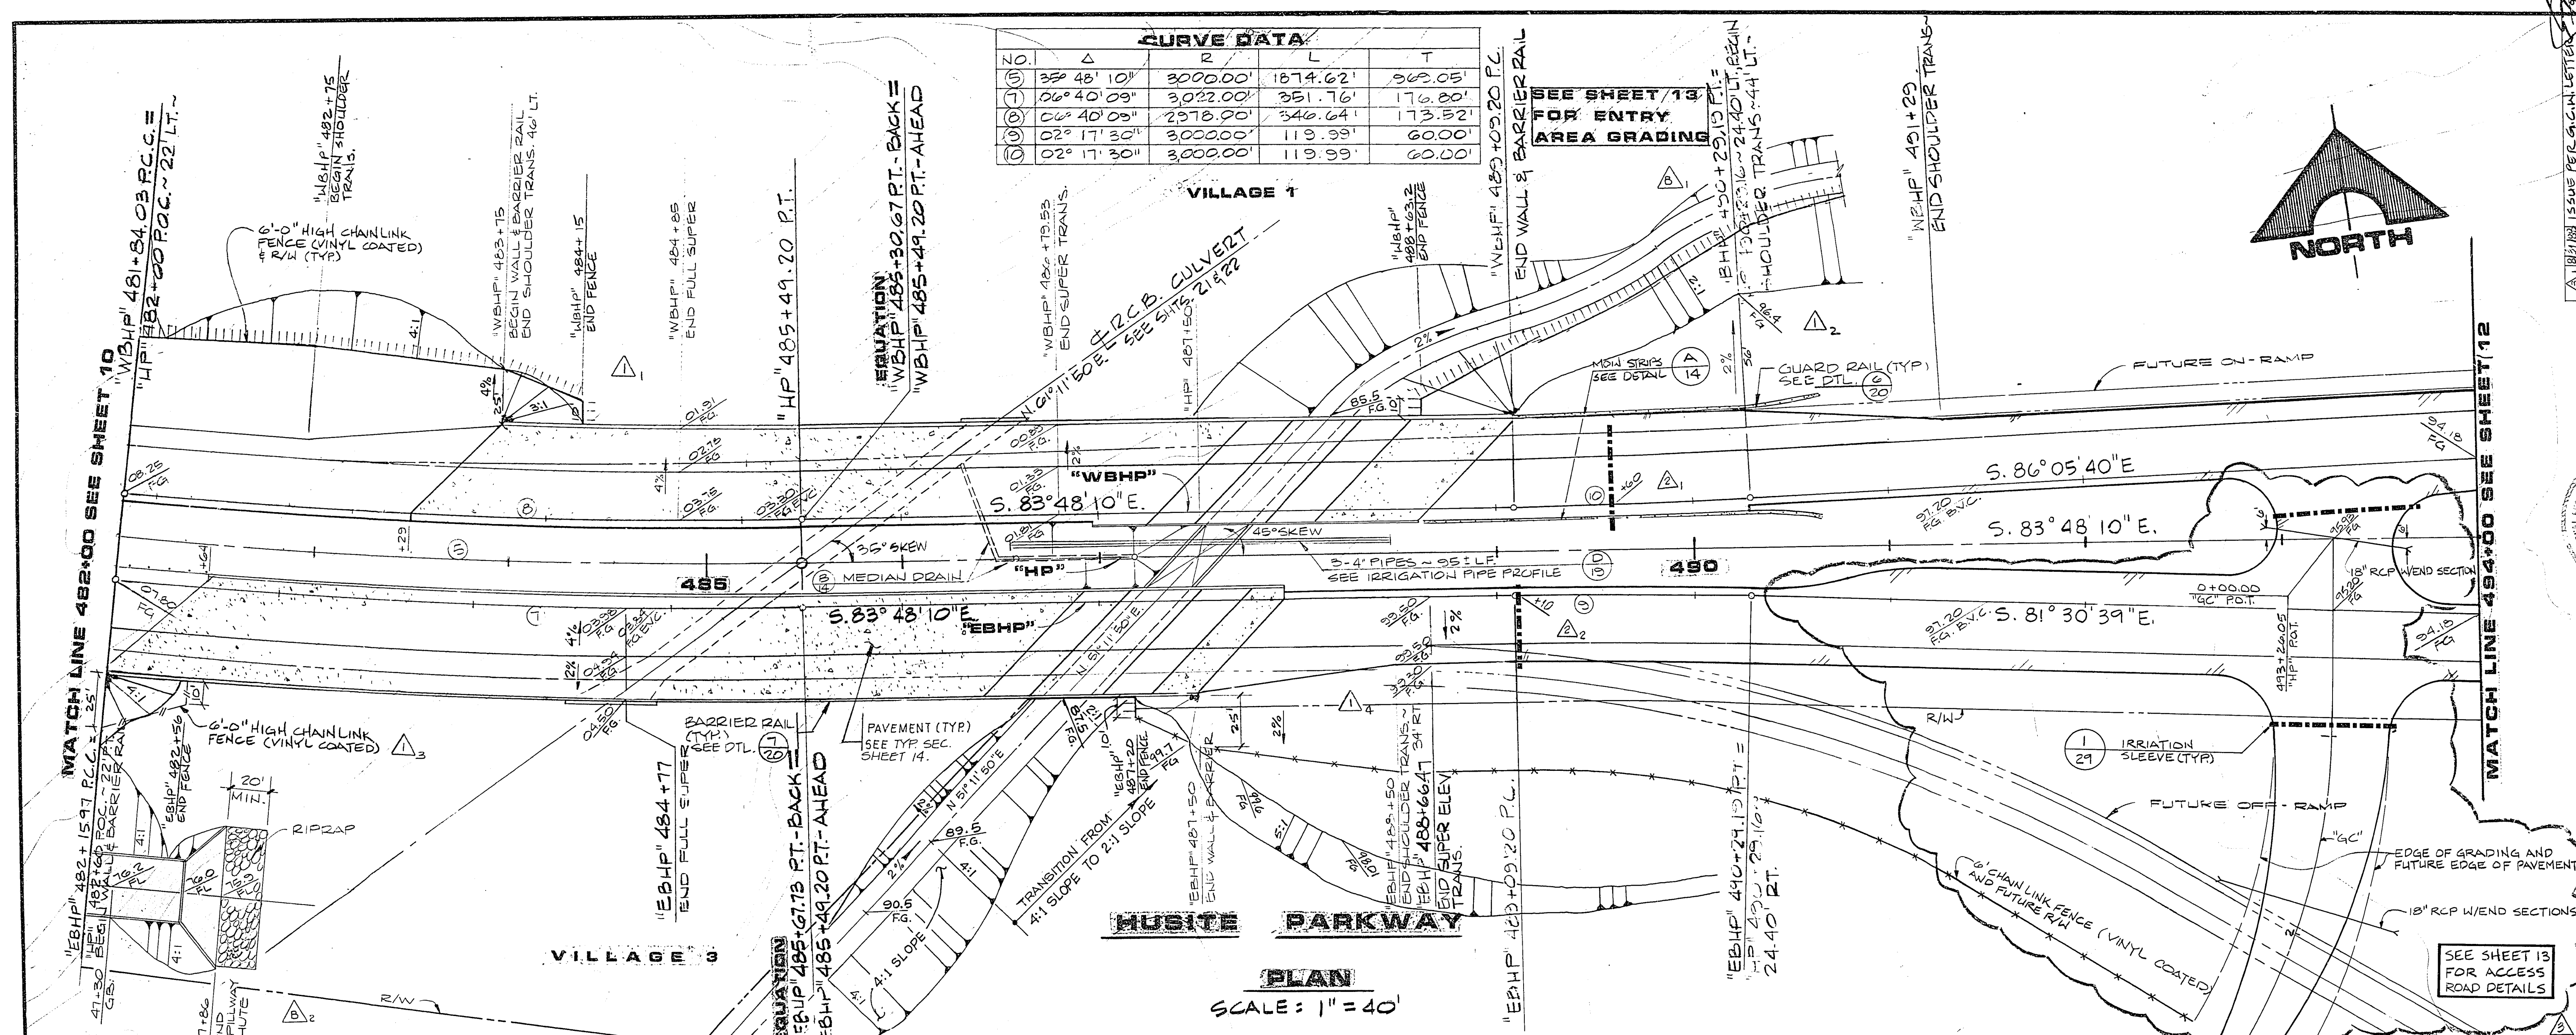

| REV | DATE     | DESCRIPTION                |
|-----|----------|----------------------------|
| A   | 11/16/51 | ISSUED FOR GRIP            |

**G.C. WALLACE, INC.**  
Engineering/Architecture

**HOWARD HUGHES PROPERTIES**  
HUSITE PARKWAY  
PLAN & PROFILE  
STA. 482+00 TO STA. 494+00

**SHEET**  
11  
OF 21 SHEETS

**DATE**  
11/16/51

**CLV CHIEF LAND DEVELOPMENT**

**6-352 107-V1571**