
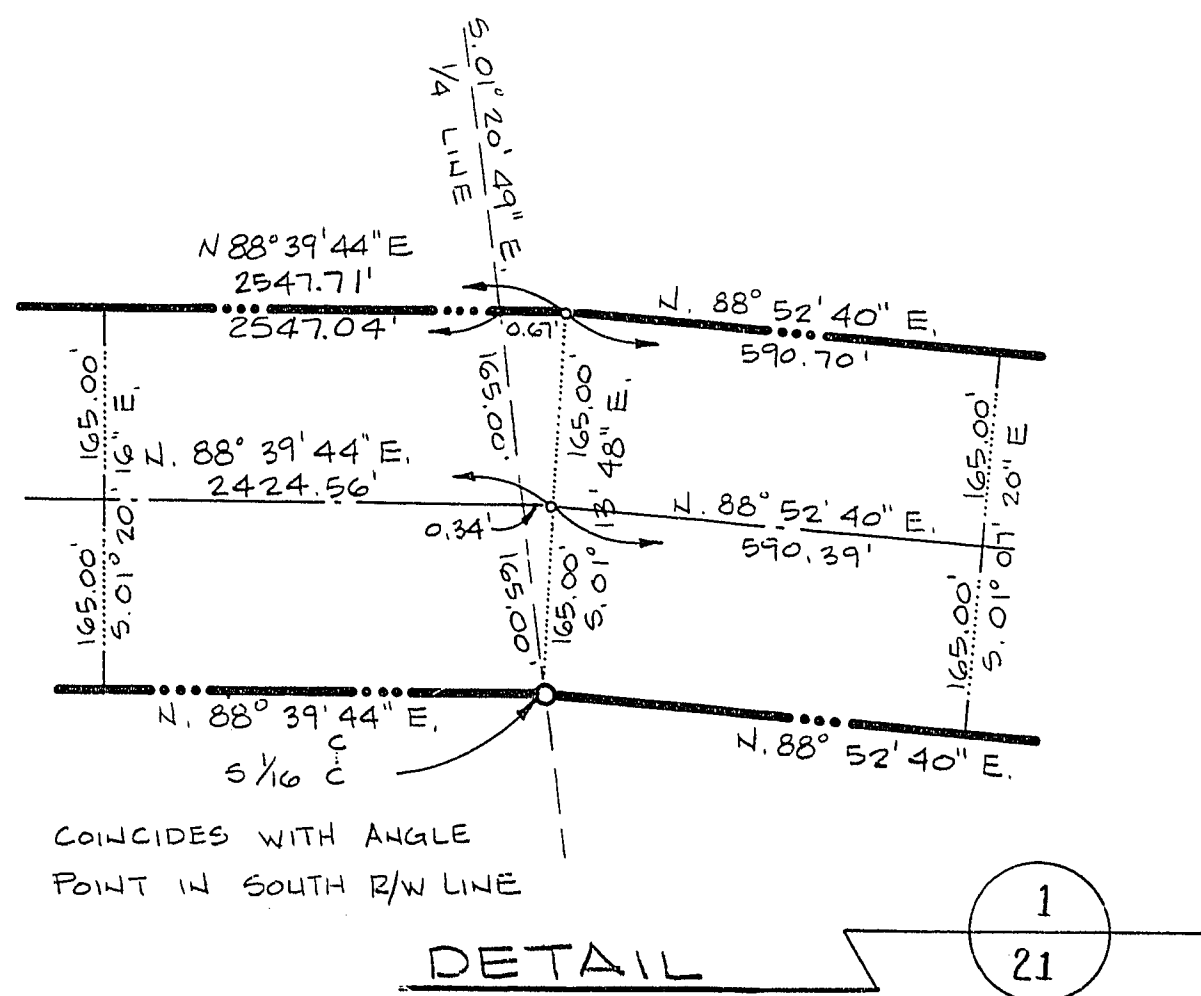
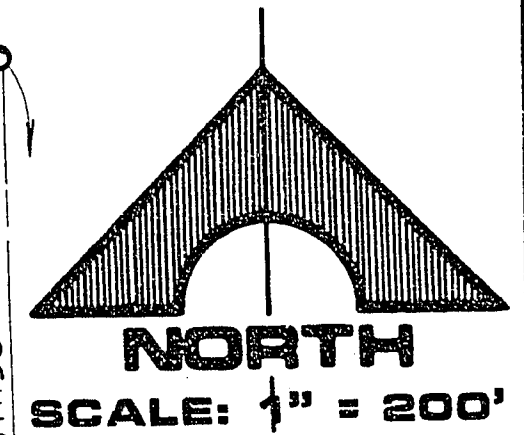


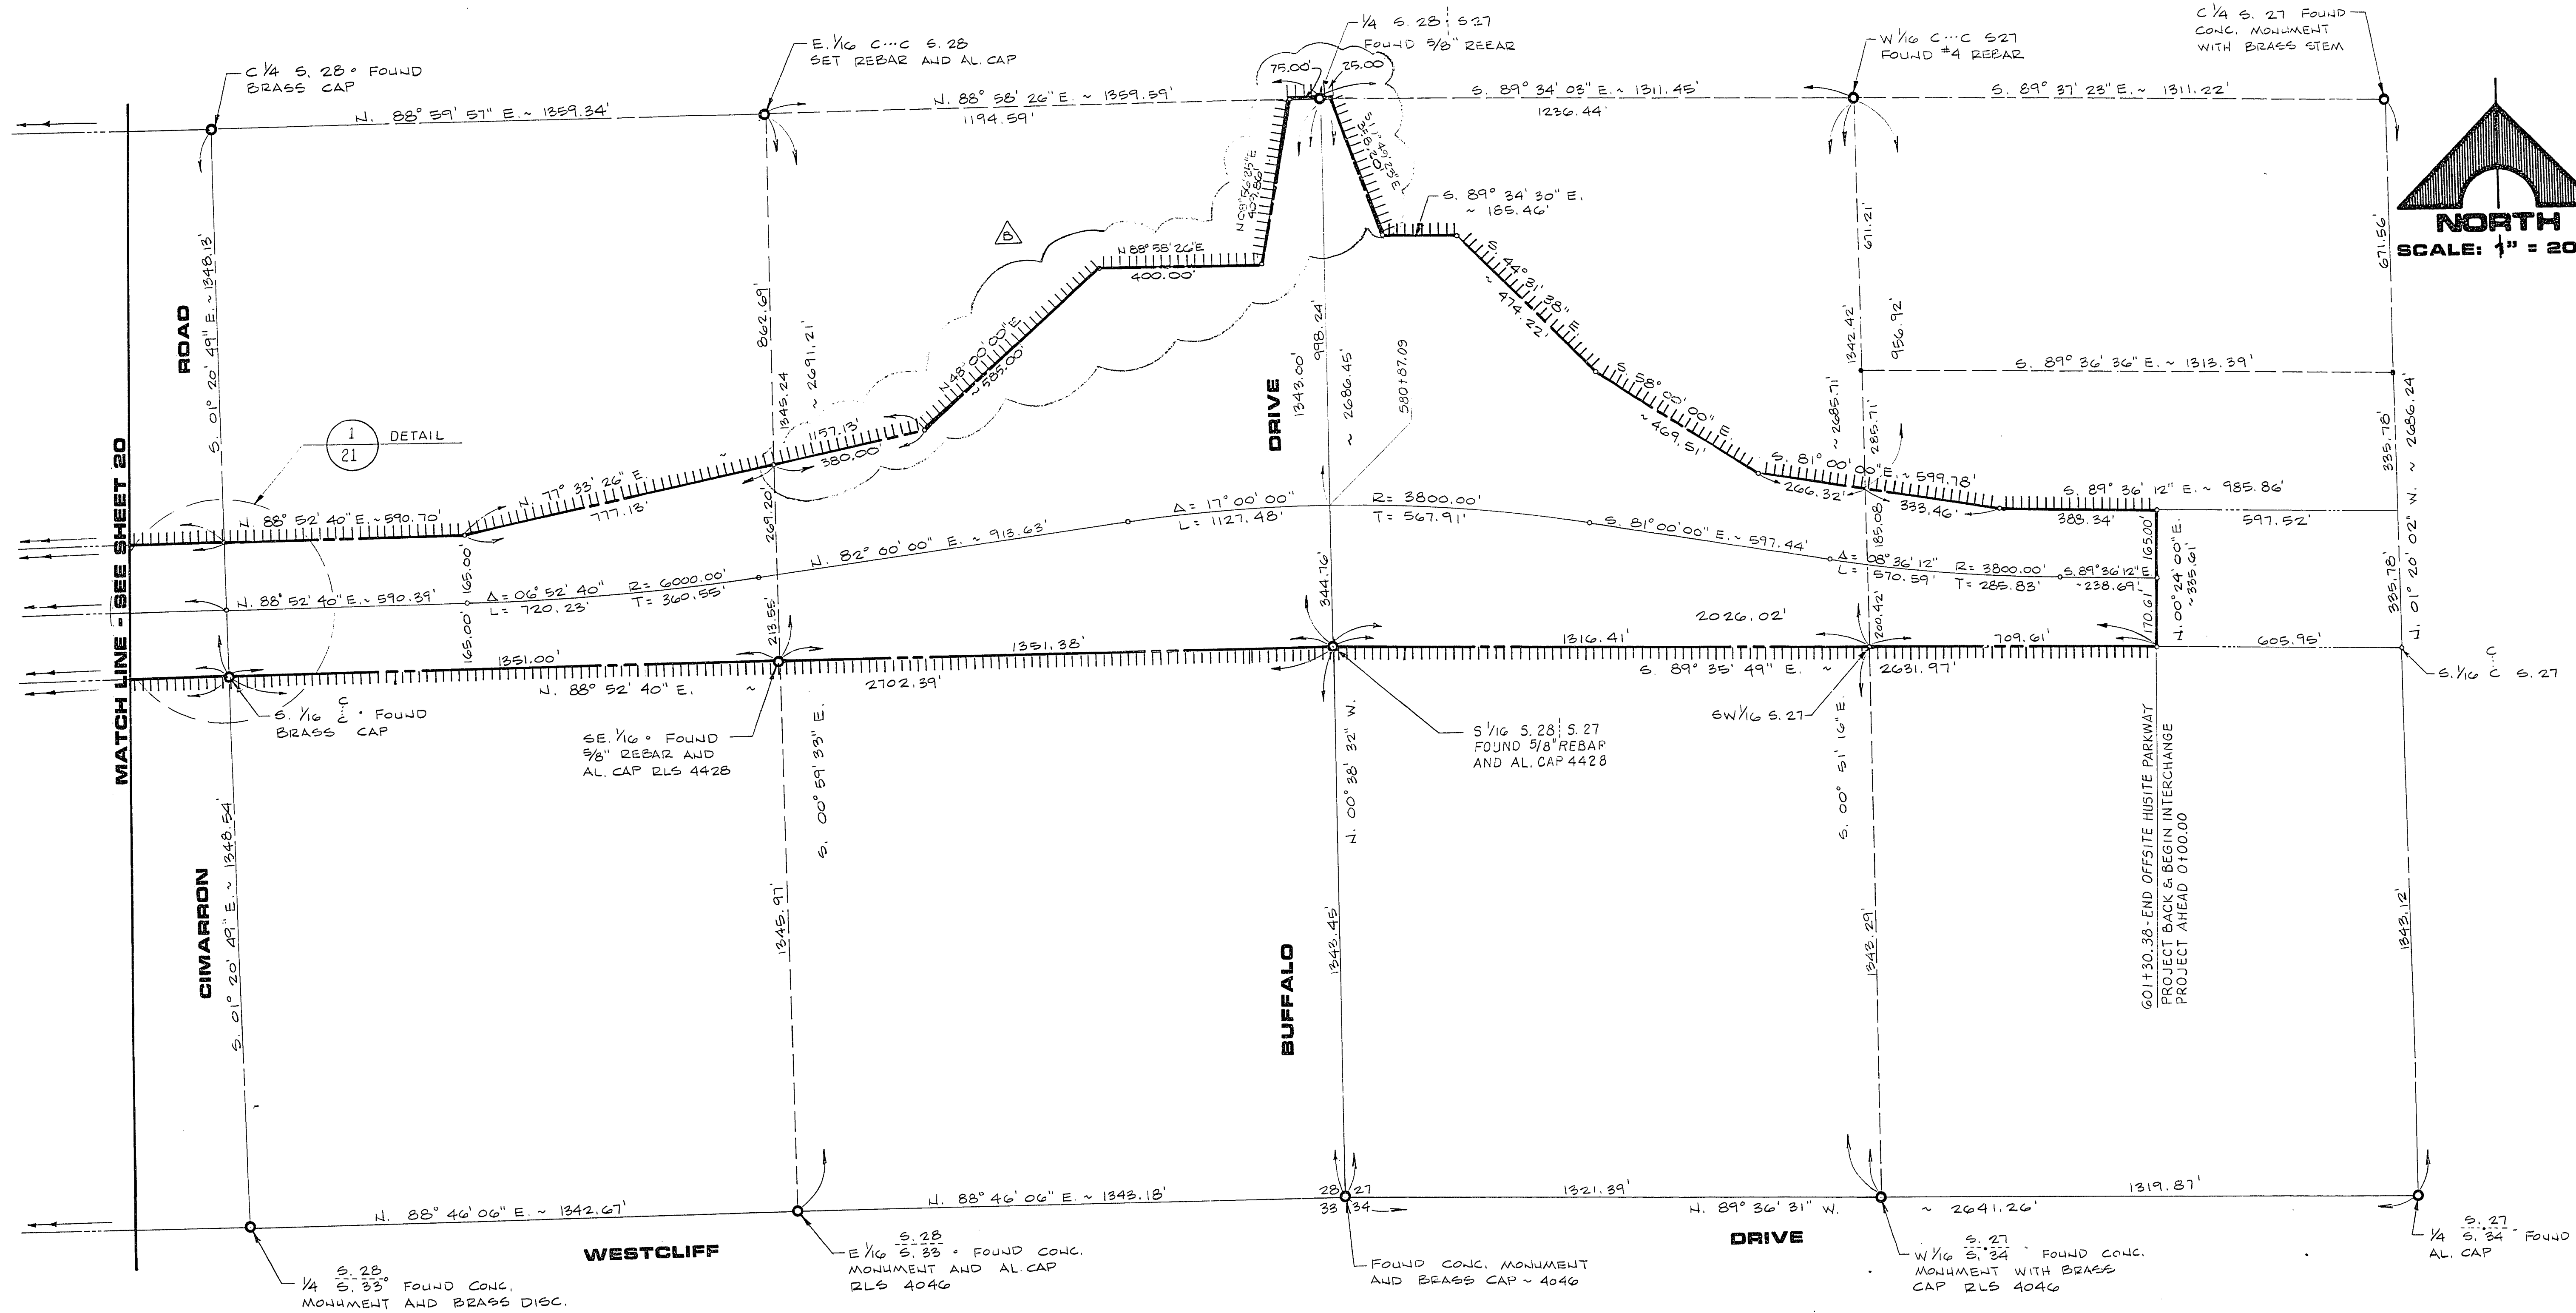

REV	DATE	DESCRIPTION
1	11/10/87	ISSUED FOR BIDD
2	11/10/87	ISSUE ADDENDUM NO. 1 TO CAMP
3	2/14/88	ISSUE FOR CONSTRUCTION

RECOMMENDED BY	DATE
CRAG A. PRIMAS	6/25/87

6638	R.E. NO.
------	----------

155 SOUTH RAINBOW BLVD. LAS VEGAS, NEVADA 8903
--

HOWARD HUGHES PROPERTIES
HUBITE PARKWAY
RIGHT-OF-WAY AND FENCE PLAN

SHEET
20
OF 20 SHEETS

CLV CHIEF LAND DEVELOPMENT

DATE 7/8/87

6-3-41

107-V1571-2