



108 10. 380.832

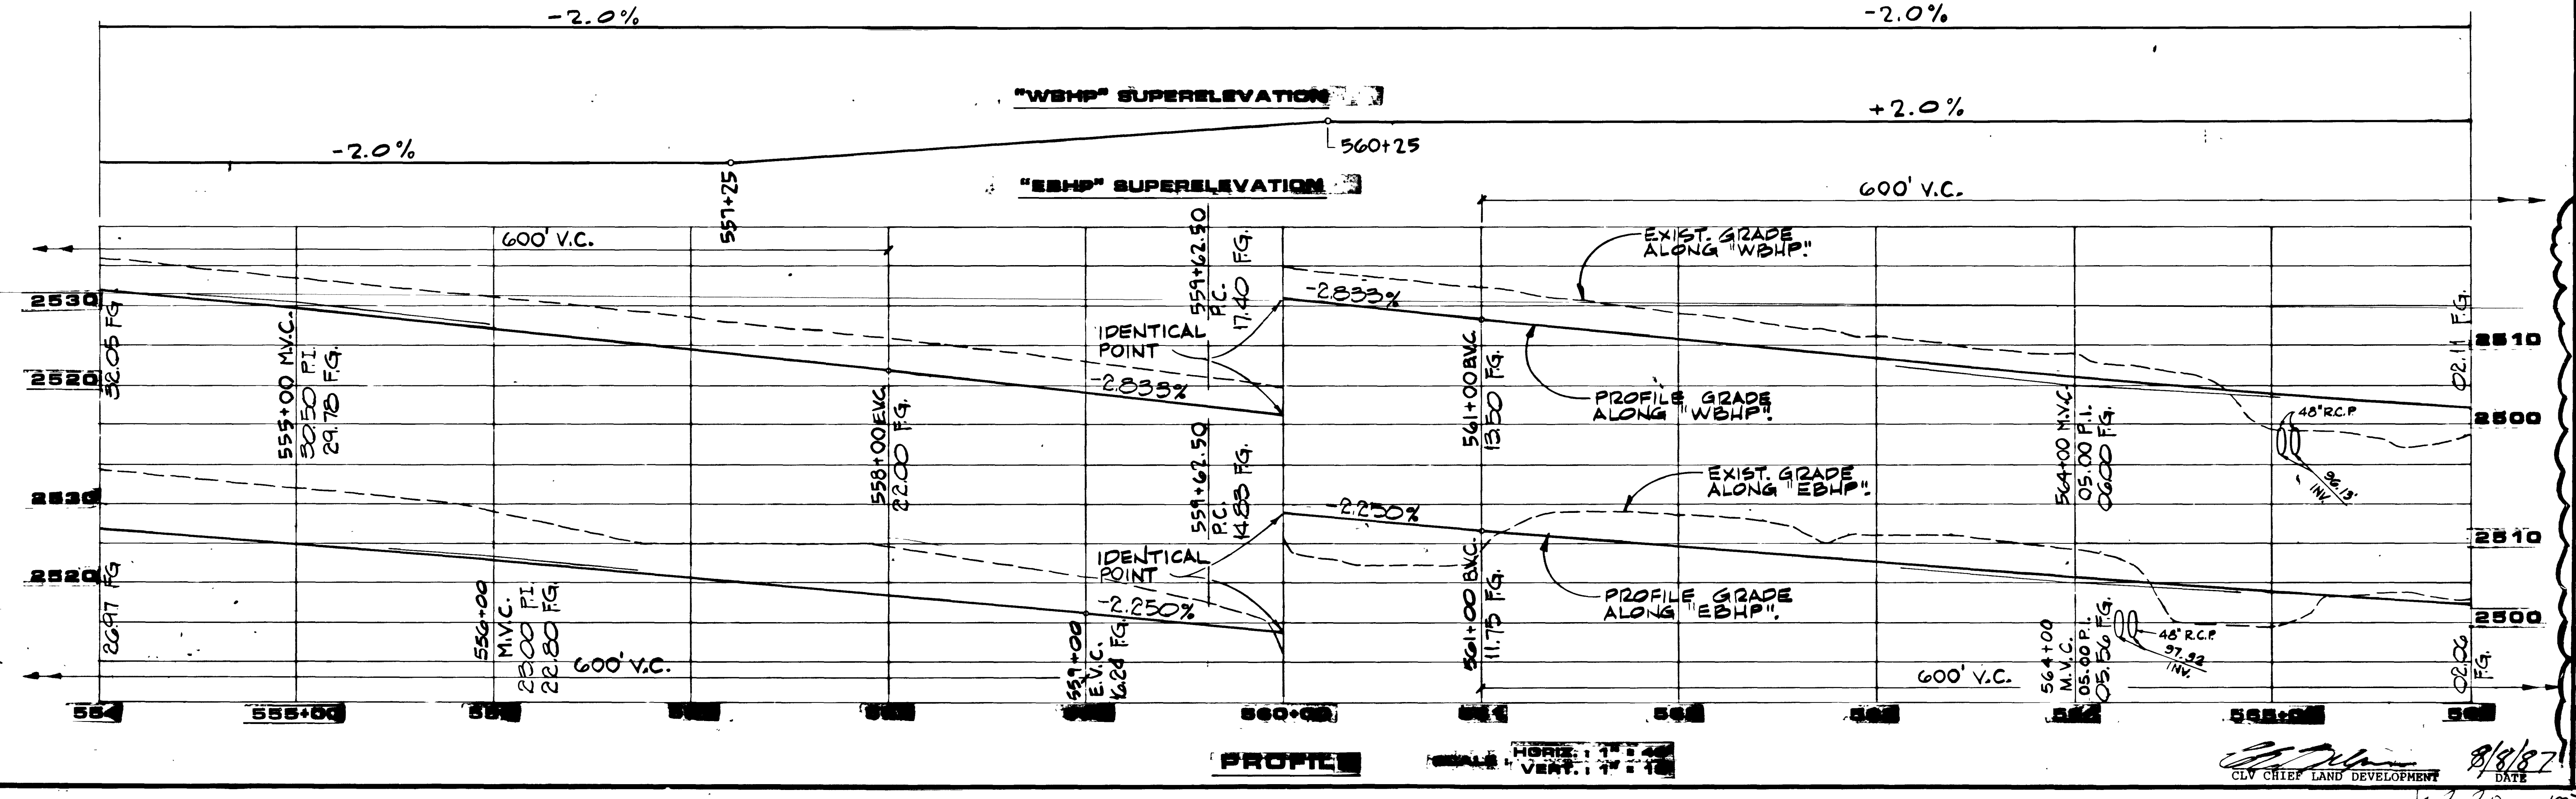

STATE OF NEVADA
 CIVIL ENGINEER
 G.C. WALLACE, INC.
 Engineering/Architecture
 1555 SOUTH BAMBURGH BLVD., LAS VEGAS, NEVADA 89102

REVISIONS:
 1. 11/18/87

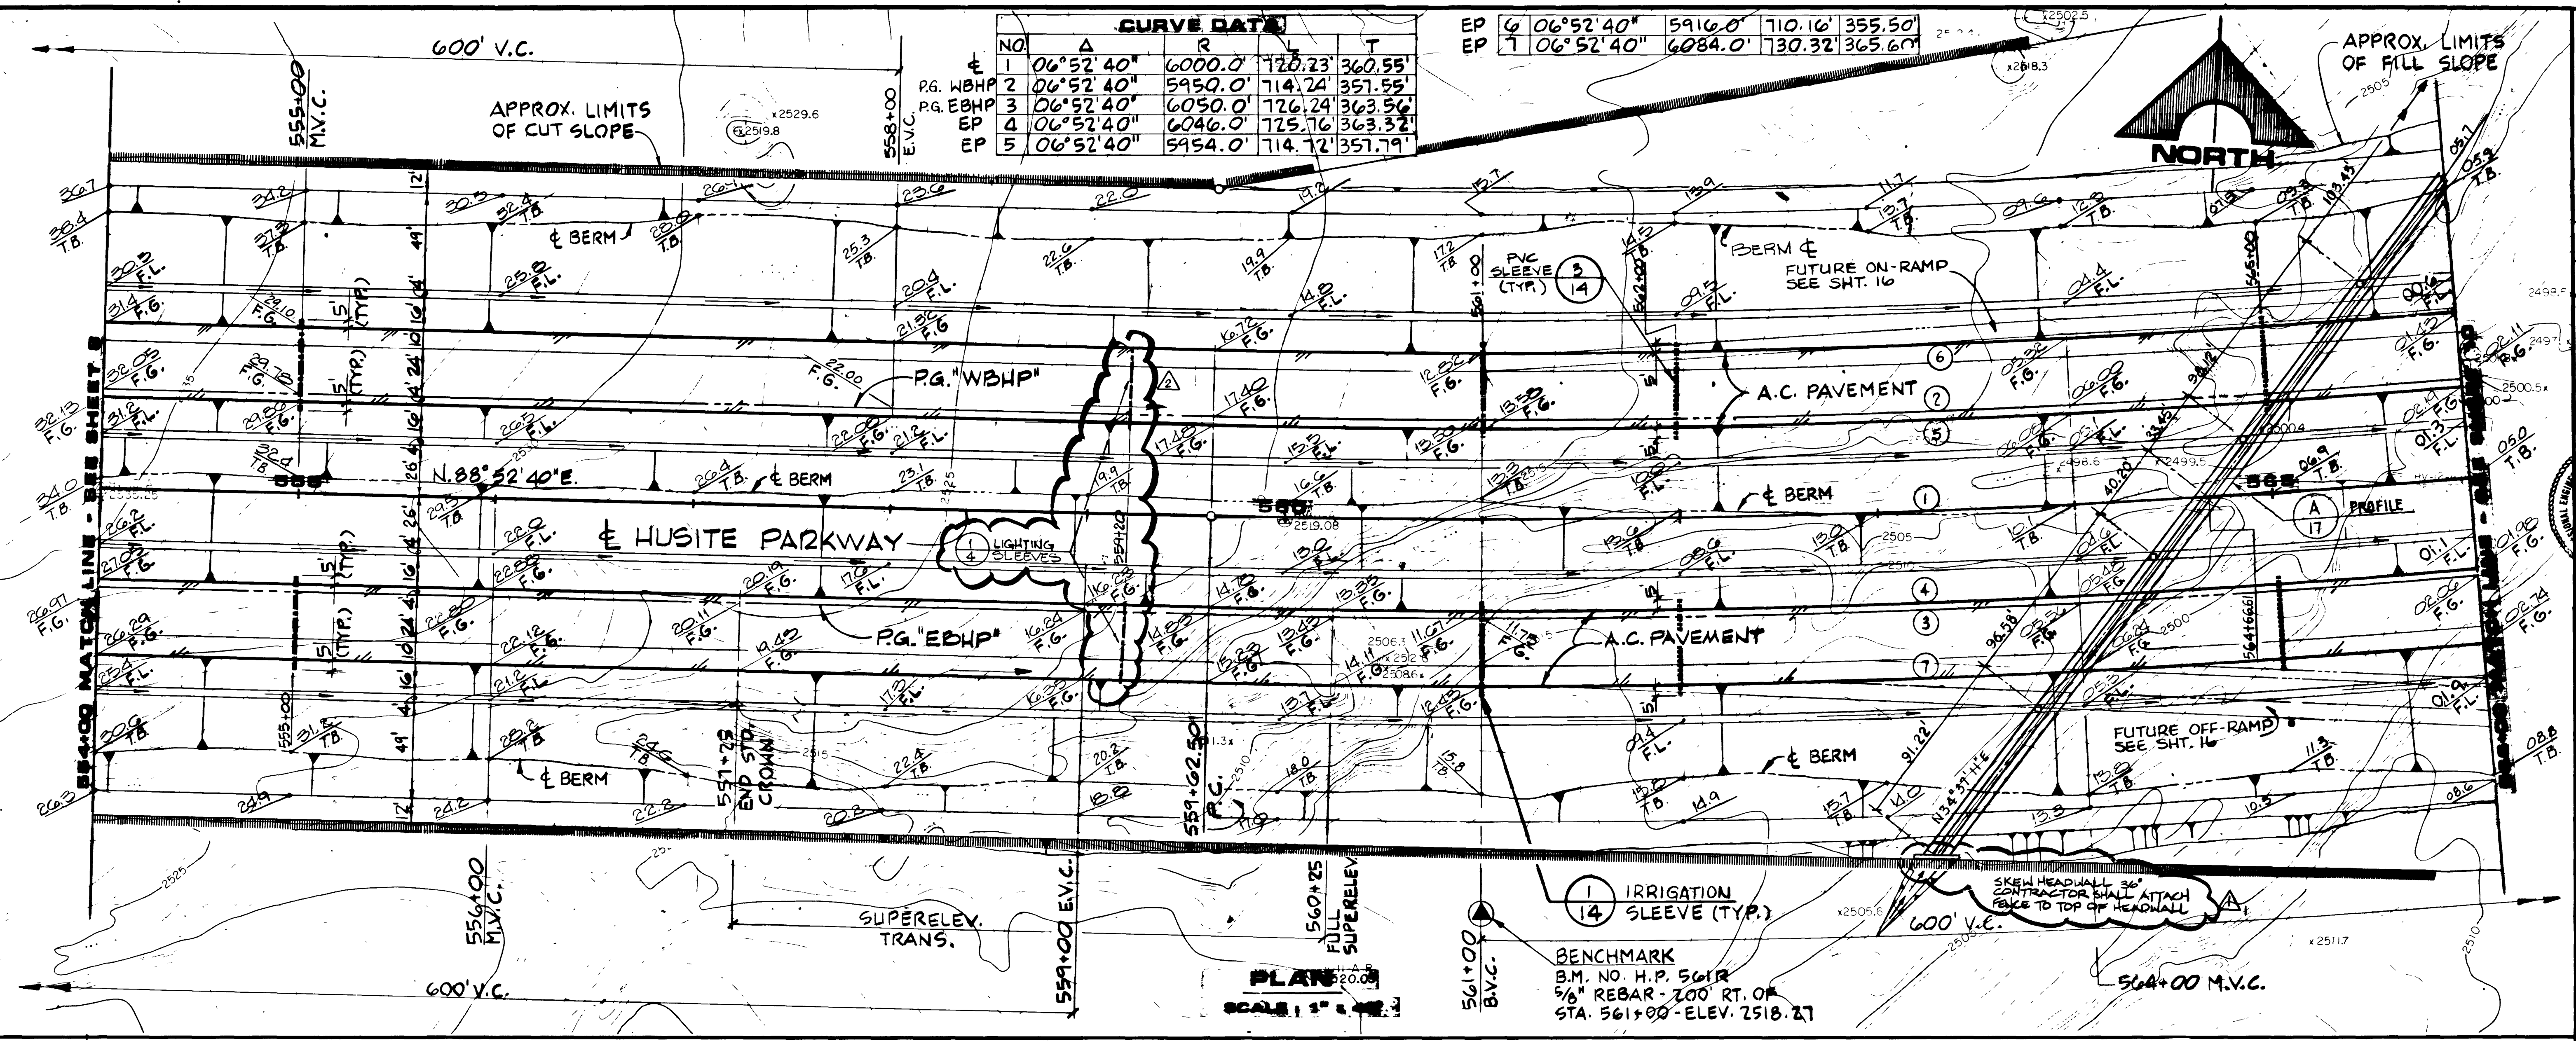